

NOZZLE SCHEDULE					
MARK	QUAN.	SIZE	ASA RATING	SCH	SERVICE
A	1	4"	150# LAP JOINT	40	COND. RETURN W/ 1 1/2"
A1	1	1 1/2"	150# LAP JOINT	40	DIP PIPE
B	1	4"	150# LAP JOINT	40	INLET W/ 3" DIP PIPE
B1	1	3"	150# LAP JOINT	40	DIP PIPE
C	1	8"	150# LAP JOINT	1/4"	RELIEF / VENT
D	1	12"	150# SLIP-ON W/ RF	1/4"	AGITATOR
E	1	24"	150# SLIP-ON	1/4"	MANWAY W/ DAVIT
F	1	2"	150# LAP JOINT	80	CONS. VENT
G	1	1 1/2"	150# LAP JOINT	80	LEVEL SW
H	1	1 1/2"	150# LAP JOINT	80	SPARE W/ BLIND FLG
I	1	1 1/2"	150# LAP JOINT	80	TEMP. TRANS
J	1	3"	150# LAP JOINT	80	LEVEL TRANS.
K	1	4"	150# LAP JOINT	40	BTM OUTLET
L1 TO L4	4	1 1/2"	150# LAP JOINT	10	JACKET INLETS
M1 TO M4	4	1 1/2"	150# LAP JOINT	10	JACKET OUTLETS
N	1	3"	150# LAP JOINT	40	RECIRC. W/ .2" DIP PIPE
N1	1	2"	150# LAP JOINT	40	DIP PIPE
O	1	3"	150# LAP JOINT	40	SPARE W/ BLIND FLG
P	1	6"	150# LAP JOINT	1/4"	LEVEL INDICATOR

★ SUPPLIED W/ BLIND FLG., GASKET & BOLTING

- NOTES -  
1. CONSTRUCTION TO COMPLY WITH ASME CODE SECTION VIII DIV. 1 1995 ED. 406 INCLUDING CERT. & STAMP FOR INSTALLATION IN STATE OF MD.  
2. NAME PLATE STAMPING:

U	CERTIFIED BY:	NAT'L. BOARD	939L
	W RT-3	ROBEN MFG. CO. INC.	LAKEWOOD, N.J. 08701
VESSEL MAMP		-2.5/25	PSI AT 331 OF
MIN DESIGN METAL TEMP		0	OF AT -2.5/25
JACKET MAMP		-14.7/90	PSI AT 331 OF
MIN DESIGN METAL TEMP		0	OF AT -14.7/90
TUBE MAMP		-	PSI AT -
MIN DESIGN METAL TEMP		-	OF AT -
SERIAL NO.		97095	YEAR 1995
P.O. NO.		44012555	
TAG NO.		T-17030	

DETAIL DWGS  
VARIOUS DETAILS D-97095-1

3. TEST PRESSURE	SHELL SIDE	JACKET SIDE
CORROSION ALLOWANCE	40	140
	1/32"	NONE
4. WEIGHTS:		
EMPTY (APPROX.)		16100 LBS.
5. PAINT: REFER TO NOTE 4 & 5		
SANDBLAST: YES - EXT. C/S & S/S SURFACES PER SSPC-SP5		
6. STRESS RELIEVE: NO		
8. RADIOGRAPHY: YES SPOT X-RAY LONG SEAM		
9. SPECIAL TESTS: LIQUID PENETRANT CHECK ALL WELDS		
10. CUSTOMER'S INSPECTION: YES		

- GENERAL NOTES -  
1. ALL BOLT HOLES TO STRADDLE MAIN CENTER LINES.  
2. VESSEL TO BE FREE OF ALL WELD SPLATTER, DIRT, OIL, AND GREASE.  
3. COVER & PLUG ALL OPENINGS FOR SHIPMENT.  
4. PAINT ALL EXTERNAL C/S SURFACES W/ (D) COAT OF BRINER SILICONE ACRYLIC BLACK (4900-7038)  
5. PAINT ALL EXTERNAL STAINLESS STEEL SURFACES W/ (D) COAT OF BRINER SILICONE RUBBER 2954.  
6. GRIND ALL INTERNAL WELDS SMOOTH.  
7. TANK TO BE BUILT PER THE FOLLOWING FMC SPECS: D-251.D-211, W-201, 8004 & 8004A



CUSTOMER FMC CORP.  
P.O. NO. 44012555  
UNITS REQ'D. (1) ONE

**ROBEN Manufacturing Company, Inc.**  
Steel and Alloy Fabrication  
126" I.D. HASTELLOY C-276  
STEP 6 PRODUCT TANK  
TAG NO. T-17030



SCALE	MADE	CKD	DATE	DRAWING
AS SHOWN	RED	GH	11-6-97	D-97095

ASME MATERIAL SPECIFICATIONS											
SHELLS		FACINGS		COILS		FACINGS		BOLTING	ZINC PLTD	GASKETS	1/8" THK
PIPE		EXPANSION JOINT		WELD CAPS		VORTEX BREAKER		SA-193 GR B7		COMPRESSED ASBESTOS	
ROLLED PLATE	HAST C-276	SB-575	HAND HOLES	BTM HEAD COIL	HAST C-276	COVERS	FACED	SA-325		TEFLON ENV. W/ GARLOCK	
BAFFLES	HAST C-276	SB-575	PIPE			TUBE SHEETS		SA-320		6326 FILLER	
TIE RODS			FORMED HEADS	HAST C-276	SB-575	TUBES	SEAMLESS WELDED	NUTS	ZINC PLTD		
SPACERS			UNIT FLANGES			LIFT LUGS	316L	SA-194 GR 2H			
NOZZLE FLG'S LJ	GALV. STL.	SA-105	FITTINGS	NOZZLE FLG'S LJ	GALV. STL.	REINF. PADS	316L	SA-325		O-RINGS	
NOZZLE NECKS	HAST C-276	SB-619	SUPPORTS	316L	SA-240	NOZZLE NECKS	HAST C-276	SA-320			
						MANWAY	HAST C-276	SB-575			



REV.	DESCRIPTION	BY	CHKD	DATE
1	REV. NOZZLE SCH. FOR "C,D,P" TO 1/4" 12/30/97	RED	GRH	12-30-97
2	REV PER CUSTOMERS DWG 11-19-97	RED	GRH	12-9-97

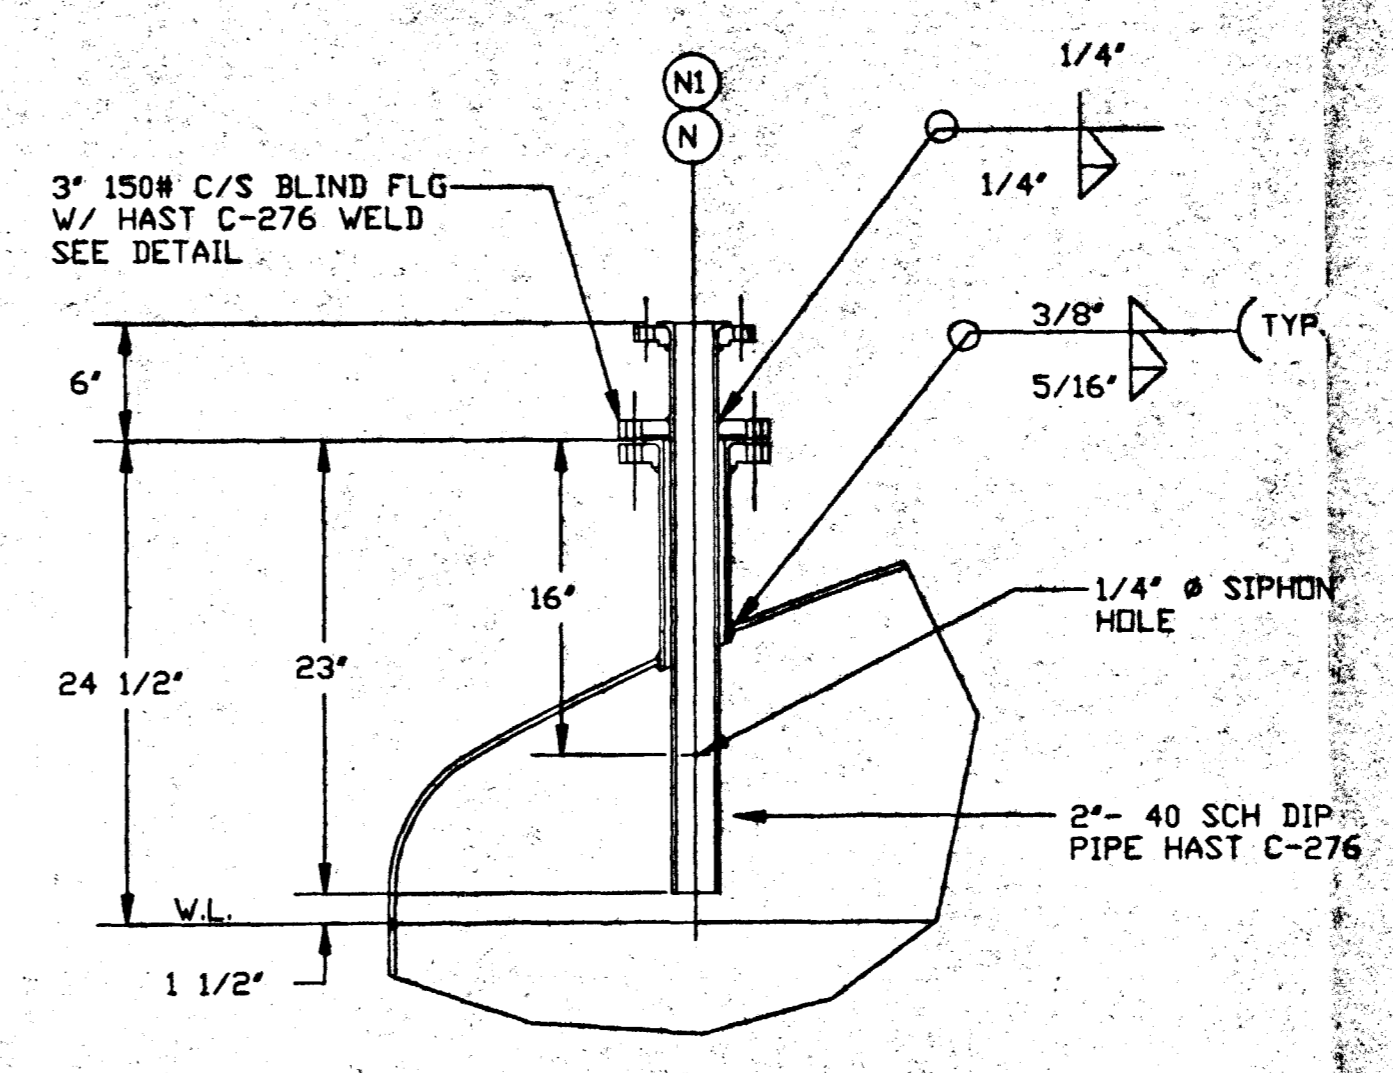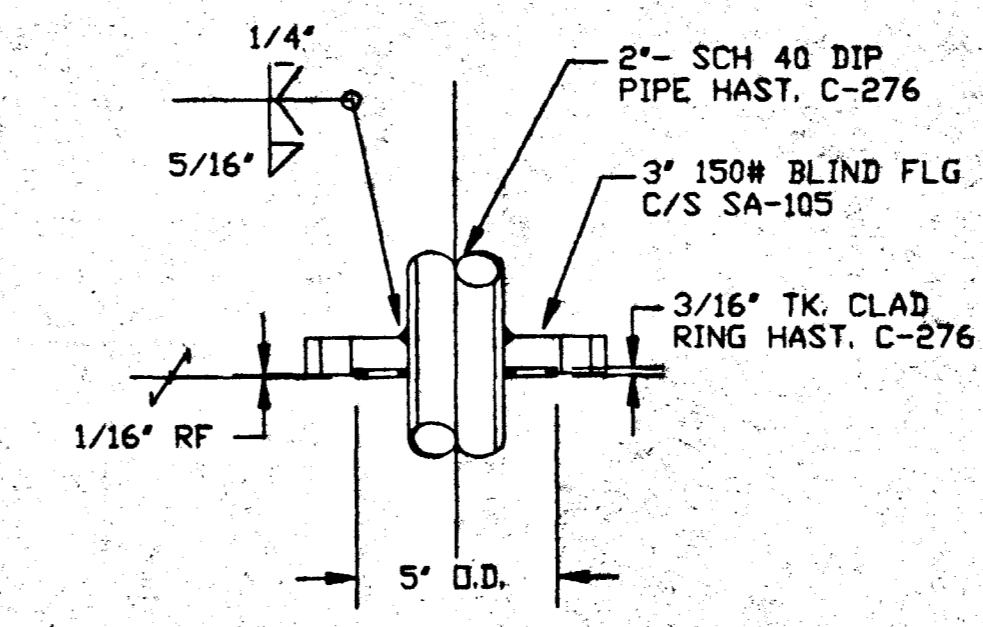

NOZZLE "N" DETAIL  
SCALE 1" = 12"

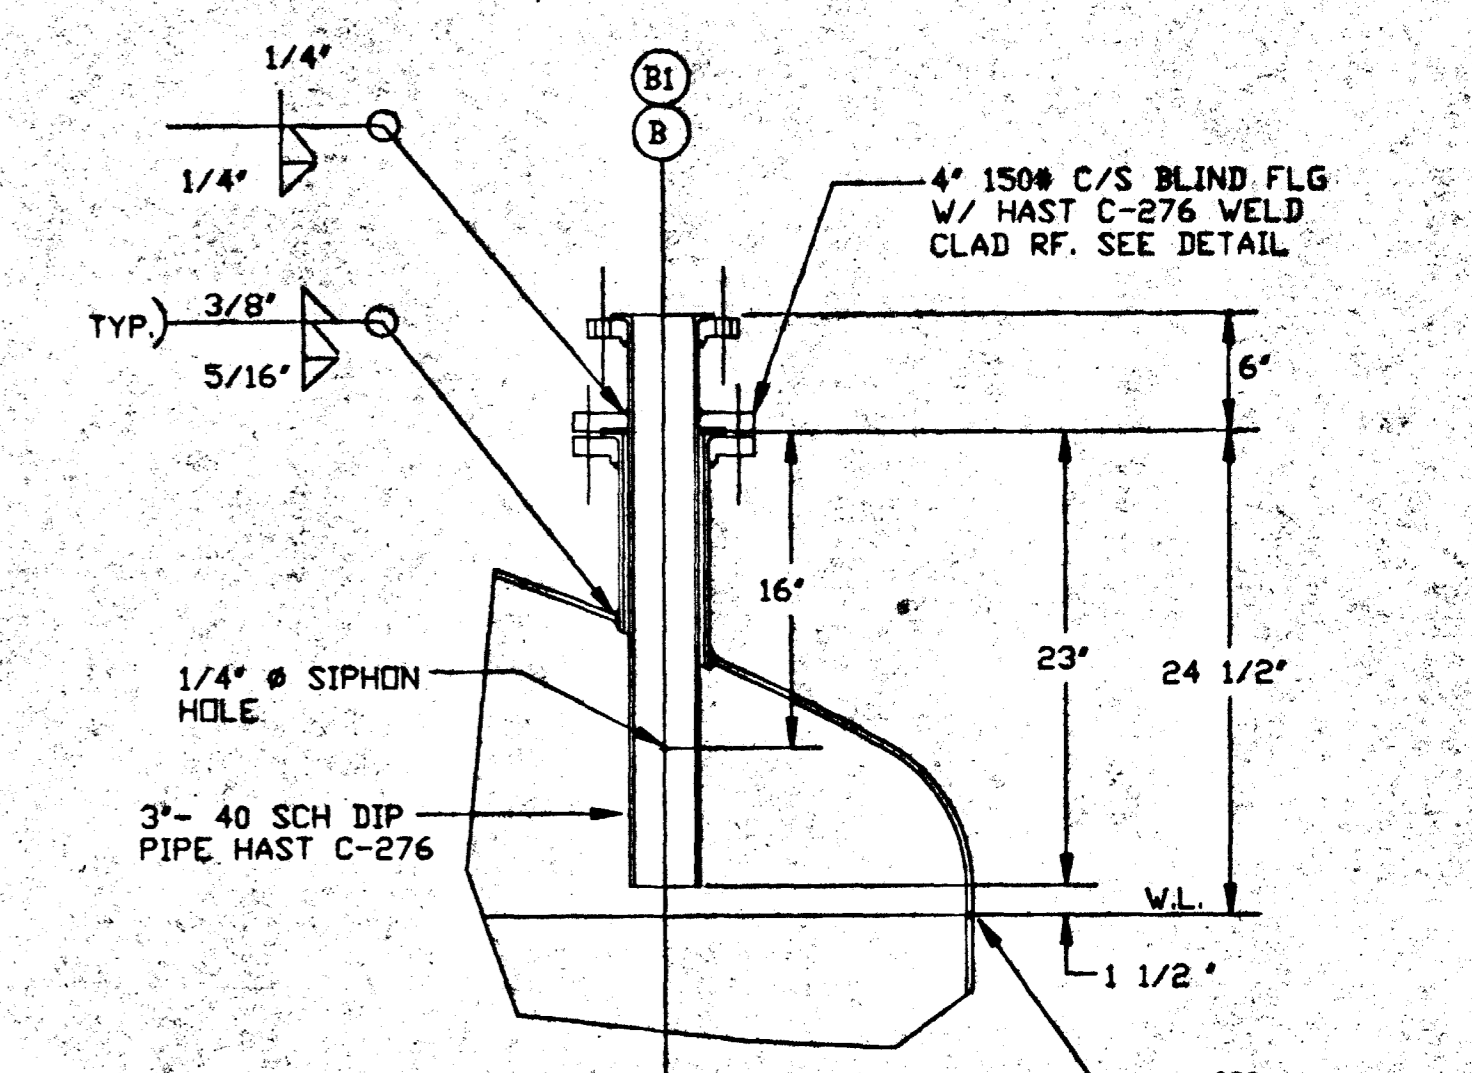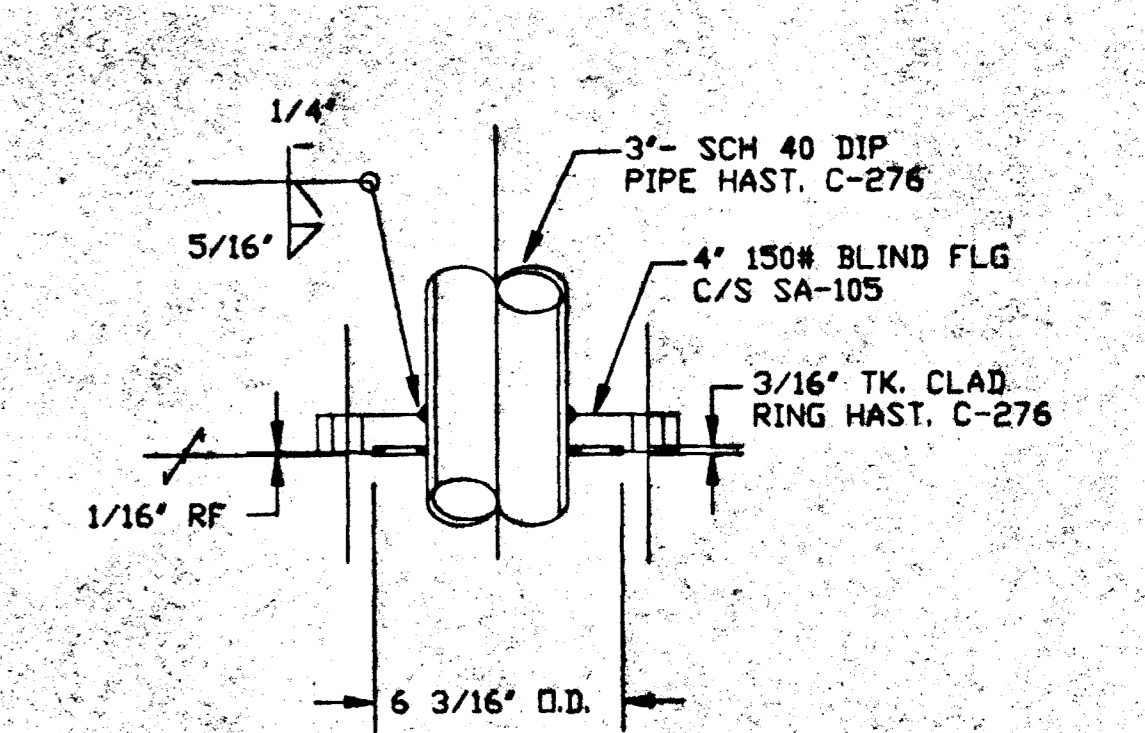

NOZZLE "B" DETAIL  
SCALE 1" = 12"

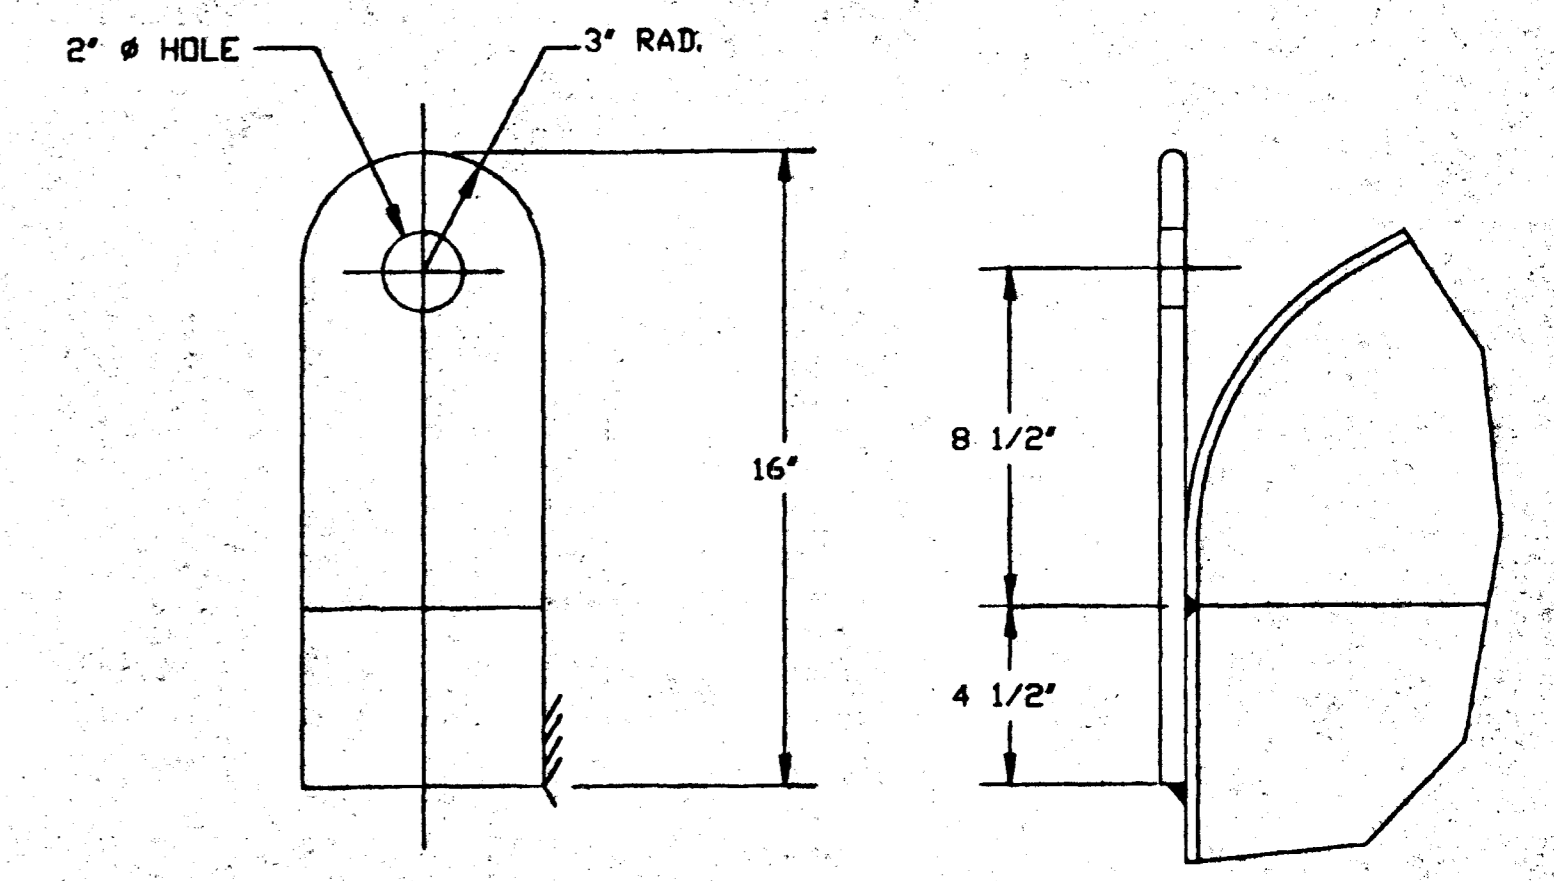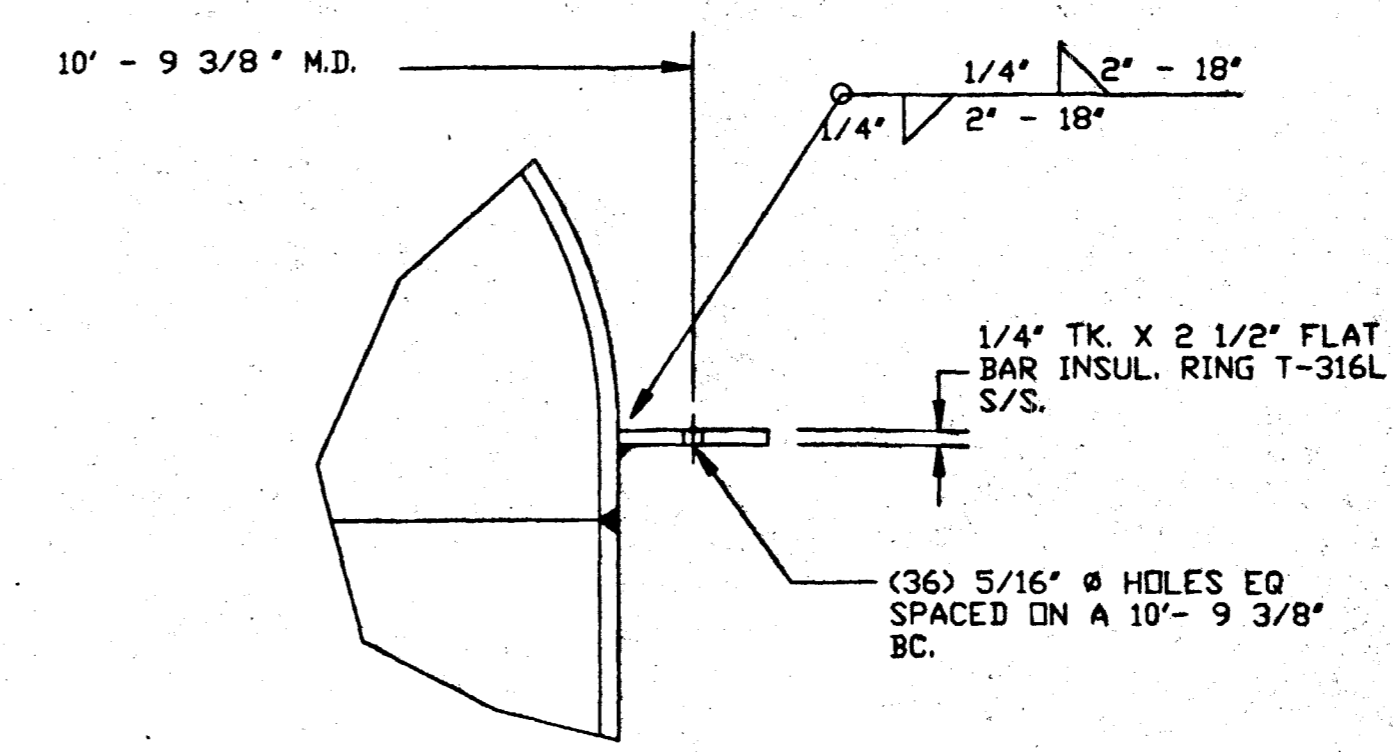

#93533

ROBEN Manufacturing Company, Inc.				
Steel and Alloy Fabrication				
126" I.D. HASTELLOY C-276				
STEP 6 PRODUCT TANK DETAILS				
TAG NO. T-17030				
SCALE	MADE	CKD	DATE	DRAWING
AS SHOWN	RED	GH	12-11-97	D-97095-1

**MANUFACTURER'S PARTIAL DATA REPORT (ALTERNATIVE FORM)**  
**A Part of a Pressure Vessel Fabricated by One Manufacturer for Another Manufacturer**  
**As Required by the Provisions of the ASME Code Rules, Section VIII, Division 1**

1. Manufactured and certified by Trinity Industries Inc. Head Division 11861 Mosteller Rd. Cinti, OH 45241  
 2. Manufactured for HAYNES INTL, 12241 FM 529, HOUSTON TX 77041-2805, PO# 1072243  
 3. Location of installation Unknown  
 4. Type: ASME (2PC) HEADS 126" ID X .3125 NOM THK  
 (Name and address of Manufacturer) (Name and address of Purchaser) (Name and address) (Mfg's serial No.) (CRN) **#93533**

5. ASME Code, Section VIII, Div. 1 1995 Edition 1996 ADD (Drawing No.) (Drawing prepared by) (Year built) 1997  
 6. Shell (a) No. of course(s): \_\_\_\_\_ (b) Overall length (ft & in.): \_\_\_\_\_  
 Code Case No. \_\_\_\_\_ Special Service per UG-120(d) \_\_\_\_\_

Course(s)			Material		Thickness		Long. Joint (Cat. A)			Circum. Joint (Cat. A, B, & C)			Heat Treatment	
No.	Diameter, in.	Length, ft & in.	Spec./Grade or Type	Nom.	Corr.	Type	Full, Spot, None	Ell.	Type	Full, Spot, None	Ell.	Temp.	Time	

7. Heads: (a) SB 575 HAST C276, UNS# N10276 (b) \_\_\_\_\_  
 (Mat'l Spec. No., Grade or Type) H.T. - Time & Temp. (Mat'l Spec. No., Grade or Type) H.T. - Time & Temp.

Location (Top, Bottom, End)	Thickness		Radius		Elliptical Ratio	Conical Apex Angle	Hemispherical Radius	Flat Diameter	Side to Pressure		Category A		
	Min.	Corr.	Crown	Knuckle					Convex	Concave	Type	Full, Spot, None	Ell.
(a)	.298		120	8.0							1	FULL	
(b)													

If removable, bolts used (describe other fastening) \_\_\_\_\_

8. MAWP \_\_\_\_\_ (Internal) \_\_\_\_\_ (external) psi at max. temp. \_\_\_\_\_ (Internal) \_\_\_\_\_ (external) °F. Min. design metal temp. \_\_\_\_\_ °F at \_\_\_\_\_ psi.  
 (Mat'l Spec. No., Grade, Size, No.)

9. Impact test \_\_\_\_\_  
 (Indicate yes or no and the component(s) impact tested)

10. Hydro., pneu., or comb. test press. \_\_\_\_\_ Proof test \_\_\_\_\_

11. Nozzles, inspection, and safety valve openings:

Purpose (Inlet, Outlet, Drain, etc.)	No.	Diameter or Size	Flange Type	Material		Nozzle Thickness		Reinforcement Material	How Attached		Location (Insp. Open.)
				Nozzle	Flange	Nom.	Corr.		Nozzle	Flange	

12. Supports: Skirt \_\_\_\_\_ Lugs \_\_\_\_\_ (Yes or no) \_\_\_\_\_ (No.) \_\_\_\_\_ Legs \_\_\_\_\_ (No.) \_\_\_\_\_ Others \_\_\_\_\_ (Describe) \_\_\_\_\_ Attached \_\_\_\_\_ (Where and how)

13. Remarks: No design functions performed by Trinity Industries Inc. Head Division  
Customer is responsible for specifying minimum design metal temp.

**CERTIFICATE OF SHOP/FIELD COMPLIANCE**

We certify that the statements made in this report are correct and that all details of material, construction, and workmanship of this pressure vessel part conform to the ASME Code for Pressure Vessels, Section VIII, Division 1.  
 U Certificate of Authorization No. 25,479 Expires March 25 2000  
 Date 12-22-97 Name Trinity Industries Inc. Head Division Signed \_\_\_\_\_  
 (Manufacturer) (Representative)

**CERTIFICATE OF SHOP/FIELD INSPECTION**

I, the undersigned, holding a valid commission issued by the National Board of Boiler and Pressure Vessel Inspectors and/or the State or Province of Ohio and employed by Commercial Union Insurance Companies of Boston, MA have inspected the pressure vessel part described in this Manufacturer's Data Report on 12-22, 19 97, and state that, to the best of my knowledge and belief, the Manufacturer has constructed this pressure vessel part in accordance with ASME Code, Section VIII, Division 1. By signing this certificate neither the Inspector nor his employer makes any warranty, expressed or implied, concerning the pressure vessel part described in this Manufacturer's Data Report. Furthermore, neither the Inspector nor his employer shall be liable in any manner for any personal injury or property damage or a loss of any kind arising from or connected with this inspection.  
 Date 12-22-97 Signed \_\_\_\_\_ Commissions \_\_\_\_\_  
 (Authorized Inspector) (Not'l Board Incl. endorsement, State, Province and No.)

1. Manufactured and certified by ROBEN MFG. CO., INC. 760 Vassar Ave., Lakewood NJ, 08701  
(Name and address of Manufacturer)

2. Manufactured for FMC CORPORATION 1701 E. PATAPSCO AVE. BALTIMORE MD.  
(Name and address of Purchaser)

3. Location of Installation FMC CORPORATION 1701 E. PATAPSCO AVE. BALTIMORE MD.  
(Name and address)

#93533

4. Type: Vertical Jacketed Tank  
(Horiz., vert., or sphere) (Tank, separator, jkt. vessel, heat exh., etc.)  
5. ASME Code, Section VIII, Div. 1 1995, A96 Edition and Addenda (date)  
Code Case No. 97095 (Mfg's serial No.) (CRN) D-97095 REV B (Drawing No.)  
9391 (Nat'l Bd. No.) 199 (Year bl.)

Items 6 - 11 Incl. to be completed for single wall vessels, jackets of jacketed vessels, shell of heat exchangers, or chamber of multi-chamber vessels.  
6. Shell (a) No. of course(s): 3 (b) Overall length (ft & in.): 691'-10 7/8" Special Service per UG-120(d)

No.	Course(s)		Material Spec./Grade or Type	Thickness		Long Joint (Cat. A)			Circum. Joint (Cat. A, B & C)			Heat Treatment					
	Diameter, in.	Length (ft. & in.)		Nom.	Corr.	Type	Full	Spot	None	Eff.	Type	Full	Spot	None	Eff.	Temp.	Time
1	6"	238'-0 1/8"	SB575 C276	.135"	.0312												
1	6"	238'-0 1/8"	SB575 C276	.135"	.0312												
1	6"	215'-10 5/8"	SB575 C276	.135"	.0312												

7. Heads: (a) \_\_\_\_\_ (Mat'l Spec. No., Grade or Type) H.T.-Time & Temp (b) SB575 C276

Location (Top, Bottom, Ends)	Thickness		Radius		Elliptical Ratio	Conical Apex Angle	Hemispherical Radius	Flat Diameter	Side to Pressure		Category A						
	Min.	Corr.	Crown	Knuckle					Convex	Concave	Type	Full	Spot	None	Eff.		
(a)																	
(b)	BTM	.135"	.062"														

If removable, bolts used (describe other fastening)

8. Type of jacket Type 1 & Type 3 130° 3" Half Pipe Coil (Mat'l Spec. No., Grade, size, No.)  
Jacket closure Welded (Describe as oges & weld, bar, etc.)

9. MAWP 90 (internal) -14.7 (external) psi at max. temp. 331 (internal) 331 (external) of Min. design metal temp. 0 of at -14.7 psi  
If bolted, describe or sketch

10. Impact test No as per paragraph UG-20(f), UHA-51, UCS-66 & UNF-65  
(Indicate yes or no and the component(s) impact tested)

11. Hydro., pneu., or comb. test press. 140  
Items 12 and 13 to be completed for tube sections. Proof test \_\_\_\_\_

12. Tubesheet:  
Stationary (Mat'l Spec. No.) \_\_\_\_\_ Dia., in. (subject to press.) \_\_\_\_\_ Norm. thk., in. \_\_\_\_\_ Corr. Allow., in. \_\_\_\_\_ Attachment (welded or bolted) \_\_\_\_\_  
Floating (Mat'l Spec. No.) \_\_\_\_\_ O.D., in. \_\_\_\_\_ Norm. thk., in. or gauge \_\_\_\_\_ Corr. Allow., in. \_\_\_\_\_ Attachment \_\_\_\_\_

13. Tubes:  
Mat'l Spec. No., Grade or Type \_\_\_\_\_ O.D., in. \_\_\_\_\_ Norm. thk., in. or gauge \_\_\_\_\_ Corr. Allow., in. \_\_\_\_\_ Attachment \_\_\_\_\_  
Items 14 - 18 Incl. to be completed for inner chambers of jacketed vessels or channels of heat exchangers.

14. Shell (a) No. of course(s): 2 (b) Overall length (ft & in.): 14'-9" Type (Straight or U)

No.	Course(s)		Material Spec./Grade or Type	Thickness		Long Joint (Cat. A)			Circum. Joint (Cat. A, B & C)			Heat Treatment					
	Diameter, in.	Length (ft. & in.)		Nom.	Corr.	Type	Full	Spot	None	Eff.	Type	Full	Spot	None	Eff.	Temp.	Time
1	10'-6"	7'-4 1/4"	SB575 C276	.3125"	.0312												
1	10'-6"	7'-4 3/4"	SB575 C276	.3125"	.0312	1	Spot	85%	1	None	70%	-	-				
						1	Spot	85%	1	None	70%	-	-				

5. Heads: (a) SB575 C276 (Mat'l Spec. No., Grade or Type) H.T.-Time & Temp (b) SB575 C276

Location (Top, Bottom, Ends)	Thickness		Radius		Elliptical Ratio	Conical Apex Angle	Hemispherical Radius	Flat Diameter	Side to Pressure		Category A						
	Min.	Corr.	Crown	Knuckle					Convex	Concave	Type	Full	Spot	None	Eff.		
Top	.2198"	.062"	120"	8"													
Bottom	.2802"	.062"	120"	8"													

If removable, bolts used (describe other fastening)

(Mat'l Spec. No., Grade, Size, No.)

(Internal) -2.5 psi at max. temp. 331 (Internal) 331 (external) of Min. design metal temp. 0 °F at -2.5/25 ps

7. Impact test No. as per paragraph UG-20(f), UCS-66(a) & UHA-51

3. Hydro., pneu., or comb. test press. 40 (Indicate yes or no and the component(s) Impact tested)

9. Nozzles, inspection, and safety valve openings: Proof test

Purpose (inlet, outlet, Drain, etc.)	No.	Diameter or Size	Flange Type	Material		Nozzle Thickness		Reinforcement Material	How Attached		Location (Insp. Open)
				Nozzle	Flange	Nom.	Corr.		Nozzle	Flange	
Cond. Return	1	4"	Flange	SB619 C276	SA105	.237"	.0312	None	UW16.1(d)	Fig2-4(1)	
Dip Pipe	1	1 1/2"	Flange	SB619 C276	SA105	.145"	.0312	None	UW16.1(d)	Fig2-4(1)	
Inlet	1	4"	Flange	SB619 C276	SA105	.237"	.0312	None	UW16.1(d)	Fig2-4(1)	
Dip Pipe	1	3"	Flange	SB619 C276	SA105	.216"	.0312	None	UW16.1(d)	Fig2-4(1)	
Relief/Vent	1	8"	Flange	SB575 C276	SA105	.25"	.0312	None	UW16.1(d)	Fig2-4(1)	
Agitator	1	12"	Flange	SB575 C276	*SA105	.25"	.0312	SA240 T316L	UW16.1(d)	Fig2-4(8a)	Head
Manway	1	24"	Flange	SB575 C276	*SA105	.25"	.0312	SA240 T316L	UW16.1(d)	Fig2-4(8a)	Head

0. Supports: Skirt No (Yes or No) Lugs 2 (No.) Legs      (No.) Others      (No.) Attached      (Describe) Welded to Shell      (Where and How)

1. Manufacturer's Partial Data Reports properly identified and signed by Commissioned Inspectors have been furnished for the following items of the report:  
(List the name of part, item number, mfg's. name and identifying number)

Top Head 2-25906-1 Trinity Industries Inc. "U" 25.479.

Btm Head 2-24941-1 Trinity Industries Inc. "U" 25.479.

2. Remarks: Unit will be used as 126" ID Hastelloy C276 Step 6 product tank. Non-lethal service. Bottom head installed with 130° Half Coil 6" SCH10 SB619 C276 on 7 1/4" center. Total running feet 71'-6".

\*Agitator & Manway flanges clad with SB575 C276.

**CERTIFICATE OF SHOP COMPLIANCE**

We certify that the statements made in this report are correct and that all details of design, material, construction, and workmanship of this vessel conform to the ASME Code for Pressure Vessels, Section VIII, Division 1, Certificate of Authorization No. 24,584

Date JUN 09 1998 Expires 1/5, 19 99  
Name ROBEN MFG. CO., INC. (Manufacturer) Signed Ashish Mathur (Representative)

**CERTIFICATE OF SHOP INSPECTION**

I, the undersigned, holding a valid commission issued by The National Board of Boiler and Pressure Vessel Inspectors and the State or Province of NJ and employed by KEMPER INSURANCE COMPANIES of LONG GROVE, IL have inspected the pressure vessel described in this Manufacturer's Data Report on JUN 09 1998 and state that, to the best of my knowledge and belief, the manufacturer has constructed this pressure vessel in accordance with ASME Code, Section VIII, Division 1. By signing this certificate neither the inspector nor his employer makes any warranty, expressed or implied, concerning the pressure vessel described in this Manufacturer's Data Report. Furthermore, neither the inspector nor his employer shall be liable in any manner for any personal injury or property damage or a loss of any kind arising from or connected with this inspection.

Date JUN 09 1998 Signed [Signature] (Authorized Inspector) Commissions NB 7050AB, NJ 476 (Nat'l Board incl. endorsement, State, Province and No.)

**CERTIFICATE OF FIELD ASSEMBLY COMPLIANCE**

We certify that the statements on this report are correct and that the field assembly construction of all parts of this vessel conforms with the requirements of ASME Code, Section VIII, Division 1, Certificate of Authorization No.     

Date      Expires     , 19       
Name      (Assembler) Signed      (Representative)

**CERTIFICATE OF FIELD ASSEMBLY INSPECTION**

I, the undersigned, holding a valid commission issued by The National Board of Boiler and Pressure Vessel Inspectors and the State or Province of      and employed by      of      compared the statements in this Manufacturer's Data Report with the described pressure vessel and state that parts referred to as data items      not included in the certificate of shop inspection, have been inspected by me and to the best of my knowledge and belief, the Manufacturer has constructed and assembled this pressure vessel in accordance with ASME Code, Section VIII, Division 1. The described vessel inspected and subjected to a hydrostatic test of      psi. By signing this certificate neither the inspector nor his employer makes any warranty, expressed or implied, concerning the pressure vessel described in this Manufacturer's Data Report. Furthermore, neither the inspector nor his employer shall be liable in any manner for any personal injury or property damage or a loss of any kind arising from or connected with this inspection.

Date      Signed      (Authorized Inspector) Commissions      (Nat'l Board incl. endorsement, State, Province and No.)

Manufactured and certified by ROBEN MFG. CO., INC. 760 Vassar Ave., Lakewood, NJ, 08701  
(name and address of manufacturer)

Manufactured for FMC CORPORATION 1701 E. PATAPSCO AVE. BALTIMORE MD.  
(name and address of purchaser)

Location of installation FMC CORPORATION 1701 E. PATAPSCO AVE. BALTIMORE MD.  
(name and address)

Type: Vertical Jacketed Tank 97095  
(horiz., vert., or sphere) (tank, separator, heat exh., etc.) (mfg's serial no.)

(CRN) D-97095 REV B 9391 1998  
(drawing no.) (Nat'l. Bd. no.) (year built)

*\* 935 33*

PURPOSE	Remarks						
	NO DIA	FLANGE TYPE	MATERIAL NOZZLE / FLANGE	NOZZLE TK NOM / CORR	R MATL	HOW ATTACHED NOZZLE / FLANGE	
Cons Vent	1 2"	Flange	SB622 C276 SA105	.218" .0312"	None	UW16.1(d)	Fig2-4(1)
Level Sw	1 1 1/2"	Flange	SB622 C276 SA105	.200" .0312"	None	UW16.1(d)	Fig2-4(1)
Spare	1 1 1/2"	Flange	SB622 C276 SA105	.200" .0312"	None	UW16.1(d)	Fig2-4(1)
Temp Trans	1 1 1/2"	Flange	SB622 C276 SA105	.200" .0312"	None	UW16.1(d)	Fig2-4(1)
Level Trans	1 3"	Flange	SB622 C276 SA105	.300" .0312"	None	UW16.1(d)	Fig2-4(1)
Stm Outlet	1 4"	Flange	SB622 C276 SA105	.337" .0312"	None	UW16.1(d)	Fig2-4(1)
Jacket Inlet	4 1 1/2"	Flange	SB619 C276 SA105	.109" .0312"	None	UW16.1(d)	Fig2-4(1)
Jacket Outlet	4 1 1/2"	Flange	SB619 C276 SA105	.109" .0312"	None	UW16.1(d)	Fig2-4(1)
Recirc	1 3"	Flange	SB619 C276 SA105	.216" .0312"	None	UW16.1(d)	Fig2-4(1)
Dip Pipe	1 2"	Flange	SB619 C276 SA105	.154" .0312"	None	UW16.1(d)	Fig2-4(1)
Spare	1 3"	Flange	SB619 C276 SA105	.216" .0312"	None	UW16.1(d)	Fig2-4(1)
Level Indicator	1 6"	Flange	SB575 C276 SA105	.25" .0312"	None	UW16.1(d)	Fig2-4(1)

Certificate of Authorization: Type "U" No. 24,584 Expires 1/5/99, 1998

Name ROBEN MFG. CO., INC. (manufacturer) Signed Abhishek Mathur (representative)

Name [Signature] (Authorized Inspector) Commission NB 7050AB, NJ 476 (Nat'l. Board Incl. endorsement, state, province and no.)

JUN 09 1998  
 JUN 09 1998

# LIGHTNIN

## A UNIT OF GENERAL SIGNAL

ALL EQUIPMENT DESIGN AND APPLICATION DATA SHOWN HEREIN AND RELATED KNOW-HOW ARE CONFIDENTIAL AND THE PROPERTY OF LIGHTNIN. NO USE OR DISCLOSURE THEREOF MAY BE MADE WITHOUT WRITTEN PERMISSION.

DWG. NO.: E25682A REV.:  $\Delta$

CUSTOMER: JOHN BROWN E & C



P.O. NO.: JB94037-26.01

TAG NO.: G-17030



DRN. BY: AMG

DATE: 2-8-95

### INSTALLATION DATA FOR MODEL 74S10

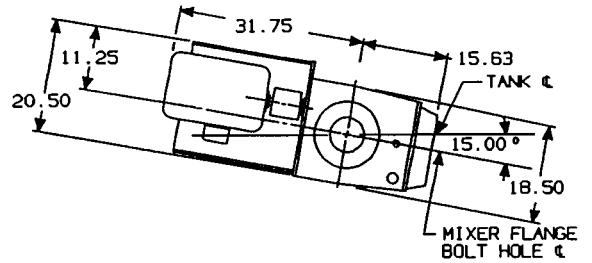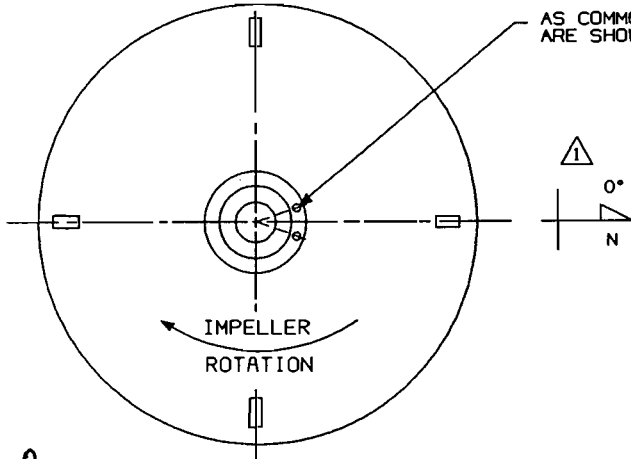

#93533

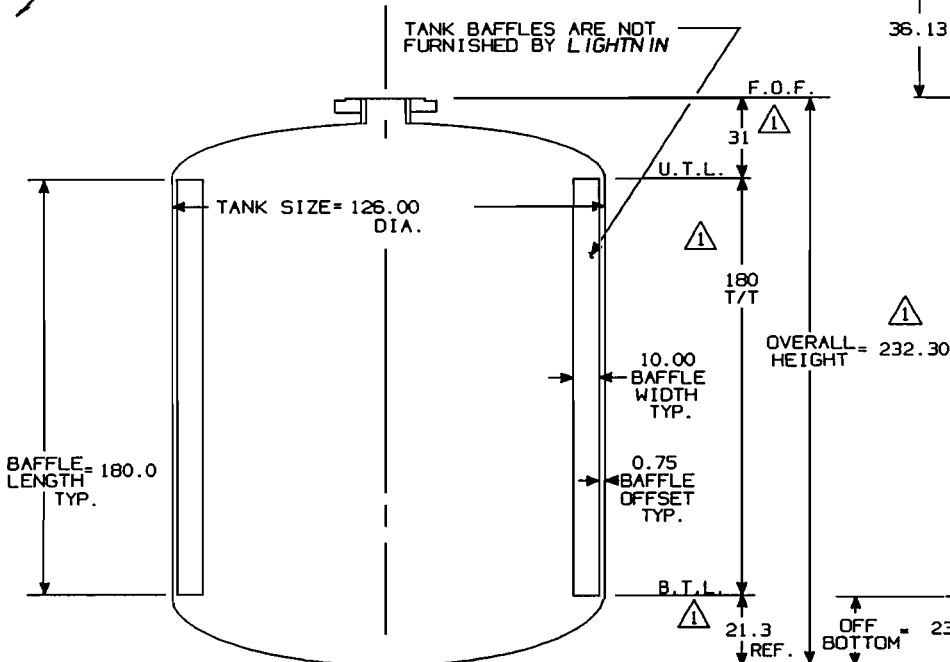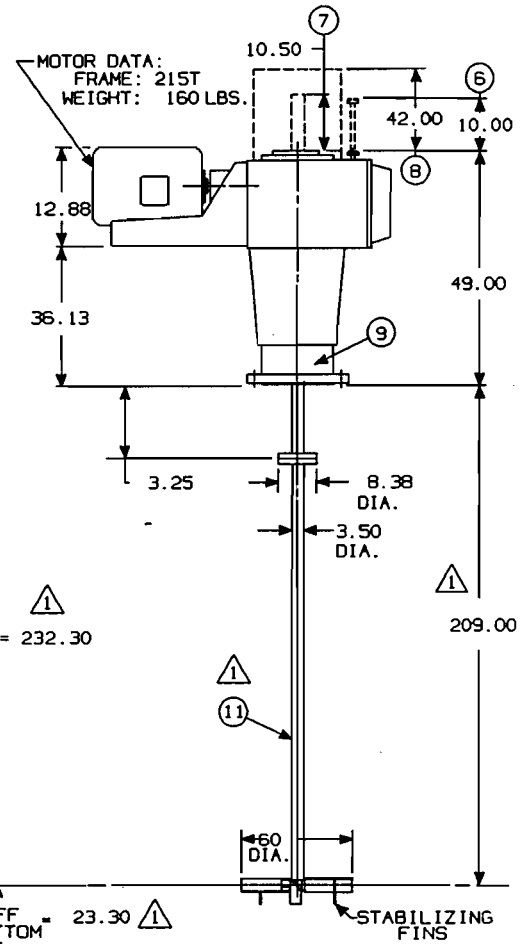

NOZZLE DESIGN DATA	IMPELLER DATA	NOTES
VERTICAL DOWNWARD LOAD (POUNDS): 4,900  TORQUE (INCH-LBS.): 20,700  BENDING MOMENT (INCH-LBS.): 48,400  DESIGN LOADS ARE GREATER THAN ACTUAL LOADS BY A SUITABLE FACTOR, CONSISTENT WITH CONSTRUCTION CODES AND LIGHTNIN EXPERIENCE.	TYPE: A200 RPM: 46 QUANTITY OF BLADES: 4 LOWER IMPELLER IS REMOVABLE, BUT NOT ADJUSTABLE.	1. REFER TO INSTRUCTIONS FOR START-UP AND MAINTENANCE PROCEDURES, AND SAFE LIFTING PRACTICES. 2. ALL DIMENSIONS ARE IN INCHES. 3. MATERIAL OF MIXER PARTS IN THE TANK IS 316L UNLESS OTHERWISE SPECIFIED. 4. TOTAL MIXER WEIGHT (LESS MOTOR) 2148 POUNDS. 5. TANK MUST HAVE MINIMUM OPENING SIZE OF 13.75 DIAMETER TO PASS DISASSEMBLED MIXER PARTS. 6. CLEARANCE REQUIRED FOR DIPSTICK REMOVAL. 7. CLEARANCE REQUIRED ABOVE MIXER AND ABOVE IMPELLER(S) TO PERMIT REMOVAL OF SEAL CARTRIDGE. 8. CLEARANCE REQUIRED FOR PULLER ASSEMBLY (OPTIONAL) 9. MECHANICAL SEAL: PER DWG: L-16628 STYLE: C CODE: SPECIAL INLET & OUTLET CONNECTIONS TO SEAL LUBRICANT 1/8 NPT - COOLANT 1/4 NPT. 10. UNIT IS FURNISHED WITH A TYPE 4A, DEAD END LUBRICATOR REFER TO L-16841. 11. THE LOWER 72" OF SHAFT IS STEPPED TO 2.5" DIAMETER.
WARRANTIES AND GUARANTEES APPLY FOR THOSE ITEMS FURNISHED BY LIGHTNIN. ALL OTHER EQUIPMENT AND DESIGNS ARE THE RESPONSIBILITY OF OTHERS.		
UNIT MOUNTING FLANGE DATA LB. ANSI (ASA) SERIES DRILLING SIZE: 12 O.D.: 19.00 NO. OF EQUI-SPACED BOLTS: 12 B.C.: 17.00 FLANGE THICKNESS FOR BOLTING: 3.50 BOLT DIA: .88 (MOUNTING BOLTS NOT FURNISHED BY LIGHTNIN)		

PLATE 5102E

© 1980

**LIGHTNIN**

P.O. BOX 1370 • 135 MT. READ BULD. • ROCHESTER N.Y. 14603  
A UNIT OF GENERAL SIGNAL

**LIGHTNIN**

MIXERS AND AERATORS

<b>SOLD TO</b> BROWN JOHN C/O FMC CORP P O BOX 2879  BALTIMORE MD 21225	<b>SHIP TO</b> TO FOLLOW     <div style="text-align: right; font-size: 2em; font-family: cursive;">#93533</div>
---	--

<b>PURCHASE ORDER NO.</b> JB94037-26.01	<b>CUSTOMER REF NO.</b> G-17030
--	------------------------------------

**CHANGE ORDER** DELY WAS 16WKS ADA, SHAFT LENGTH, IMPELLER OFF BOTTOM, TANK OAH

**TAG** PLEASE REFER TO THE FOLLOWING PAGE FOR TAGGING INFORMATION.

<b>QTY</b> 001	<b>MODEL</b> 74-S-10	<b>UNIT SIZE</b> 74	<b>LIGHTNIN ORDER NO.</b> E25682
	<b>SERIAL NO.</b> 95E2568201	<b>EXACT RATIO</b> 38.2	<b>CHANGE DATE</b> 05/02/95 <b>CHANGE ORDER NO.</b> 4

<b>MOTOR OR DRIVE</b>	<b>DESCRIPTION</b> RELIANCE HI-EFF S.D.			<b>FRAME SIZE</b> 215T	<b>HORSEPOWER</b> 10	<b>RPM</b> 1750	<b>VOLTS</b> 460
	<b>CYCLE</b> 60	<b>PHASE</b> 3	<b>SERVICE FACTOR</b> 1.15	<b>ENCLOSURE</b> TEFC	<b>FURNISHED BY</b> LIGHTNIN	<b>MOUNTED BY</b> LIGHTNIN	

**WETTED PARTS** STAINLESS STEEL - 316L OF UNIT C

<b>IN TANK SHAFT</b>	<b>DIAMETER</b> 3.5/2.5 in	<b>LENGTH FROM MOUNTING BASE</b> 209 in	<b>COUPLING TYPE</b> RIGID BELOW BASE			
<b>IMPELLER</b>	<b>UPPER DIAMETER</b>	<b>TYPE</b>	<b>NO OF BLADES</b>	<b>HUB CONSTRUCTION</b>	<b>DISC CONSTRUCTION</b>	
	<b>MIDDLE DIAMETER</b>	<b>TYPE</b>	<b>NO OF BLADES</b>	<b>HUB CONSTRUCTION</b>	<b>DISC CONSTRUCTION</b>	
	<b>LOWER DIAMETER</b> 60.00in	<b>TYPE</b> A200	<b>NO OF BLADES</b> 4P	<b>HUB CONSTRUCTION</b> STD	<b>DISC CONSTRUCTION</b>	<b>STABILIZER FINS</b>
	<b>NOMINAL SPEED</b> 46.0	<b>OFF BOTTOM</b> 23.30in		<b>SPACING</b>		

<b>SHAFT SEAL</b>	<b>ANSI FLANGE SIZE</b> 12 in	<b>CLASS</b> 150	<b>PRESSURE</b> 14PSI	<b>TEMPERATURE</b> 166C	<b>PACKING TYPE</b>
	<b>SEAL TYPE</b> C SPECIAL			<b>STUFFING BOX</b>	

<b>OPTIONAL EQUIP.</b>	<b>LUBRICATION</b> TYPE 4A	<b>PULLER</b>	<b>STEADY BEARING TYPE</b>	<b>BUSHING MATERIAL</b>
------------------------	----------------------------	---------------	----------------------------	-------------------------

<b>INSTALL DATA</b>	<b>TANK SHAPE</b> ROUND	<b>DIA/SIZE</b> 126.00 in	<b>MIXER MOUNTING</b> VERTICAL (ON CENTER)
---------------------	-------------------------	---------------------------	--

<b>TANK DATA</b>	<b>NOZZLE/BEAM HEIGHT</b> 10.00 in	<b>TOP</b> 21.00in	<b>BOTTOM</b> 21.30in	<b>OVERALL HEIGHT</b> 232.30in
	<b>BAFFLES REQUIRED</b> YES	<b>QUANTITY</b> 4	<b>OFF WALL DISTANCE</b> .75in	<b>WIDTH</b> 10.00in

**DRAWING DATA**

**OTHER DATA** PEDESTAL MTD. TUNGSTEN CARBIDE STAT. SEAL FACE, DEAD END LUBRICATOR MTR. PER SPEC.