

**FORM U-1A MANUFACTURER'S DATA REPORT FOR PRESSURE VESSELS**  
 (Alternative Form for Single Chamber, Completely Shop-Fabricated Vessels Only)  
 As Required by the Provisions of the ASME Code Rules, Section VIII, Division 1

1. Manufactured and certified by WARD TANK CORPORATION, 6670 EAST HARRIS BLVD., CHARLOTTE, NC 28215 #93874  
 (Name and address of manufacturer)

Manufactured for FMC Corp., 440 Route 22 East, Bridgewater, NJ 08807  
 (Name and address of purchaser)

3. Location of installation FMC Corp., 1701 East Patapsco Ave., Baltimore, MD 21226  
 (Name and address)

4. Type Horizontal W-2751 N/A 94-W-2751 1278 1995  
 (Horiz. or vert. tank) (Mfg's serial No.) (CRN) (Drawing no.) (Nat'l Bd. No.) (Year built)

5. The chemical and physical properties of all parts meet the requirements of material specifications of the ASME BOILER AND PRESSURE VESSEL CODE. The design, construction, and workmanship conform to ASME Rules, Section VIII, Division 1 1992  
 Year

to 1993 N/A N/A  
 Addenda (Date) Code Case Nos. Special Service per UG 120(d)

6. Shell: SA-240 Ty 304L 1/2" 1/32" 8'-5" 14'-3"  
 Mat'l. (Spec. No., Grade) Nom. Thk. (in.) Corr. Allow. (in.) Diam. I.D. (ft. & in.) Length (overall) (ft. & in.)

7. Seams: 1 Spot 85 N/A N/A 1 Spot 2  
 Long. (Welded, Dbl., Sngl., Lap, Butt) R.T. (Spot or Full) Eff. (%) H.T. Temp (F) Time (hr) Girth (welded, Dbl., Sngl., Lap, Butt) R.T. (Spot, Partial, or Full) No. of Courses

8. Heads: (a) Mat'l. SA-240 Ty 304L (b) Mat'l. \_\_\_\_\_  
 (Spec No., Grade) (Spec No., Grade)

	Location (Top, Bottom, Ends)	Minimum Thickness	Corrosion Allowance	Crown Radius	Knuckle Radius	Elliptical Ratio	Conical Apex Angle	Hemispherical Radius	Flat Diameter	Side to Pressure Convex or Concave
(a)	Ends	3/8"	1/32"	102"	6.5"	---	---	---	---	Concave
(b)										

If removable, bolts used (describe other fastenings) N/A  
 (Mat'l., Spec. No., Gr., Size, No.)

9. MAWP 15 & FV. 230 psi at max. temp. \_\_\_\_\_ ° F  
 Min. design metal temp. -20 ° F at 15 psi Hydro., 230 or 230 test pressure 23 PSI psi

10. Inspection and safety valve openings:

Purpose (Inlet, Outlet, Drain)	No.	Diam. or Size	Type	Mat'l.	Nom. Thk.	Reinforcement Mat'l.	How Attached	Location
Manway	2	24"	Cl-150 LJ	SA-240 Ty 304L	1/2"	None	Welded	Shell
Process	7	1 1/2"-2"	Cl-150 LJ	SA-312 Ty TP304L WLD	S80	None	Welded	
Process	4	3'-4"	Cl-150 LJ	SA-312 Ty TP304L WLD	S40s	None	Welded	

11. Supports: Skirt No Lugs --- Legs --- Other (2) Saddles Attached --- Welded to Shell ---  
 (Yes or no) (No.) (No.) (Describe) (Where and how)

12. Remarks: Manufacturer's Partial Data Reports properly identified and signed by Commissioned Inspectors have been furnished for the following items of this report: (2) 102"OD. Heads; SR# 9573881 & 9573882 ; Enerfab Corp.

(Name of part, item number, Mfg's name and identifying stamp)

The Customer is responsible for the pressure relief device per UG 125 F.N. 39.

Customer P.O.No.-JB-94037-11.05 ; Customer Equip.No.-T-15070

Impact test exempt per UHA-51(c) & UCS-66(a) (1) (b) & (c).

**CERTIFICATE OF SHOP COMPLIANCE**

We certify that the statements made in this report are correct and that all details of design, material, construction, and workmanship of this vessel conform to the ASME Code for Pressure Vessels, Section VIII, Division 1. "U" Certificate of Authorization No. 18,365 expires 2-17 19 96

Date 6-28-95 Co. Name WARD TANK CORPORATION Signed [Signature]  
 (Manufacturer) (Representative)

**CERTIFICATE OF SHOP INSPECTION**

Vessel constructed by WARD TANK CORPORATION at CHARLOTTE, NC 28215

I, the undersigned, holding a valid commission issued by The National Board of Boiler and Pressure Vessel Inspectors and the State or Province of NC and employed by NC. Department of Labor Raleigh, NC. have inspected

the component described in this Manufacturer's Data Report on 6-28, 19 95, and state that, to the best of my knowledge and belief, the manufacturer has constructed this pressure vessel in accordance with ASME Code, Section VIII, Division 1. By signing this certificate neither the inspector nor his employer makes any warranty, expressed or implied, concerning the pressure vessel described in this Manufacturer's Data Report. Furthermore, neither the inspector nor his employer shall be liable in any manner for any personal injury or property damage or a loss of any kind arising from or connected with this inspection.

Date 6-28-95 Signed [Signature] Commissions NB 10508(B,A), NC 1230  
 (Authorized Inspector) (Nat'l Board (incl. endorsements) State, Prov. and No.)

**FORM U-2A MANUFACTURER'S PARTIAL DATA REPORT (ALTERNATIVE FORM)  
A Part of a Pressure Vessel Fabricated by One Manufacturer for Another Manufacturer  
As Required by the Provisions of the ASME Code Rules, Section VIII, Division 1**

Manufactured and certified by Enerfab, Inc. 4955 Spring Grove Avenue Cincinnati, Ohio 45232  
(Name and address of Manufacturer)

2. Manufactured for Ward Tank Corporation P.O. Box 560066 Charlotte, NC 28256-0066  
(Name and address of Purchaser)

3. Location of installation Unknown  
(Name and address)

4. Type: ASME Flanged & Dished Head 9573882  
(Description of vessel part (shell, two-piece head, tube bundle)) (Mfg's serial No.)  
 -- 957388 Enerfab, Inc. 1995  
 (Mfrl. Bd. No.) (Drawing No.) (Drawing prepared by) (Year built)

5. ASME Code, Section VIII, Div. 1 1992 Edition Dec. 1993 Addenda -- --  
 Edition and Addenda (date) Code Case No. Special Service per UG-120(d)

6. Shell (a) No. of course(s): --- (b) Overall length (ft & in.): ---

*93874*

Course(s)			Material		Thickness		Long Joint (Cat. A)			Circum. Joint (Cat. A, B & C)			Heat Treatment	
No.	Diameter, in.	Length (ft & in.)	Spec./Grade or Type	Nom.	Corr.	Type	Full, Spot, None	Eff.	Type	Full, Spot, None	Eff.	Temp.	Tim	
-													--	
-													--	
-													--	

7. Heads: (a) SA240 304L -- (b) ---  
 (Mfrl Spec. No., Grade or Type) H.T. - Time & Temp (Mfrl Spec. No., Grade or Type) H.T. - Time & Temp

Location (Top, Bottom, Ends)	Thickness		Radius		Elliptical Ratio	Conical Apex Angle	Hemispherical Radius	Flat Diameter	Side to Pressure		Category A	
	Min.	Corr.	Crown	Knuckle					Convex	Concave	Type	Full, Spot, None
(a) <u>Unknown</u>	<u>.47"</u>	<u>Unk</u>	<u>102."</u>	<u>6.5"</u>							<u>1</u>	<u>Full</u>
(b)												

If removable, bolts used (describe other fastening) ---

8. MAWP -- -- psi at max. temp. -- -- °F Min. design metal temp. -- °F at --  
 (internal) (external) (internal) (external)

Impact test ---  
 (Indicate yes or no and the component(s) impact tested)

10. Hydro., pneu., or comb. test press. --- Proof test ---

11. Nozzles, inspection, and safety valve openings:

Purpose (Inlet, Outlet, Drain, etc.)	No.	Diameter or Size	Flange Type	Material		Nozzle Thickness		Reinforcement Material	How Attached		Location (Insp. Op)
				Nozzle	Flange	Nom.	Corr.		Nozzle	Flange	
---											
---											
---											
---											

12. Supports: Skirt --- Lugs -- Legs -- Others --- Attached ---  
 (Yes or No) (No.) (No.) (Describe) (Where and How)

13. Remarks No design function performed by Enerfab, Inc.  
7. 102."OD

**CERTIFICATE OF SHOP/FIELD COMPLIANCE**

We certify that the statements made in this report are correct and that all details of material, construction, and workmanship of this pressure vessel part conform to the ASME Code for Pressure Vessels, Section VIII, Division 1.

U Certificate of Authorization No. 2631 Expires December 31, 19 97  
 Date 2-7-95 Name Enerfab, Inc. Signed Don Cox  
 (Manufacturer) (Representative)

**CERTIFICATE OF SHOP/FIELD INSPECTION**

I, the undersigned, holding a valid commission issued by The National Board of Boiler and Pressure Vessel Inspectors and the State or Province of Ohio and employed by Hartford Steam Boiler Inspection & Insurance Co. of Hartford, CT have inspected the

pressure vessel part described in this Manufacturer's Data Report on 2-7, 19 95, and state that, to the best of my knowledge and belief, the Manufacturer has constructed this pressure vessel part in accordance with ASME Code, Section VIII, Division 1. By signing this certificate neither the Inspector nor employer makes any warranty, expressed or implied, concerning the pressure vessel part described in this Manufacturer's Data Report. Furthermore, neither the inspector nor his employer shall be liable in any manner for any personal injury or property damage or a loss of any kind arising from or connected with this inspection.  
 Date 2-7-95 Signed [Signature] Commissions [Signature]  
 (Authorized Inspector) (Natl Board Incl. endorsement, State, Province and No.)

**FORM U-2A MANUFACTURER'S PARTIAL DATA REPORT (ALTERNATIVE FORM)**  
**A Part of a Pressure Vessel Fabricated by One Manufacturer for Another Manufacturer**  
**As Required by the Provisions of the ASME Code Rules, Section VIII, Division 1**

Manufactured and certified by Enerfab, Inc. 4955 Spring Grove Avenue Cincinnati, Ohio 45232  
(Name and address of Manufacturer)  
 Manufactured for Ward Tank Corporation P.O. Box 560066 Charlotte, NC 28256-0066  
(Name and address of Purchaser)

3. Location of installation Unknown  
(Name and address)  
 4. Type: ASME Flanged & Dished Head 957388 1  
(Description of vessel part (shell, two-piece head, tube bundle)) (Mfg's serial No.)  
957388 Enerfab, Inc. 1995  
(Natl. Bd. No.) (Drawing No.) (Drawing prepared by) (CRN) (Year built)  
 5. ASME Code, Section VIII, Div. 1 1992 Edition Dec. 1993 Addenda  
Edition and Addenda (date) Code Case No. Special Service per UG-120(d)  
 6. Shell (a) No. of course(s): --- (b) Overall length (ft & in.): ---

Course(s)			Material		Thickness		Long Joint (Cat. A)			Circum. Joint (Cat. A, B & C)			Heat Treatment	
No.	Diameter, in.	Length (ft & in.)	Spec./Grade or Type		Nom.	Corr.	Type	Full, Spot, None	Eff.	Type	Full, Spot, None	Eff.	Temp.	Time
-														--
-														--
-														--

7. Heads: (a) SA240 304L --- (b) ---  
(Natl Spec. No., Grade or Type) H.T. - Time & Temp (Natl Spec. No., Grade or Type) H.T. - Time & Temp

	Location (Top, Bottom, Ends)	Thickness		Radius		Elliptical Ratio	Conical Apex Angle	Hemispherical Radius	Flat Diameter	Side to Pressure		Category A		
		Min.	Corr.	Crown	Knuckle					Convex	Concave	Type	Full, Spot, None	Eff.
(a)	<u>Unknown</u>	<u>.48"</u>	<u>Unk</u>	<u>102."</u>	<u>6.5"</u>							<u>1</u>	<u>Full</u>	<u>--</u>
(b)														

If removable, bolts used (describe other fastening) ---  
(Natl Spec. No., Grade, Size, No.)

8. MAWP --- --- psi at max. temp. --- --- °F Min. design metal temp. --- °F at --- p  
(Internal) (external) (Internal) (external)  
 9. Impact test ---  
(Indicate yes or no and the component(s) impact tested)

10. Hydro., pneu., or comb. test press. --- Proof test ---  
 11. Nozzles, inspection, and safety valve openings:

Purpose (Inlet, Outlet, Drain, etc.)	No.	Diameter or Size	Flange Type	Material		Nozzle Thickness		Reinforcement Material	How Attached		Location (Insp. Open.)
				Nozzle	Flange	Nom.	Corr.		Nozzle	Flange	
---											
---											
---											
---											

12. Supports: Skirt --- Lugs --- Legs --- Others --- Attached ---  
(Yes or No) (No.) (No.) (Describe) (Where and How)

13. Remarks No design function performed by Enerfab, Inc.  
7. 102."OD

**CERTIFICATE OF SHOP/FIELD COMPLIANCE**

We certify that the statements made in this report are correct and that all details of material, construction, and workmanship of this pressure vessel part conform to the ASME Code for Pressure Vessels, Section VIII, Division 1.  
 U Certificate of Authorization No. 2631 Expires December 31, 19 97  
 Date 2-7-95 Name Enerfab, Inc. Signed Jim Cox  
(Manufacturer) (Representative)

**CERTIFICATE OF SHOP/FIELD INSPECTION**

I, the undersigned, holding a valid commission issued by The National Board of Boiler and Pressure Vessel Inspectors and the State or Province of Ohio and employed by Hartford Steam Boiler Inspection & Insurance Co. of Hartford, CT have inspected the pressure vessel part described in this Manufacturer's Data Report on 2-7, 19 95, and state that, to the best of my knowledge and belief, the manufacturer has constructed this pressure vessel part in accordance with ASME Code, Section VIII, Division 1. By signing this certificate neither the inspector nor employer makes any warranty, expressed or implied, concerning the pressure vessel part described in this Manufacturer's Data Report. Furthermore, neither the inspector nor his employer shall be liable in any manner for any personal injury or property damage or a loss of any kind arising from or connected with this inspection.  
 Date 2-7-95 Signed [Signature] Commissions Other Commissions  
(Authorized Inspector) (Natl Board incl. endorsement, State, Province and No.)

#93874

U 1278

W REG IV 15 239

-20 15

23 1995

W-2751

FMC CORPORATION

JB-94037-LL-05 12-12-94

NITRIC ACID STORAGE TANK

T-15070

NOZZLE SCHEDULE												
MK	SIZE	QUAN	NOZZLE FLANGE			NECK		REPAD		PROJ	ORIENT	SERVICE
			TYPE	RATG	MATL	SCH	MATL	THK	O.D.			
A	24"	1	LJ	150#	SA-105	1/2"	304L			8"	0°	MANWAY W/ DAVIT
B	2"	1				80				7"	0°	LEVEL TRANS. W/ 1" DIP
C	1 1/2"	1				80				7"	0°	LEVEL SWITCH
D	3"	1				40				7"	0°	SPARE W/ BLIND
E	1 1/2"	1				80				7"	0°	VENT TO TRUCK
G	3"	1				40				7"	0°	SPARE W/ BLIND
H	2"	1				80				7"	0°	RELIEF
I	2"	1				80				7"	0°	VENT TO SCRUB
J	3"	1				40				7"	0°	PUMP RETURN W/ 1 1/2" DIP
K	24"	1				1/2"				8"	0°	MANWAY W/ DAVIT
L	1 1/2"	1				80			**	**	**	TEMPERATURE
M	2"	1				80				7"	180°	OUTLET
O	4"	1				40				7"	0°	INLET W/ 3" DIP

NOTE: REPAD MATERIAL IS SA-240 304L  
 \*\* SEE DRAWING

DESIGN DATA

DESIGN CONDITIONS:  
 SHELL: FULL VACUUM & 15 Psig @ 239 °F  
 COIL: \_\_\_\_\_ Psig @ \_\_\_\_\_ °F  
 JACKET/TUBE SIDE: \_\_\_\_\_ Psig @ \_\_\_\_\_ °F  
 HYDROSTATIC TEST:  
 SHELL: \_\_\_\_\_ 23 Psig  
 COIL: \_\_\_\_\_ Psig  
 JACKET/TUBE SIDE: \_\_\_\_\_ Psig  
 SPECIFIED CORROSION ALLOWANCE: 1/32"  
 RADIOGRAPHY: SPOT STRESS RELIEF: \_\_\_\_\_  
 MAWP: 15 Psig LIMITED BY: \_\_\_\_\_  
 CODE: A.S.M.E. SECT. VIII, DIV. 1; 1992 A93 STAMP: YES  
 TYPE HEADS:  
 SHELL: A.S.M.E. FLANGED & DISHED  
 JACKET/TUBE SIDE: \_\_\_\_\_  
 JOINT EFFICIENCY: HEAD 100%; SHELL 85%  
 SHIPPING WEIGHT: ~ 16000 # TEST WEIGHT: ~ 80000 #

MATERIALS

SHELL: VESSEL: 1/2" TK. SA-240 304L  
 JACKET/TUBE SIDE: \_\_\_\_\_  
 HEADS: VESSEL: 7/16" NOM. SA-240 304L  
 JACKET/TUBE SIDE: \_\_\_\_\_  
 TUBES: \_\_\_\_\_  
 TUBE SHEETS: \_\_\_\_\_  
 BAFFLES: \_\_\_\_\_  
 TIE RODS: \_\_\_\_\_  
 FLANGE SPEC.: SA-105  
 RATING: CLASS 150; A.N.S.I. B 16.5  
 FACING: LAP JOINT & RAISED FACE - STANDARD STOCK  
 EXTERNAL PIPE SPEC.: SA-312 TP 304L WLD.  
 INTERNAL PIPE SPEC.: SA-312 TP 304L WLD.  
 CLADDING OR LINING SPEC.: SA-240 304L  
 BOLTING: STUD: SA-193 B7; NUT: SA-194 2H  
 GASKETS: TFE ENVELOPE/ GARLOCK 6326  
 SUPPORTS: SA-36 SADDLES ON SA-240 304L REPADS  
 INSULATION: NONE  
 PAINTING: CARBON STEEL PARTS: PER FMC SPEC. 8004-A

NOTES

- ELEVATIONS MEASURED FROM BASE LINE.
- ORIENTATION MEASURED CLOCKWISE FROM 0°.
- PROJECTION MEASURED FROM (CENTERLINE) (OUTSIDE) OF VESSEL TO EXTREME FACE OF FLANGE.
- NOZZLE BOLT HOLES TO STRADDLE 0°-180° CENTERLINE OR ITS PARALLEL UNLESS NOTED OTHERWISE.
- COVER ALL FLANGES, OPENINGS AND MACHINED SURFACES PRIOR TO SHIPMENT UNLESS NOTED OTHERWISE.
- WELDING PROCEDURES:  
 # 1 SMAW C.S. TO C.S. # 21 GTAW C.S. TO C.S.  
 # 5 GTAW S.S. TO S.S. # 36 GMAW S.S. TO S.S.  
 # 8 SMAW S.S. TO S.S. # 37 GMAW S.S. TO C.S.  
 # 9 SMAW S.S. TO C.S. # 43 GTAW S.S. TO C.S.  
 # 18 GMAW C.S. TO C.S. # 60 CLAD PLUG WELD
- ALL REPADS WILL HAVE 1/8" NPT WEEP HOLE AT LOW POINT.
- INTERIOR WELD SEAMS WILL BE GROUND SMOOTH, BUT NOT FLUSH.


**NAT'L BD. SERIAL NO.** \_\_\_\_\_  
 FABRICATED & CERTIFIED BY  
**WARD TANK CORPORATION**  
 CHARLOTTE, N.C.

SHELL	MAWP: FV 15 PSI @ 239 °F
JKT./TUBE SIDE	MAWP: _____ PSI @ _____ °F
SHELL	Min. Design Metal Temp: -20 °F @ 15 PSI
JKT./TUBE SIDE	Min. Design Metal Temp: _____ °F @ _____ PSI
TEST PRESS.	SHELL: 23 PSI JKT./TUBE SIDE: _____ PSI
MFGR. S. N.	W-2751 YR. BUI. T: 1995
CUSTOMER	FMC CORPORATION
P.O. NO.	JB-94037-11.05 DATE: 12.12.94
NOMENCLATURE	NITRIC ACID STORAGE TANK
EQUIP. NO.	T-15070


**CERTIFIED BY**  
 WARD TANK CORPORATION  
 By: CAC  
 Date: 10.3.95

**WTC WARD TANK CORPORATION**  
 8870 EAST HARRIS BOULEVARD  
 CHARLOTTE, NORTH CAROLINA 28215


CUSTOMER	FMC CORPORATION	PURCHASE ORDER NUMBER	JB-94037-11.05
TITLE <b>NITRIC ACID STORAGE TANK</b>			
EQUIPMENT NO.	T-15070	NO. REQ'D	1
CHECKED BY	C.A.C.	DATE	12.12.94
DRAWN BY	M.C.M.	SCALE	AS SHOWN
REV. NO.	DATE	DESCRIPTION	BY
2	8.2.95	PAINT SPEC. - AS BUILT	C.A.C.
1	3.23.95	PER APPROVAL DRAWING	C.A.C.

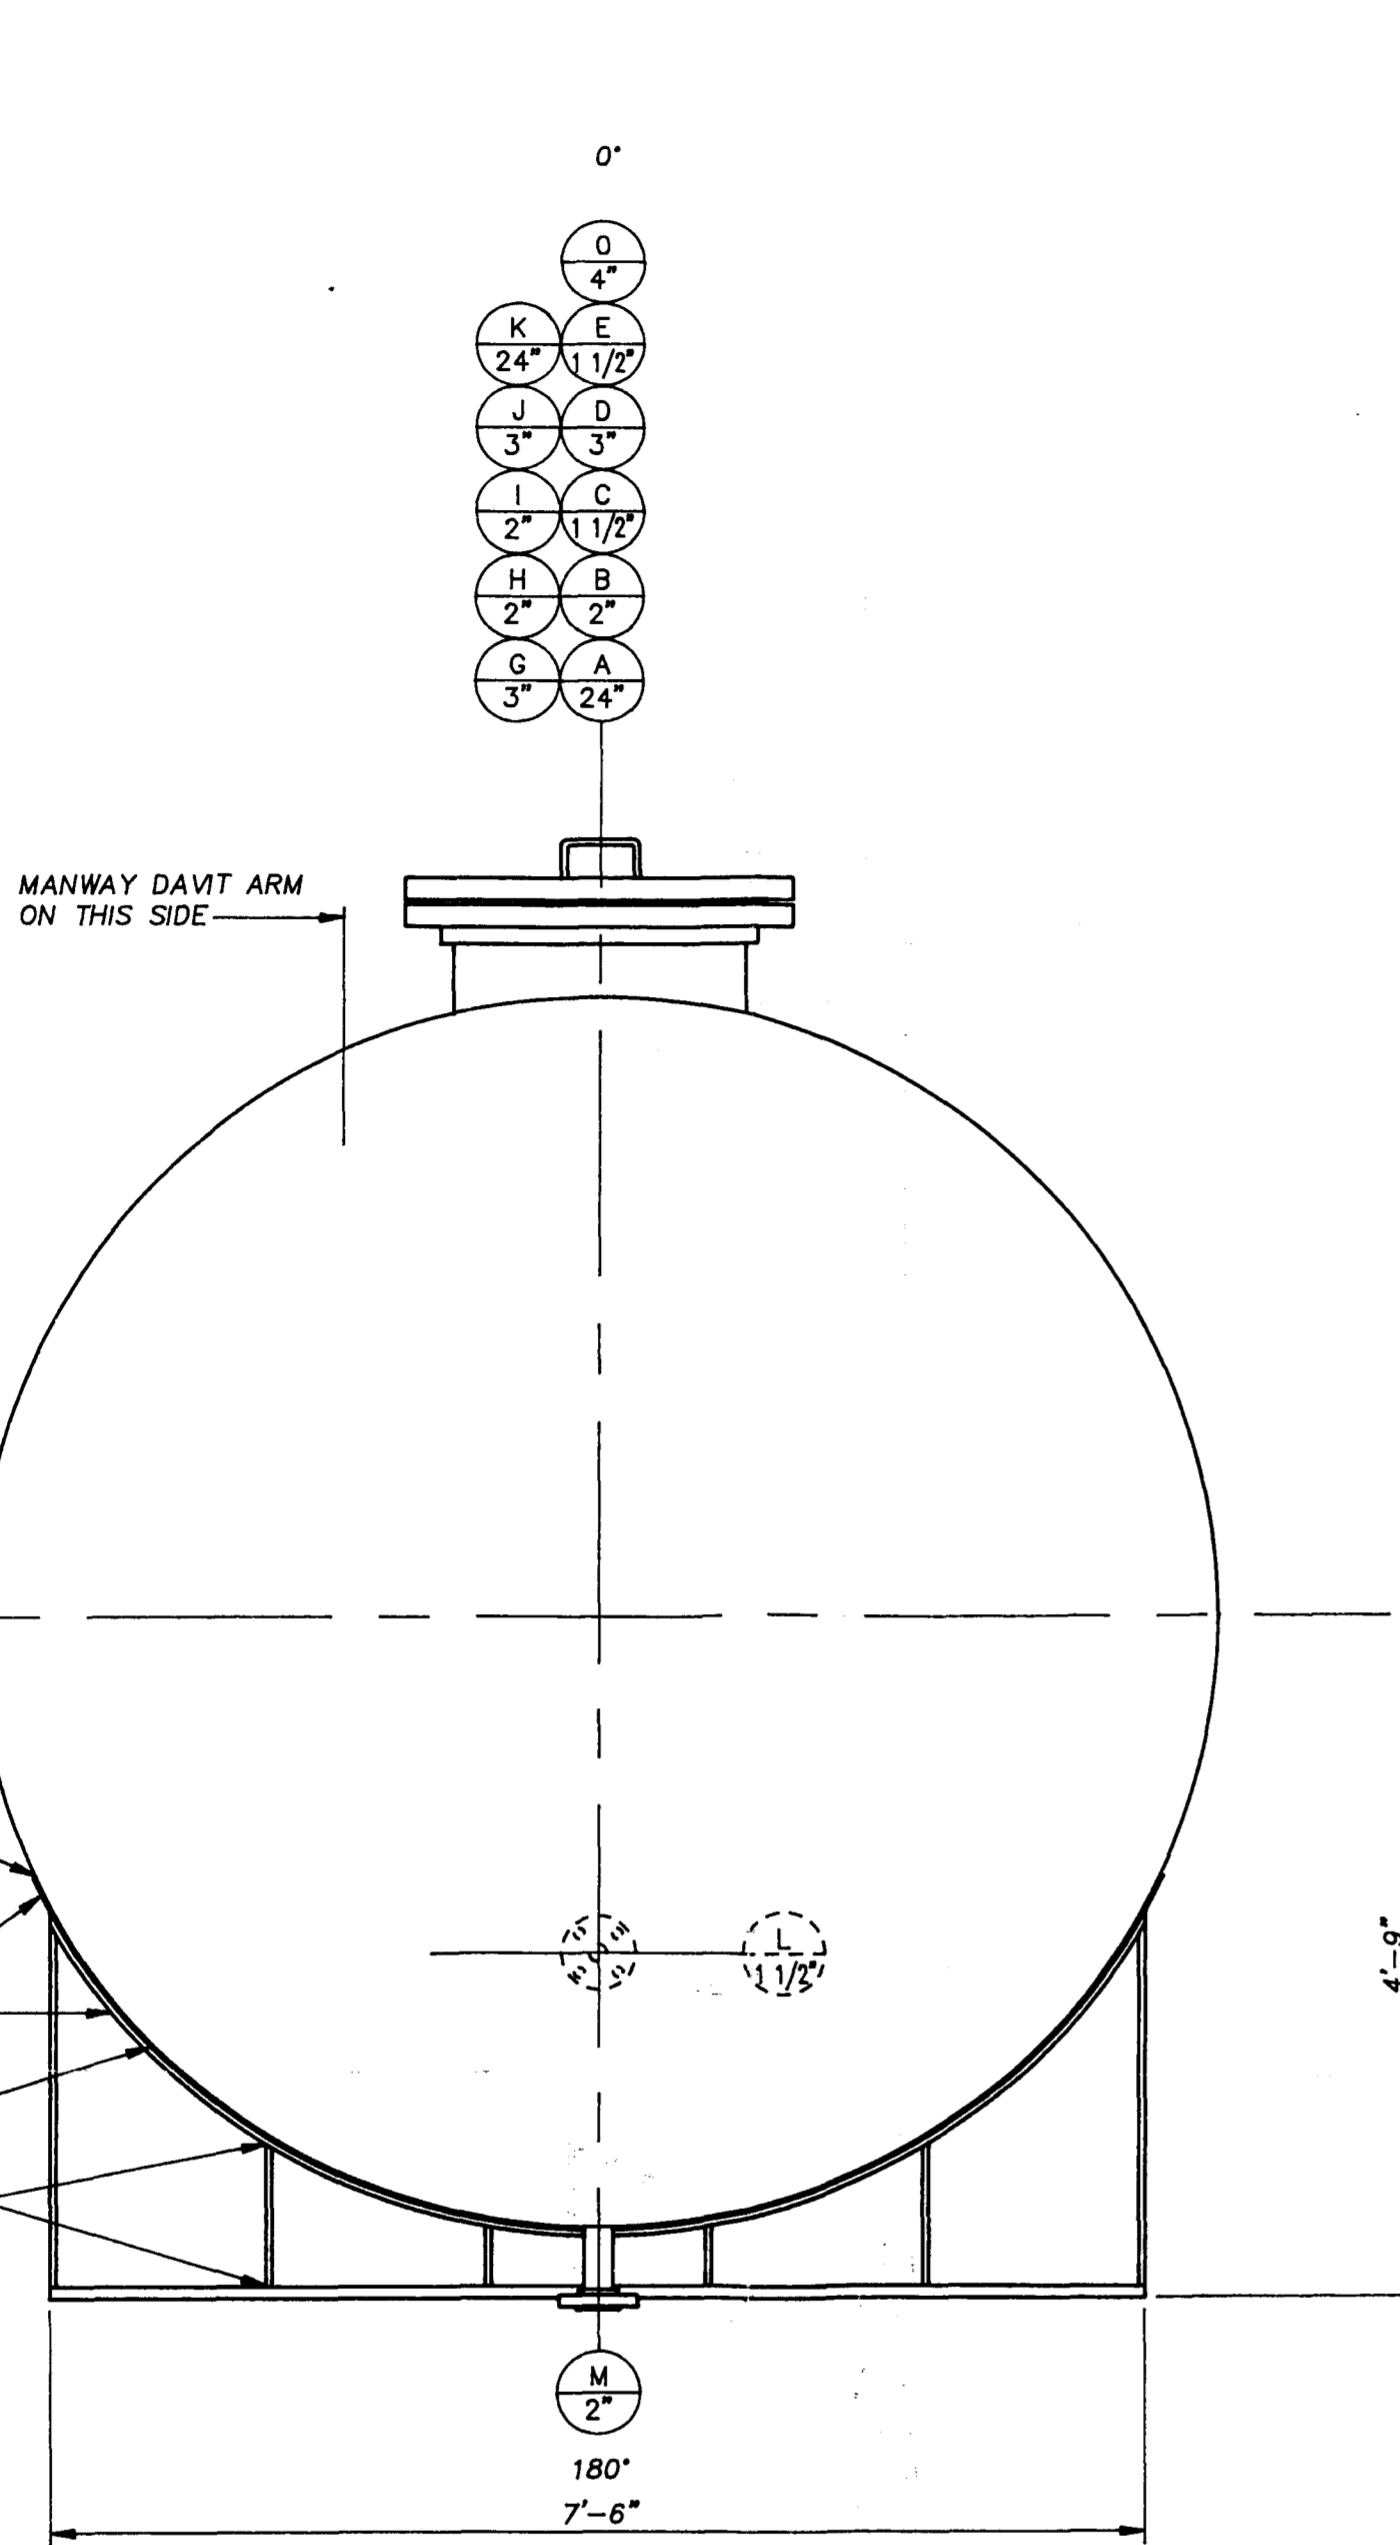

LEFT END VIEW  
 SCALE 3/4" = 1'-0"

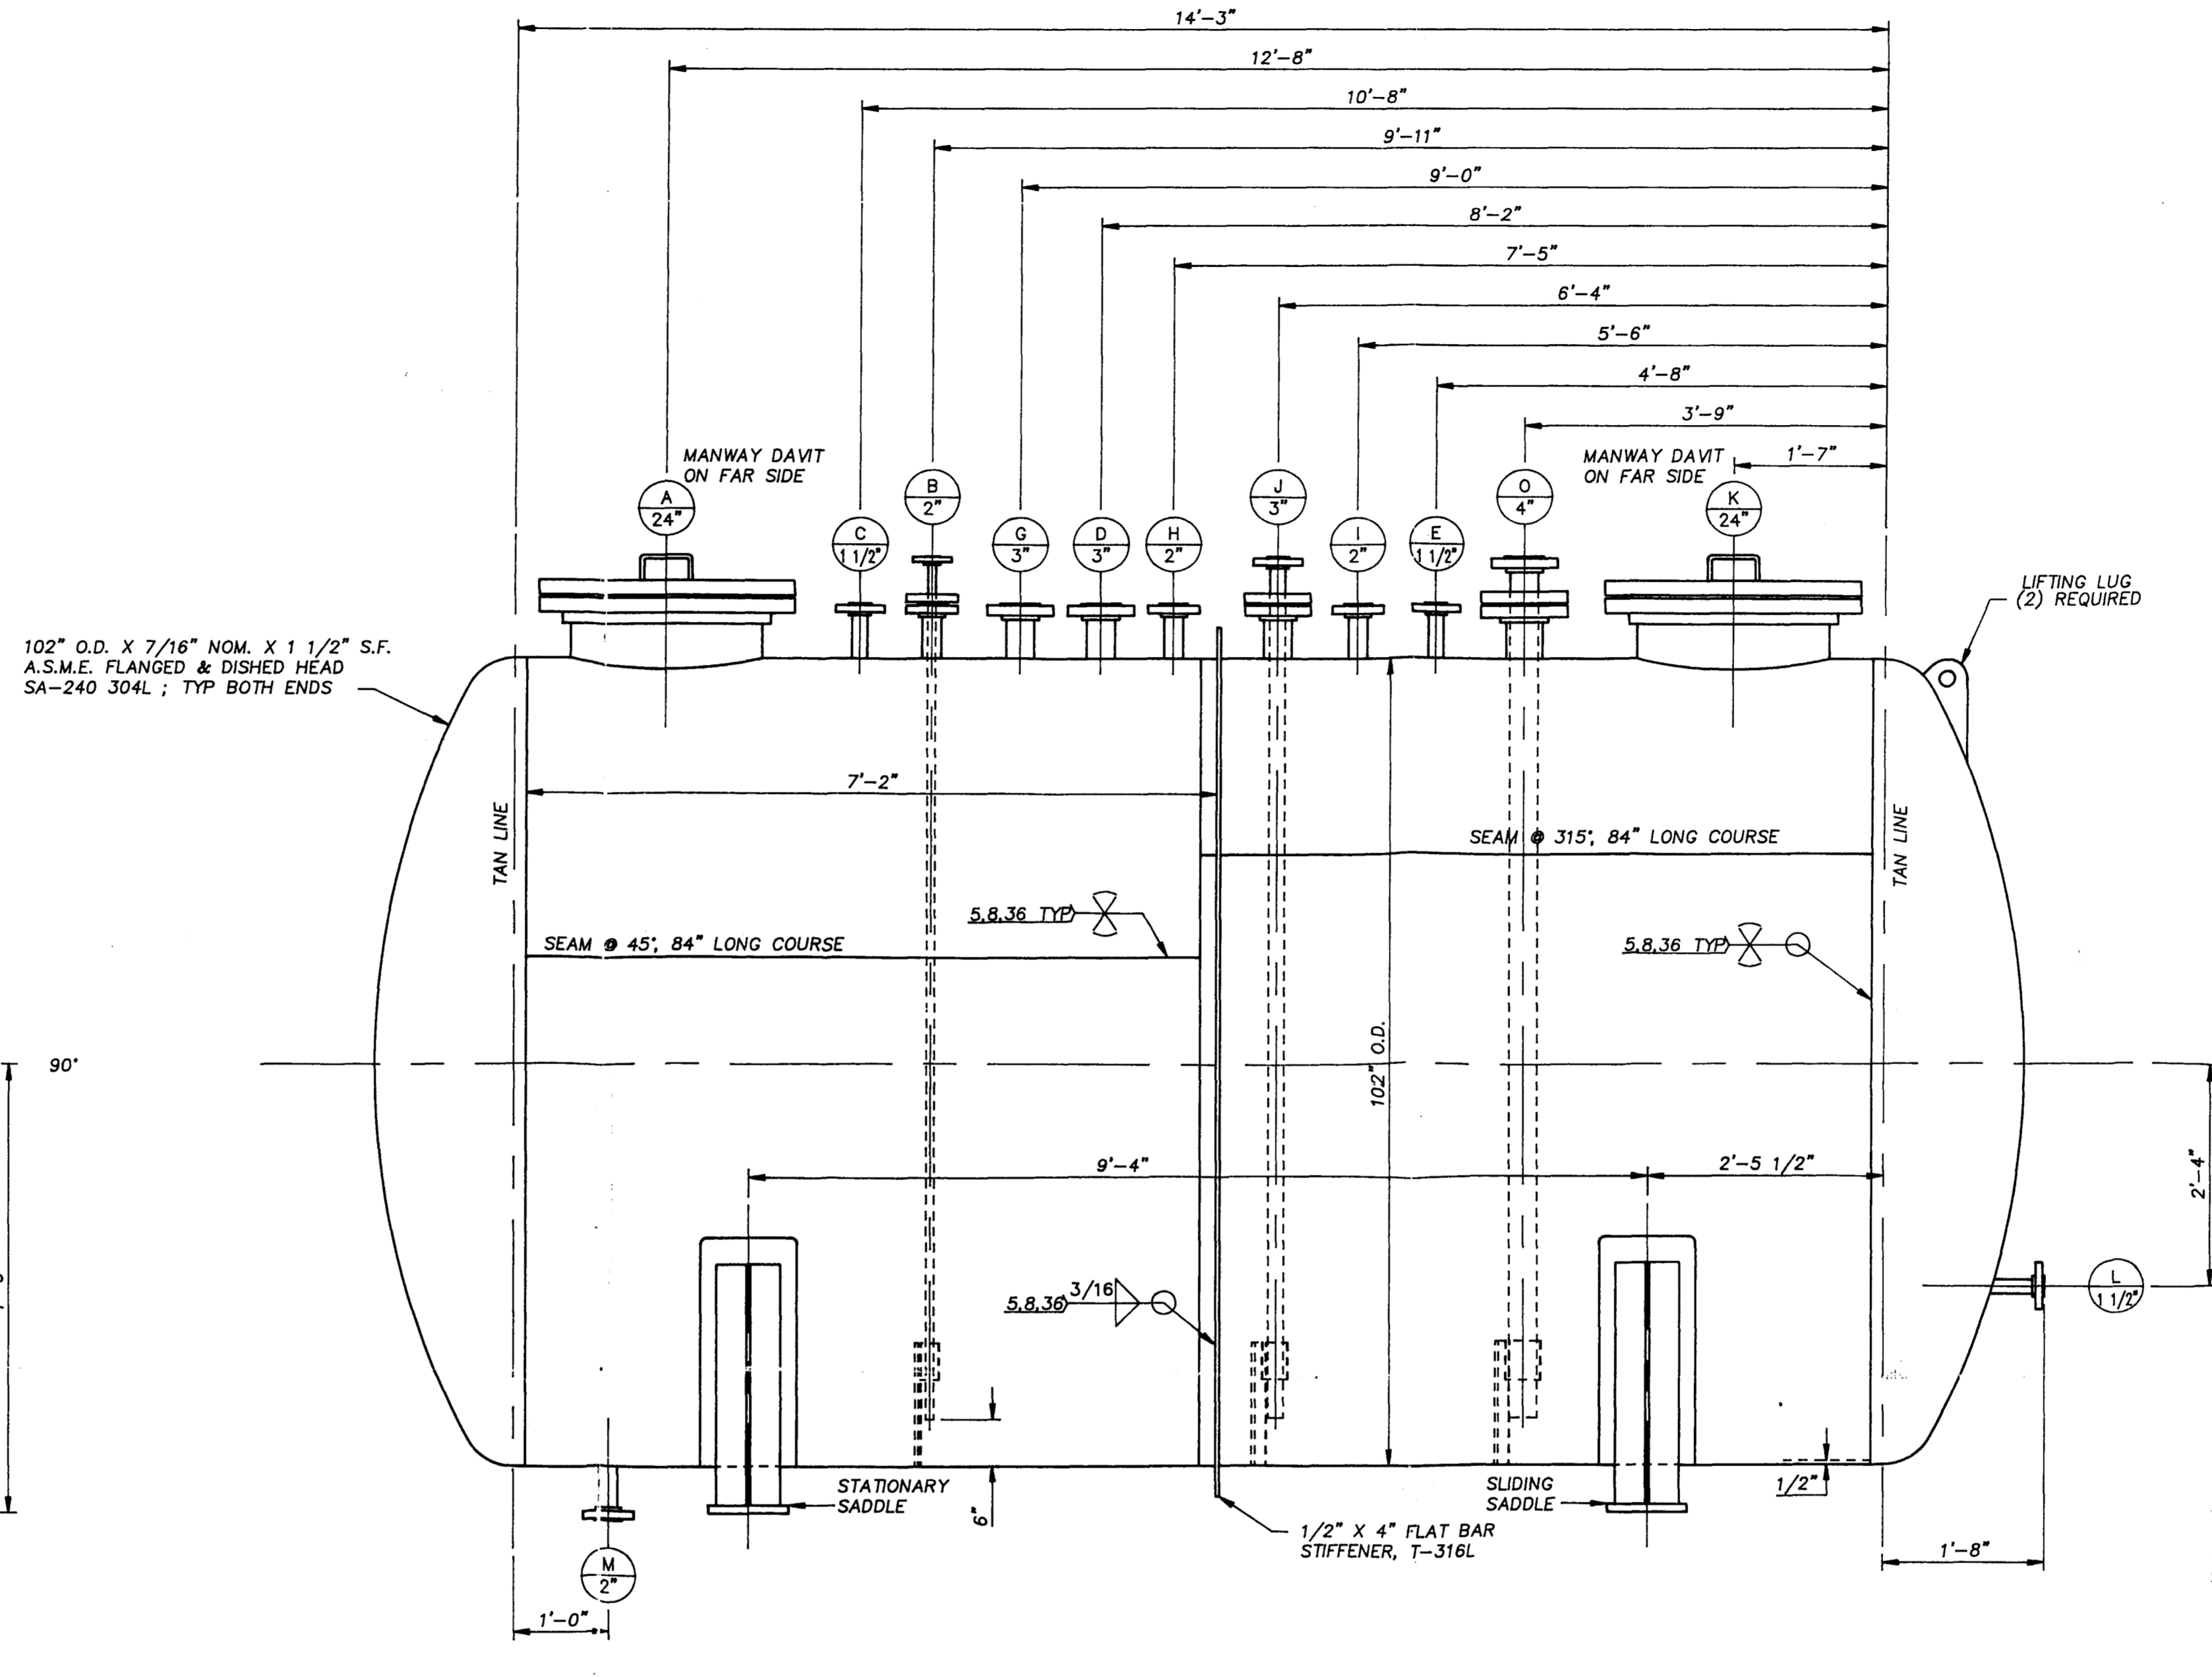


ELEVATION VIEW  
 SCALE 3/4" = 1'-0"

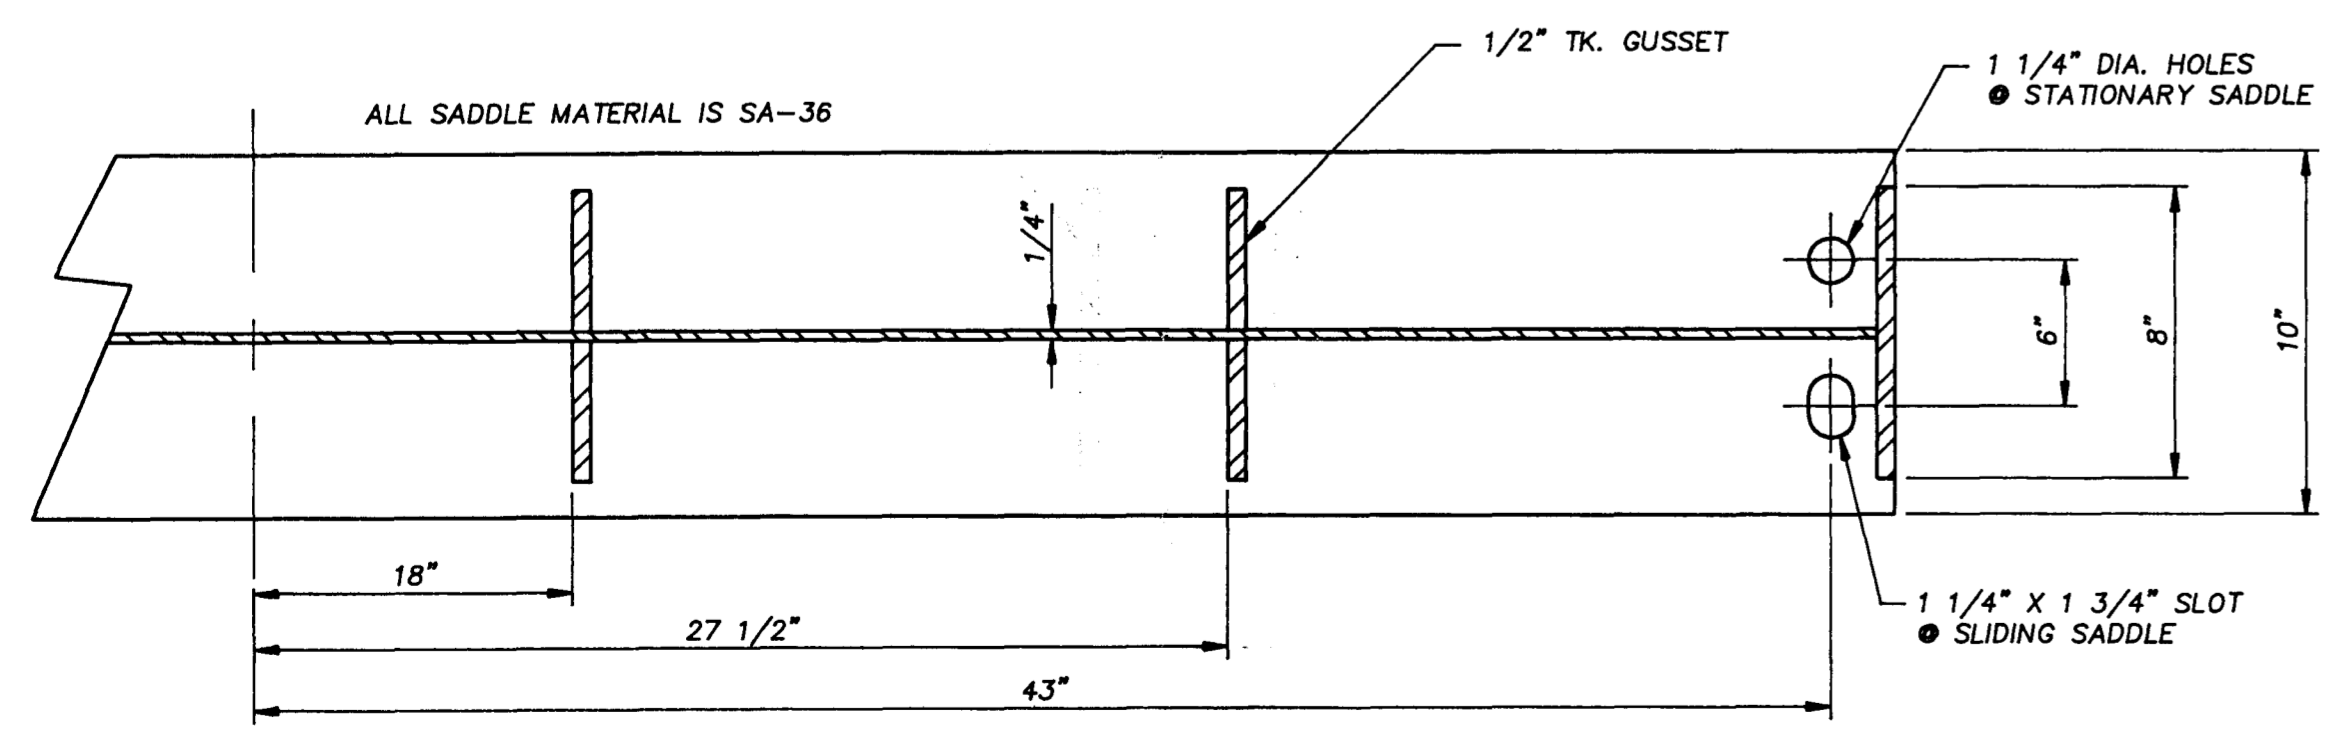


SADDLE SECTION VIEW  
 NO SCALE


REV. NO.	DATE	DESCRIPTION	BY
2	8.2.95	PAINT SPEC. - AS BUILT	C.A.C.
1	3.23.95	PER APPROVAL DRAWING	C.A.C.

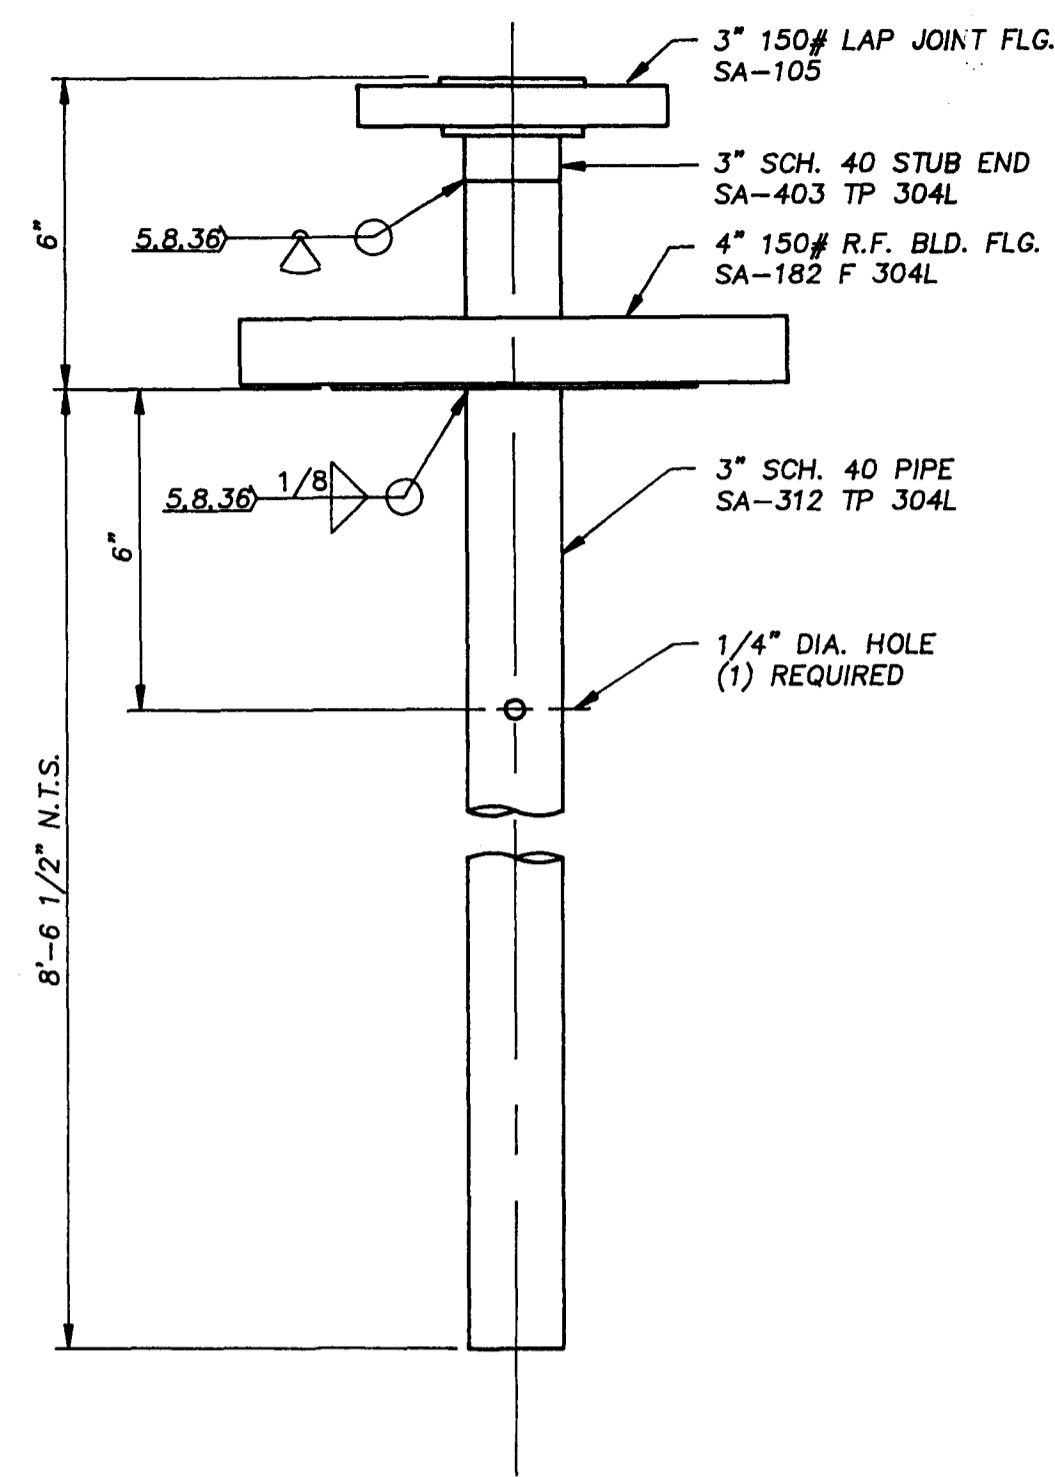


DIP PIPE DETAIL NOZZLE O  
NO SCALE

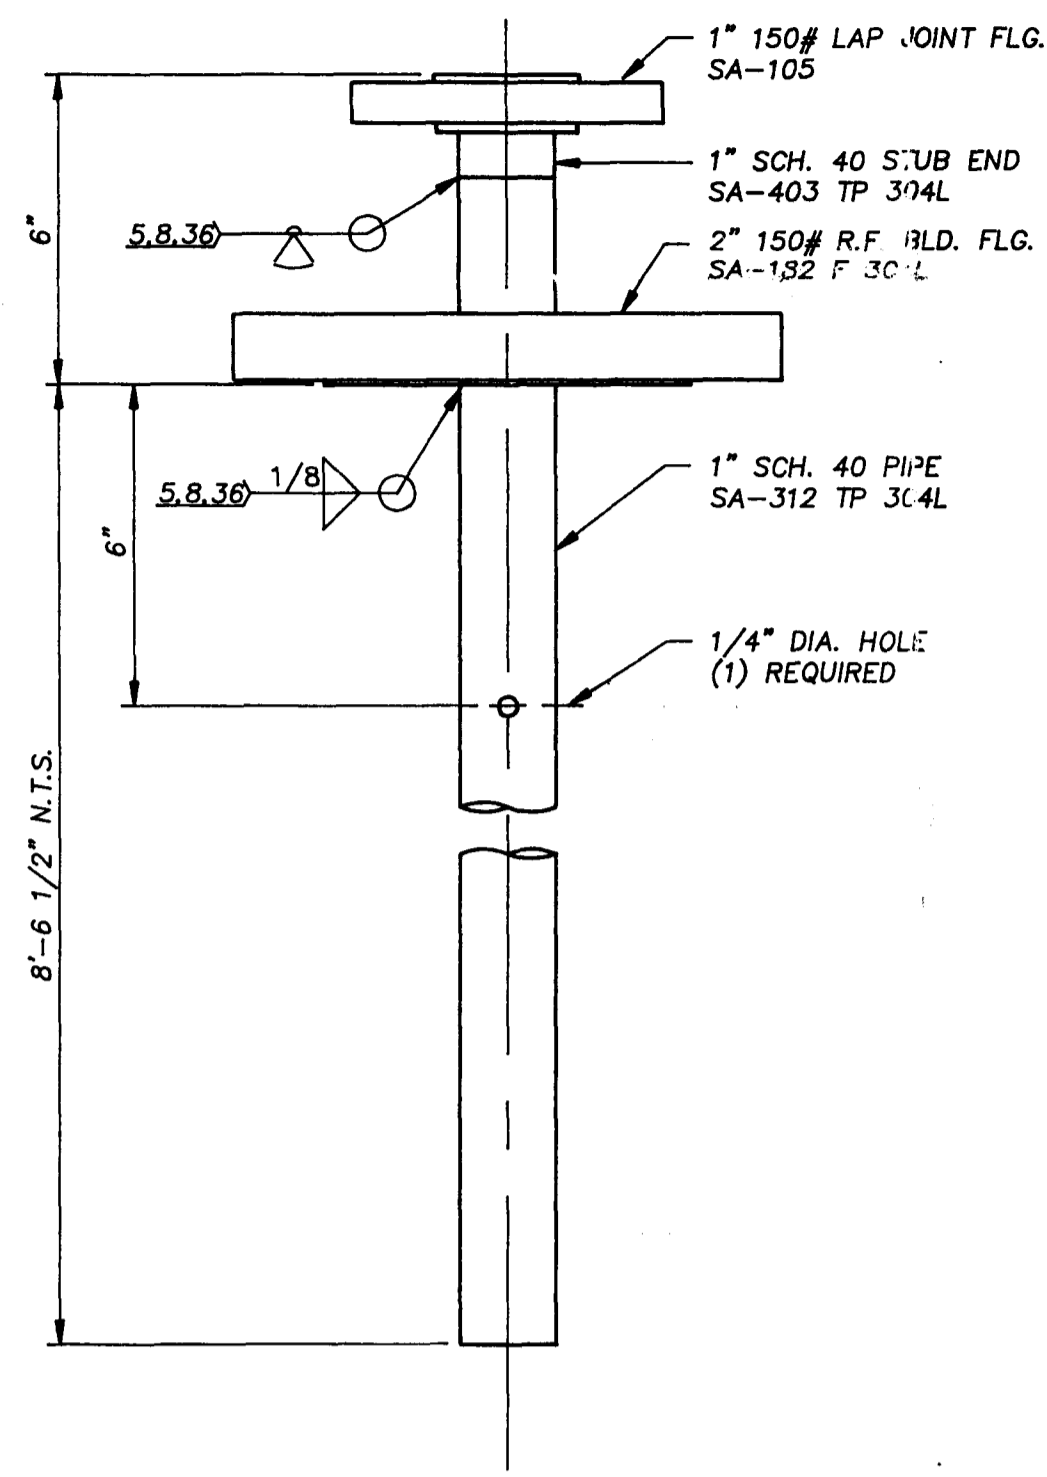


DIP PIPE DETAIL NOZZLE B  
NO SCALE

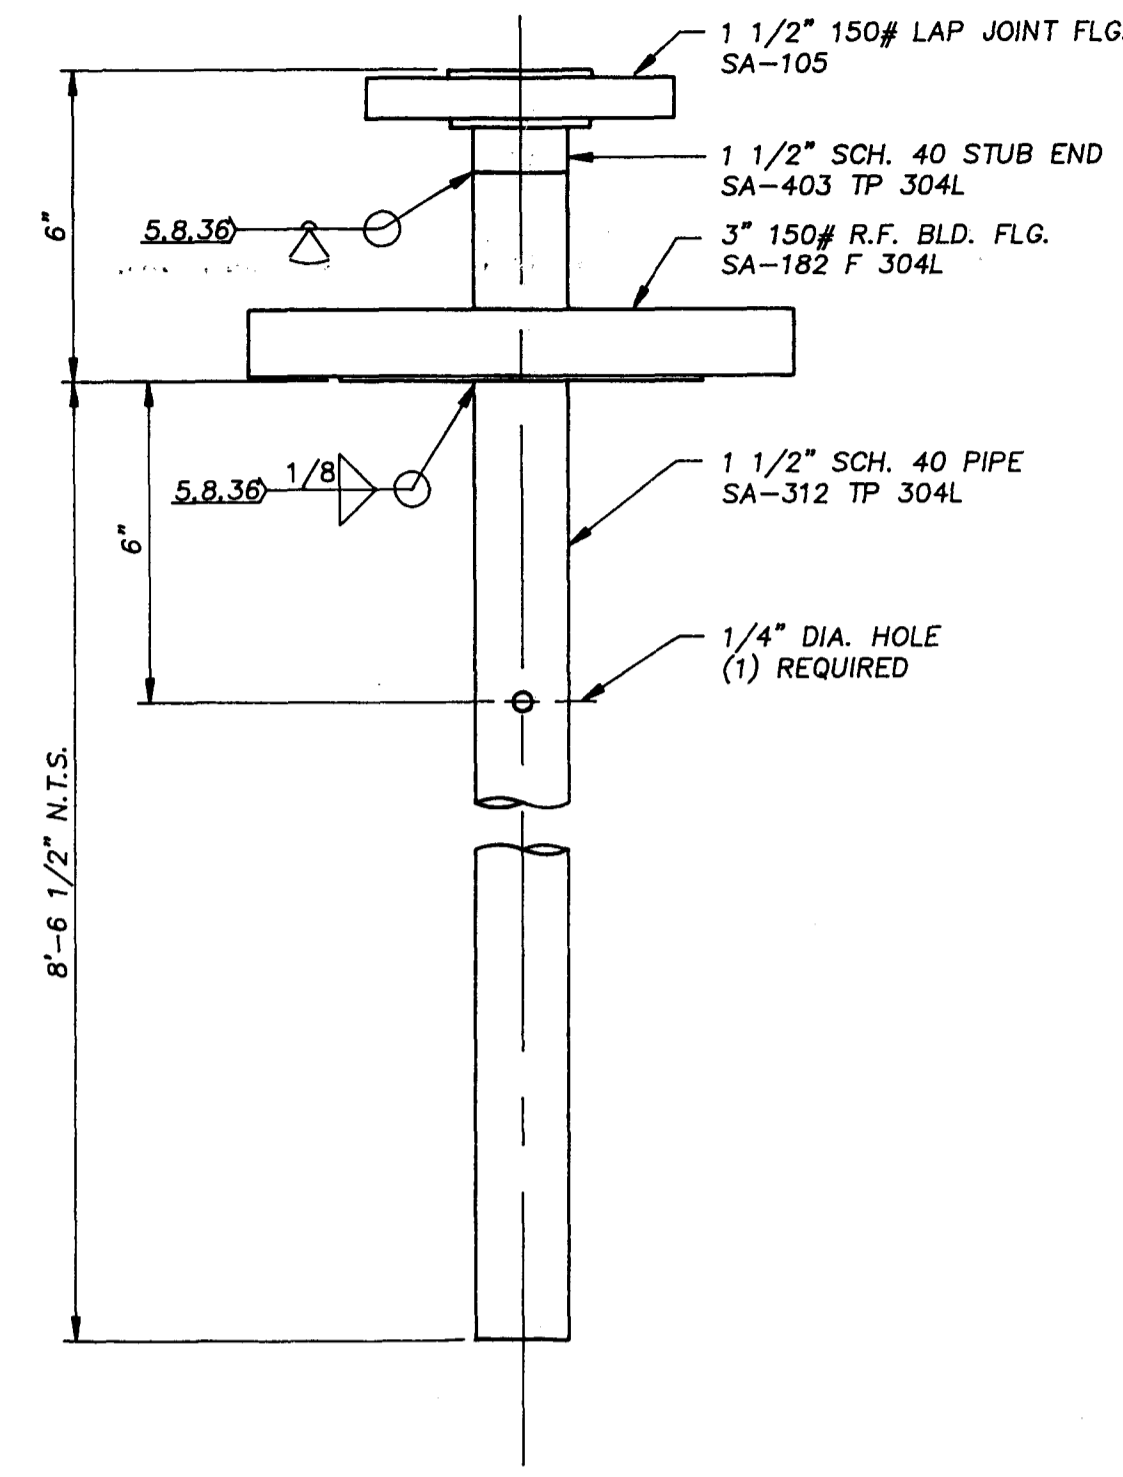


DIP PIPE DETAIL NOZZLE J  
NO SCALE

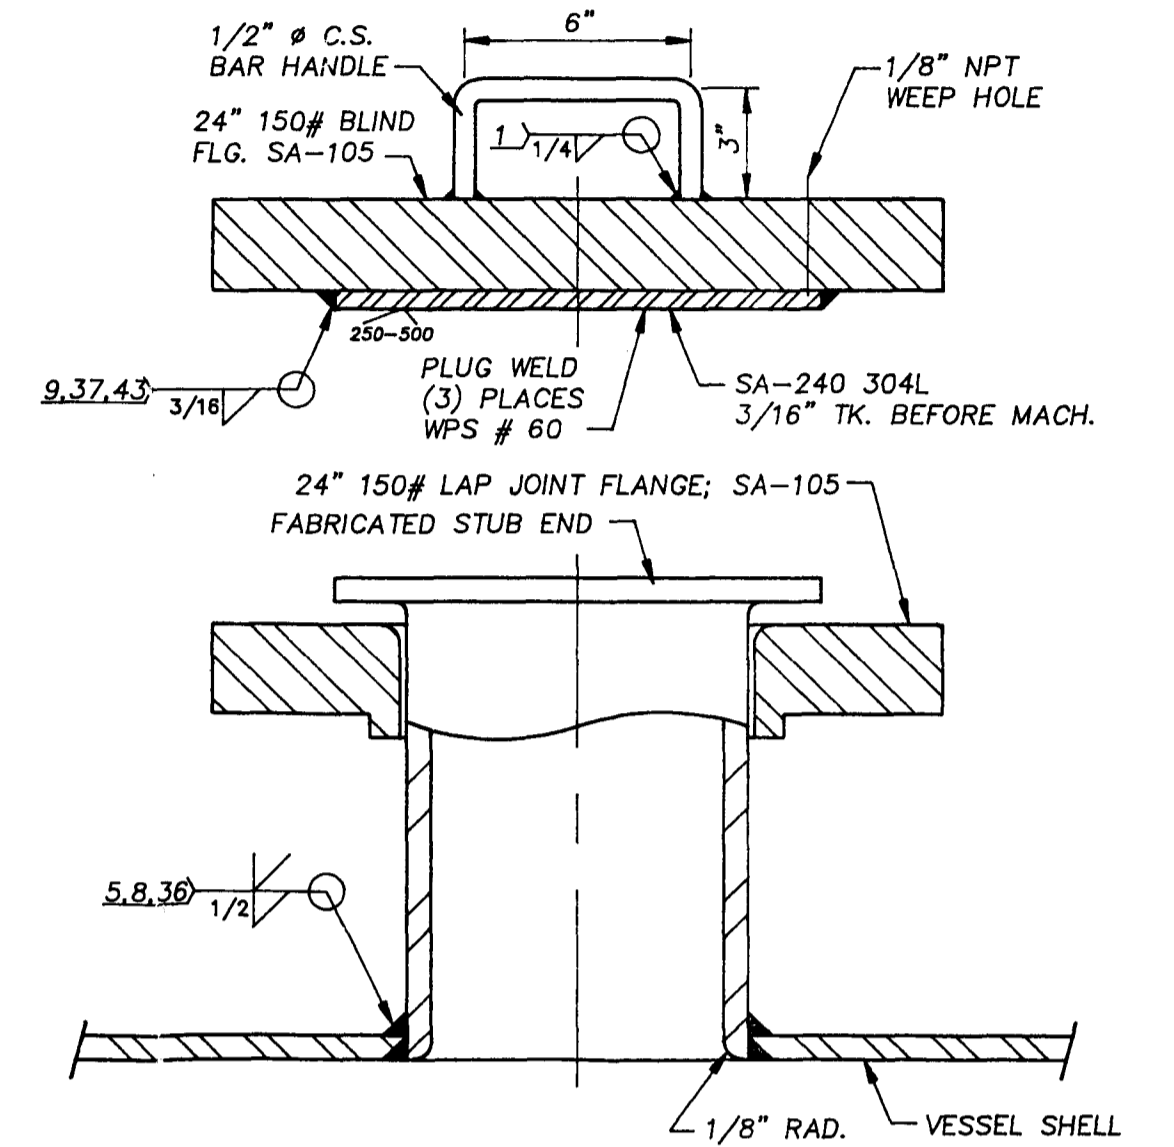


DETAIL MANWAY A & K  
NO SCALE

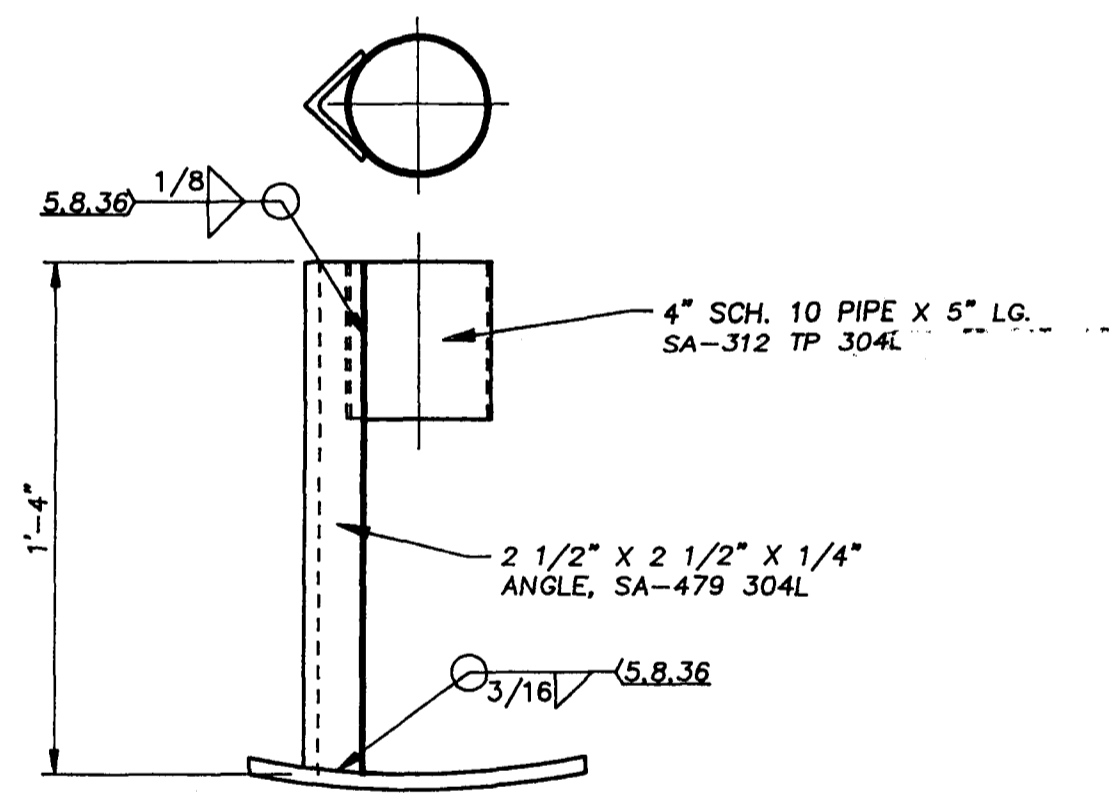


DIP PIPE SUPPORT DETAIL NOZZLE O  
NO SCALE

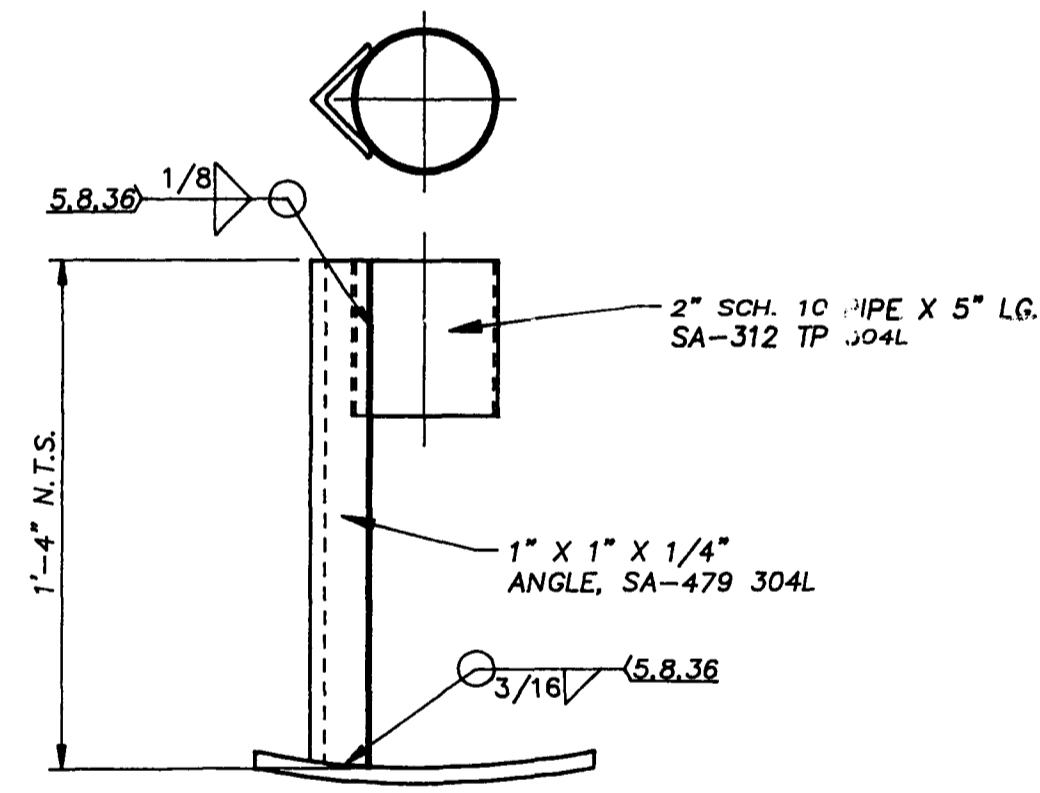

DIP PIPE SUPPORT DETAIL NOZZLE B  
NO SCALE

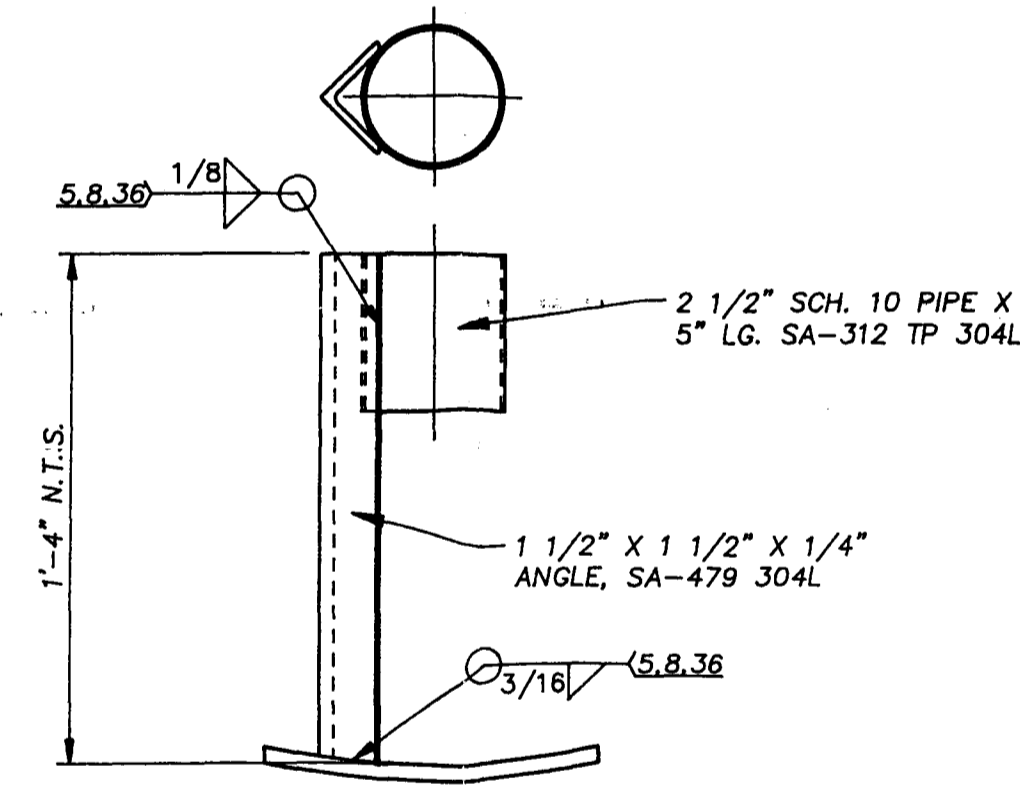


DIP PIPE SUPPORT DETAIL NOZZLE J  
NO SCALE

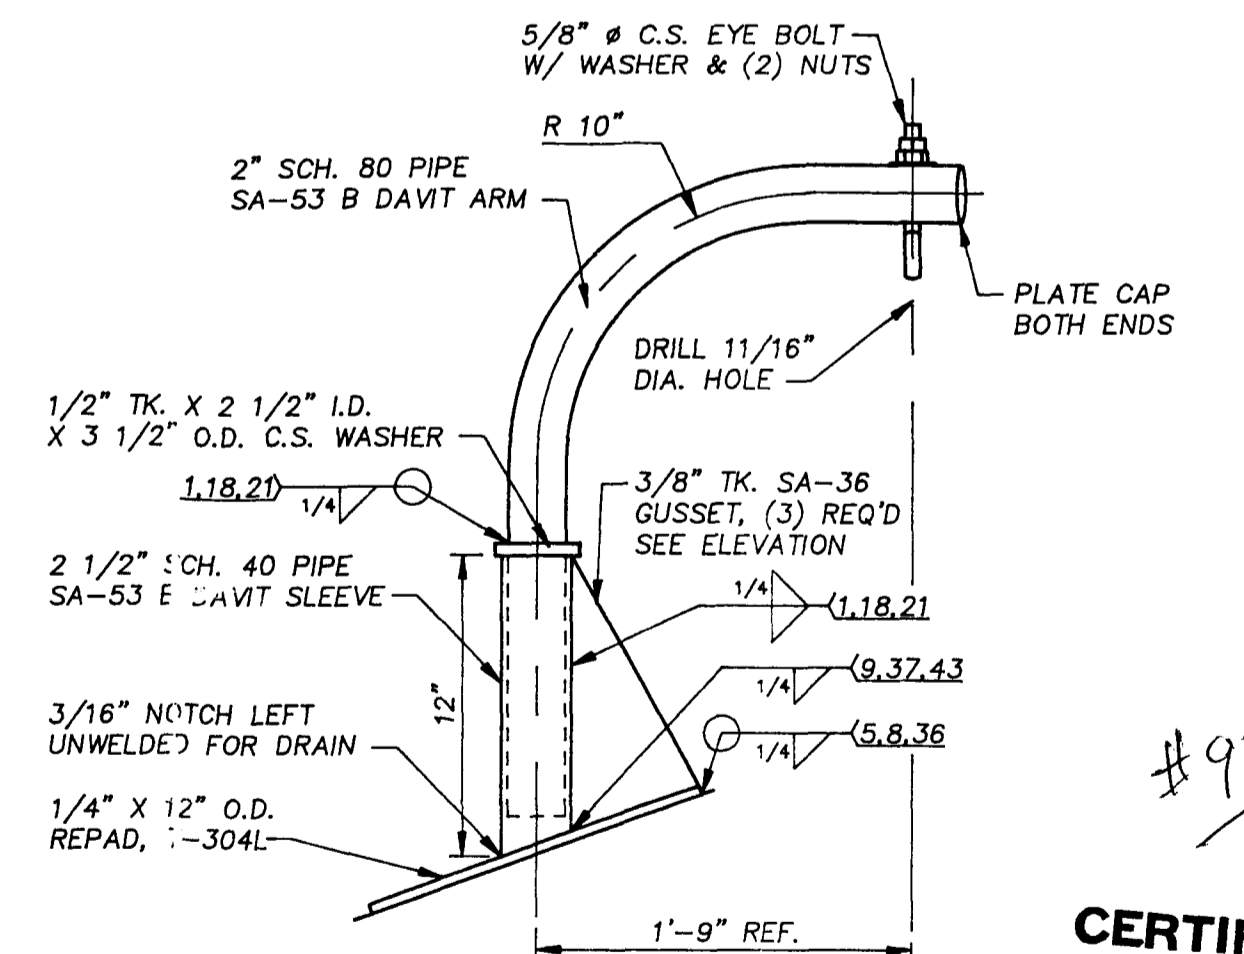


MANWAY A & K DAVIT ARM DETAIL  
NO SCALE


#93874  
**CERTIFIED PRINT**  
 WARD TANK CORPORATION  
 By: C.A.C.  
 Date: 10.3.95

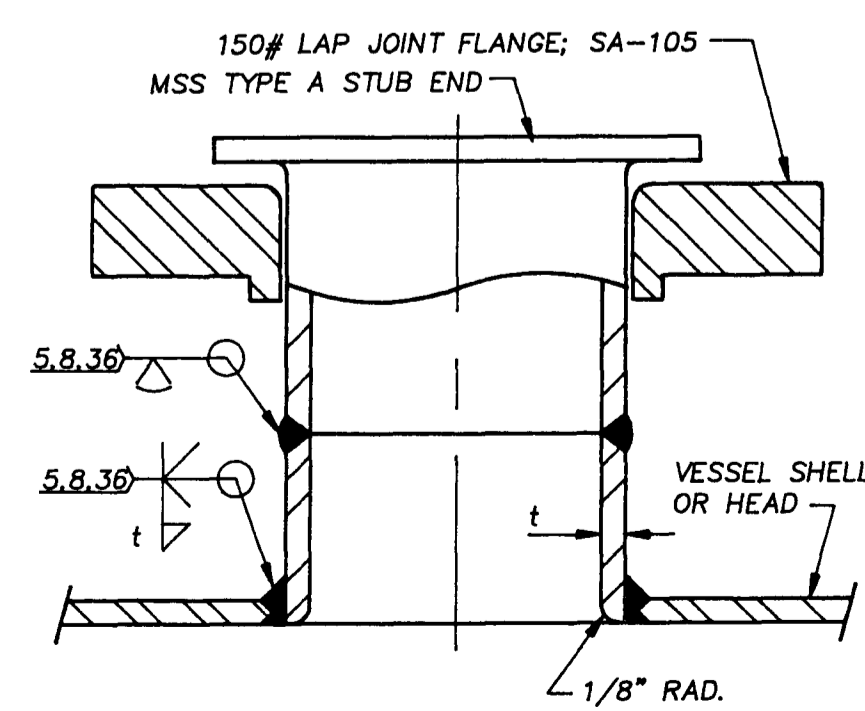

NOZZLE ASSEMBLY DETAIL  
NO SCALE

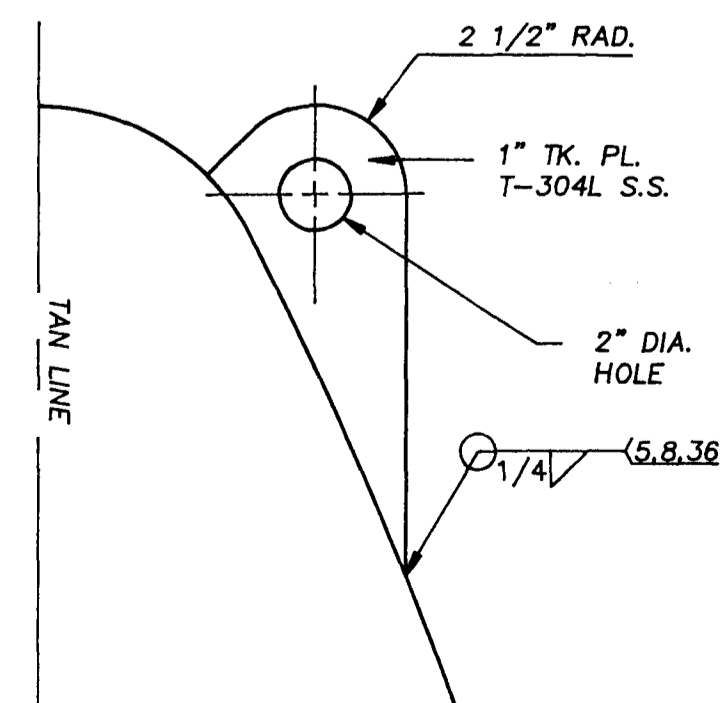

LIFTING LUG DETAIL  
NO SCALE

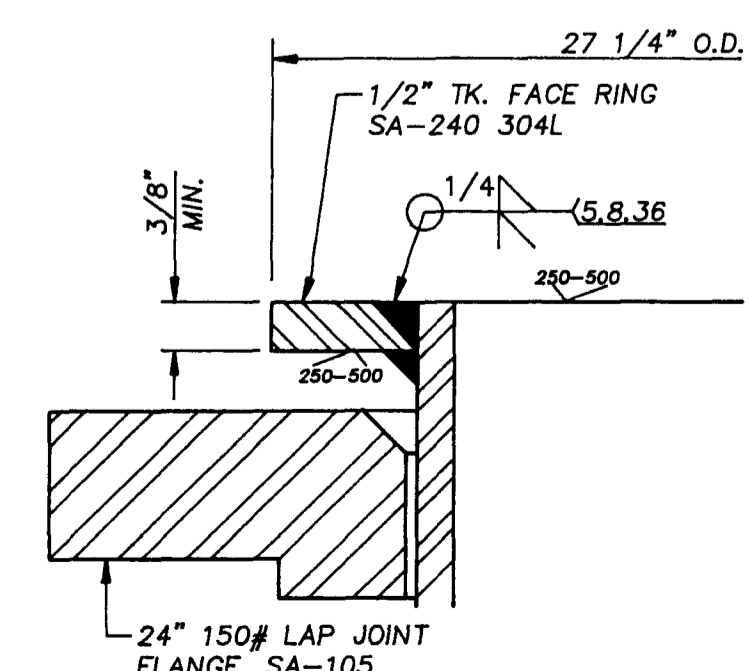

STUB END DETAIL MANWAY A & K  
NO SCALE

REV NO.	DATE	DESCRIPTION	BY
2	8.2.95	AS BUILT (NO CHANGE)	C.A.C.
1	3.23.95	PER APPROVAL DRAWING	C.A.C.

EQUIPMENT NO.	T-15070	NO. REQ'D	1
CHECKED BY	C.A.C.	DATE	12.12.94
DRAWN BY	M.C.M.	SCALE	AS SHOWN

CUSTOMER	FMC CORPORATION	PURCHASE ORDER NUMBER	JB-94037-11.05
TITLE NITRIC ACID STORAGE TANK			
DRAWING NUMBER 94-W-2751		SHEET 2 OF 2	

