
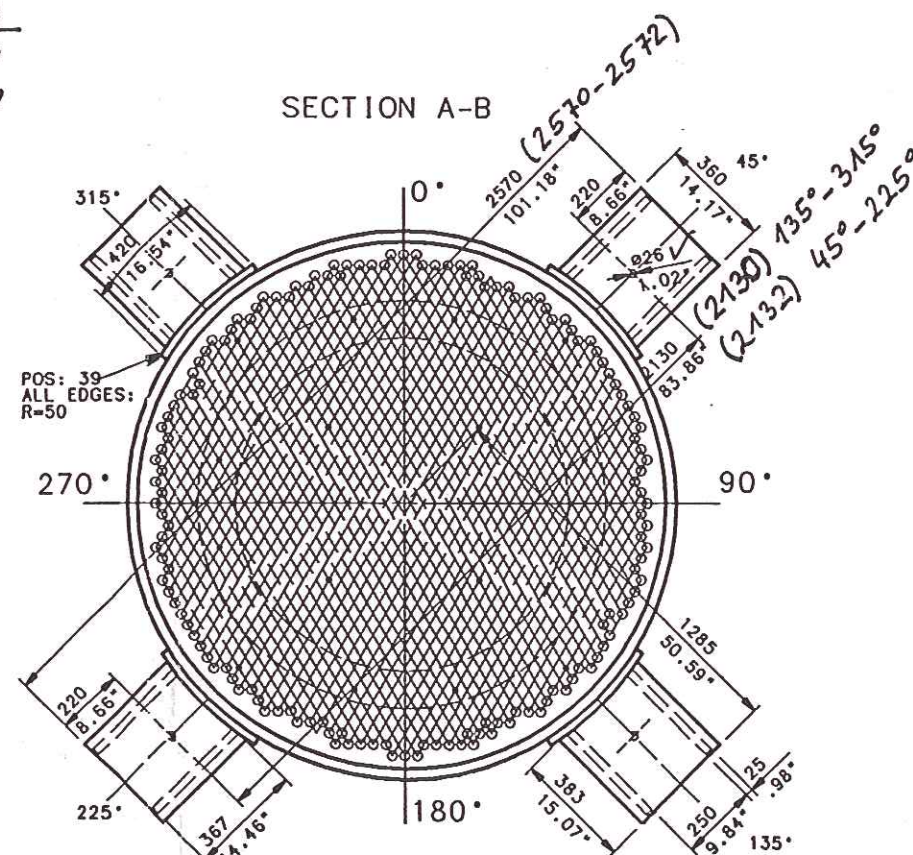
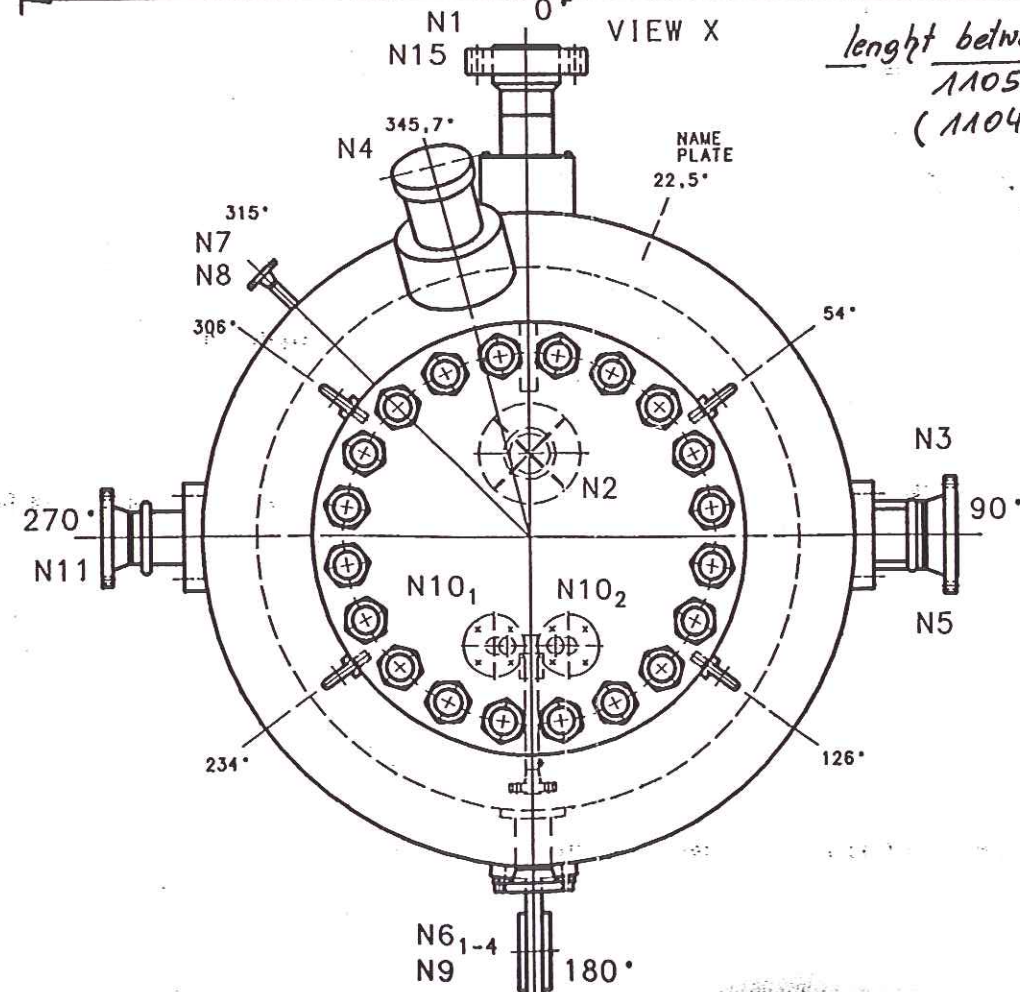


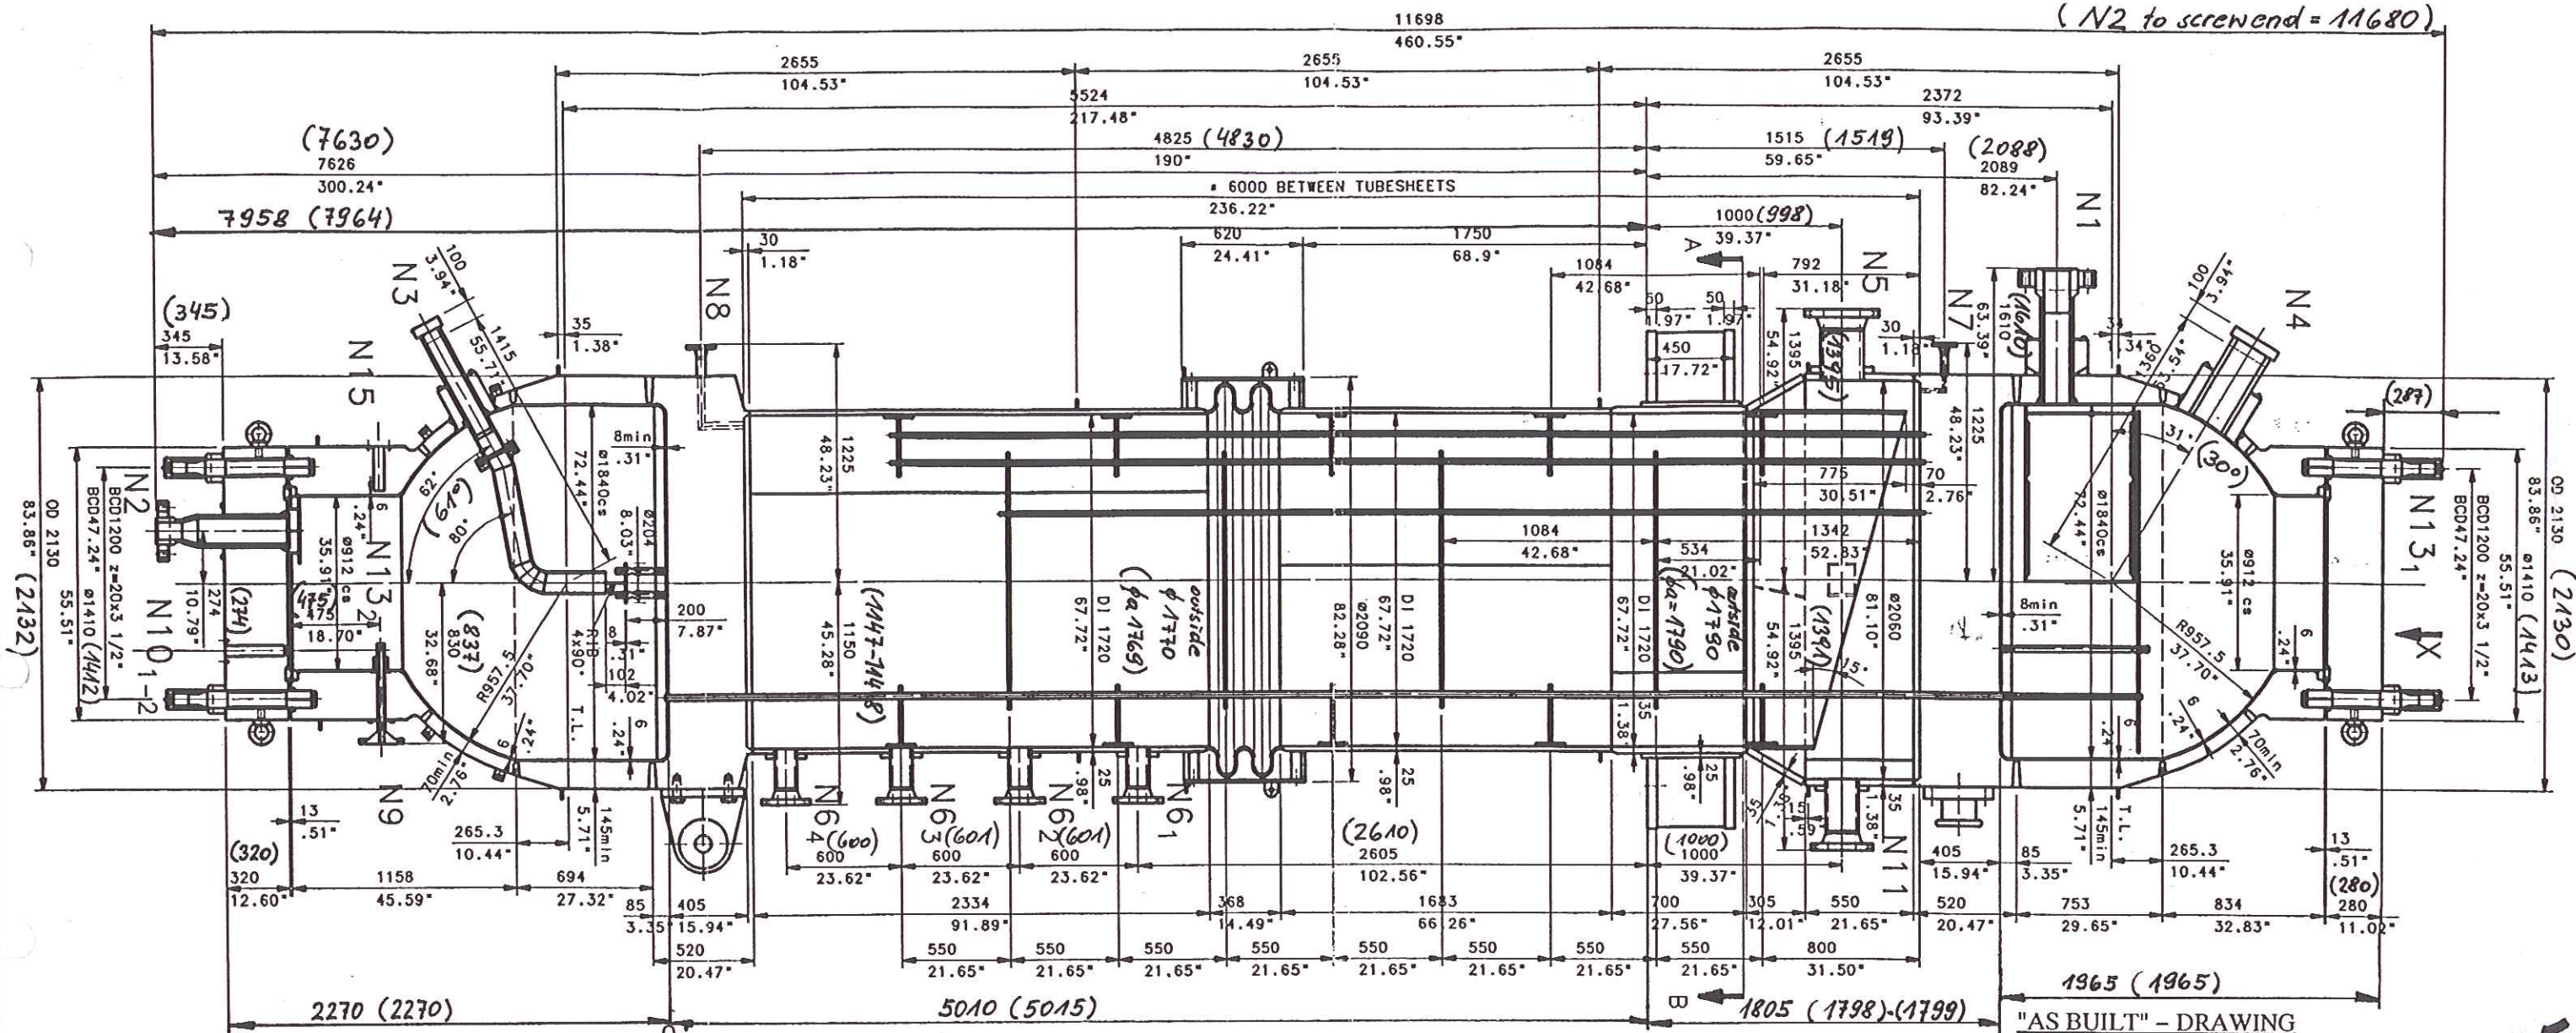

QC Inspector: Kerneggen

Report No.: 133/97

Figures in parenthesis are
"as built" - dimensions.

The dimensions are in
conformity with the drawing
and within required tolerances.

Measuring device No.: 9122, 9064,

FESTIGKEITSBERECHNUNG: STRESS CALCULATION:	T-AN10555-B	STÜCKLISTE: PART LIST:	965006-0
STANDFESTIGKEITSNACHWEIS: STABILITY ANALYSIS:	---	RESERVETEILSTÜCKLISTE: SPARE PART LIST:	965006-0
KUNDE: TRIAD CHEMICAL CLIENT: DONALDSONVILLE LA, USA		KUNDEN AUFTRAGS Nr.: CLIENT ORDER No.:	9604028
KUNDEN PROJ. SPEZ. Nr.: CLIENT PROJ. SPEZ. No.:		KUNDEN ZEICHNUNGS Nr.: CLIENT DWG. No.:	
PROJ. POS: PROJ. ITEM:	E-102 B	FABR. Nr.: MFR'S SERIAL No.:	8182
		BAUJAHR: YEAR OF MANUFACTURE:	199
DIESE ABMASSE WERDEN BEI ABNAHME BESONDERS GEPRÜFT THIS DIMENSIONS WILL BE ESPECIALLY CHECKED			
SCHÖELLER-BLECKMANN NOOTER APPARATEBAU			
DRAWN CHECKED	DATE 1997-02-28	SIGNATURE [Signature]	GÜLTIG FÜR AUFTRAG: MFR'S ORDER NO.:
			960005 EXT 965006 INT
MASSTAB: SCALE:	BENENNUNG: DESCRIPTION	AS BUILT DWG HP STRIPPER	REVISION: 0