


100455, # 100456, # 100457, # 100458, # 100459

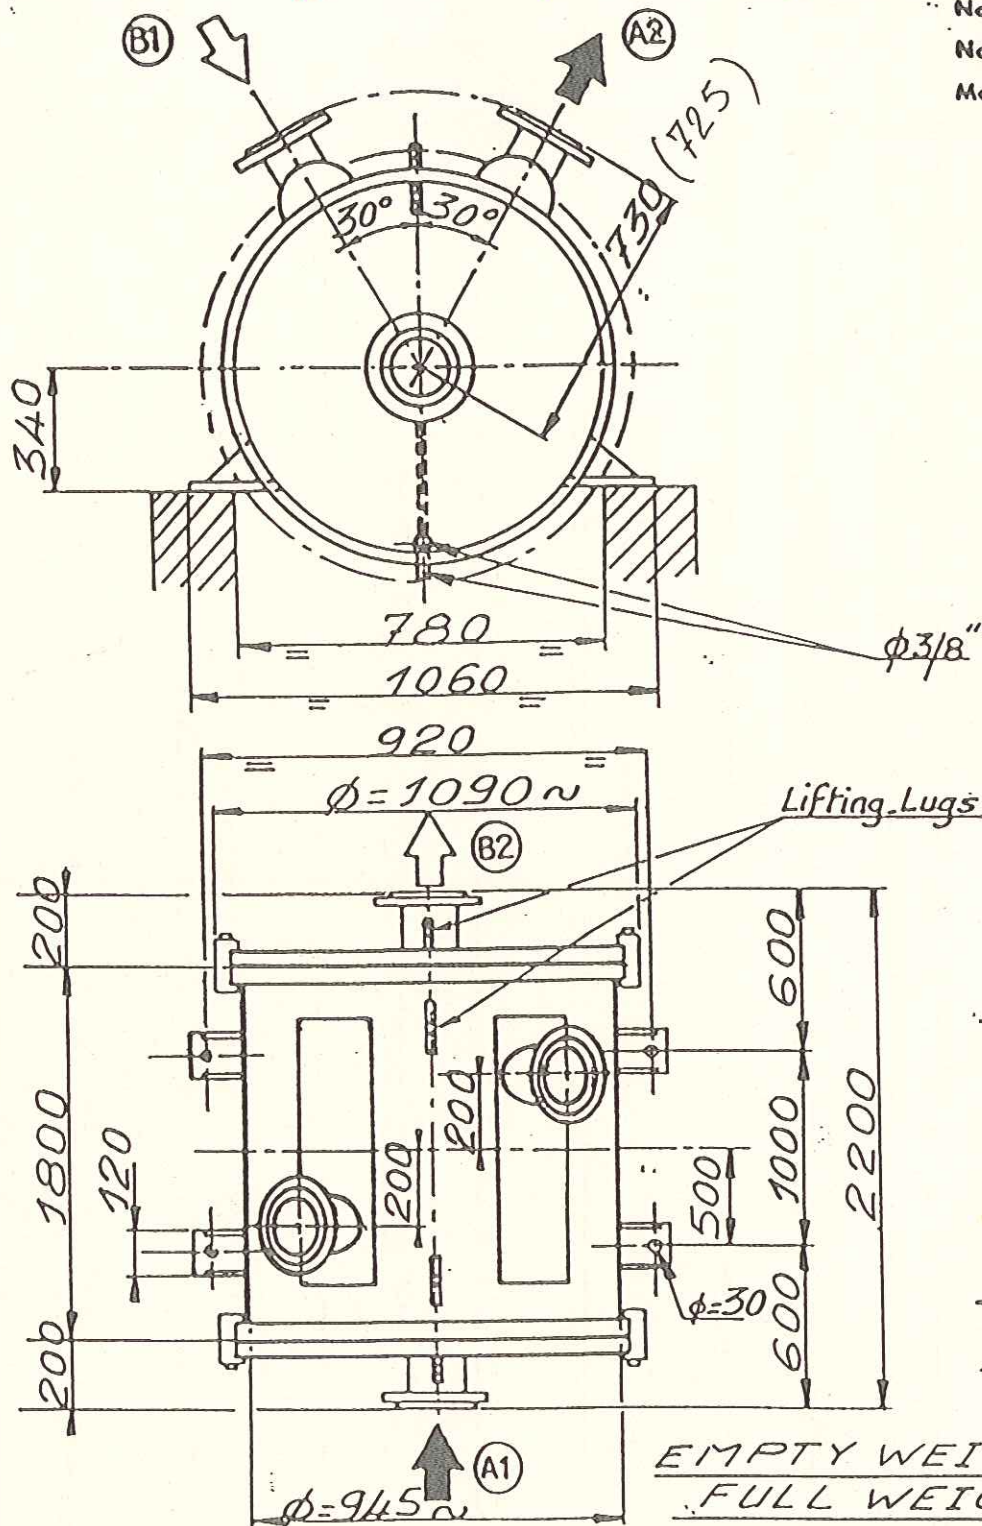

Note:
Not to scale.
Measurements in mm.

(As-built)

1.E 402 A/B

2.E 402 A/B

3.E 402

EMPTY WEIGHT: 1920 Kgn

FULL WEIGHT: 3140 Kgn

Area m ² 69,1	Material AISI 316	Spacing mm Inner 14 Outer 14		Gasket material CAFIITC	Flanges according to ANSI 150 lbs B 16.5 Lap Joint		
Medium and flow rate	Temperature °C		Working pressure bar	Design pressure bar	Design temp °C	Test press at - 20 °C	Connection sizes
Inlet channel A WATER	In 28	Out 306	5	5	109	7,5	In A ₁ 8" Out A ₁ 8" Out 3/8"
Outlet channel B CORN BROTH	In 34	Out 32	5	5	109	7,5	In B ₁ 8" Out B ₁ 8" Out 3/8"
Date order 85/06/24	Our order No 5 ME 60418	Your order No		Serial No 15926-27		ALFA-LAVAL NEVERS	
Quotation No CCT	Inquire No		28-29.30				
SPIRAL HEAT EXCHANGER — TYPE I-H							Drawing No
CUSTOMER: SPETCHIM							7364316