

LOOSE ITEMS TO BE DESPATCHED WITH UNIT INCLUDING SPARES & TEST EQUIPMENT.

NO.	DESCRIPTION	QTY	DESCRIPTION
5	WIRE BRUSH	2	Plugs (See Head)
10	STUDBOLT		
11	NUT		
12	TEST CHANNEL		

DESIGN CODES & SPECIFICATIONS
 BS 5400 SECTION VIII DIV. 1 1969 & TEMA CLASS R 1969
 F.W. ENG. STDS. - CN REQ 14-1-1210 GENERAL NOTES
 14-1-21A(LONDON) ENG. STDS. REV. 1
 14-1-20 C.4 REV. 0

SURFACE PREPARATION & PAINTING

	PREPARATION	PRIMER	FINISH
SHELL SIDE	WIRE BRUSH LOOSE SCALE ON CS. ONLY	NONE	NONE
TUBE SIDE	WIRE BRUSH LOOSE SCALE ON CS. ONLY	NONE	NONE

REMARKS: EXPOSED MACHINED SURFACES ARE TO BE COATED WITH AN EASILY REMOVABLE RUST PREVENTATIVE

INSPECTION

NO.	DESCRIPTION	QTY	DESCRIPTION
1	TEST CHANNEL		

REV.	DATE	BY	DESCRIPTION
E	12-12-72	ES	2
D	12-12-72	ES	2
C	12-12-72	ES	2
B	12-12-72	ES	2
A	12-12-72	ES	2

DRAWING LIST

SHEET NO.	DESCRIPTION
SHEET 5	MATERIAL LIST
SHEET 4	GASKETS, INTERPLATE
SHEET 3	TUBES, TUBE SHEET DETS
SHEET 2	SHELL, TUBE BUNDLE & CHANNEL PLANTATION

DESIGN DATA

UNIT TYPE & SIZE	NO. OF SHELLS	NO. OF TUBES	WEIGHT OF TUBE BUNDLE	WEIGHT OF UNIT FLANGED	WEIGHT OF UNIT EMPTY
...

NOZZLE DATA

NO.	DESCRIPTION	QTY	DESCRIPTION
55
56
57
ADDITIONAL NOTES ADDED AT REV. A.
 15. TUBESHEET TO SHELL WELD-DYE PENETRANT CHECK ON ROOT RUN.
 16. TUBESIDE FLANGES TO HAVE 125 RMS FACE FINISH OR BETTER.
 17. TUBES TO BE WELDED TO BE MADE USING WIRE ES ELECTRODES

- GENERAL NOTES
1. MACHINE FACES WHERE MARKED S TO FINISH 125 RMS.
 2. ALL WELD PREPS. AS DETAILED ON SHEET 2 & PROCEDURES AS ON SEPARATE WELD DETAIL SHEETS OF CORRESPONDING FIGURE. FOR S.S. WELDS USE WELD CONSUMABLES HAVING A MAXIMUM CARBON CONTENT OF 0.025%.
 3. TUBES ARE TO BE ROLLER EXPANDED INTO GROOVED HOLES & SEAL WELDED. FOR TUBE FIXING PROCEDURE SEE SHEET 2.
 4. 10% SPOT RADIOGRAPHY ON ALL WELDED SEAMS.
 5. PRIOR TO FINAL ASSEMBLY, STUDBOLT THREADS & NUT CONTACT FACES TO BE COATED WITH GREASE.
 6. UNIT TO BE HYDRAULICALLY TESTED TO PRESSURES SHOWN FOR A MINIMUM PERIOD OF 30 MINUTES.
 7. PRIOR TO DESPATCH, UNIT IS TO BE THOROUGHLY CLEANED & FREE FROM OIL, GREASE, SPATTER, & DEBRIS.
 8. MINIMUM TEST WATER TEMPERATURE 70°F.
 9. TUBESHEET FACE & ALL FLANGE FACES NOT FITTED WITH BLIND FLANGES ARE TO HAVE HARDWOOD COVERS FITTED FOR TRANSPORTATION PROTECTION.
 10. BELLOW'S EQUIPPED WITH BOLTED LOCKING BARS FOR TRANSPORTATION PROTECTION.

REVISIONS


NO.	DATE	BY	DESCRIPTION
1

POSITION OF SHEET
 1. SHEET 5: MATERIAL LIST
 2. SHEET 4: GASKETS, INTERPLATE
 3. SHEET 3: TUBES, TUBE SHEET DETS
 4. SHEET 2: SHELL, TUBE BUNDLE & CHANNEL PLANTATION


CERTIFIED: [Signature]
 DATE: 12th Jan 1973

THIS DOCUMENT IS A PRIVATE AND CONFIDENTIAL COMMUNICATION AND THE PROPERTY OF ICI FIRES LIMITED, WARRINGTON, YORKSHIRE. IT MUST NOT BE COPIED OR LENT WITHOUT THE CONSENT OF ICI FIRES LIMITED AND MUST BE RETURNED WITH THE TENDER AND/OR ON COMPLETION OF THE ORDER.


HEAT TRANSFER LTD
 CHELTENHAM
 10.01/8584/1/E

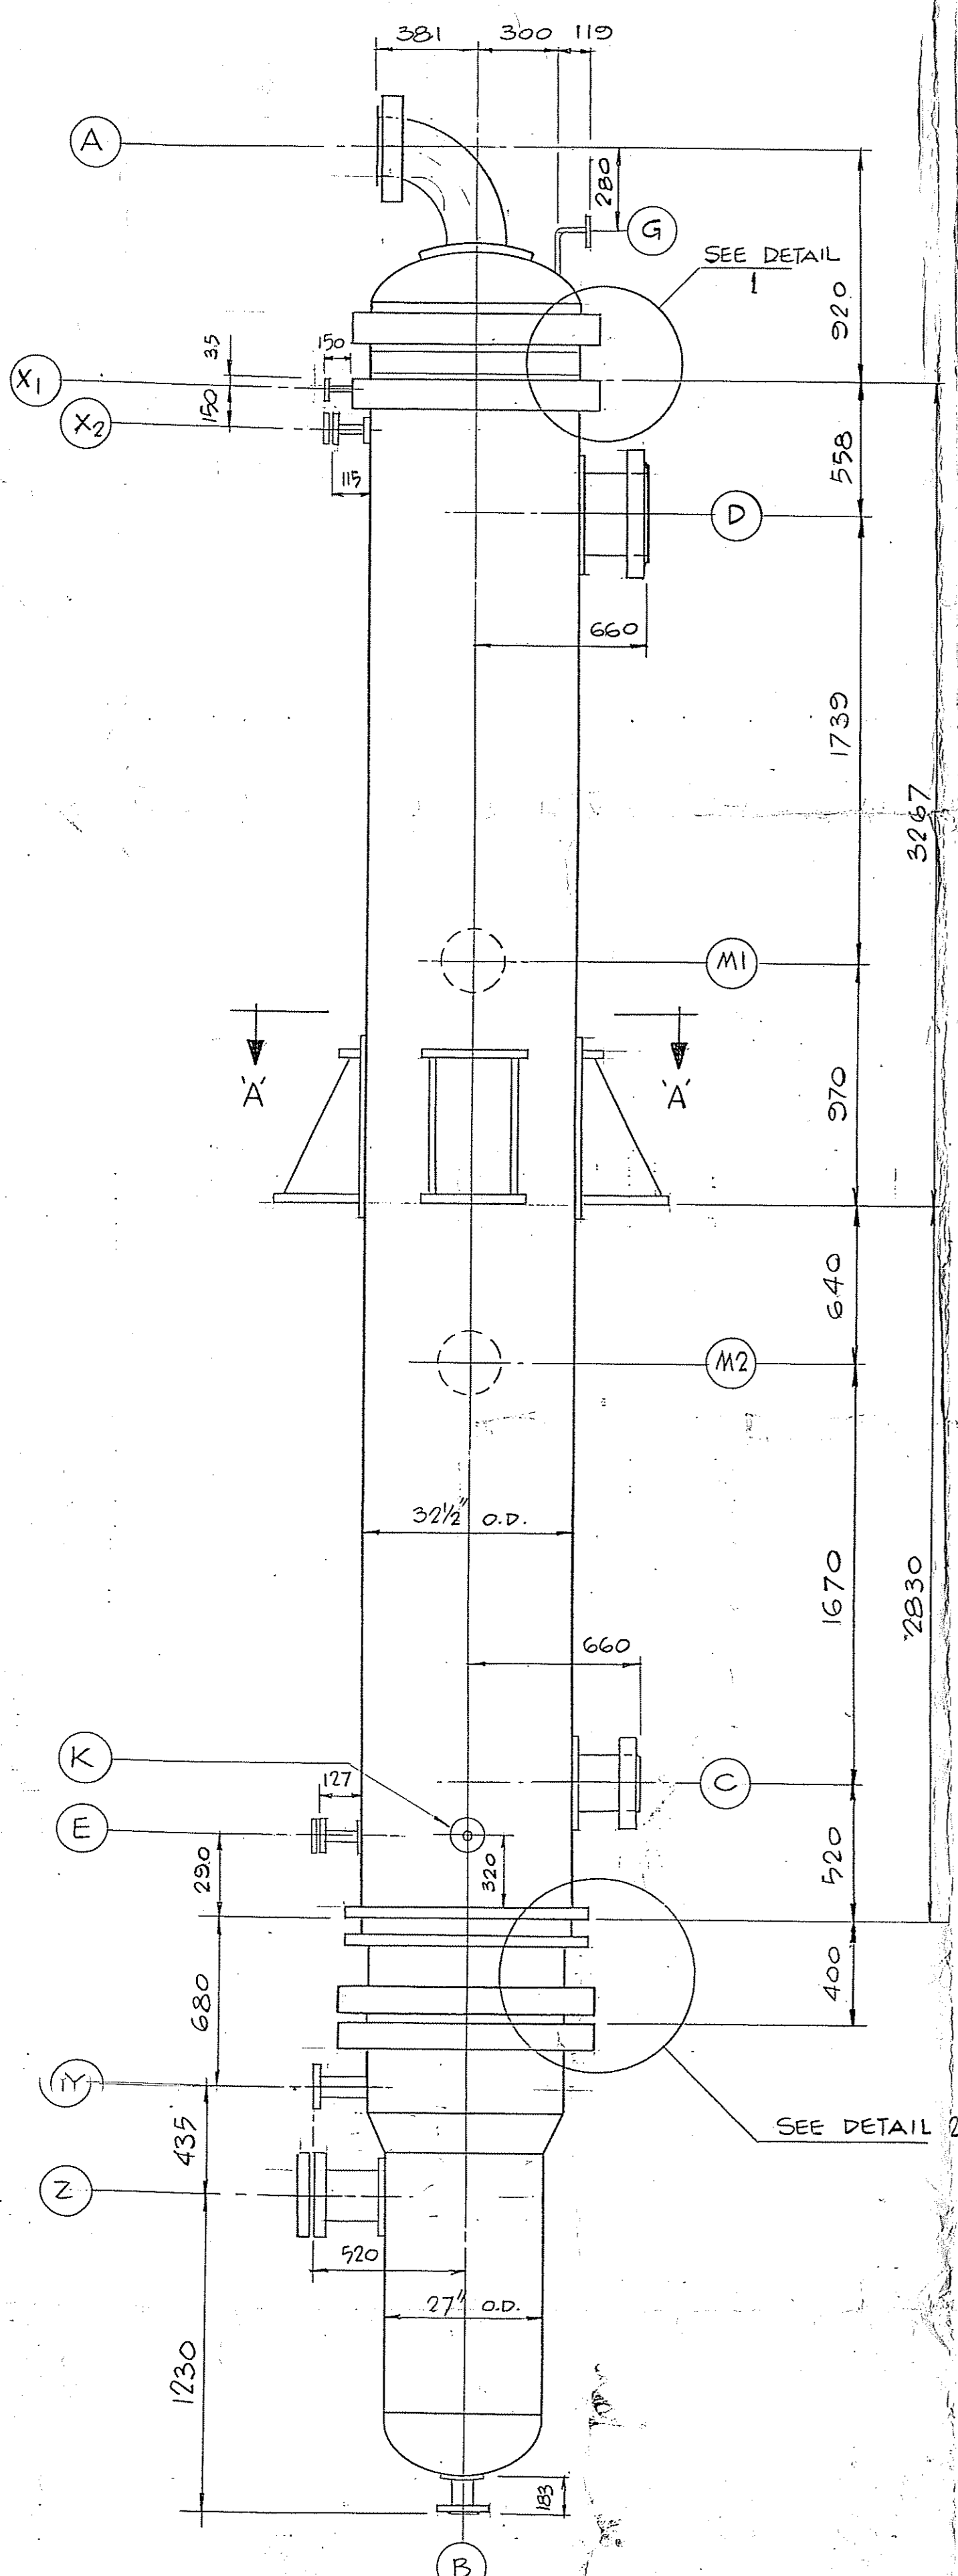


ELEVATION

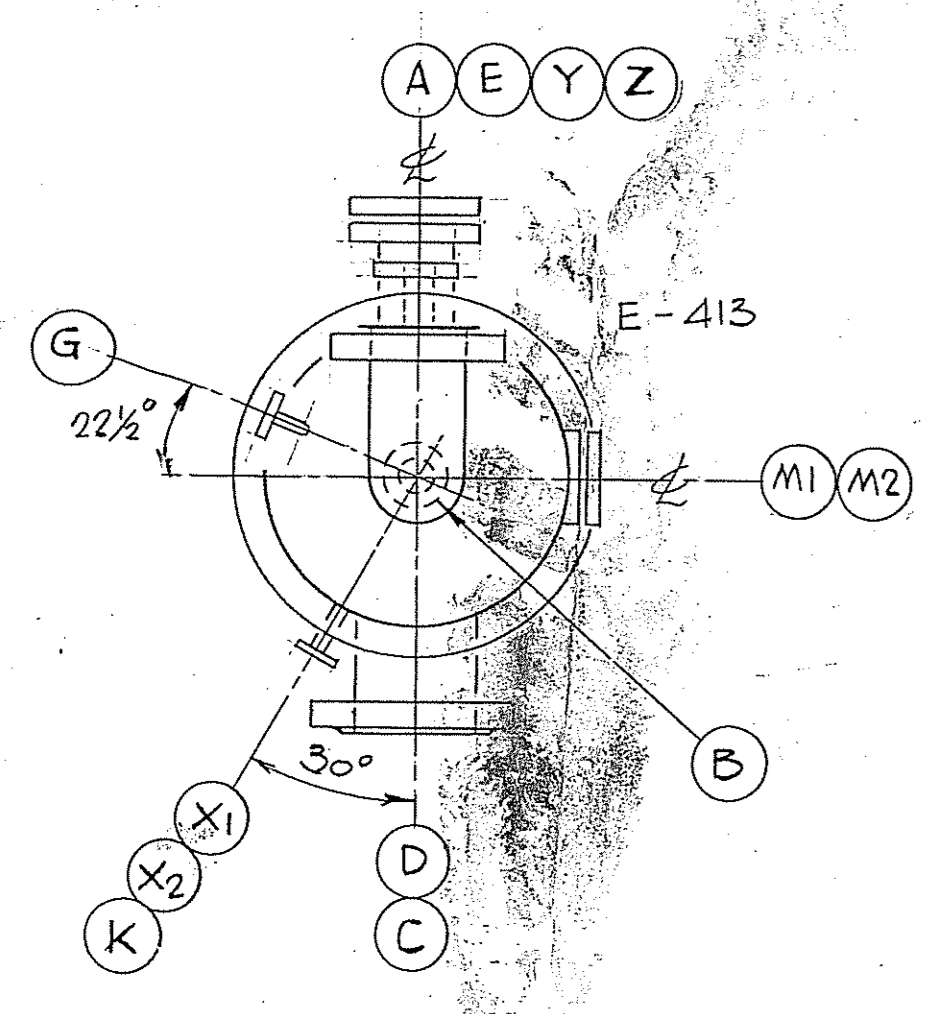

PLAN VIEW
(TRUE ORIENTATION)

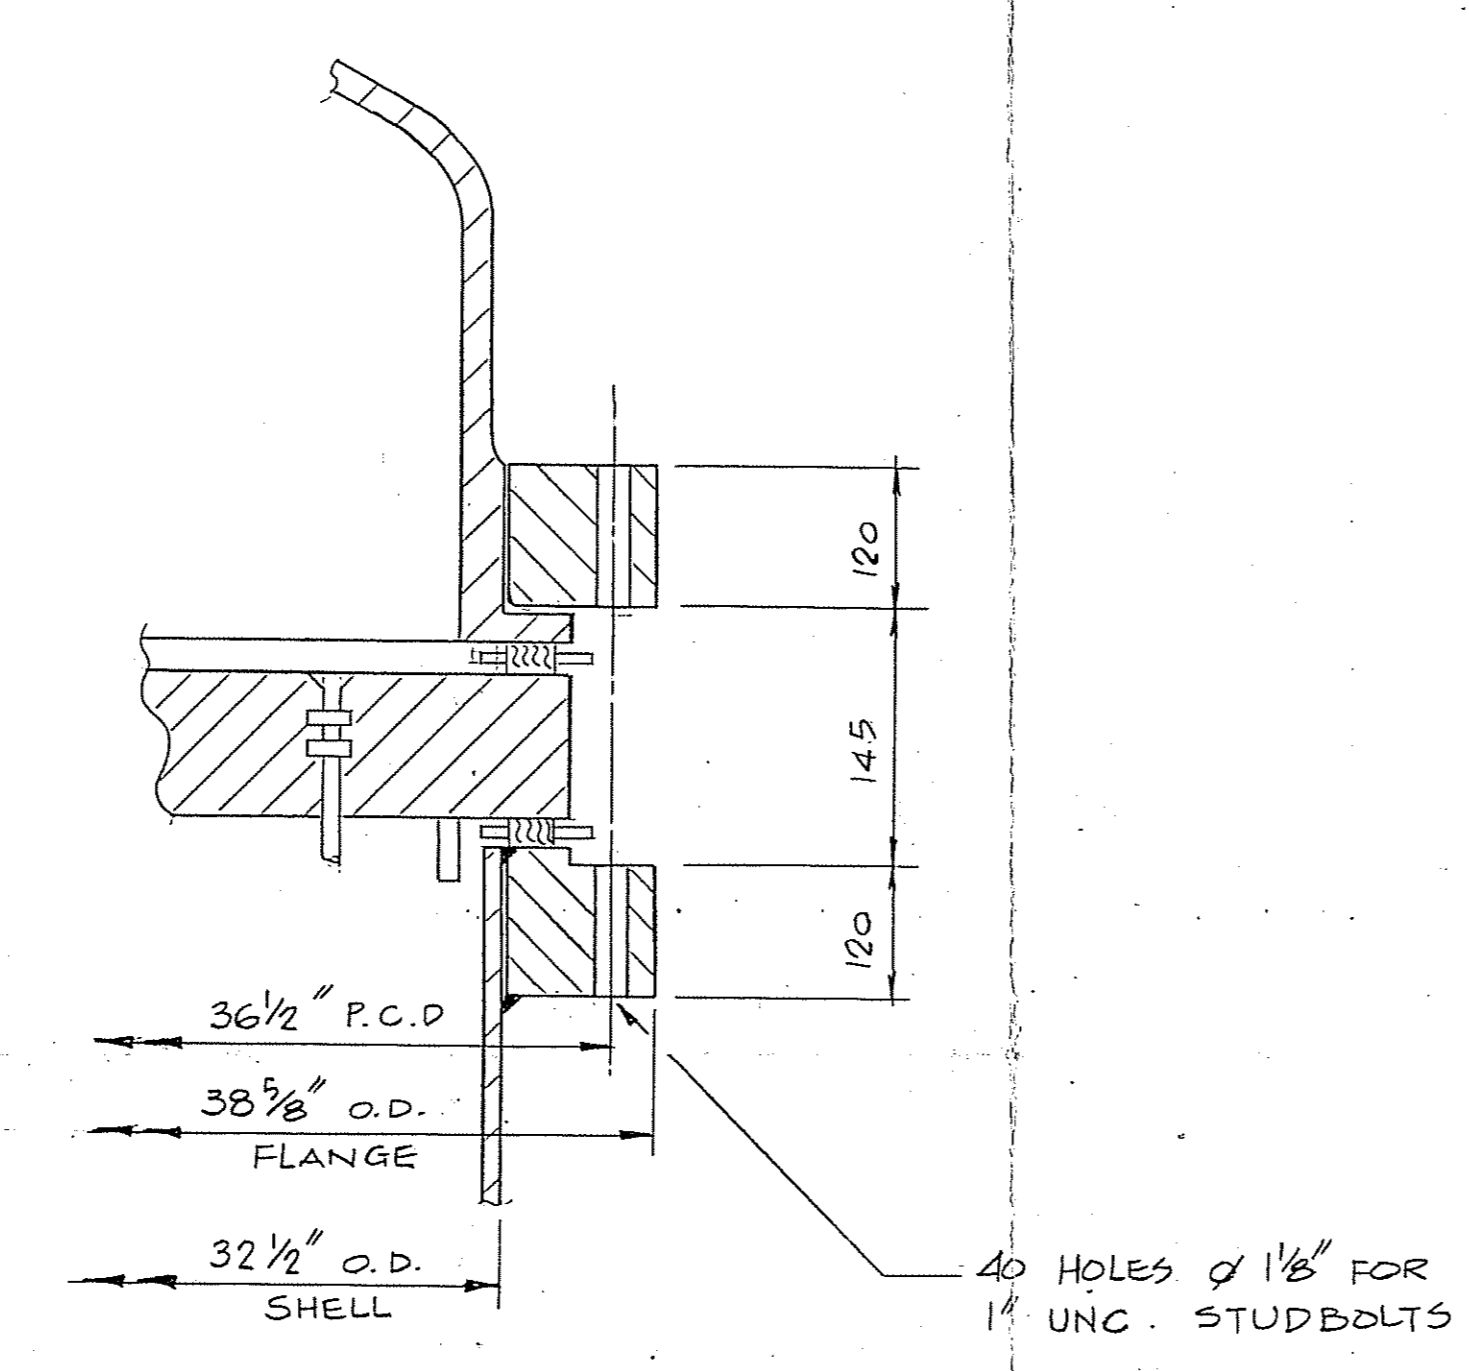


DETAIL 1

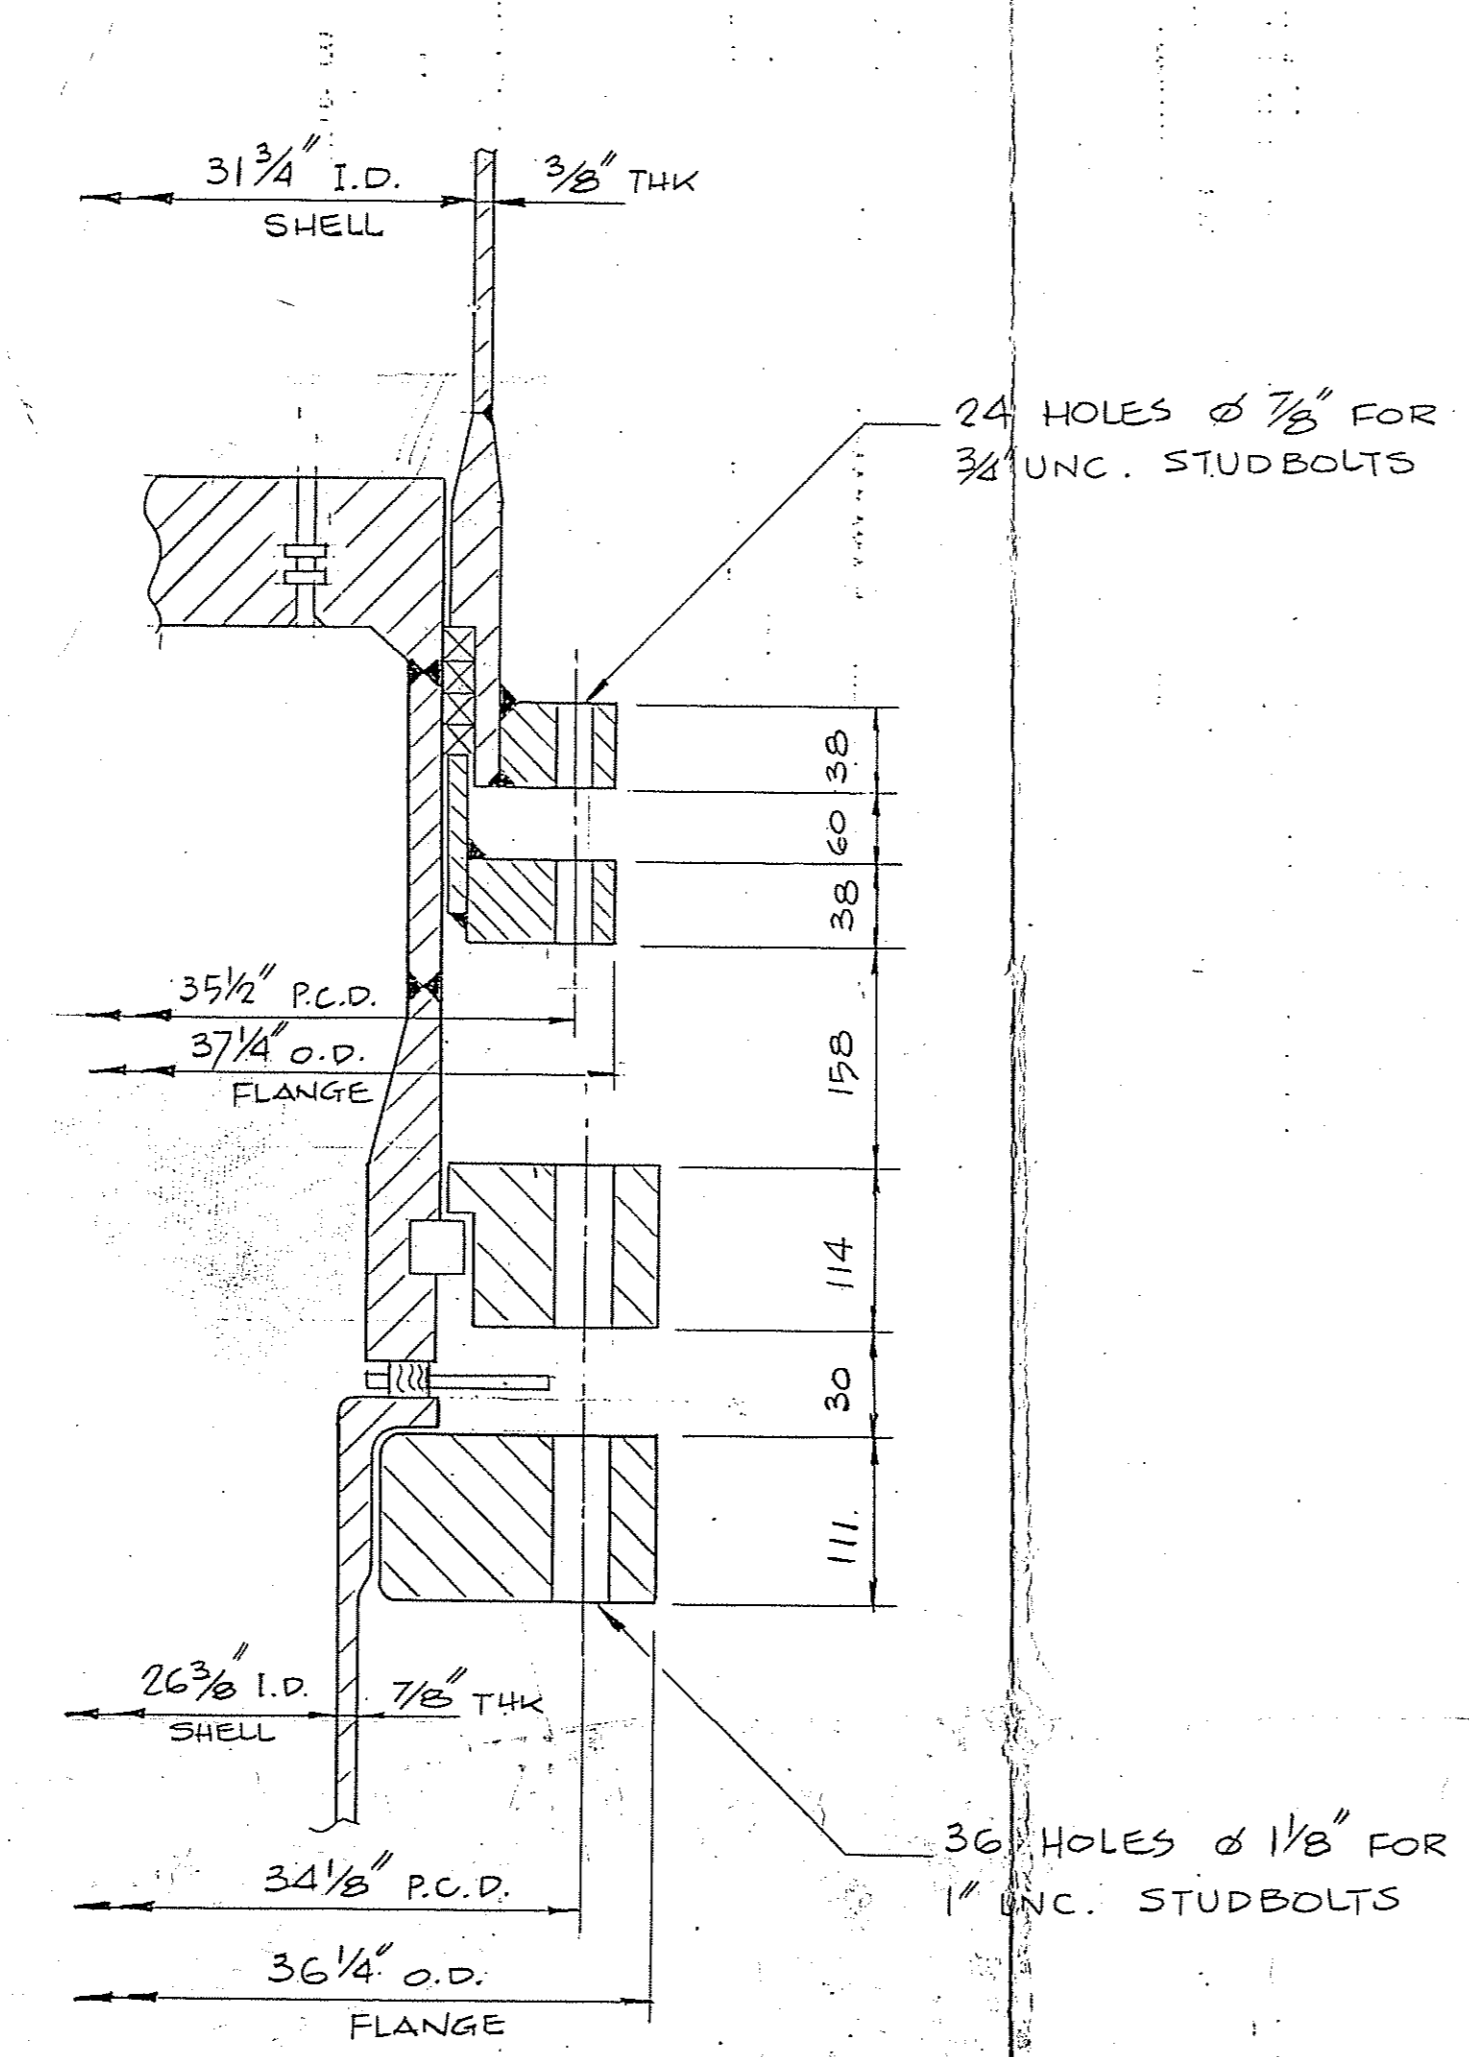


DETAIL 2

8 N° SLOTTED HOLES
Ø 22 x 45 LG FOR
M20 HEX. HEAD BOLTS

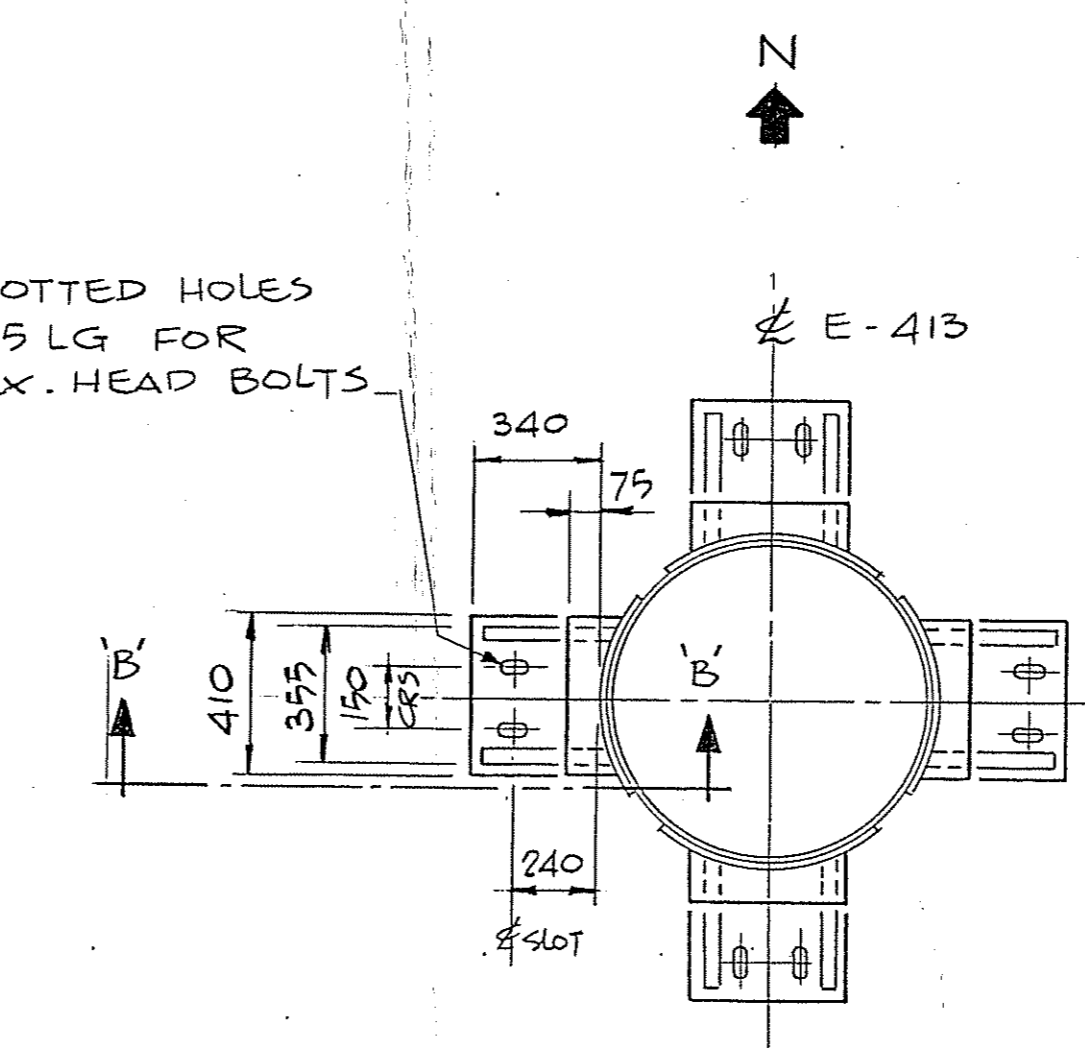

SECTION 'A-A'

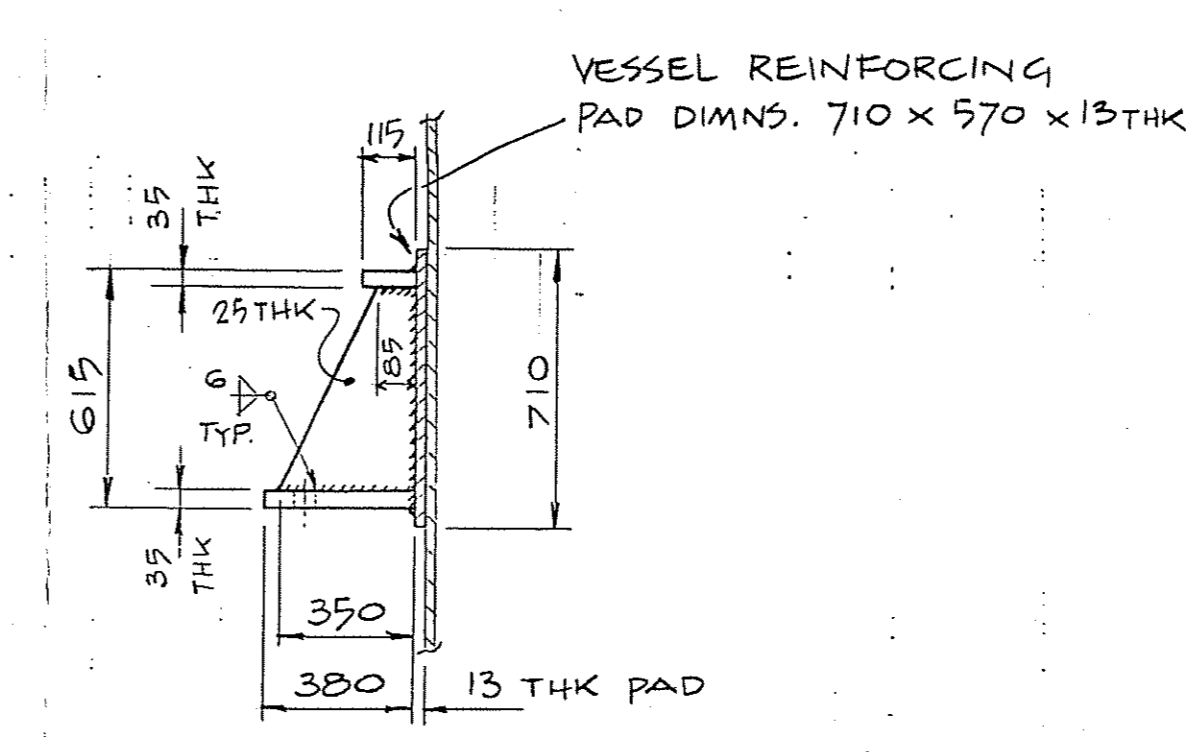

SECTION 'B-B'
(TYPICAL FOR 8 N°
VERTICAL GUSSET PLATES)

GENERAL NOTES

- ALL DIMENSIONS GIVEN ON THIS DRAWING REFLECT THE 'AS BUILT' STATUS OF VESSEL E-413/3
- VESSEL BODY FLANGES ARE SHOWN WITH O.D. AND P.C.D. IN IMPERIAL DIMENSIONS FOR PURPOSES OF RE-MATCHING

NOZZLE DATA

MARK	SIZE	RATING	FACING	WALL THK	SERVICE
A	10" NB	300#	L.J.	EX. STA	PROCESS IN
B	3" NB	300#	R.F.	SCH 40	PROCESS OUT
C	8" NB	150#	R.F.	SCH 40	CONDENSATE IN
D	14" NB	150#	R.F.	SCH 40	STEAM & WATER OUT
E	1 1/2" NB	150#	R.F.	SCH 40	BLOWDOWN CONN. (BLANKED)
G	1" NB	300#	L.J.	SCH 160	CAUSTIC CONN. (BLANKED)
M1	6" NB	150#	R.F.	PAD	INSPECTION (BLANKED)
M2	6" NB	150#	R.F.	PAD	INSPECTION (BLANKED)
X1	1" NB	150#	R.F.	SCH 80	RELIEF
X2	1" NB	150#	R.F.	SCH 80	VENT (BLANKED)
K	1" NB	150#	R.F.	SCH 80	DRAIN CONN. (BLANKED)
Y	3" NB	300#	R.F.	SCH 40	WATER INLET
Z	8" NB	300#	R.F.	SCH 40	INSPECTION (BLANKED)

UNSERVICED COPY

-9 SEP 1991

WILL NOT BE UPDATED

K. HOME ENG. JOB N° 90-2620

DRAWING PREPARED BY
K. HOME ENGINEERING LTD
Thornaby Cleveland


ISSUE	REVISIONS	INTL	DATE	DRAWING No.	REFERENCE DRAWINGS
A	APPROVED FOR INFORMATION (SEE NOTE 1)	CDC	16/4/91		

I.C.I. CHEMICALS & POLYMERS LTD.
TEESSIDE OPERATIONS - ENGINEERING
- WILTON, MIDDLESBROUGH, CLEVELAND.


THIS DRAWING IS A PRIVATE AND CONFIDENTIAL COMMUNICATION AND THE PROPERTY OF IMPERIAL CHEMICAL INDUSTRIES C & P LTD. IT MUST NOT BE COPIED OR LOANED WITHOUT THE CONSENT OF ICI AND MUST BE RETURNED.

JOB No. / E.W.D. No.	DRAWN A. PAISLEY 25/9/90	PLANT TA-T7	TITLE 'AS-BUILT' G.A. OF E-413 REACTOR CONDENSER	DRG. SIZE DE
D.O. REF. No. 900 167	CHECKED - D. NASSAU 26/9/90	BUSINESS AREA OXIDATION		
CALC. No.	APPROVED [Signature] 16/4/91	MATL LIST	DRG. No. D/A7/14/5922	ISSUE A
SCALE 1:20	[Signature]	PROJECT No.		


DRG. No. D/A7/14/5922

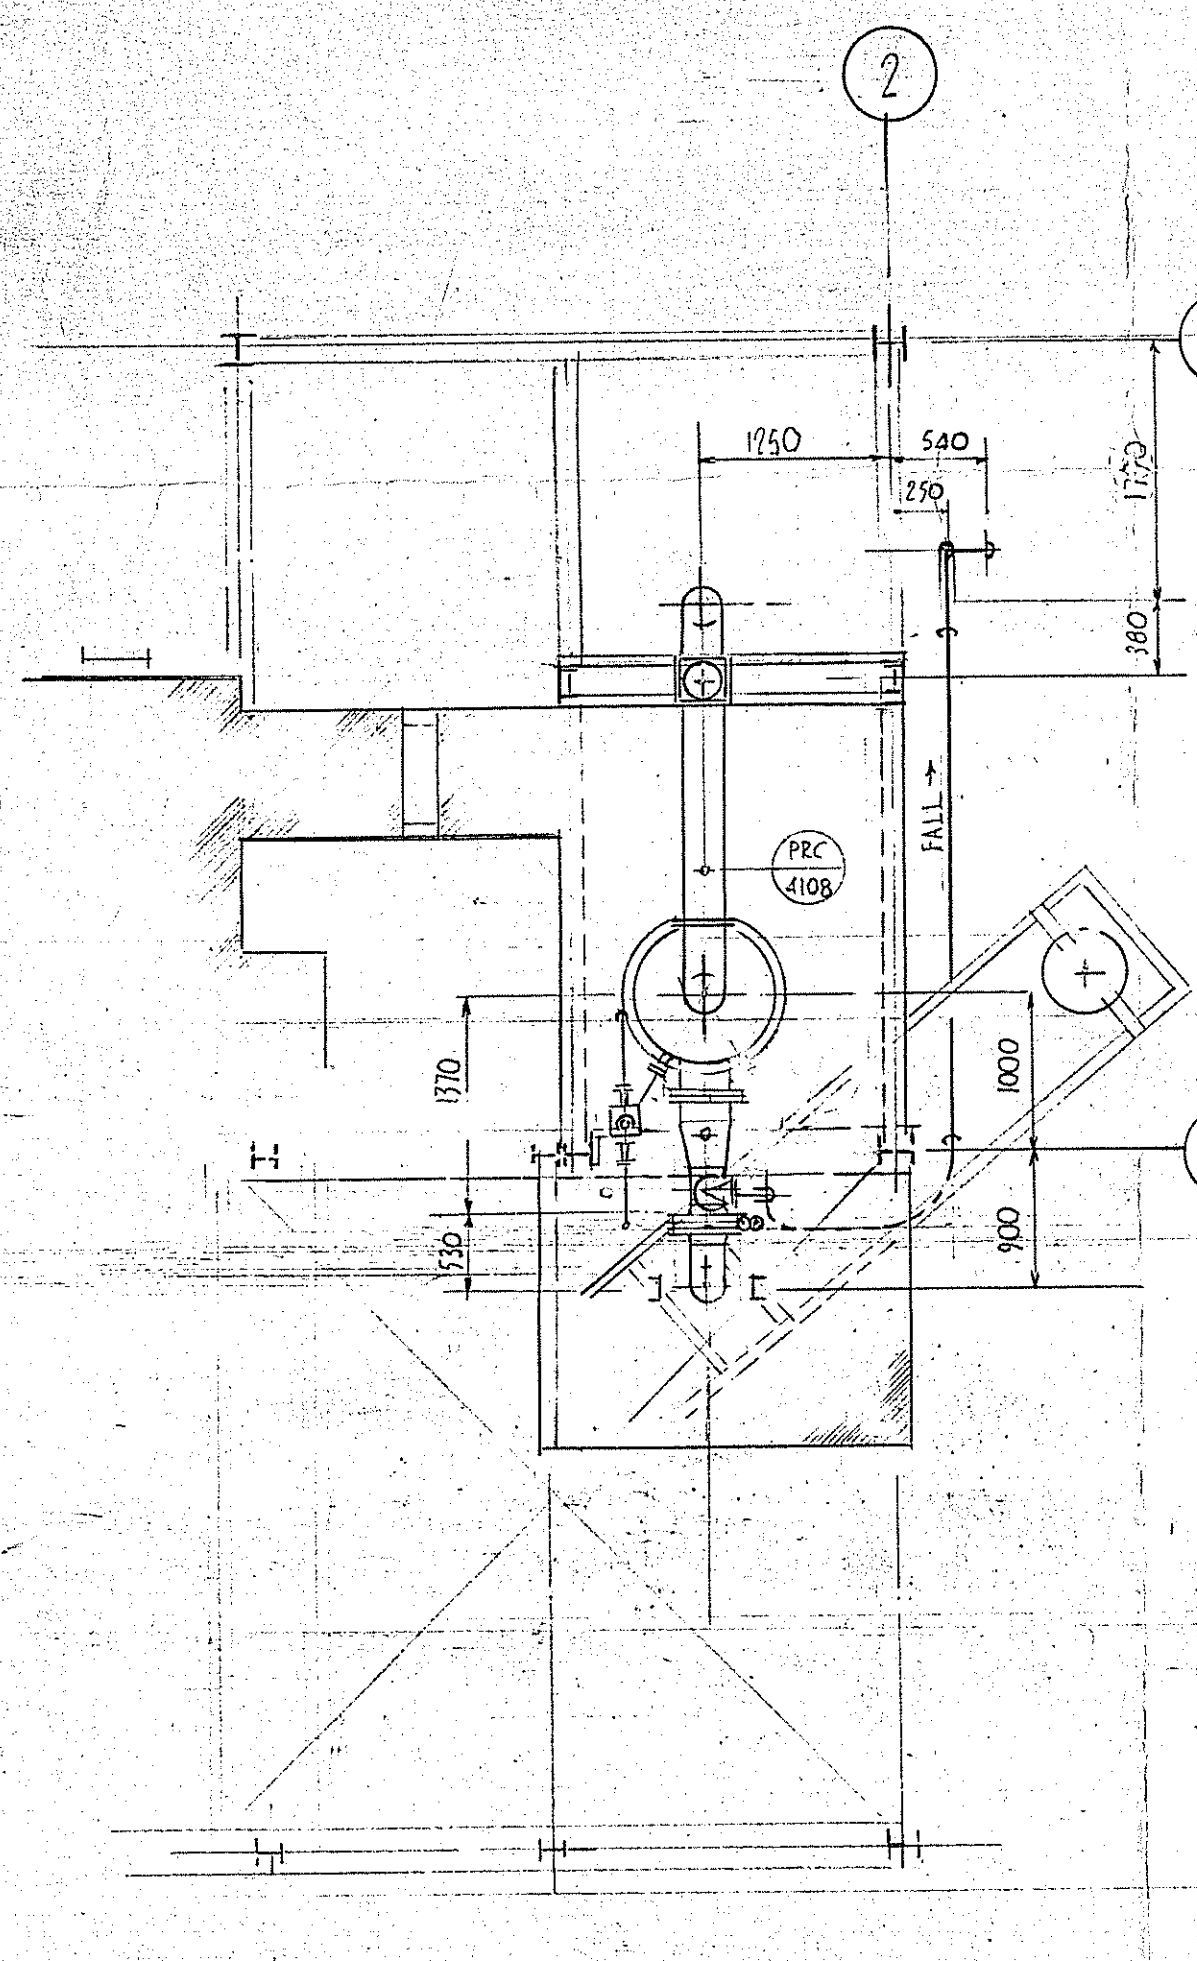


PLAN @ 22682 LV

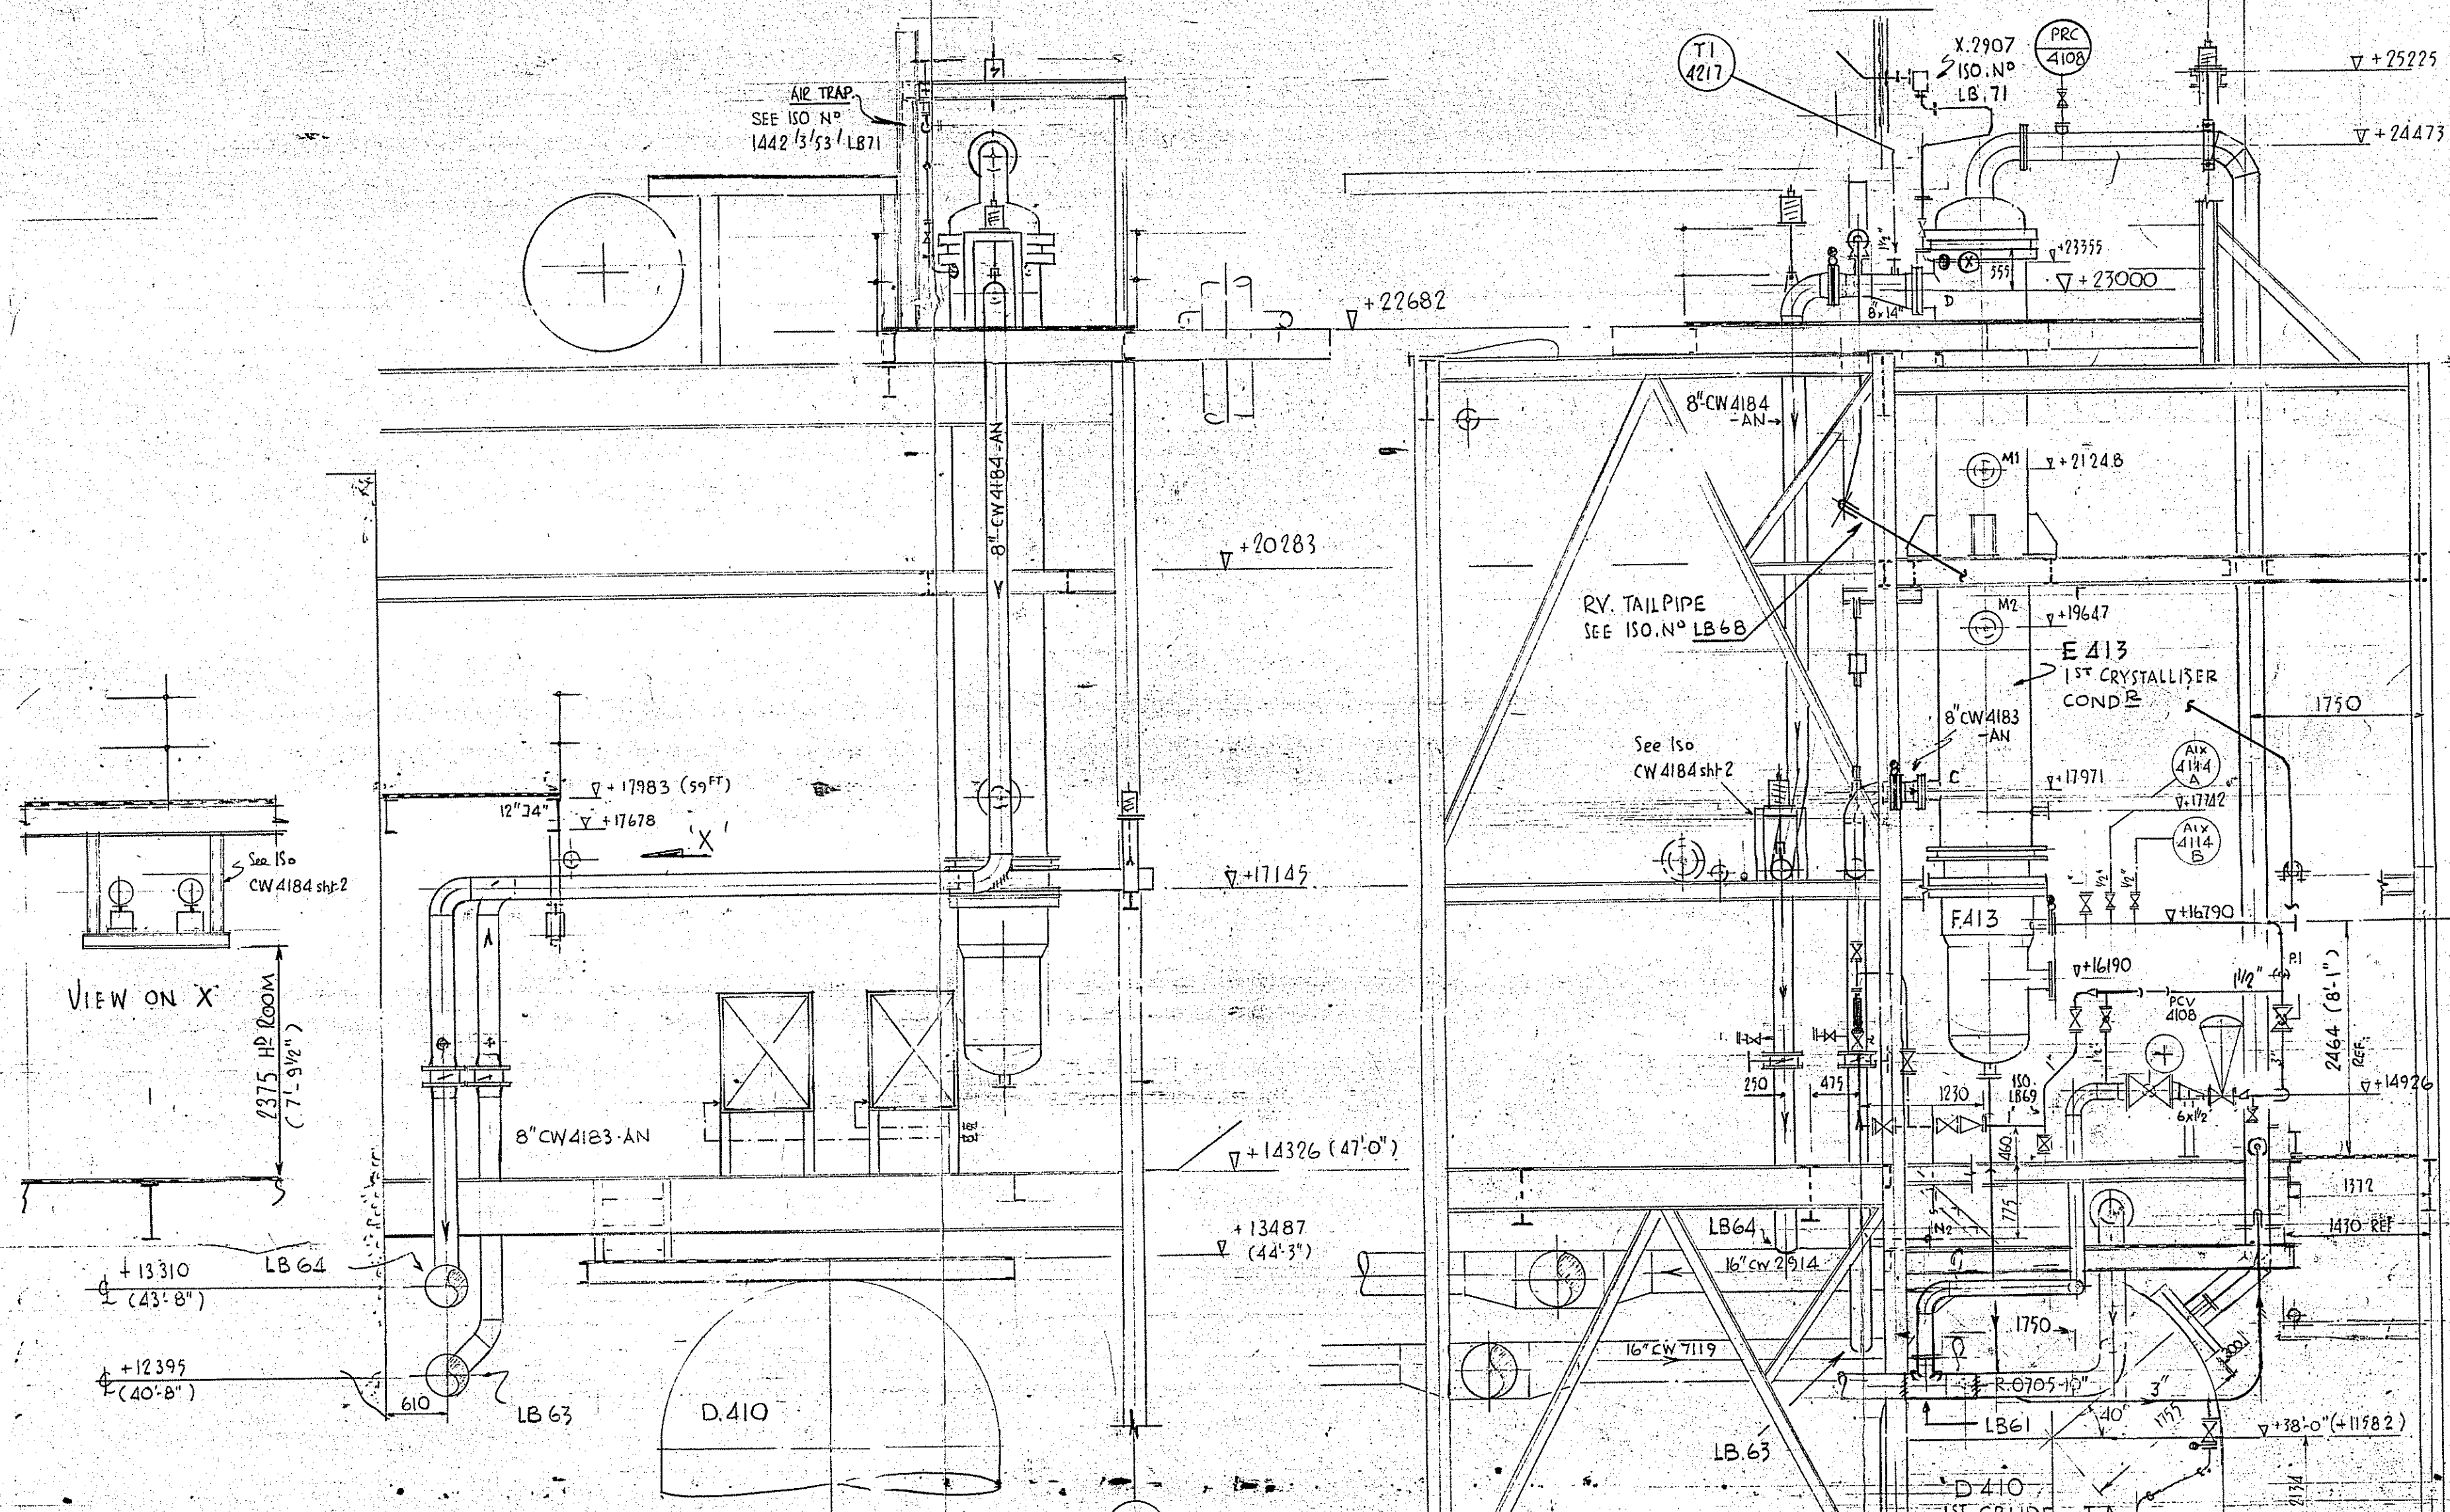


ELEVATION ON 'A-A' (LOOKING NORTH)

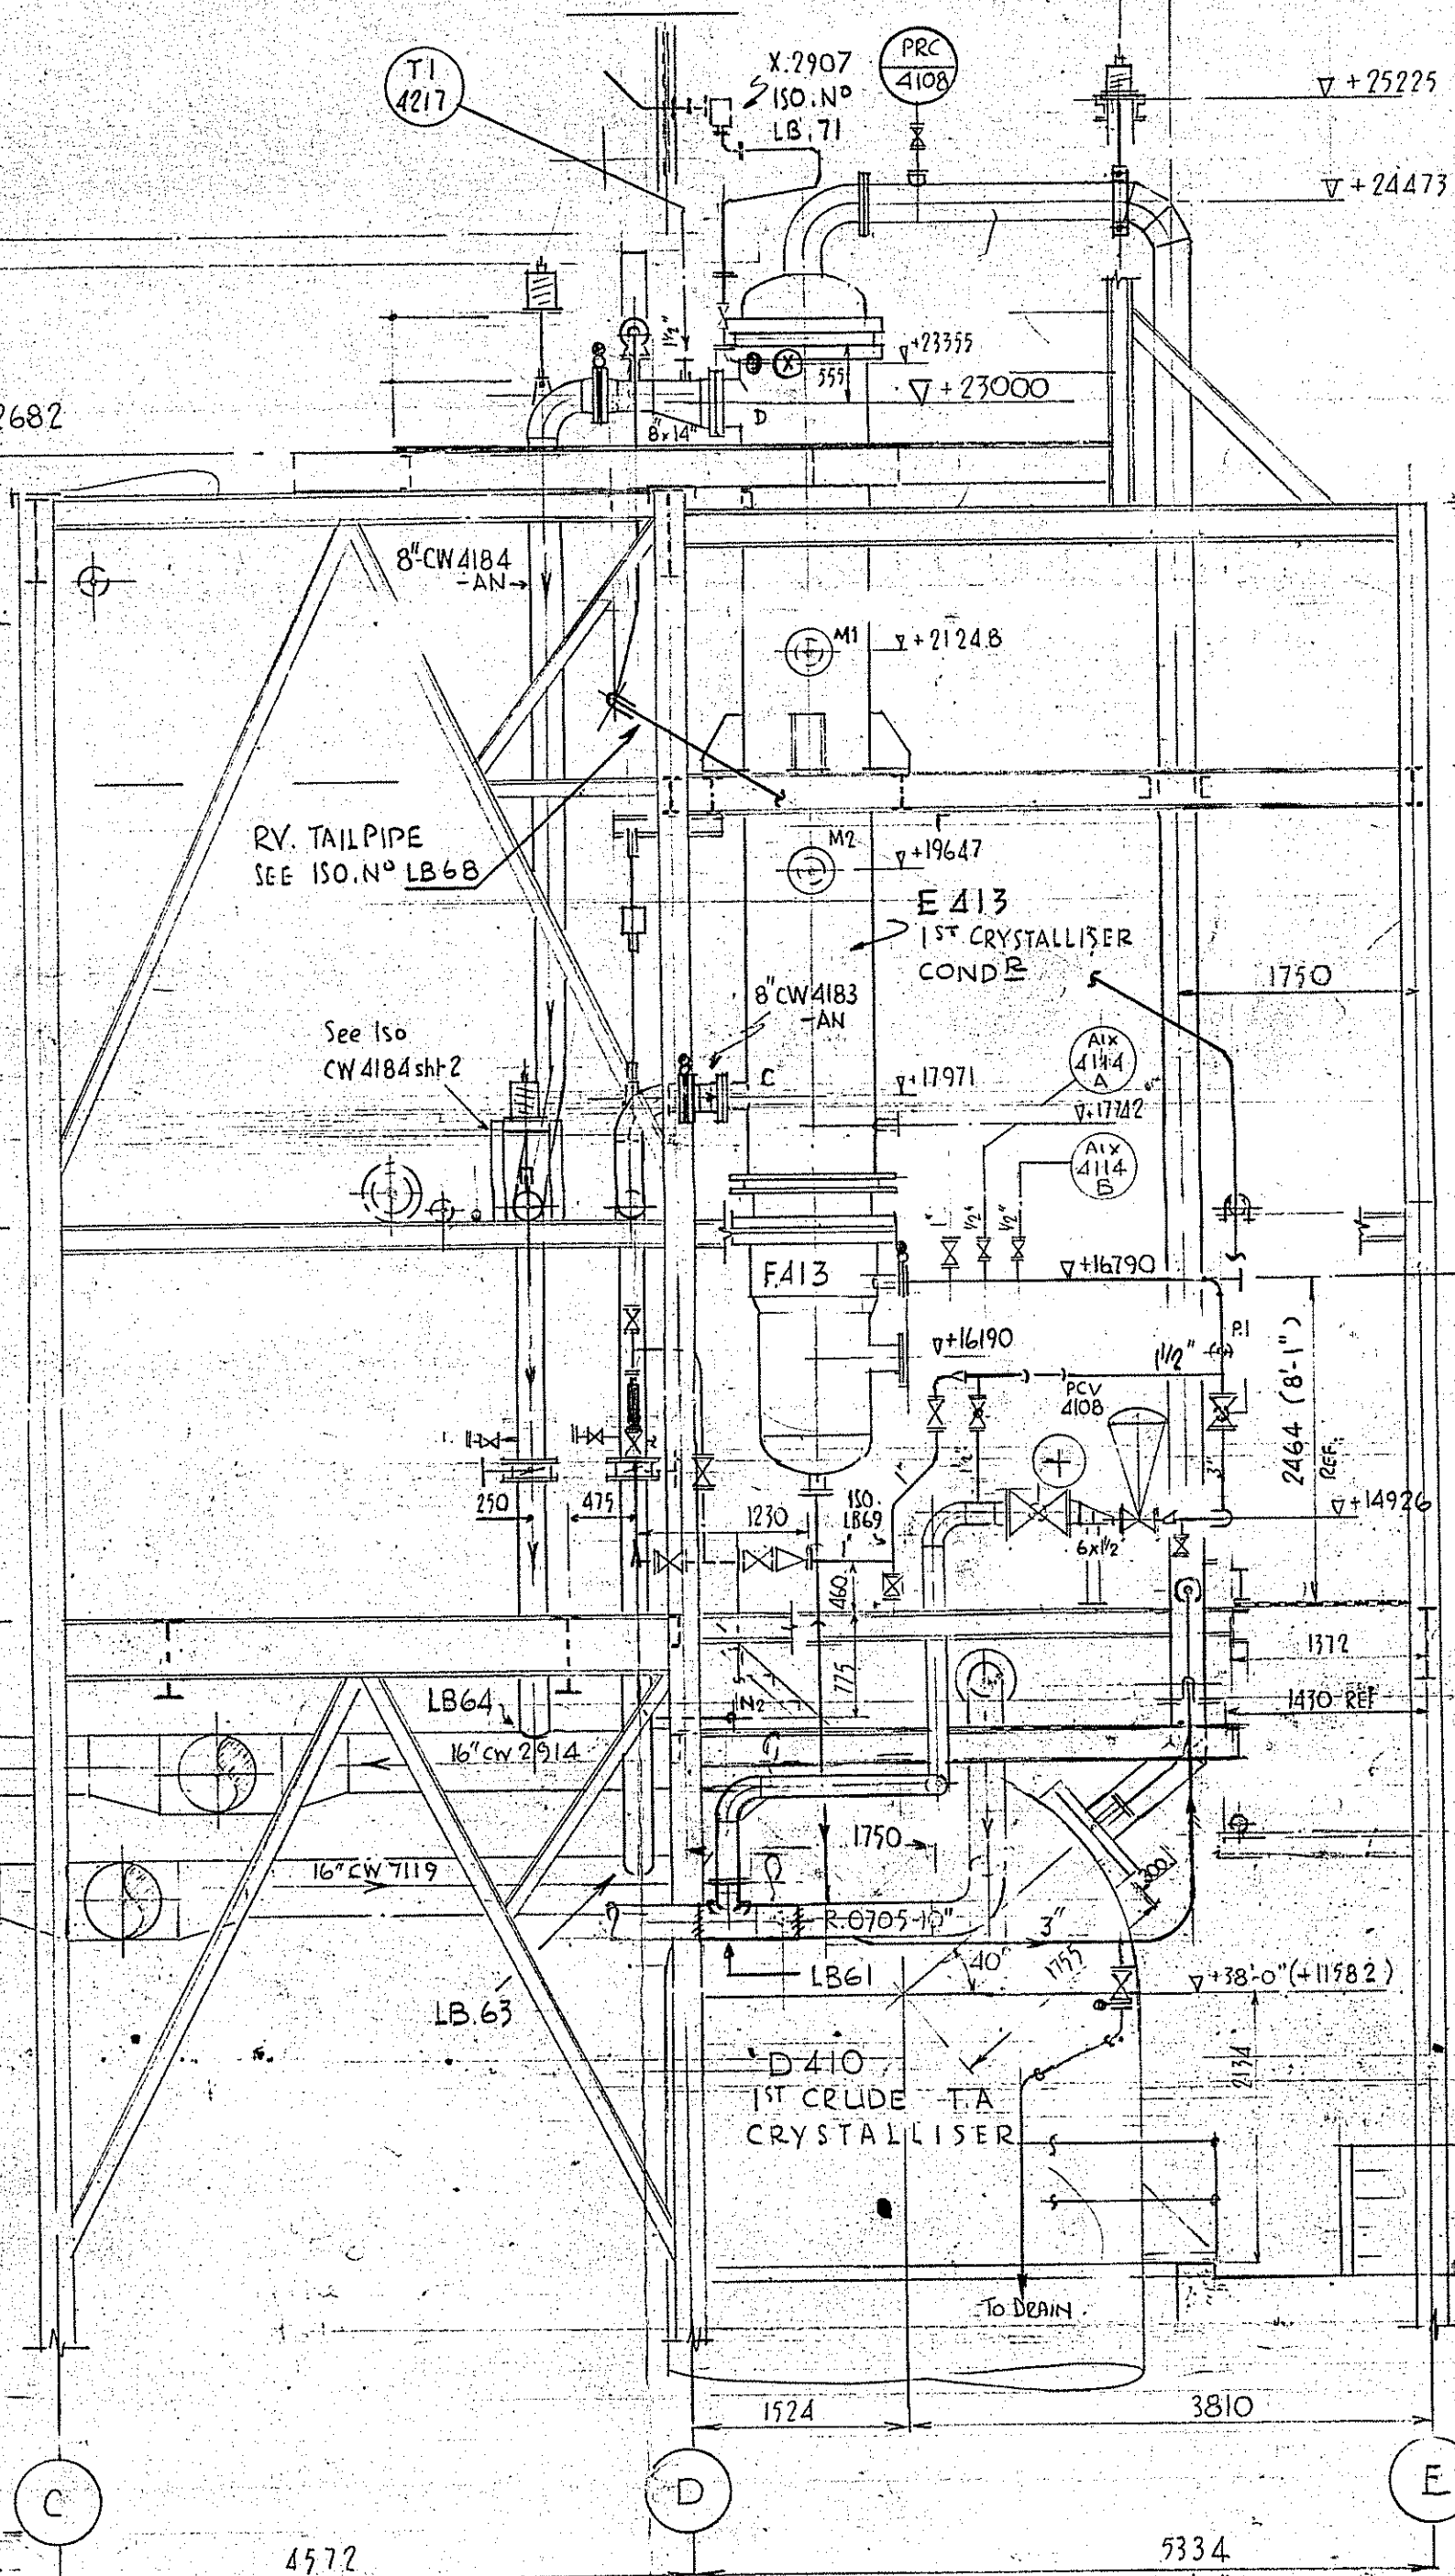


ELEVATION LOOKING WEST ON 'B-B'

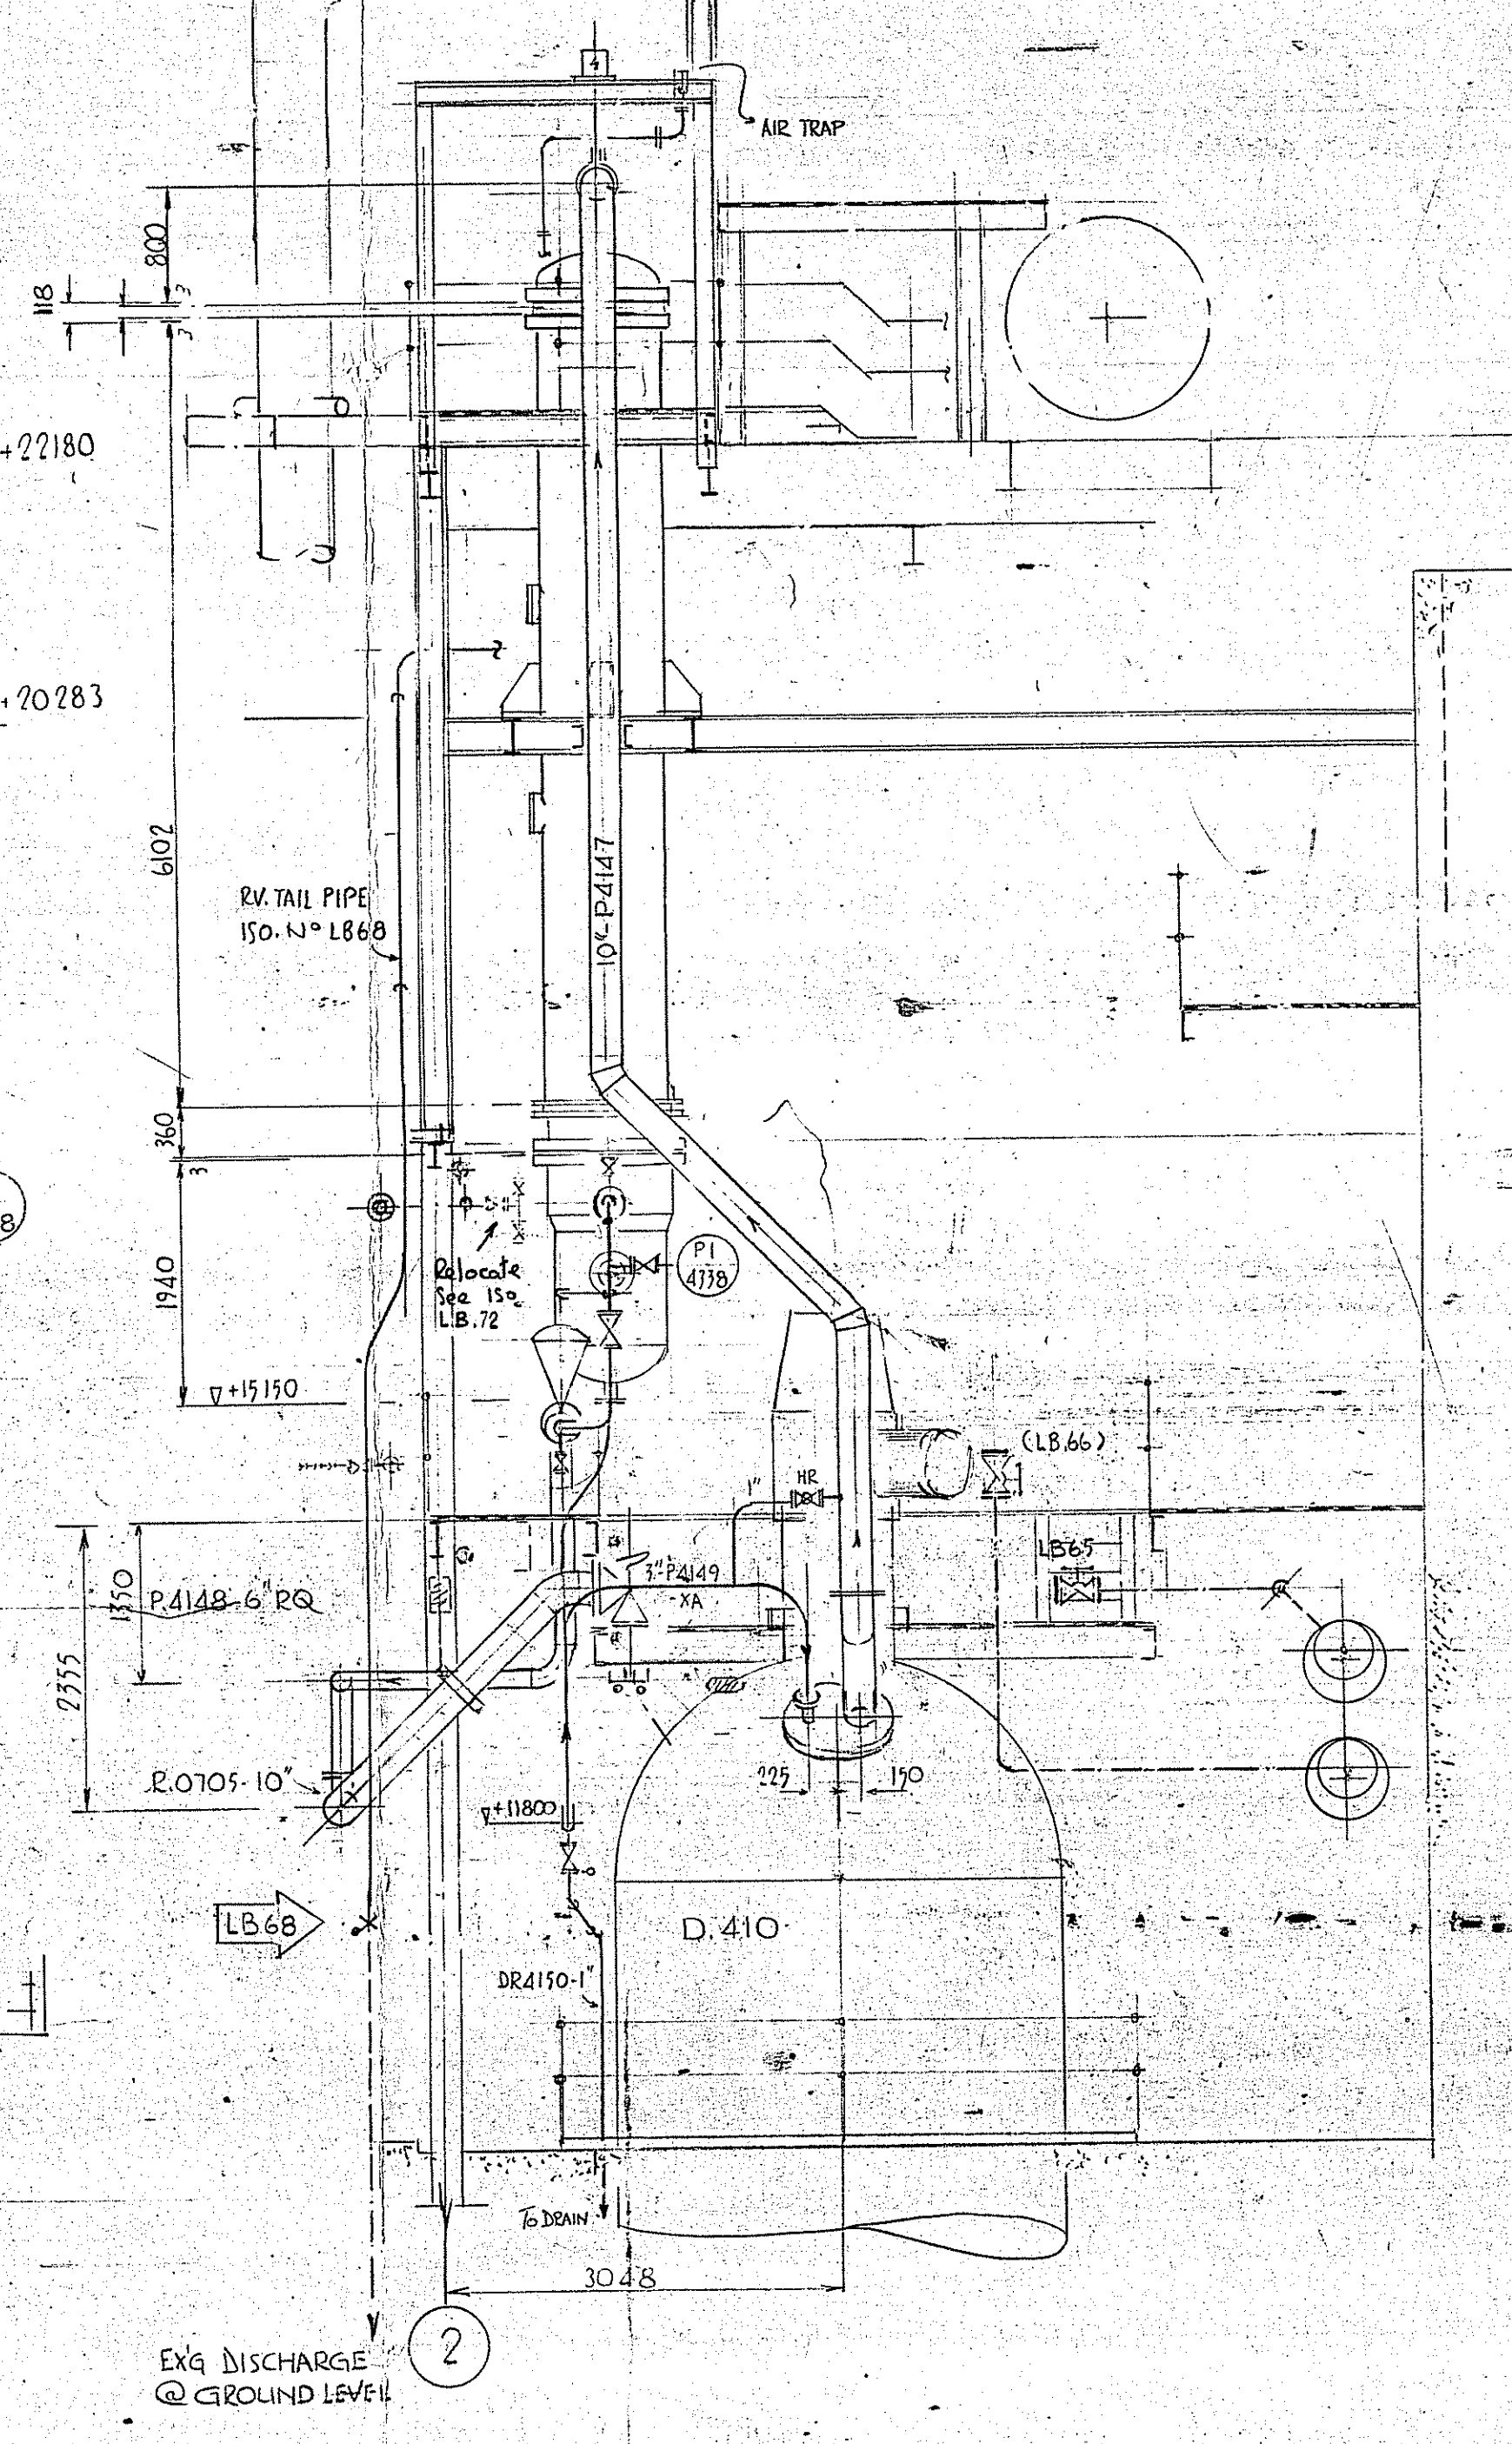

ELEVATION LOOKING SOUTH

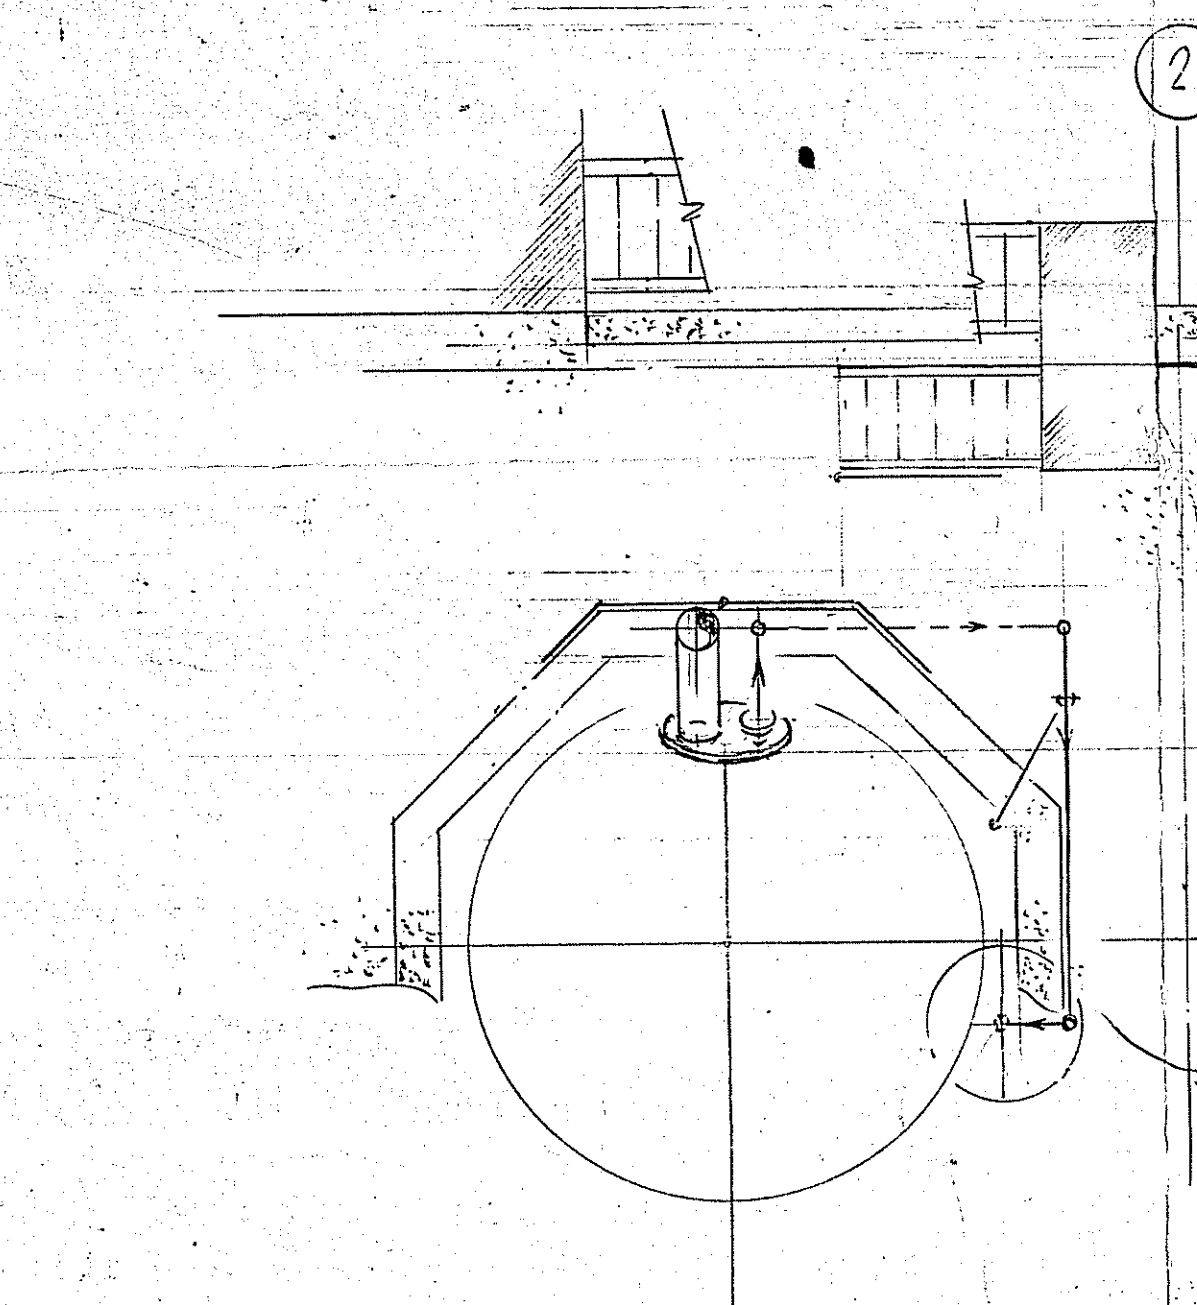

PLAN @ +9576 LV

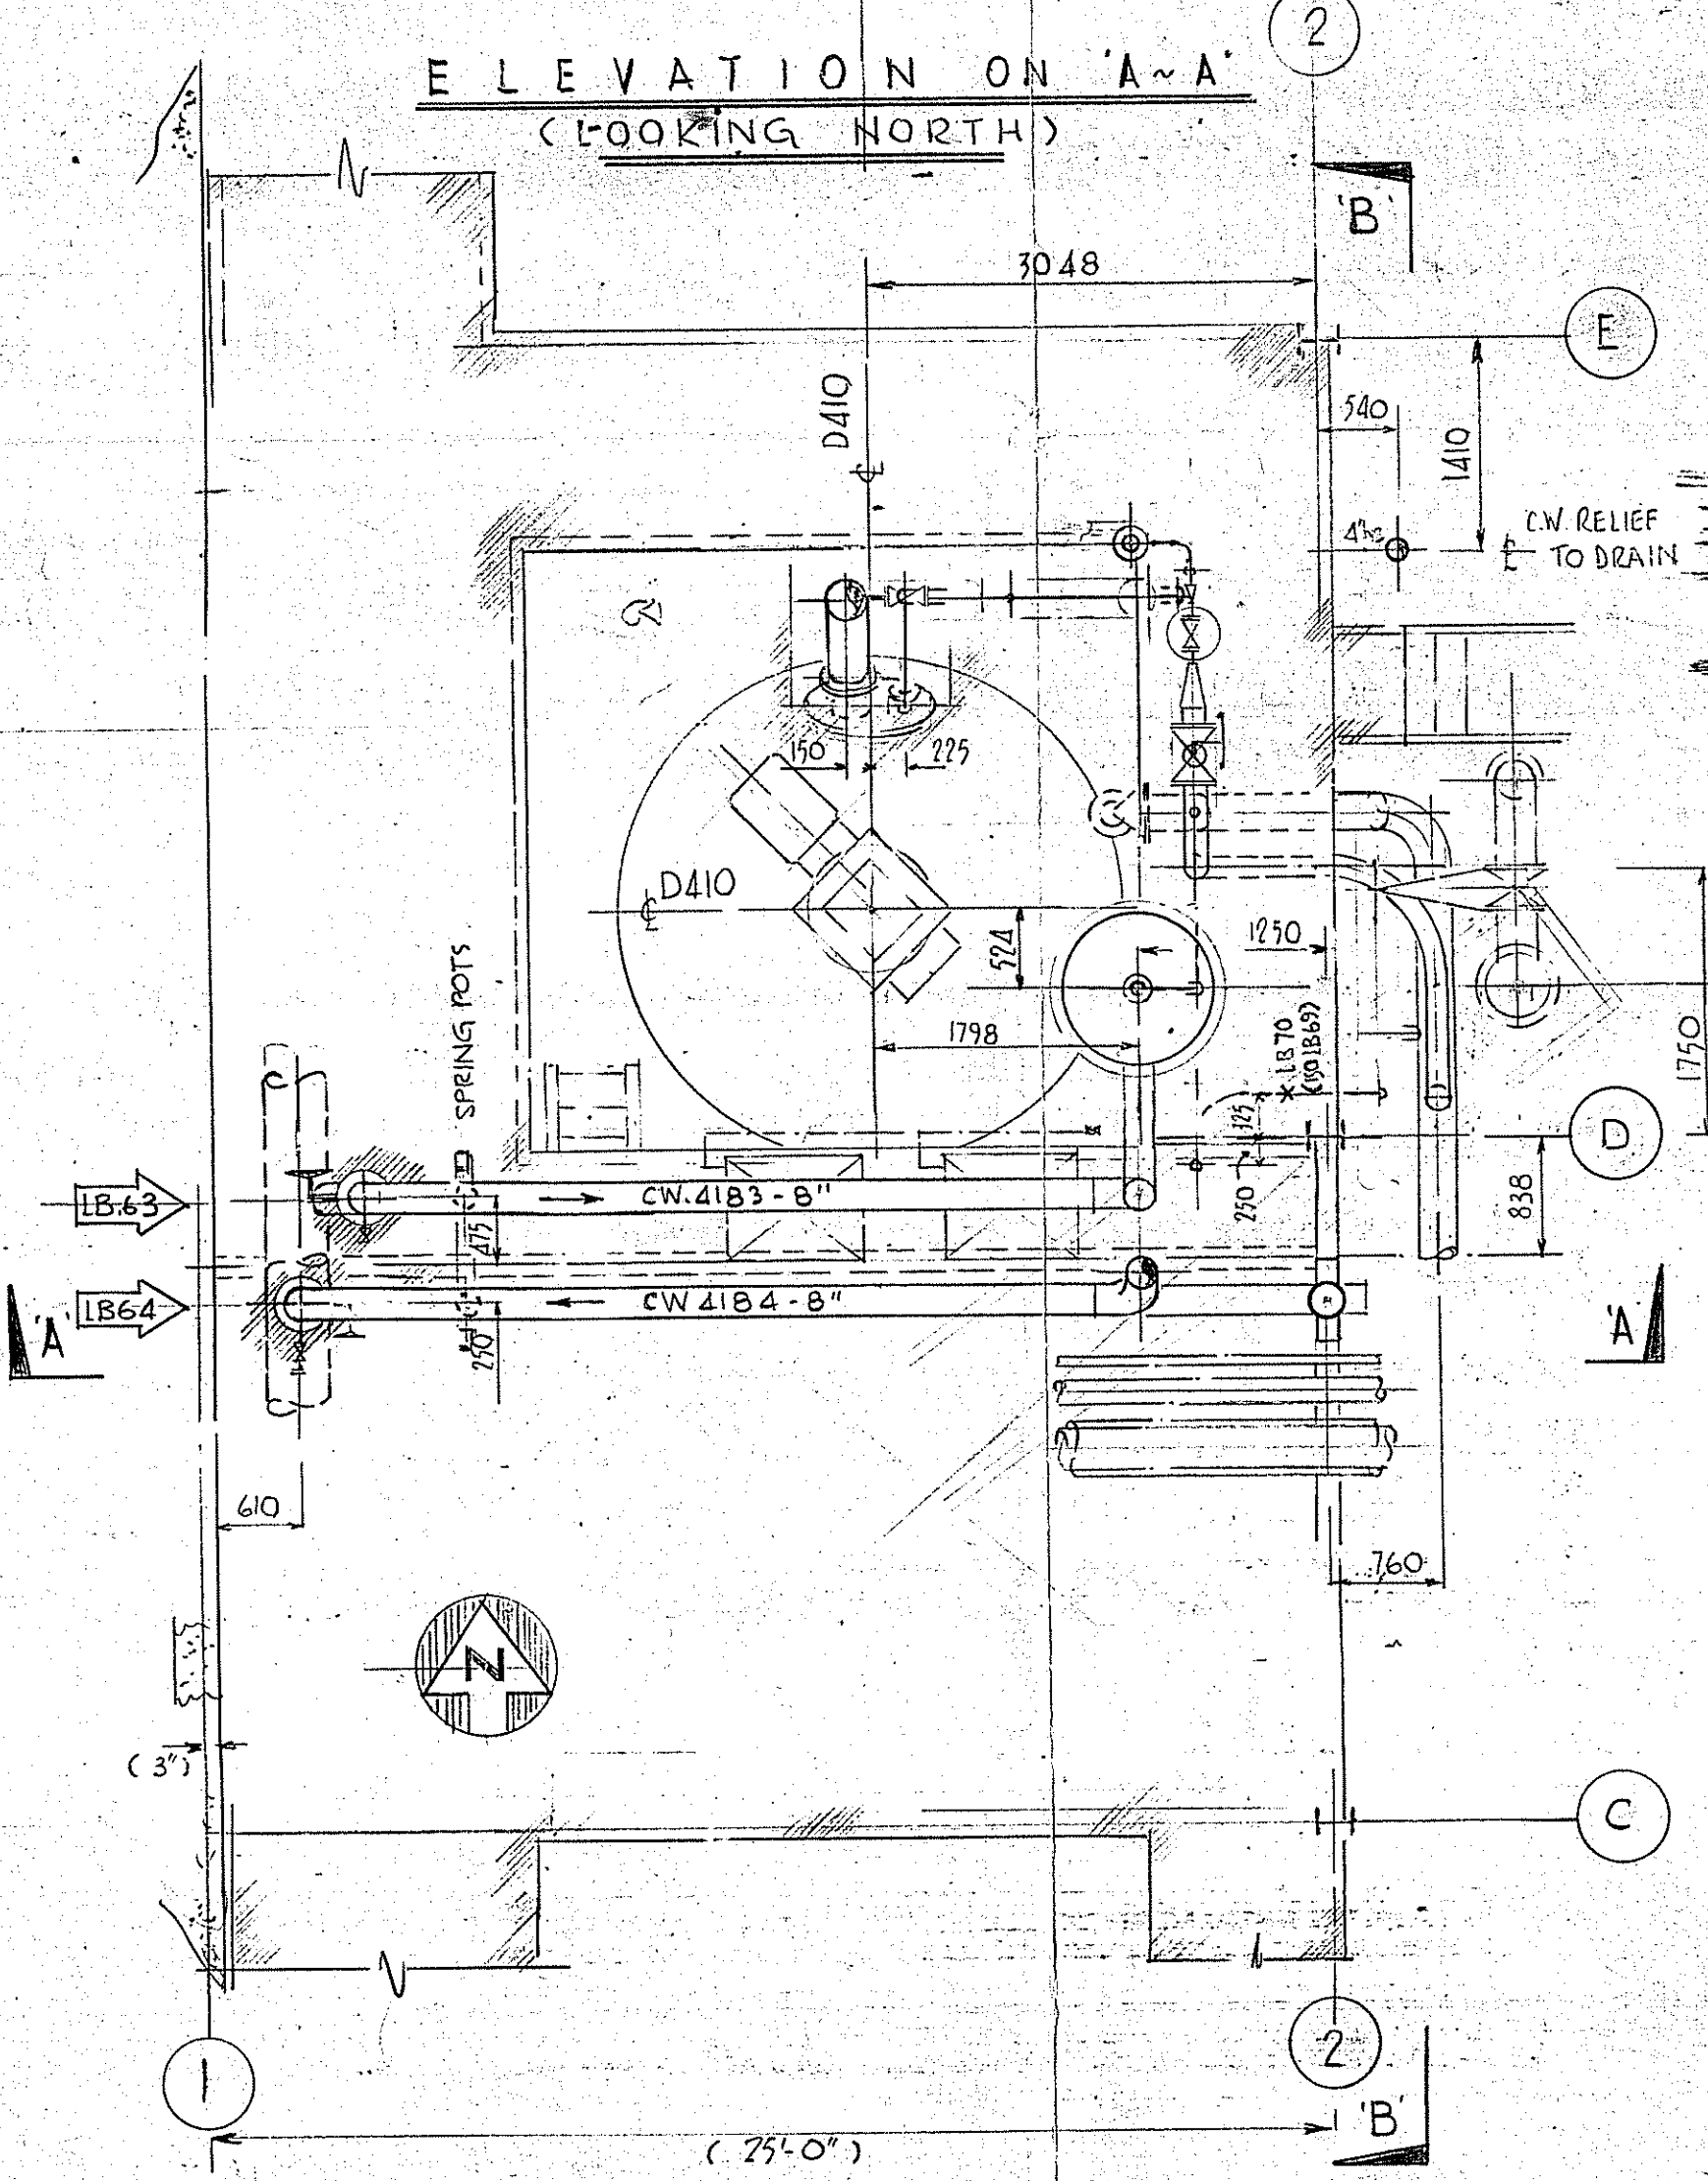

PLAN @ +14236 LV (47'-0")

- NEW PIPEWORK / SLIPSTOPS REF. NOS
ISOMETRICS 1442 13/53/1-
- CW. 4183
 - CW. 4184 SH1 1/2
 - CW. 4184 SH2 2/2 - SUPPORTS
 - DR. 4150
 - LB. 62 - STRIPPING OUT & BLK'ING OFF
 - LB. 65 - STRIPPING OUT & BLK'ING OFF
 - LB. 66
 - LB. 69
 - LB. 71
 - LB. 72
 - P.4146 SH1 1/2
 - P.4146 SH2 2/2
 - P.4149
 - W/TA 630623 - 10" TITANIUM LINE P.4147

THIS DRAWING IS A PRIVATE AND CONFIDENTIAL COMMUNICATION AND THE PROPERTY OF IPIIPL CHEMICAL INDUSTRIES PLC. IT MUST NOT BE COPIED OR LOANED WITHOUT THE CONSENT OF IPIIPL AND MUST BE RETURNED.

SCALE 1/8"

DRAWN: W/TA 62732





CHECKED: W/TA 62732

APPROVED: W/TA 62732


I.C.I. PLC, ENGINEERING DEPT., NORTH EAST GROUP, BILLINGHAM, CLEVELAND.

ISSUE	REVISIONS	GRID	PARTS LIST	INITIAL	DATE
(B)	FIRST OFFICIAL ISSUE				07/85
TITLE: TA-T7 OXIDATION AREA TREATING - WILTON					
SUB-TITLE: PIPING G.A. FOR 1ST CRYSTALLISER COND					
PROJECT NO. 87001					
DRAWING NO. W/TA 630479					
ISSUE NO. B					

ISSUE	REVISIONS	GRID	PARTS LIST	INITIAL	DATE
(B)	FIRST OFFICIAL ISSUE				07/85
TITLE: TA-T7 OXIDATION AREA TREATING - WILTON					
SUB-TITLE: PIPING G.A. FOR 1ST CRYSTALLISER COND					
PROJECT NO. 87001					
DRAWING NO. W/TA 630479					
ISSUE NO. B					

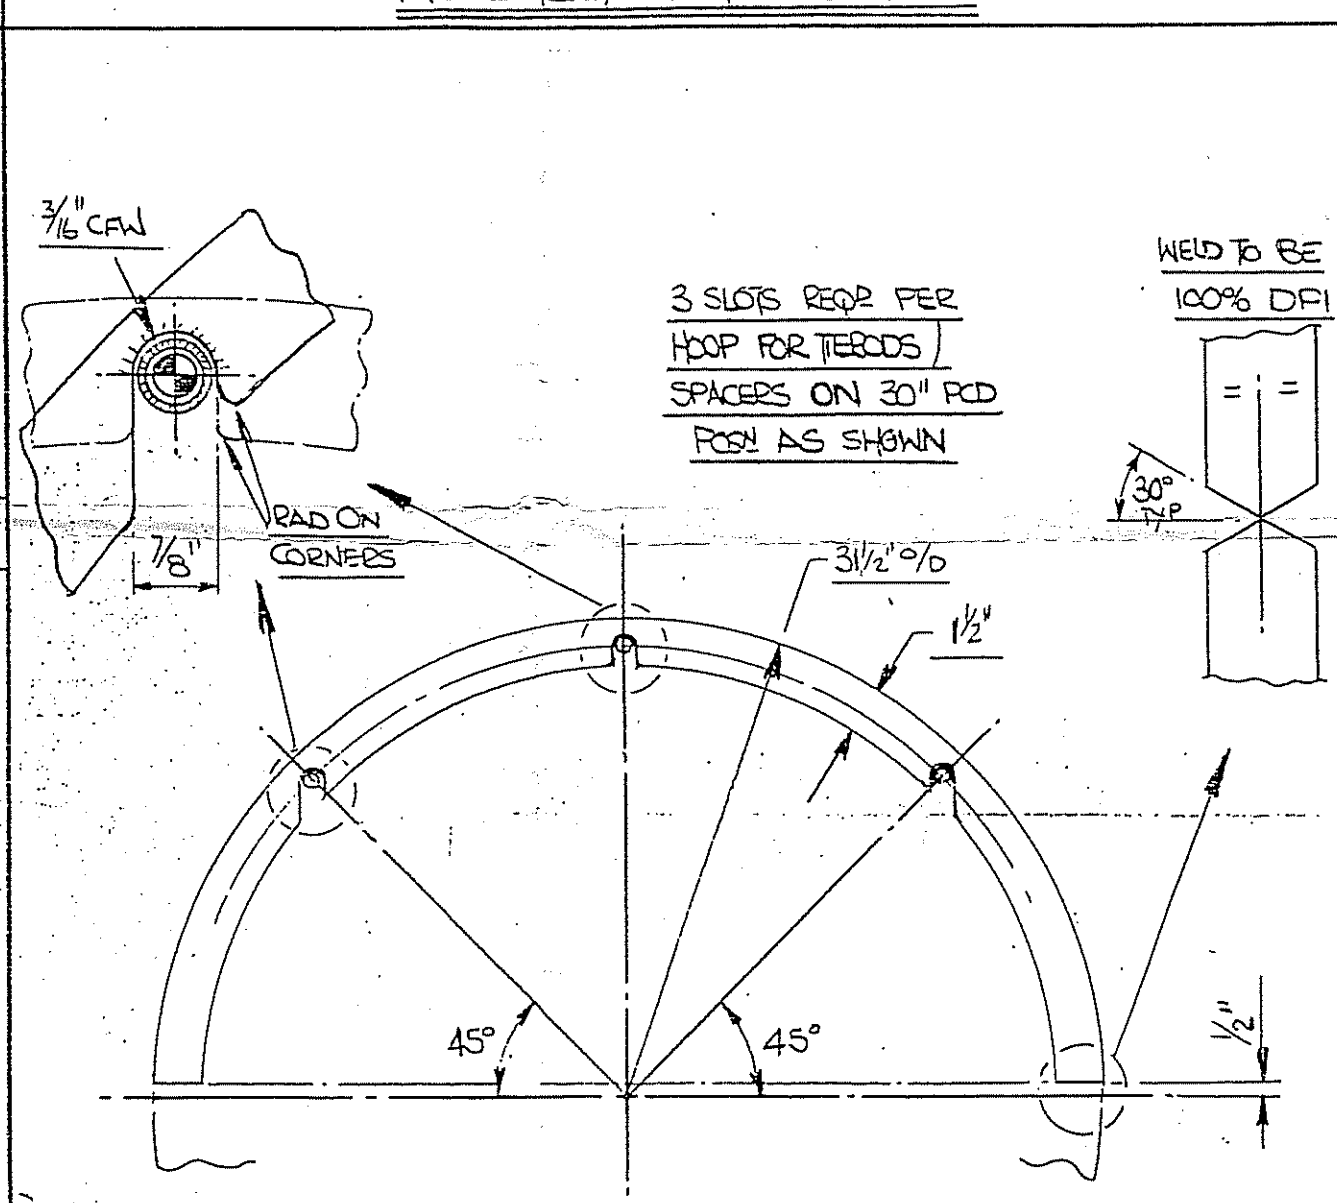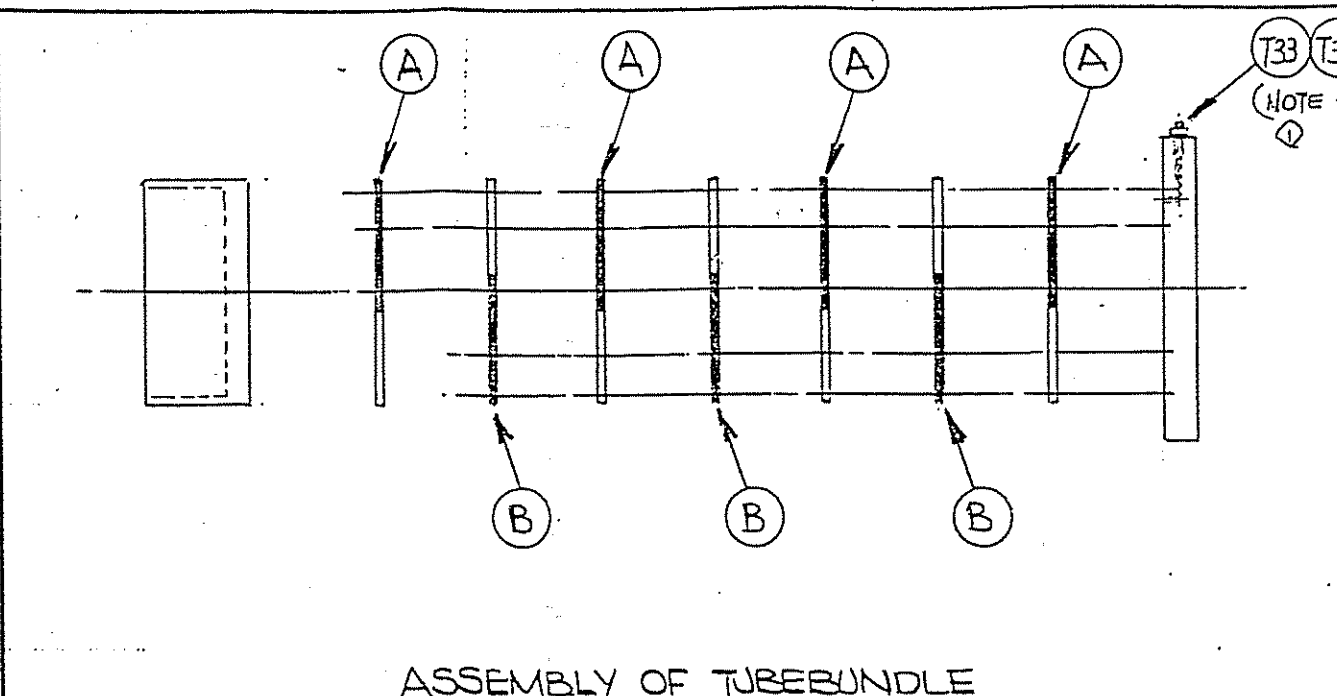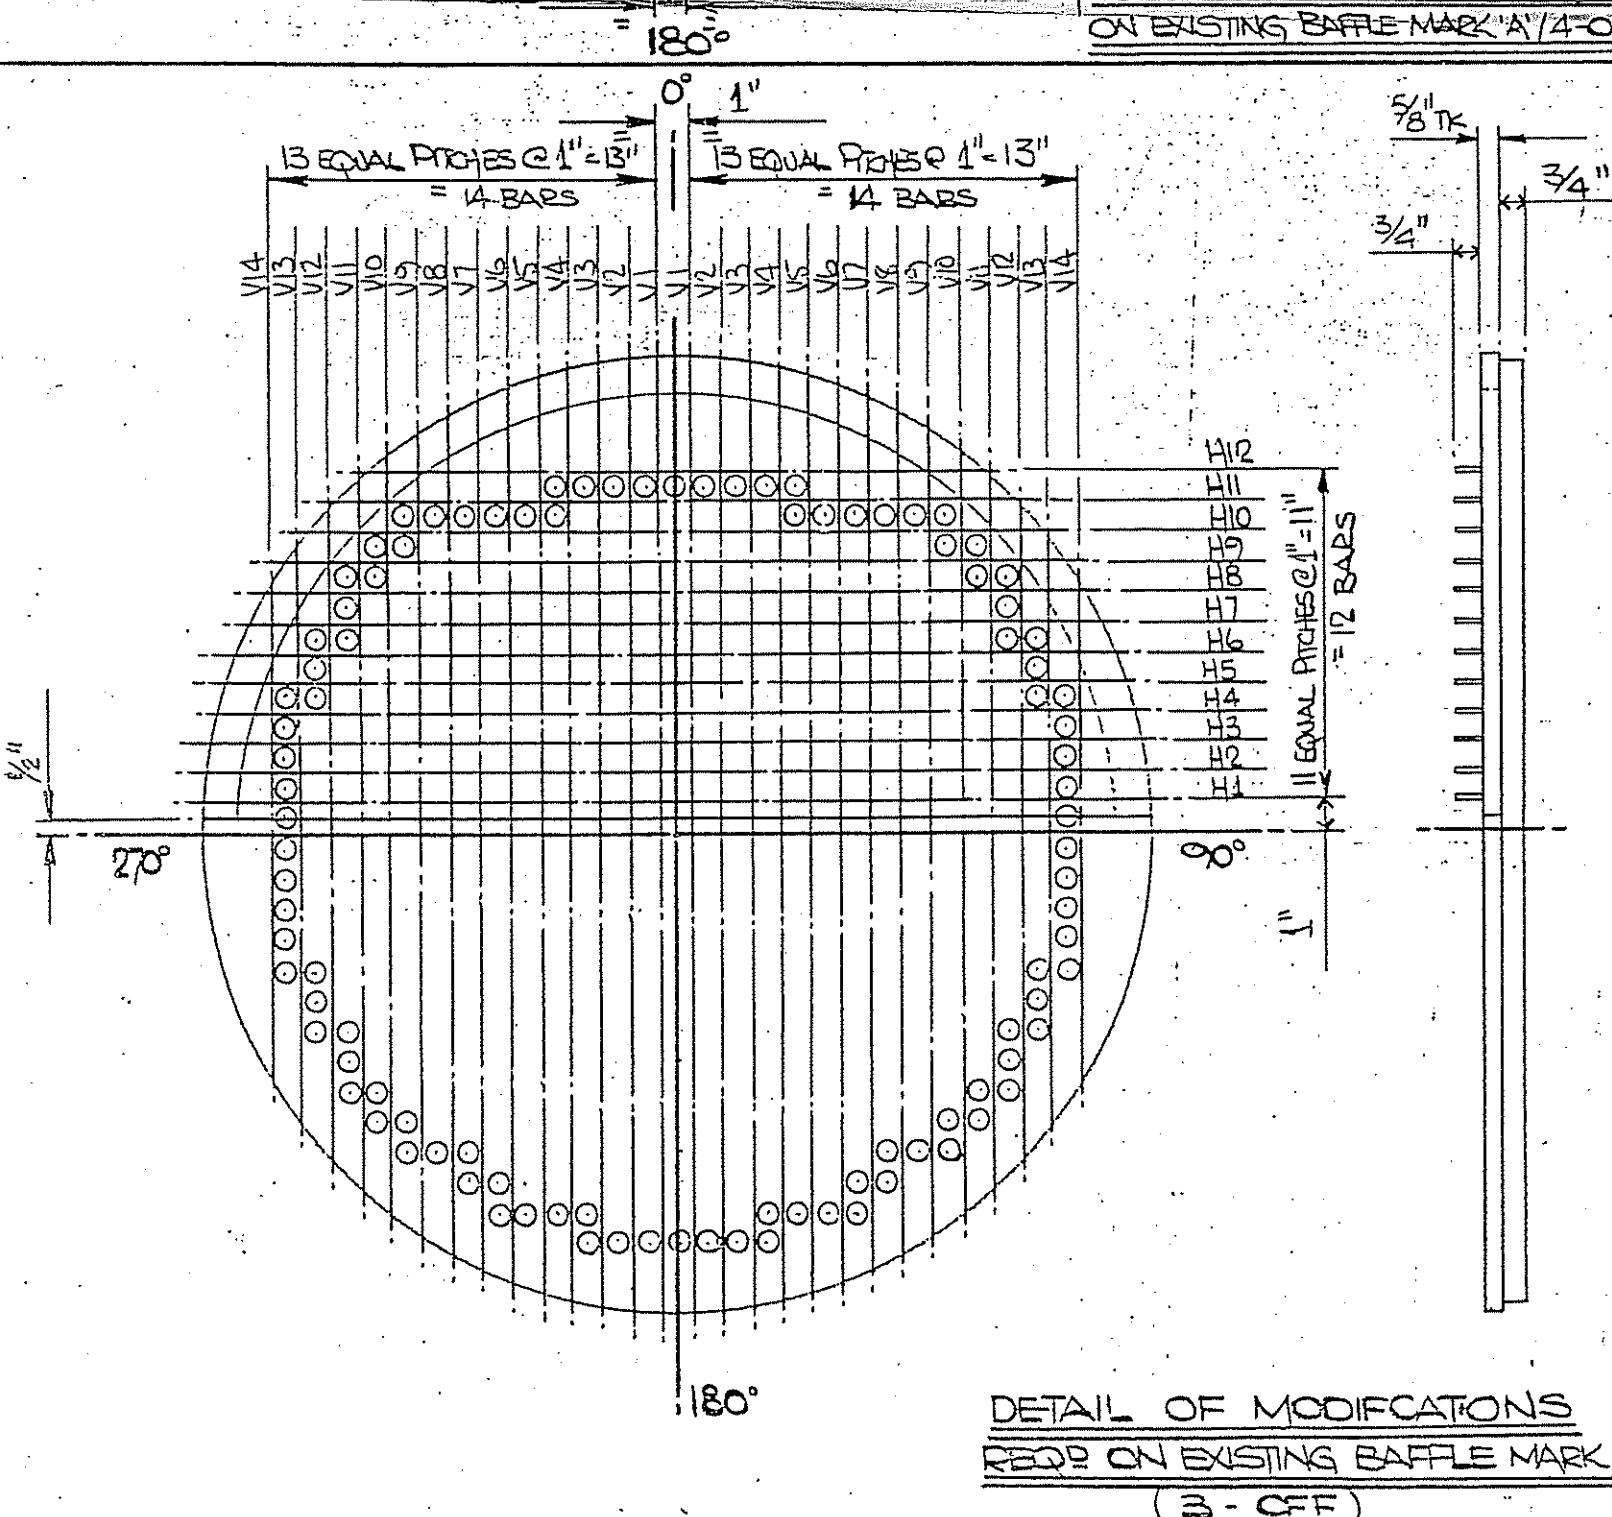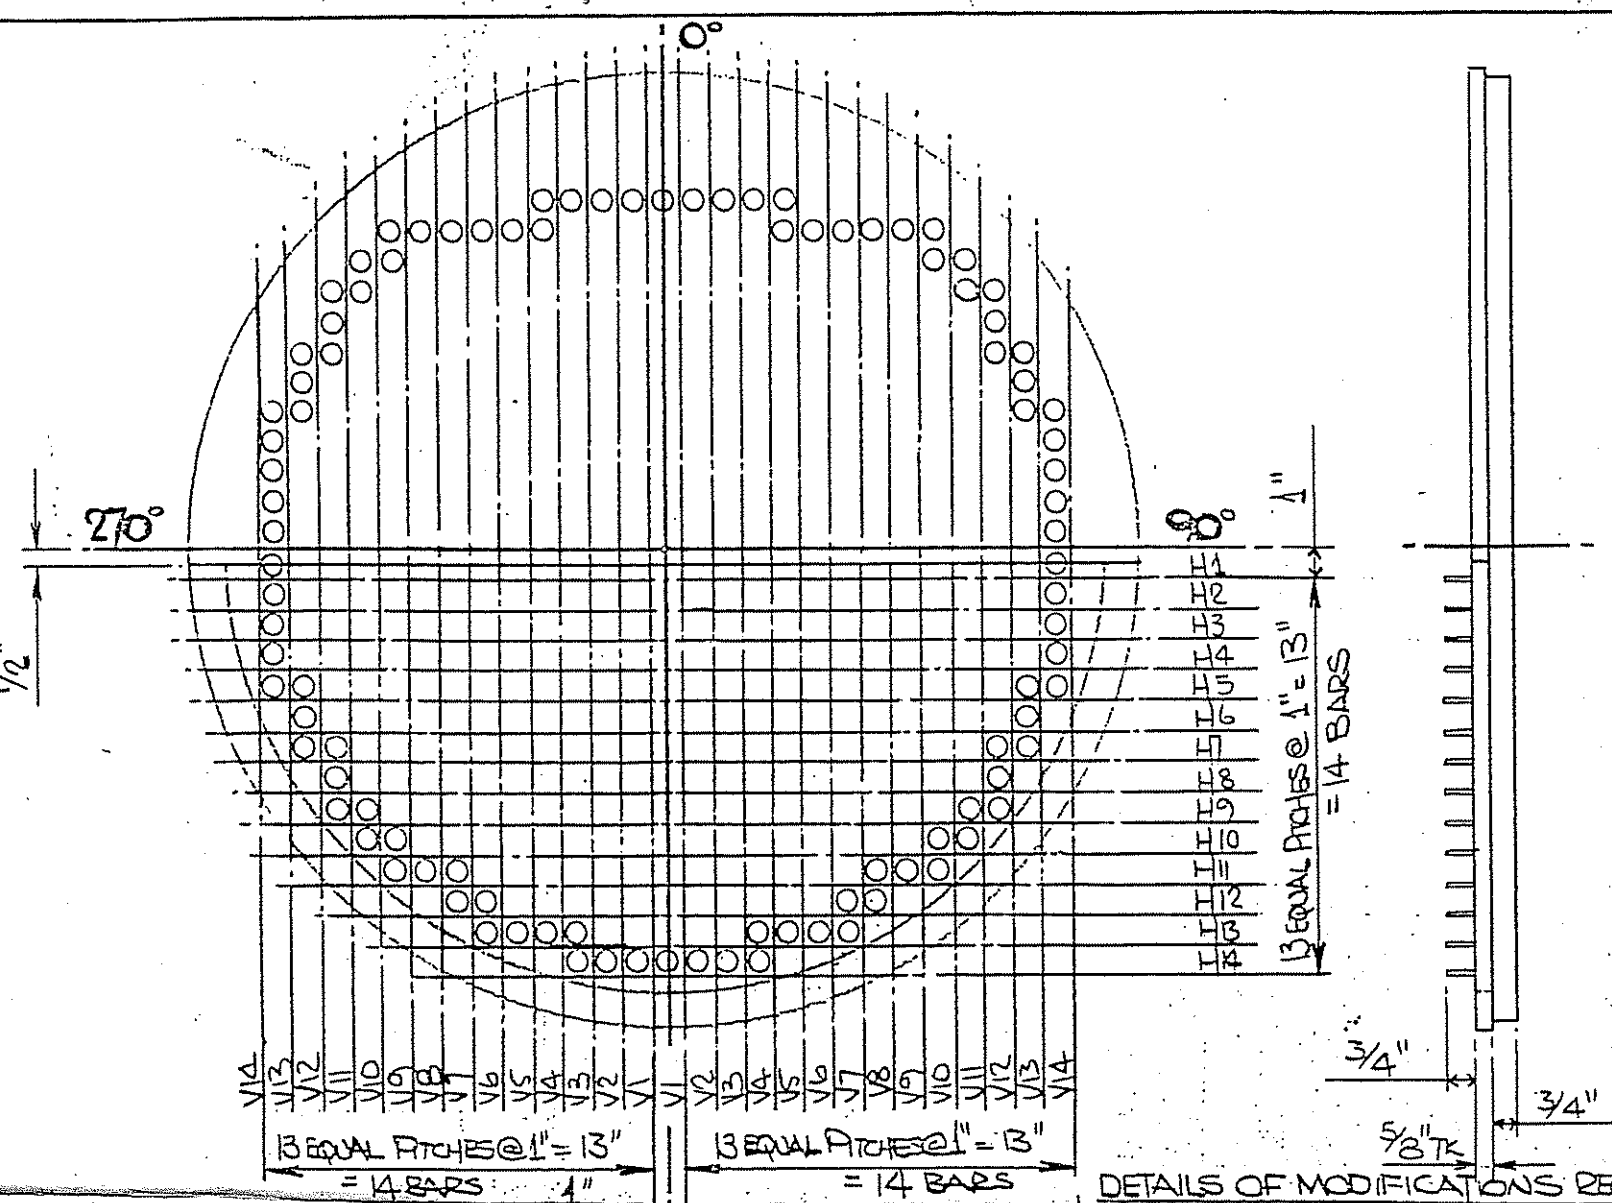

HORIZONTAL BARS T55			VERTICAL BARS T56		
REF NO	OFF	LENGTH	REF NO	OFF	LENGTH
H1	7	30.918"	V1	14	30.975"
H2	7	30.707"	V2	14	30.821"
H3	7	30.323"	V3	14	30.552"
H4	7	29.882"	V4	14	30.140"
H5	7	29.256"	V5	14	29.588"
H6	7	28.477"	V6	14	28.887"
H7	7	27.531"	V7	14	28.026"
H8	7	26.400"	V8	14	26.990"
H9	7	25.057"	V9	14	25.757"
H10	7	23.472"	V10	14	24.299"
H11	7	21.586"	V11	14	22.571"
H12	7	19.312"	V12	14	20.505"
H13	4	16.471"	V13	14	17.984"
H14	4	12.765"	V14	14	14.780"

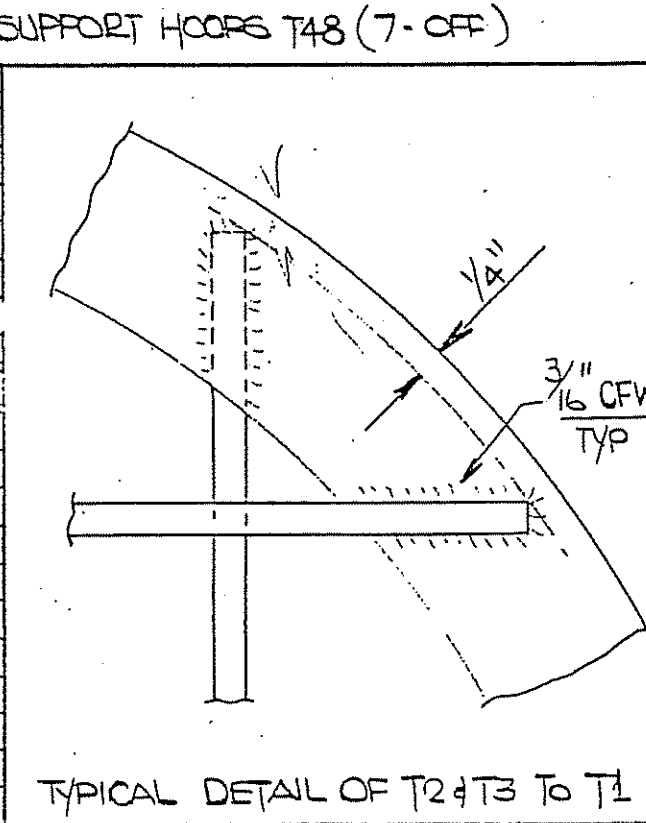

REF NO	OFF	MATERIAL	TYPE	DESCRIPTION	REQD QTY
T48	7	TP 316 L	SIST	BAFFLE SUPPORT HOOPS	301/1
T55	92	TP 316 L	SIST	HORIZONTAL SUPPT BARS - 3/8" x 1/2" LENGTH AS TABLE	301/2
T56	196	TP 316 L	SIST	VERTICAL SUPPT BARS - 3/8" x 1/2" LENGTH AS TABLE	301/2
T33	1	TP 316	SIS	VENT PLUG - SEE MBT DRG 85/108 SK2	25/1
T34	1	CAF	-	GASKET - 1 1/8" O.D. x 3/4" I.D. x 1/2" THK	25/1

- GENERAL NOTES
- ONE ASSEMBLY REQD AS DRAWN MARK :- E413
 - FOR DETAILS OF SHELL & KNOCK OUT POT SEE MBT DRG NO :- 85/1908/EF 21
 - INSPECTION BY: MBT / ICI #/OR THEIR APPOINTED REP.
 - T/SHT T1 TO HAVE 1/2" DIA VENT HOLE @ 0° X 2 1/2" DEEP TO COME OUT ON SHELLSIDE. TOP 1" OF HOLE TO BE TAPPED 3/8" BSP & RUGGED WITH 'T33' & 'T34'
 - BUNDLE TO BE CLEANED USING A HIGH PRESSURE WATER JET.



PURCHASER		ICI DRG NO D/17/15/4097	
CONTRACT		BILLINGHAM	
TITLE		DETAILS OF MODIFICATIONS REQUIRED ON TUBEBUNDLE FOR UNIT NO E413	

REVISION	0	TO CLIENT FOR APPROVAL	1	VENT HOLE ADDED TO T1. NOTE A, T33 & T34 ADDED TO SUIT AREAS ADDED.	2	AS PER CLIENT RETURN PRINTS 28-3-85
DATE	1/3/85	RELEASED FOR CONSTRUCTION	2/1/85	STATUS UNCHANGED	4-85	T55 & T56 LENGTHS REVISED
ALTERED BY	CPK	APPROVED BY	KL	STATUS UNCHANGED	1/1	STATUS UNCHANGED


THIS DRAWING IS CONFIDENTIAL AND IS THE PROPERTY OF THE MOTHERWELL BRIDGE THERMAL LTD. IT MUST NOT BE COPIED OR DISCLOSED TO ANY THIRD PARTY WITHOUT THE WRITTEN CONSENT OF THE COMPANY.

PURCHASER'S ORDER NO	CONTRACT NO	DRAWING NO	DRAWN BY	CHECKED BY	APPROVED BY	SCALE	REVISIONS
	85/1908	EF 22	CPK	KL	KL	N.T.S	1-3-85 1-3-85


D/17/15/4097

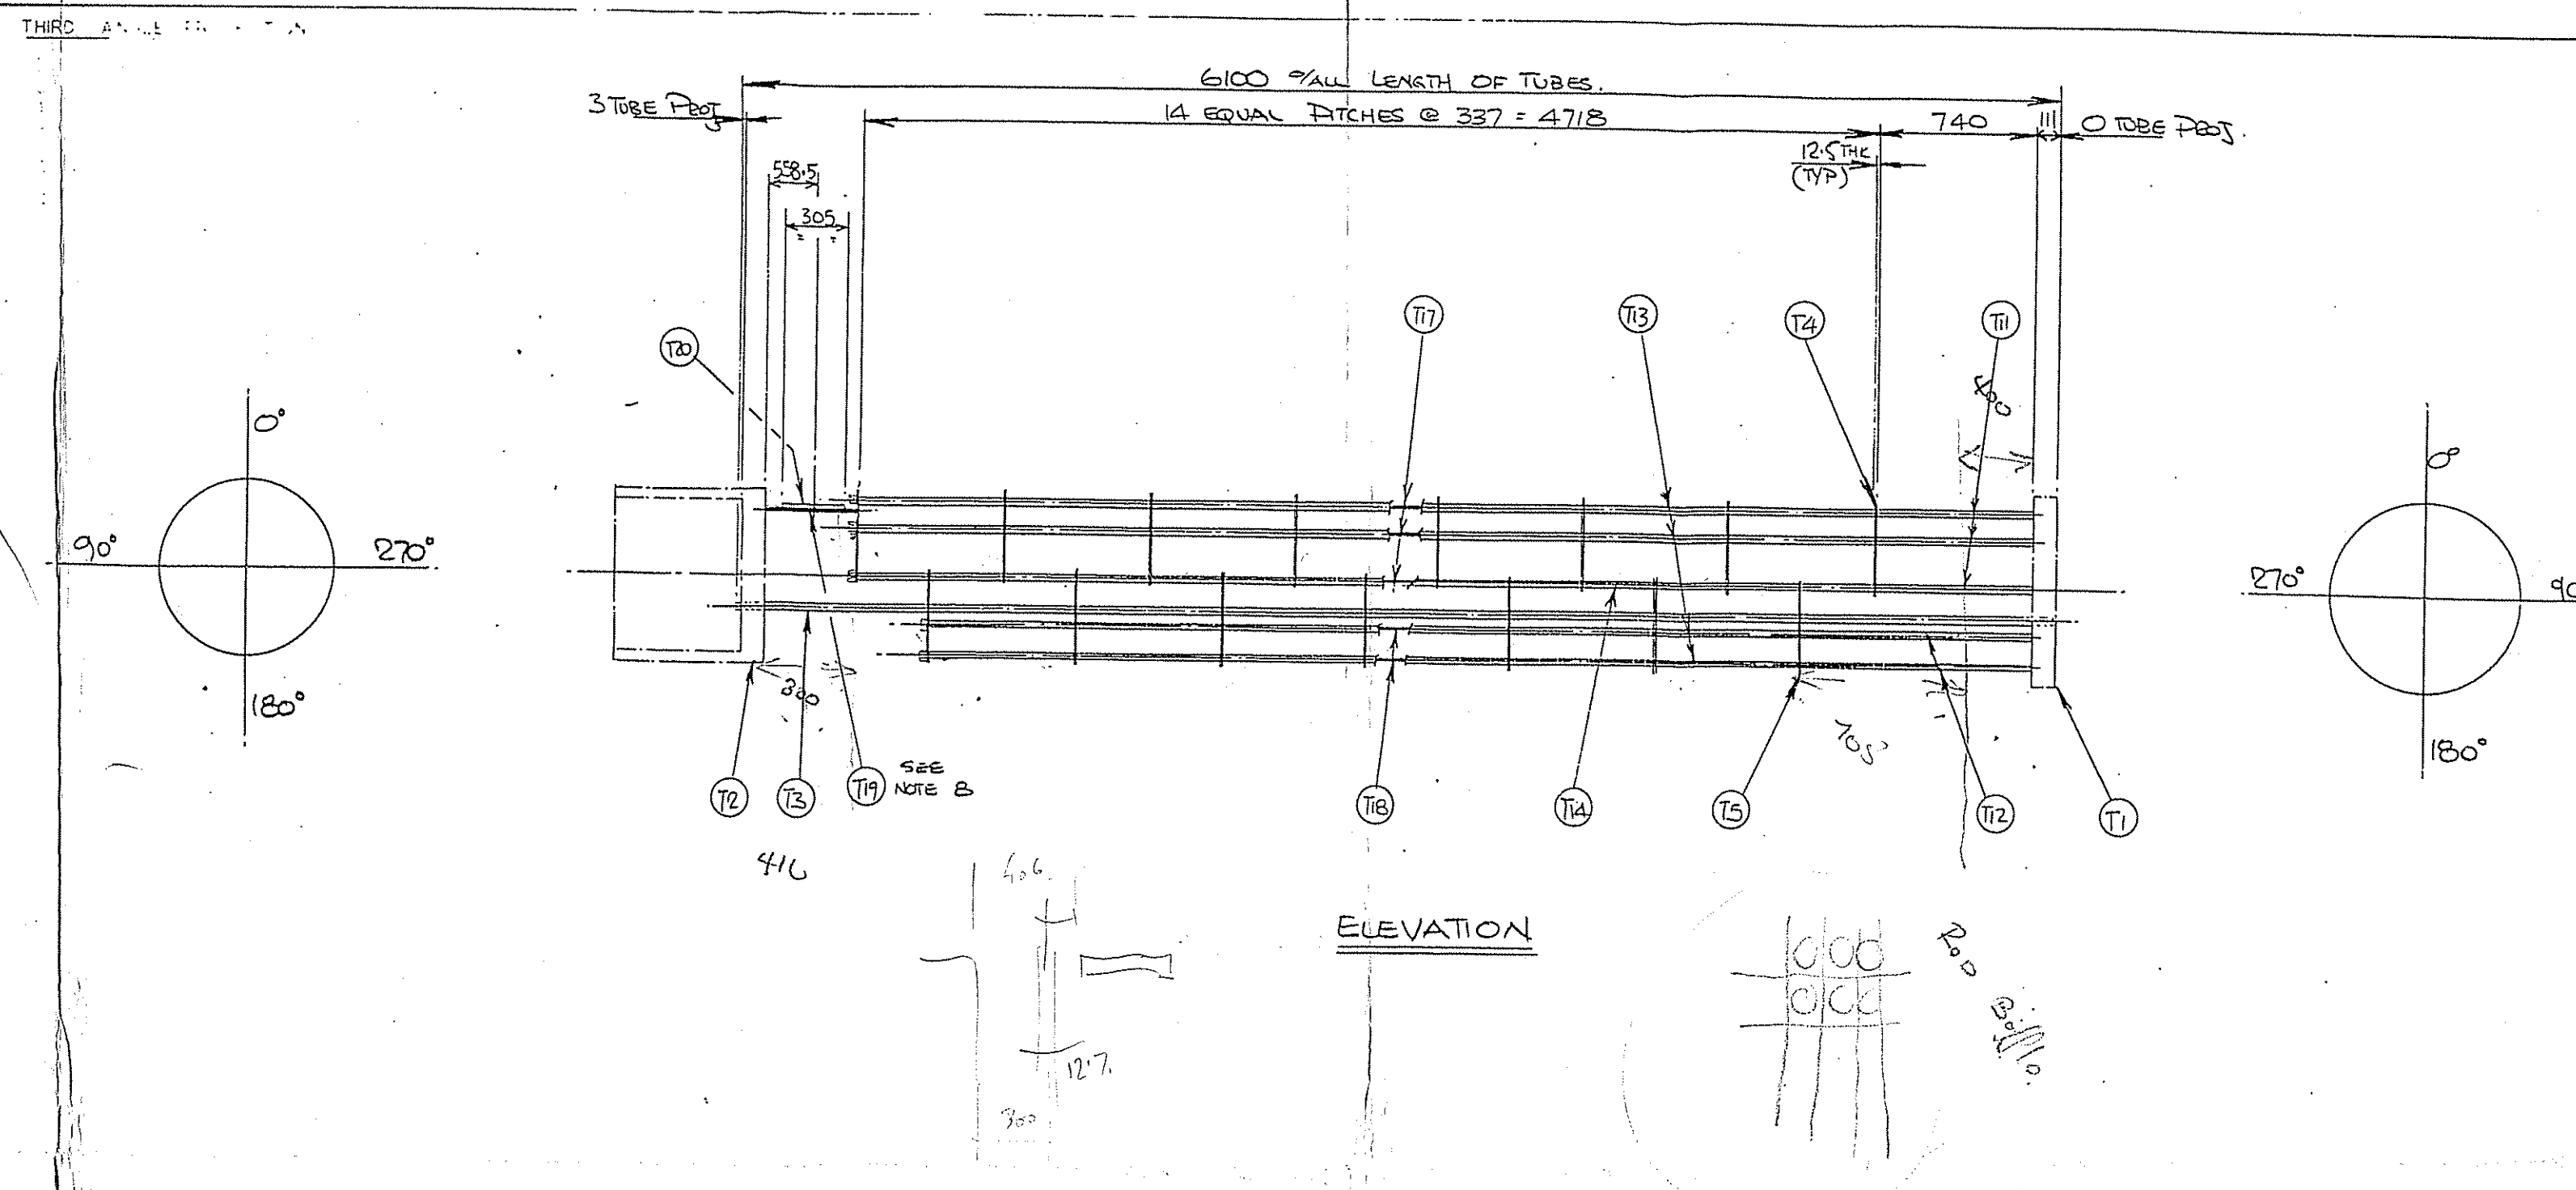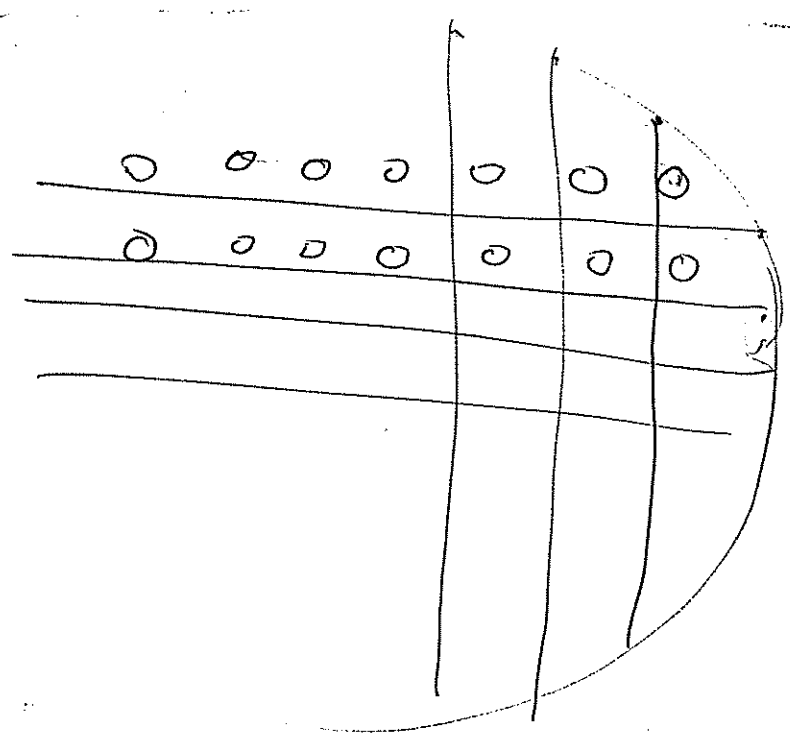


ELEVATION

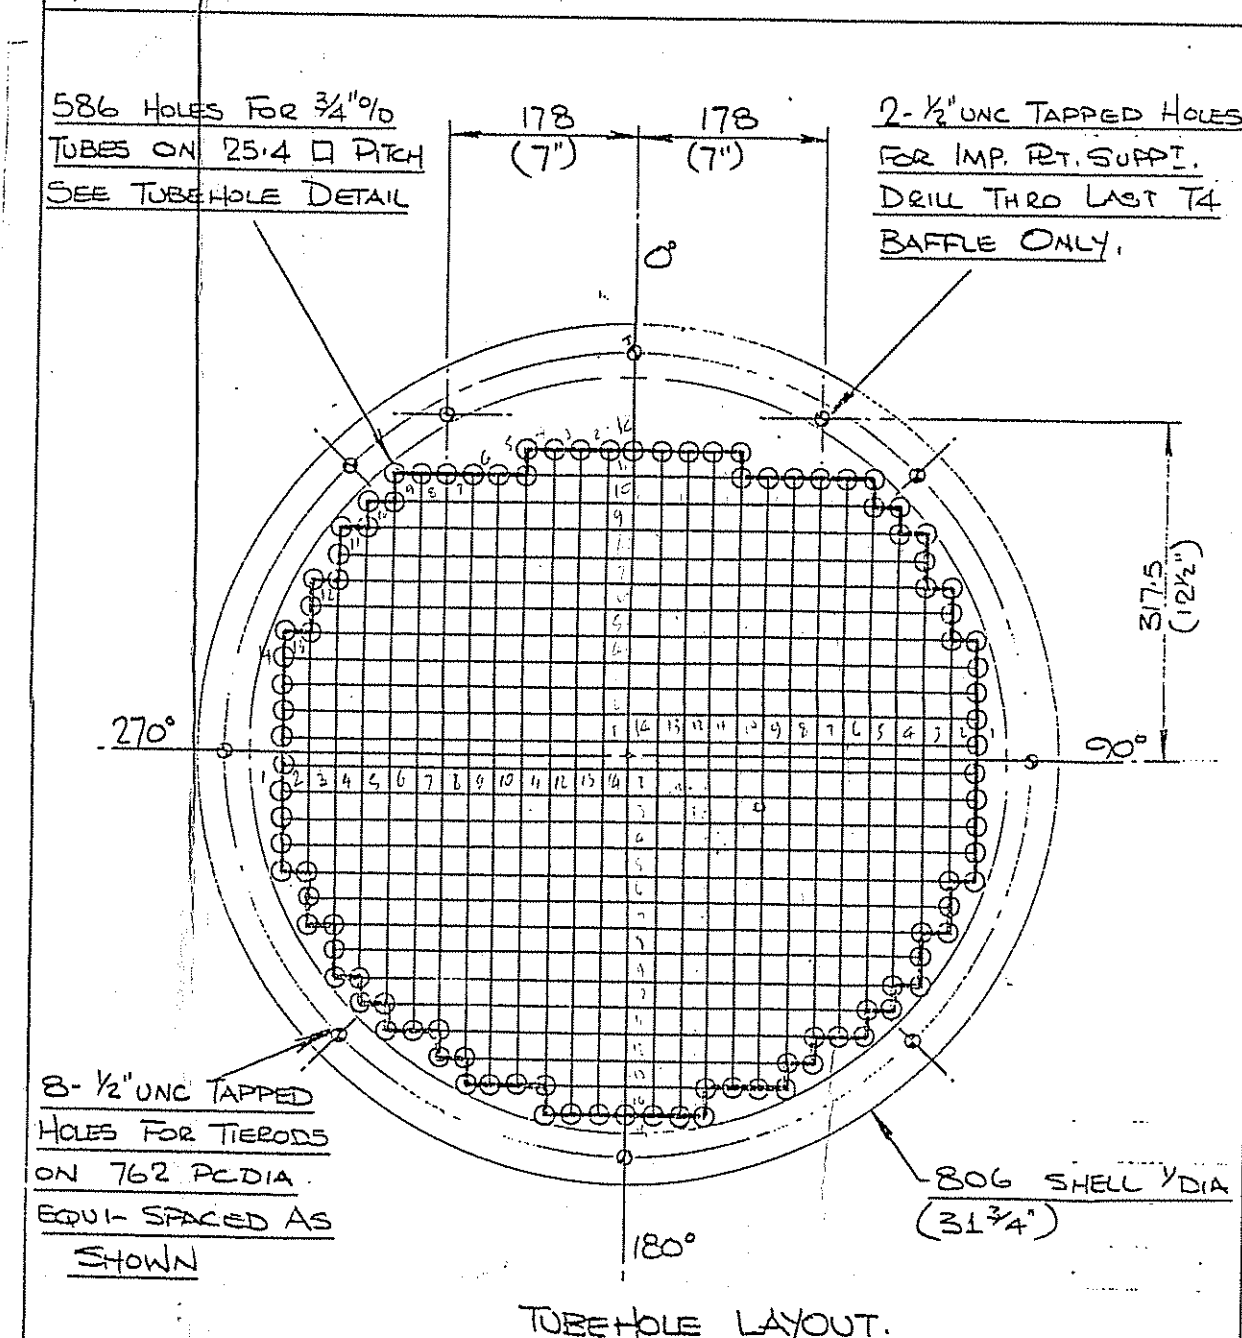

TUBEHOLE LAYOUT.

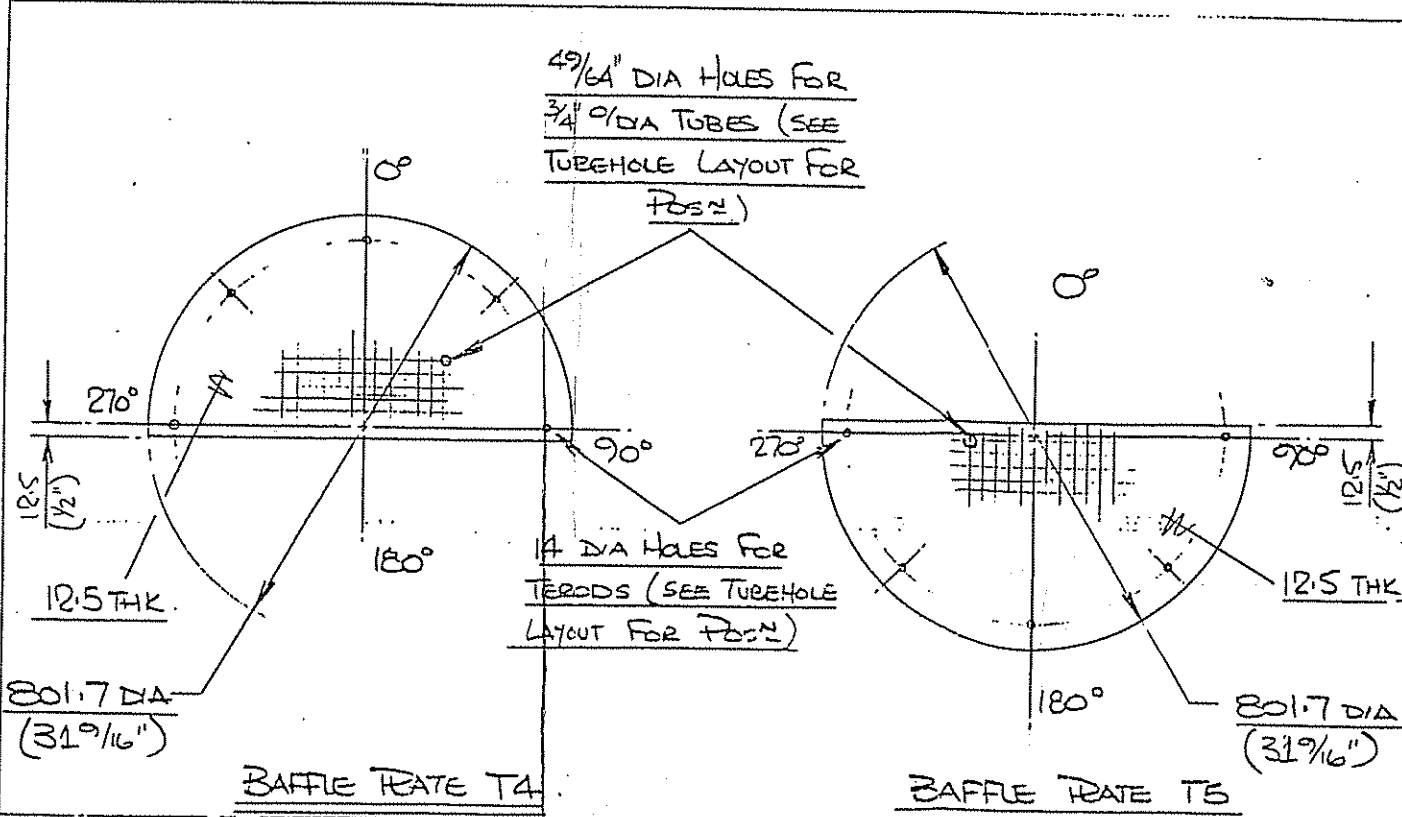

UNSERVICED COPY

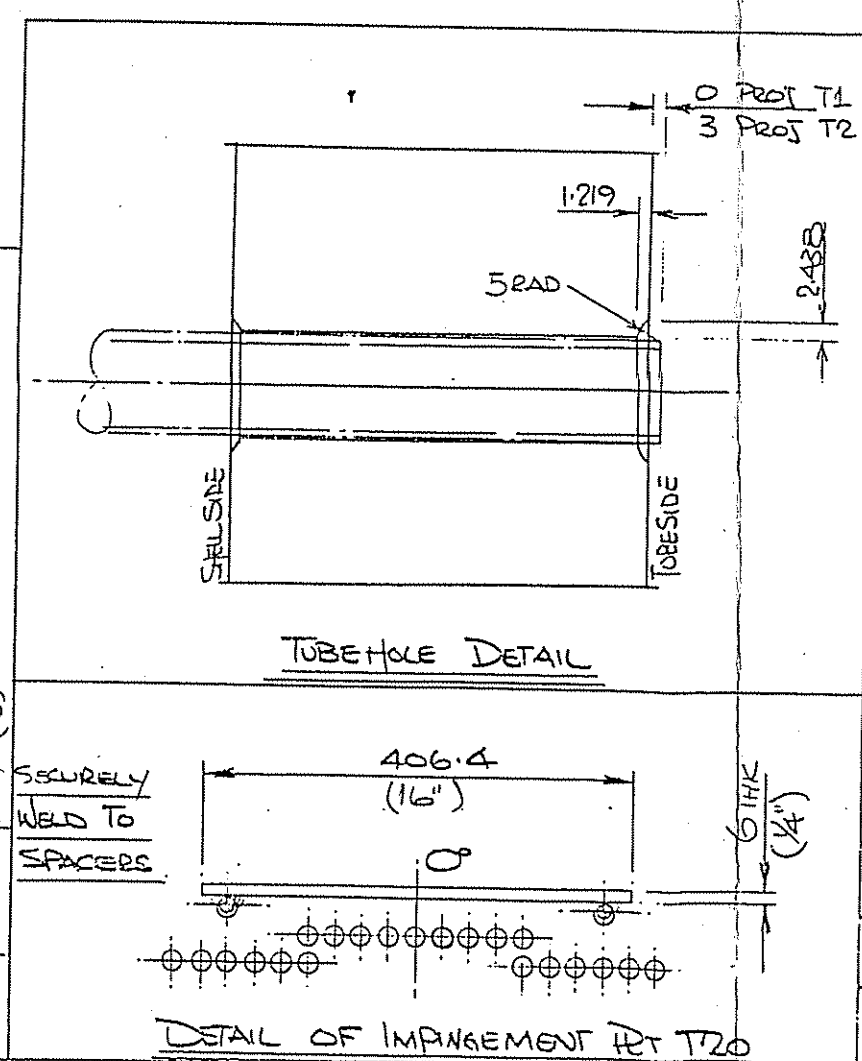

DETAIL OF IMPINGEMENT PT T20


REF NO	OFF	MATERIAL	TYPE	DESCRIPTION	REQ NO
T1	1	INI-125(1835GR)	T1	STATIONARY TUBESHEET	
T2	1	INI-125(1835GR)	T1	STATIONARY TUBESHEET	
T3	586	R 238 GR 2	T1	TUBES 3/4" x 18.5 x (MIN) x 6100 LG	131/1
T4	8	A 240 TP 304	ST	BAFFLE PLATE	12/1
T5	7	A 240 TP 304	ST	BAFFLE PLATE	12/1
T11	5	A 203 TP 316	ST	SPACER 3/4" x 18.5 x 740 LG	23/1
T12	3	A 203 TP 316	ST	SPACER 3/4" x 18.5 x 1077 LG	23/1
T13	39	A 203 TP 316	ST	SPACER 3/4" x 18.5 x 6615 LG	23/1
T14	28	A 203 TP 316	ST	SPACER 3/4" x 18.5 x 324.5 LG	23/1
T17	5	TP 304	ST	TIE RODS 1/2" DIA x 5510 LG	24/1
T18	3	TP 304	ST	TIE RODS 1/2" DIA x 5175 LG	24/1
T19	2	TP 304	ST	TIE RODS 1/2" DIA x 475 LG	24/1
T20	1	A 240 TP 304	ST	IMPAIRMENT RATE	12/2

GENERAL NOTES

1. FOR SHELL/CHANNEL, TEST DETAILS & DESIGN DATA SEE MBT DES. NO. 85/1908 (EF 21)
2. ONE ASSEMBLY REQD AS DRAWN MARK- E413.
3. MACHINE FINISH AS FOLLOWS:-
 VVV 63 cla MICROINCHES (GASKET FINISH)
 VV 125 250 cla MICROINCHES (SMOOTH FINISH)
 V 500-1000 cla MICROINCHES (MACHINE FINISH)
4. BAFFLE PLATE EDGES TO BE DEBURRED & TUBEHOLES TO HAVE A WORKMANLIKE FINISH
5. TUBE END ATTACHMENT:- STRENGTH WELDED.
6. WEIGHT OF TUBEBUNDLE =
7. MATERIALS MARKED THUS * HAVE TO BE SALVAGED FROM EXISTING BUNDLE & RE-USED.
8. TIE RODS "T19" TO RUN FROM T8T "T2" TO LAST "T4" BAFFLE ONLY. ENDS TO BE FREE IN BAFFLE.

MOTHERWELL FRIDGE THERMAL LTD			
PURCHASER	ICI BPC No. 11/12/41		
CONTRACT	BILLINGHAM		
TITLE	DETAILS OF RETACEMENT TUBEBUNDLE FOR UNIT NO. E413		
PURCHASER'S ORDER NO.	62/245416/INI/WS.		
CONTRACT NO.	DRAWING NO.	DRAWN BY	CPK/MS
85/1908	85/1908	CHECKED BY	CPK 28.5.85
	EF 24.	APPROVED BY	CPK 28.5.85
		SCALE	
		REVISIONS	0.

REVISION	0	TO CLIENT FOR APPROVAL
DATE		RELEASED FOR CONSTRUCTION
ALTERED		
APPROVED		

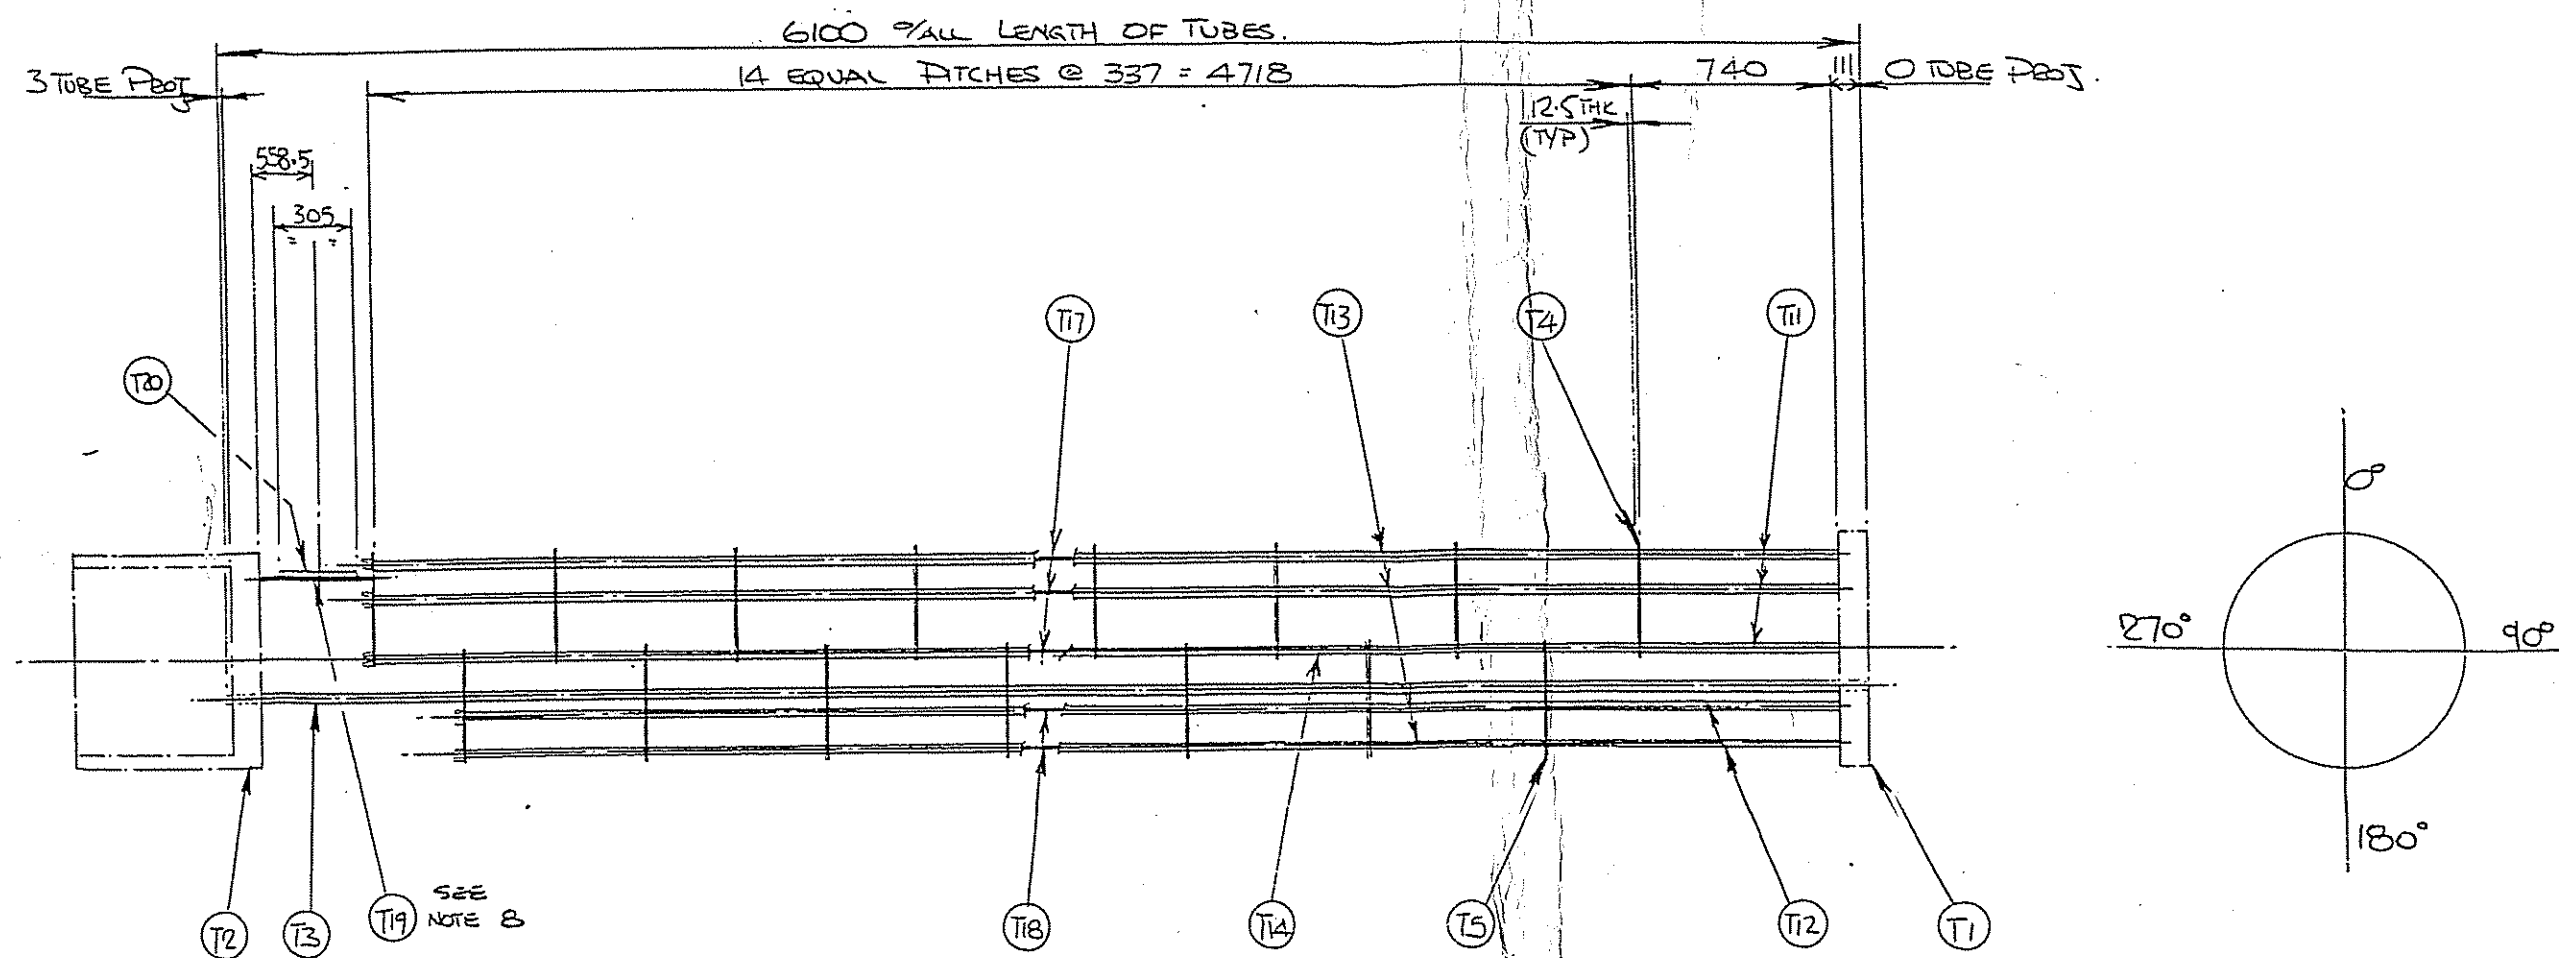


ELEVATION

BILL OF MATERIAL FOR ONE ASSEMBLY AS DRAWN


REF NO	OFF	MATERIAL	TYPE	DESCRIPTION	REQD NO
*T1	1	IMI-125 (335 GR)	T	STATIONARY TUBESHEET	---
*T2	1	IMI-125 (335 GR)	T	FLOATING TUBESHEET	---
T3	586	R 338 GR 2	T	TUBES 1/2" x 3/4" x 18 SWG (MIN) x 6100 LG	13/1
T4	8	A 240 TP 304	ST	BAFFLE PLATE	12/1
T5	7	A 240 TP 304	ST	BAFFLE PLATE	12/1
T11	5	A 213 TP 316	ST	SPACER: 3/4" x 18 SWG x 740 LG	23/1
T12	3	A 213 TP 316	ST	SPACER: 3/4" x 18 SWG x 1077 LG	23/1
T13	39	A 213 TP 316	ST	SPACER: 3/4" x 18 SWG x 6615 LG	23/1
T14	28	A 213 TP 316	ST	SPACER: 3/4" x 18 SWG x 3245 LG	23/1
T17	5	TP 304	ST	TIE RODS 12.5 DIA x 5510 LG	24/1
T18	3	TP 304	ST	TIE RODS 12.5 DIA x 5175 LG	24/1
T19	2	TP 304	ST	TIE RODS 12.5 DIA x 475 LG	24/1
T20	1	A 240 TP 304	ST	IMPERMEDIATE RATE	12/2

GENERAL NOTES

- FOR SHELL/CHANNEL, TEST DETAILS & DESIGN DATA SEE MBT DRG NO 85/1908/EF21
- ONE ASSEMBLY REQD AS DRAWN MARK- E413.
- MACHINE FINISH AS FOLLOWS:-
 ∇∇∇ 63 CLA MICROINCHES (GASKET FINISH)
 ∇∇ 125-250 CLA MICROINCHES (SMOOTH FINISH)
 ∇ 500-1000 CLA MICROINCHES (MACHINE FINISH)
- BAFFLE PLATE EDGES TO BE DEBURRED & TUBEHOLES TO HAVE A WORKMANLIKE FINISH
- TUBE END ATTACHMENT! - STRENGTH WELDED.
- WEIGHT OF TUBE BUNDLE =
- MATERIALS MARKED THIS * HAVE TO BE SALVAGED FROM EXISTING BUNDLE & RE-USED.
- TIE RODS "T19" TO RUN FROM TSH "T2" TO LAST "T4" BAFFLE ONLY. ENDS TO BE FREE IN BAFFLE.

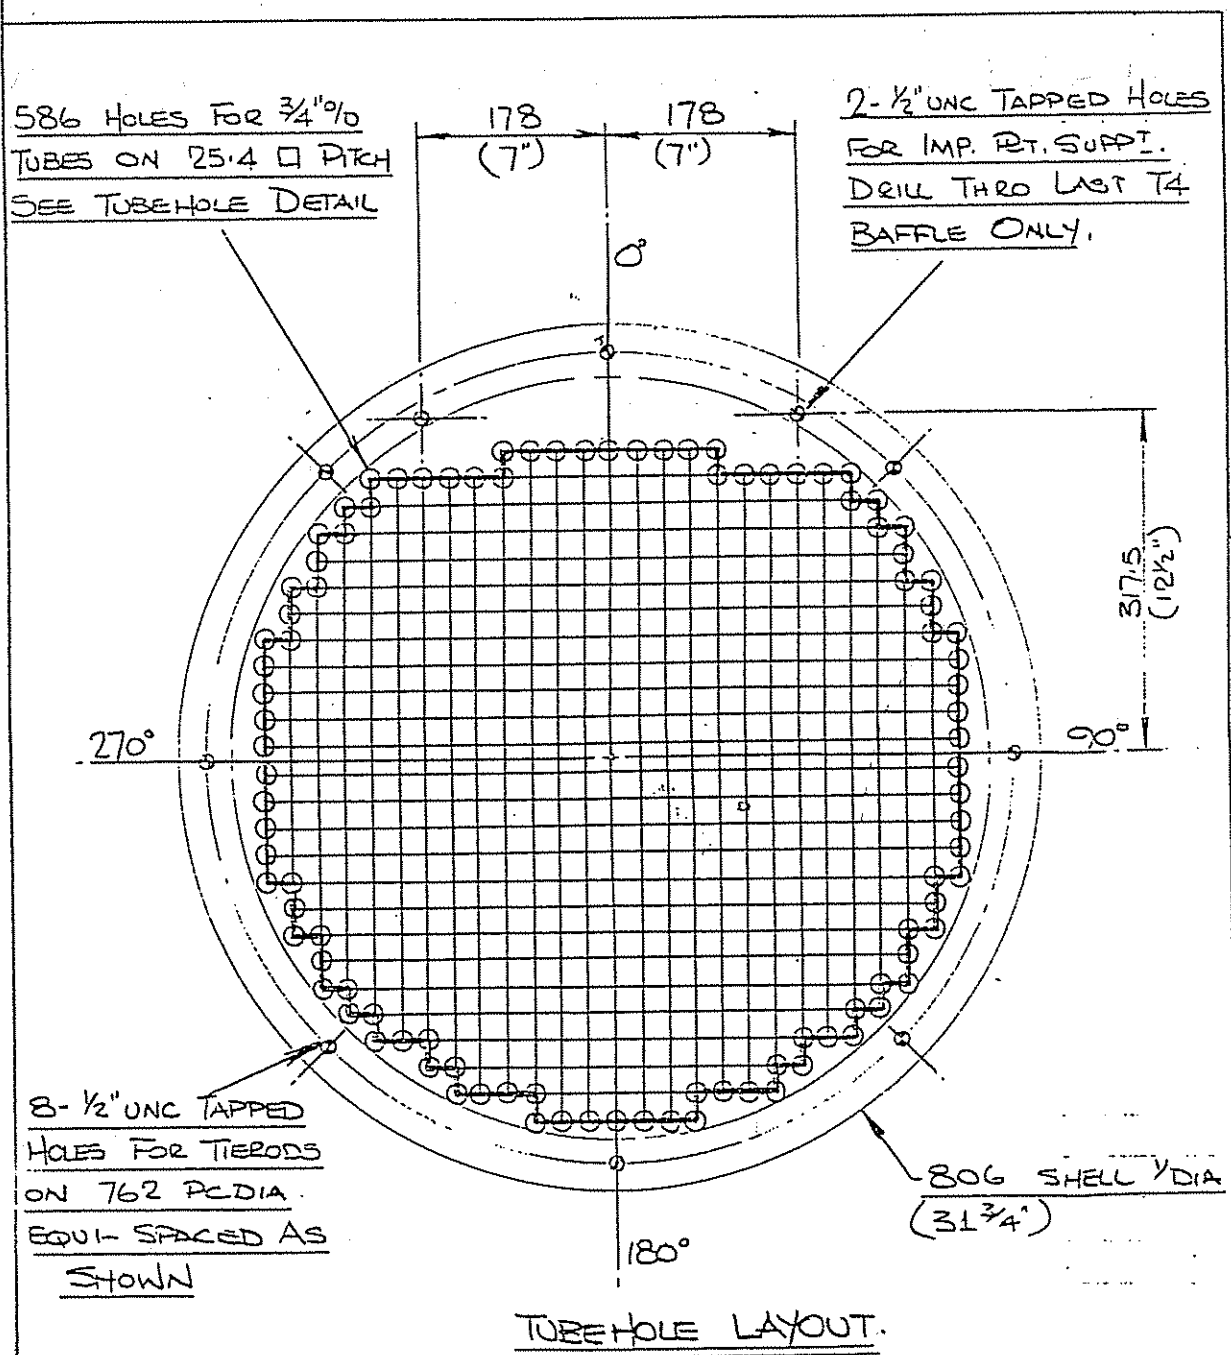


TUBEHOLE LAYOUT.

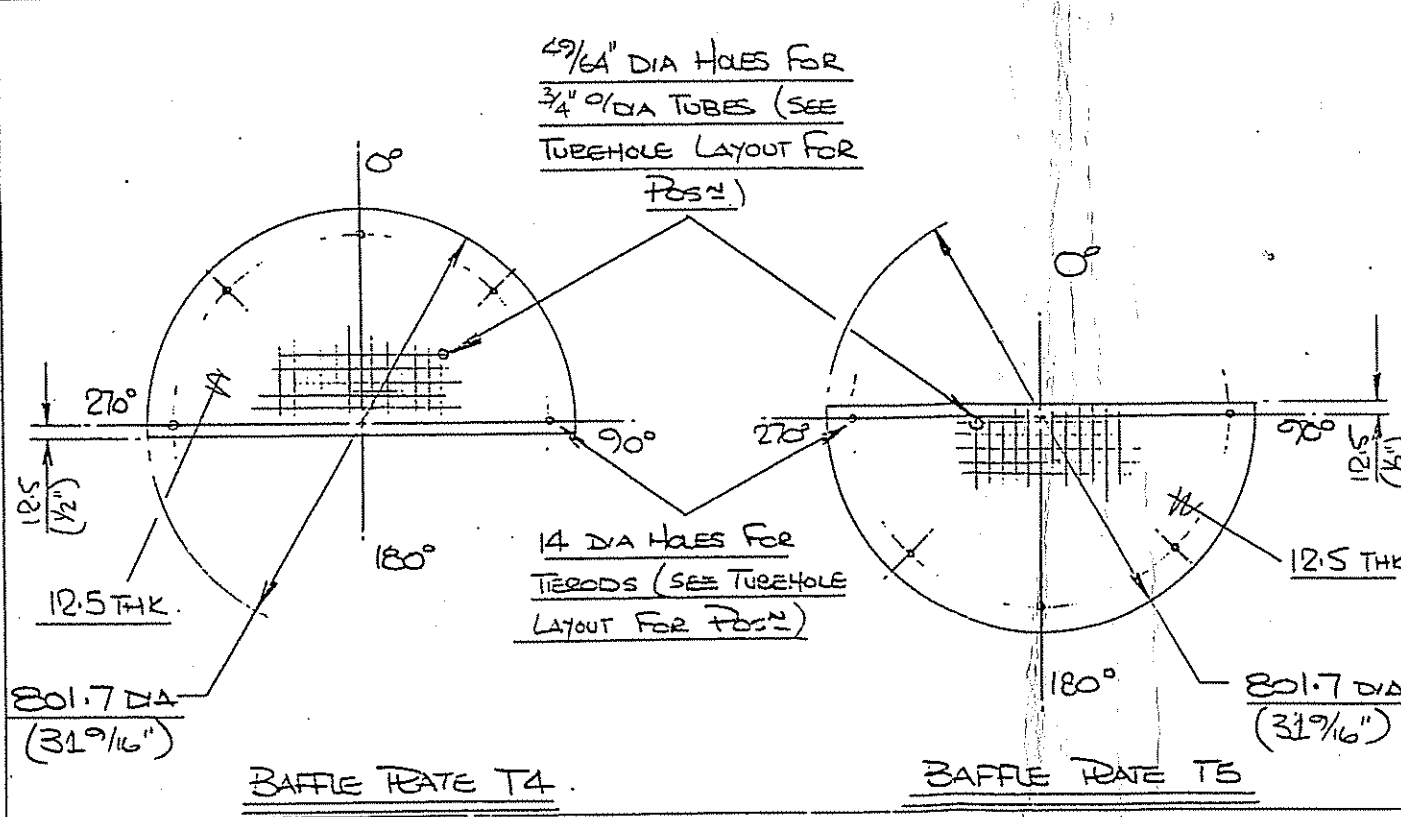


BAFFLE PLATE T4

BAFFLE PLATE T5

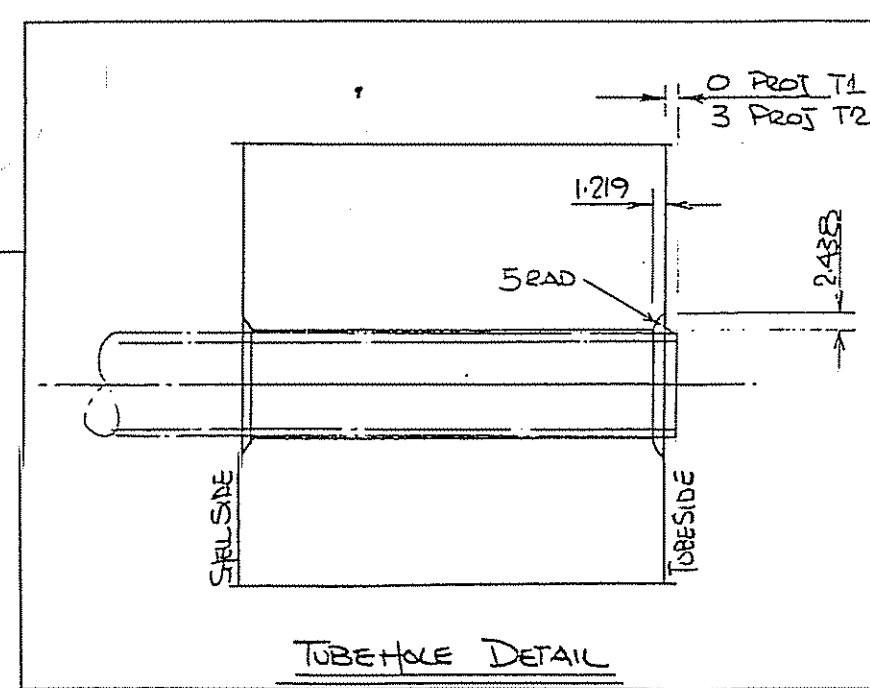

TUBEHOLE DETAIL

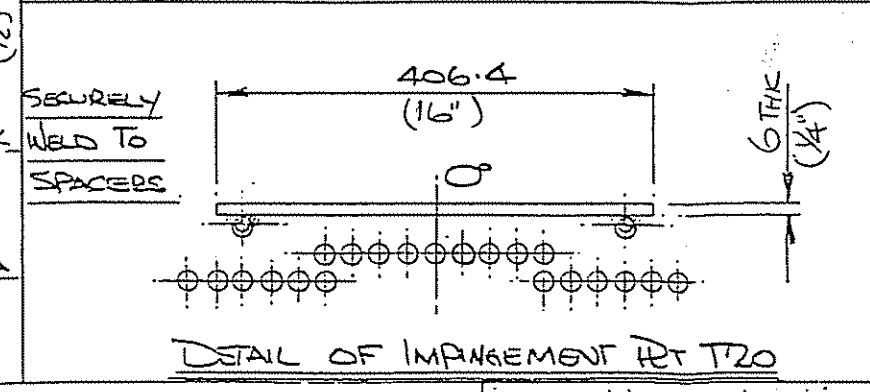


DETAIL OF IMPINGEMENT RET T20

MOTHERWELL EDGE THERMAL LTD


PURCHASER	ICI Ref No: D/17/10/4100		
CONTRACT	BILLINGHAM		
TITLE	DETAILS OF REPLACEMENT TUBE BUNDLE FOR UNIT No E413.		
PURCHASERS' ORDER NO	62/245416/INI/WS.		
CONTRACT NO	DRAWING NO	DRAWN BY	CPK/28-5-85
85/1908	85/P28	CHECKED BY	CPK 28-5-85
	EF 24.	APPROVED BY	CPK 28-5-85
		SCALE	
		REVISIONS	0

REVISION	0	TO CLIENT FOR APPROVAL
DATE	23/5/85	RELEASED FOR CONSTRUCTION
ALTERED BY	CPK	
APPROVED BY	CPK	


71801581
71801659
71801660

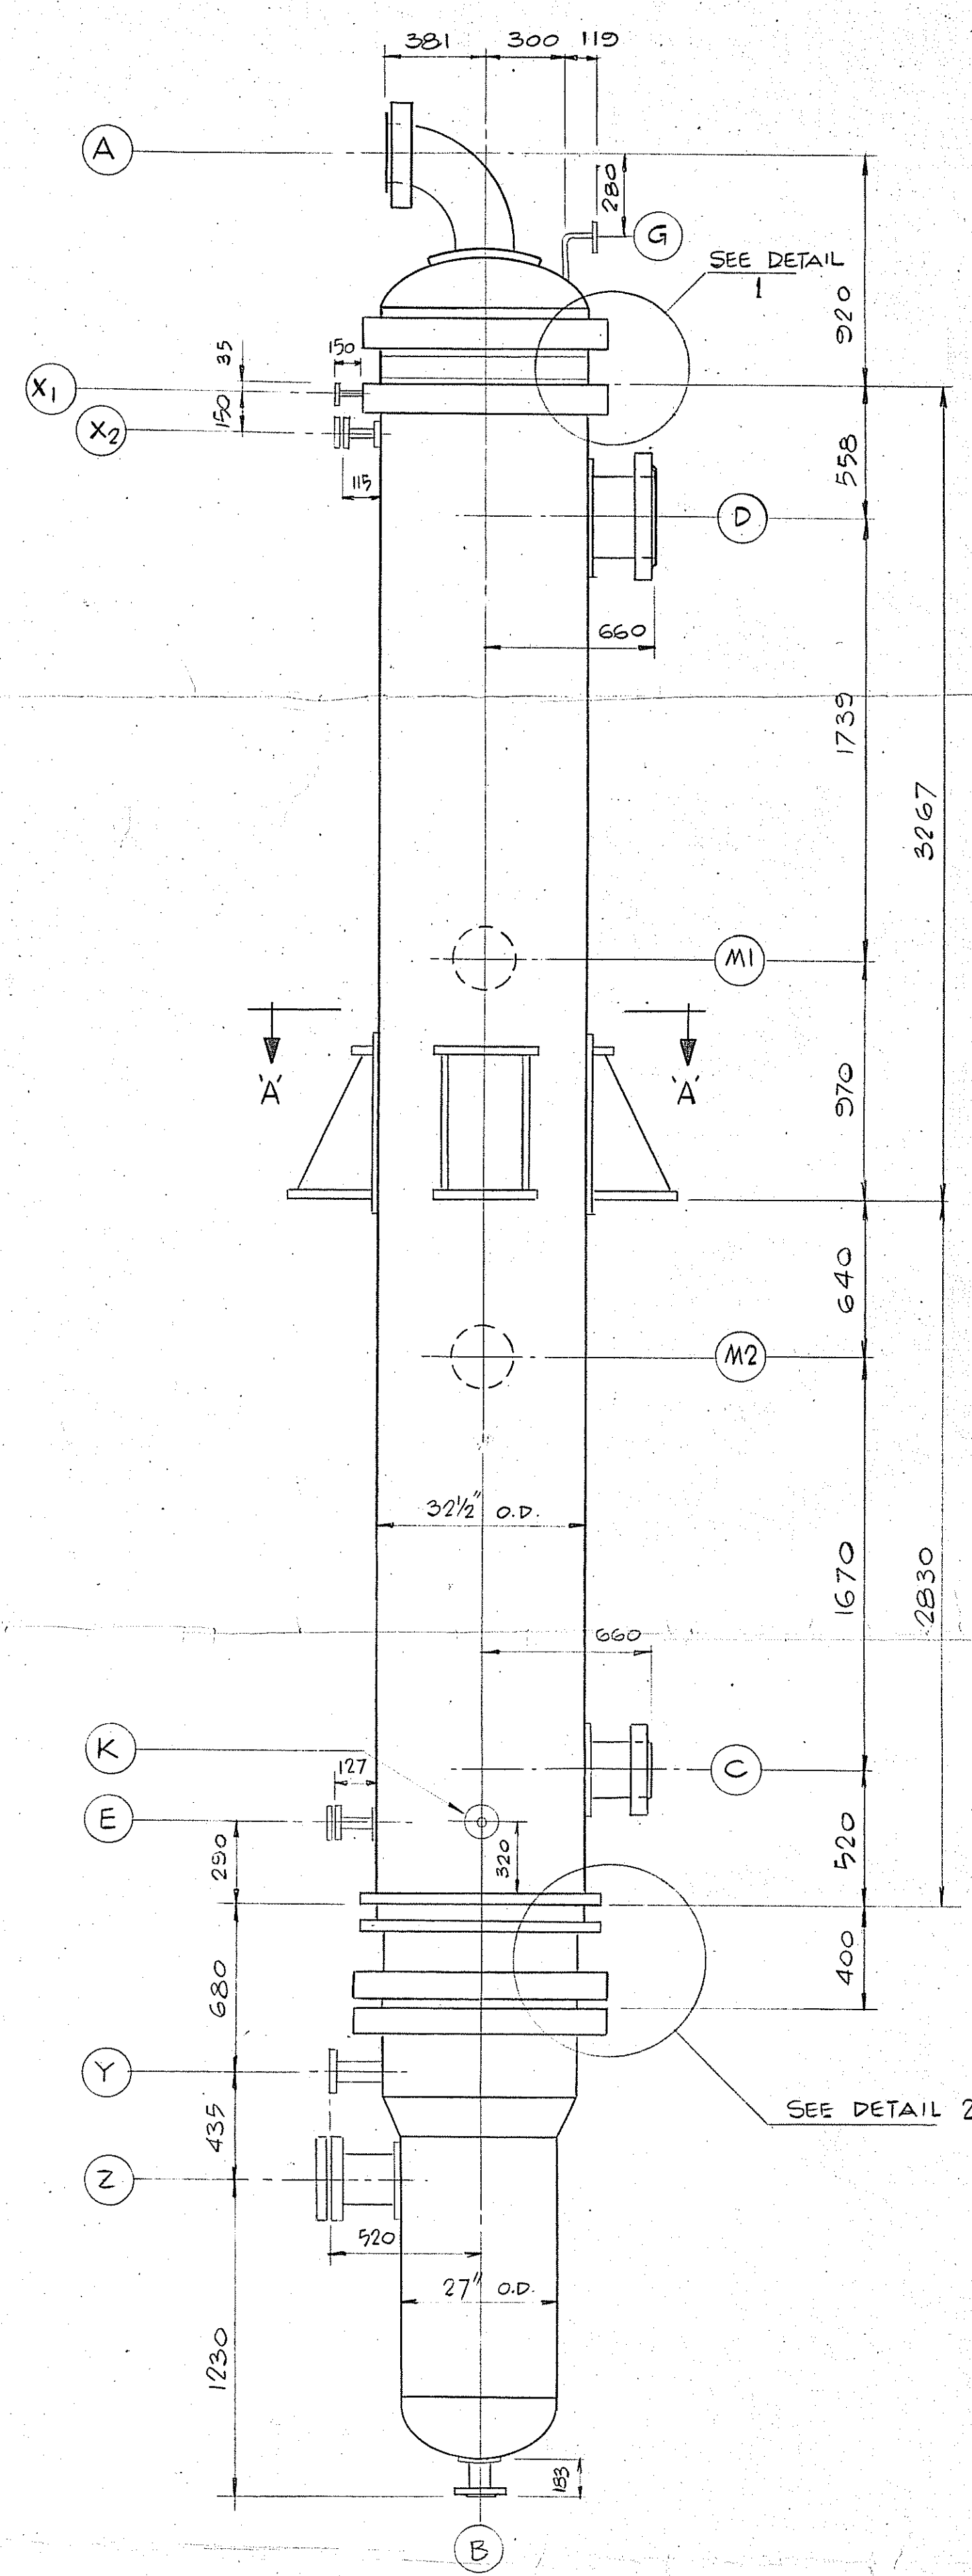


ELEVATION

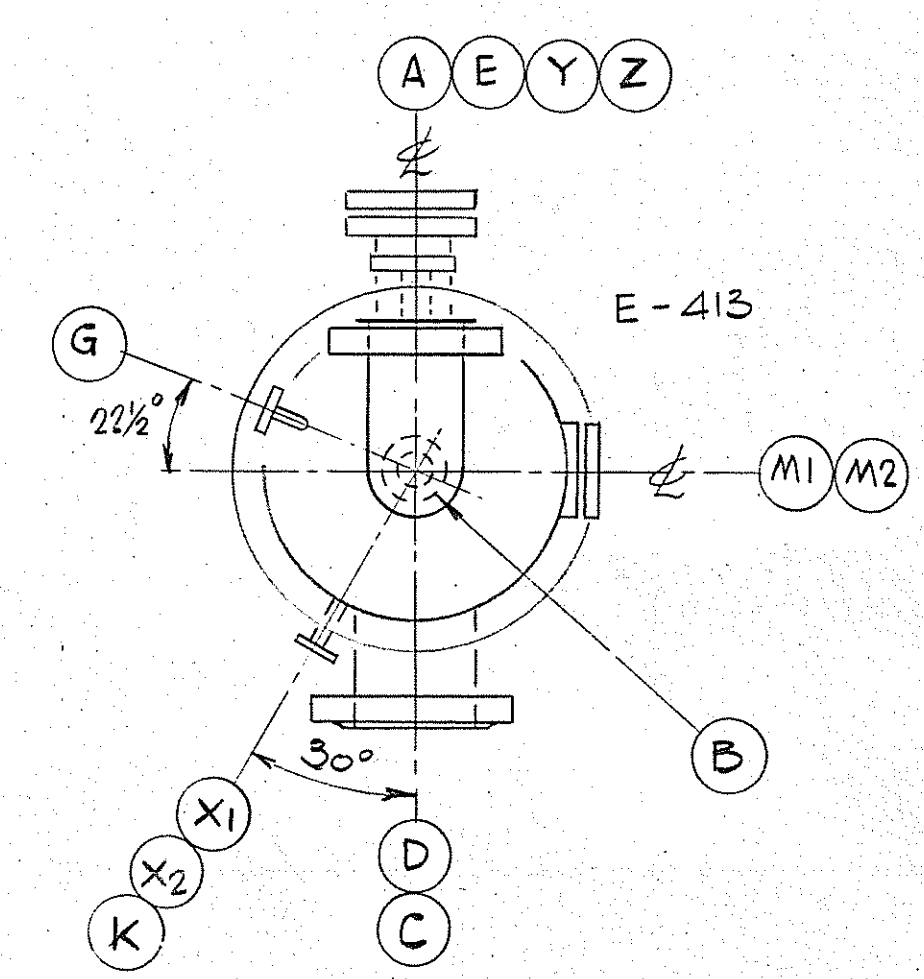

PLAN VIEW
(TRUE ORIENTATION)

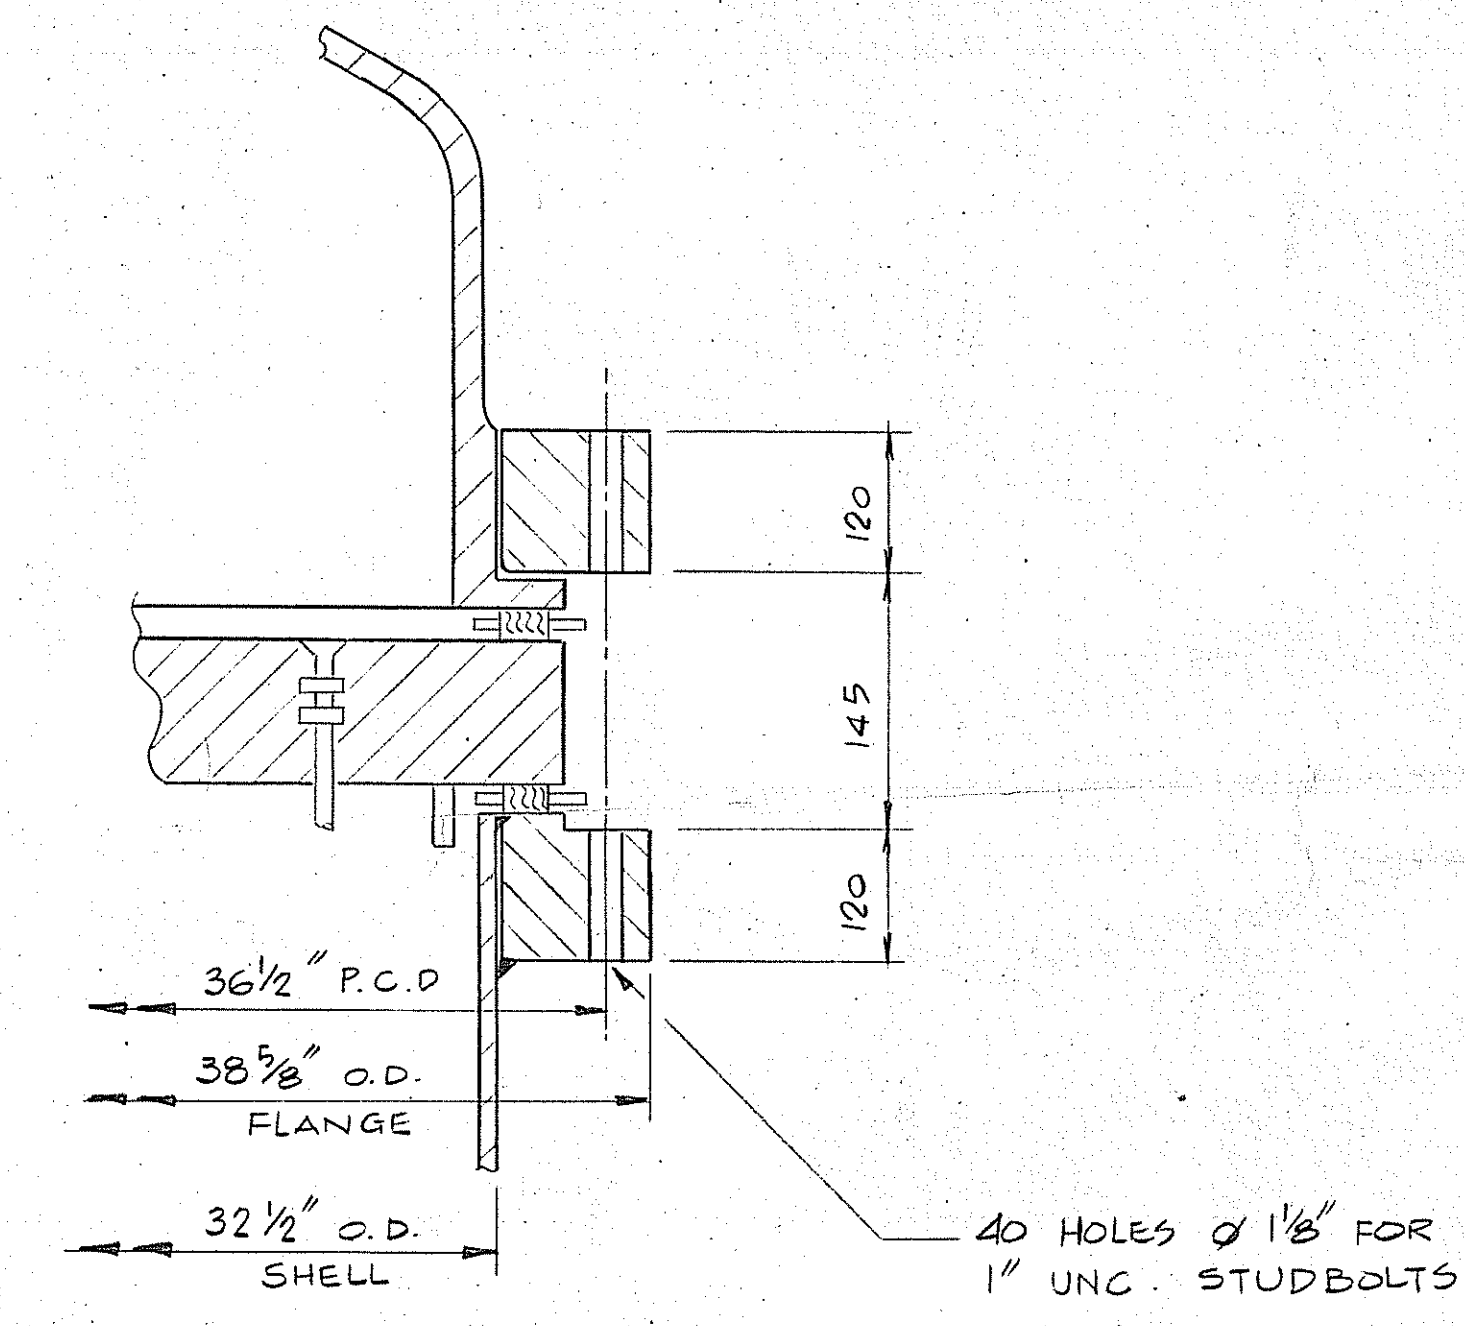


DETAIL 1

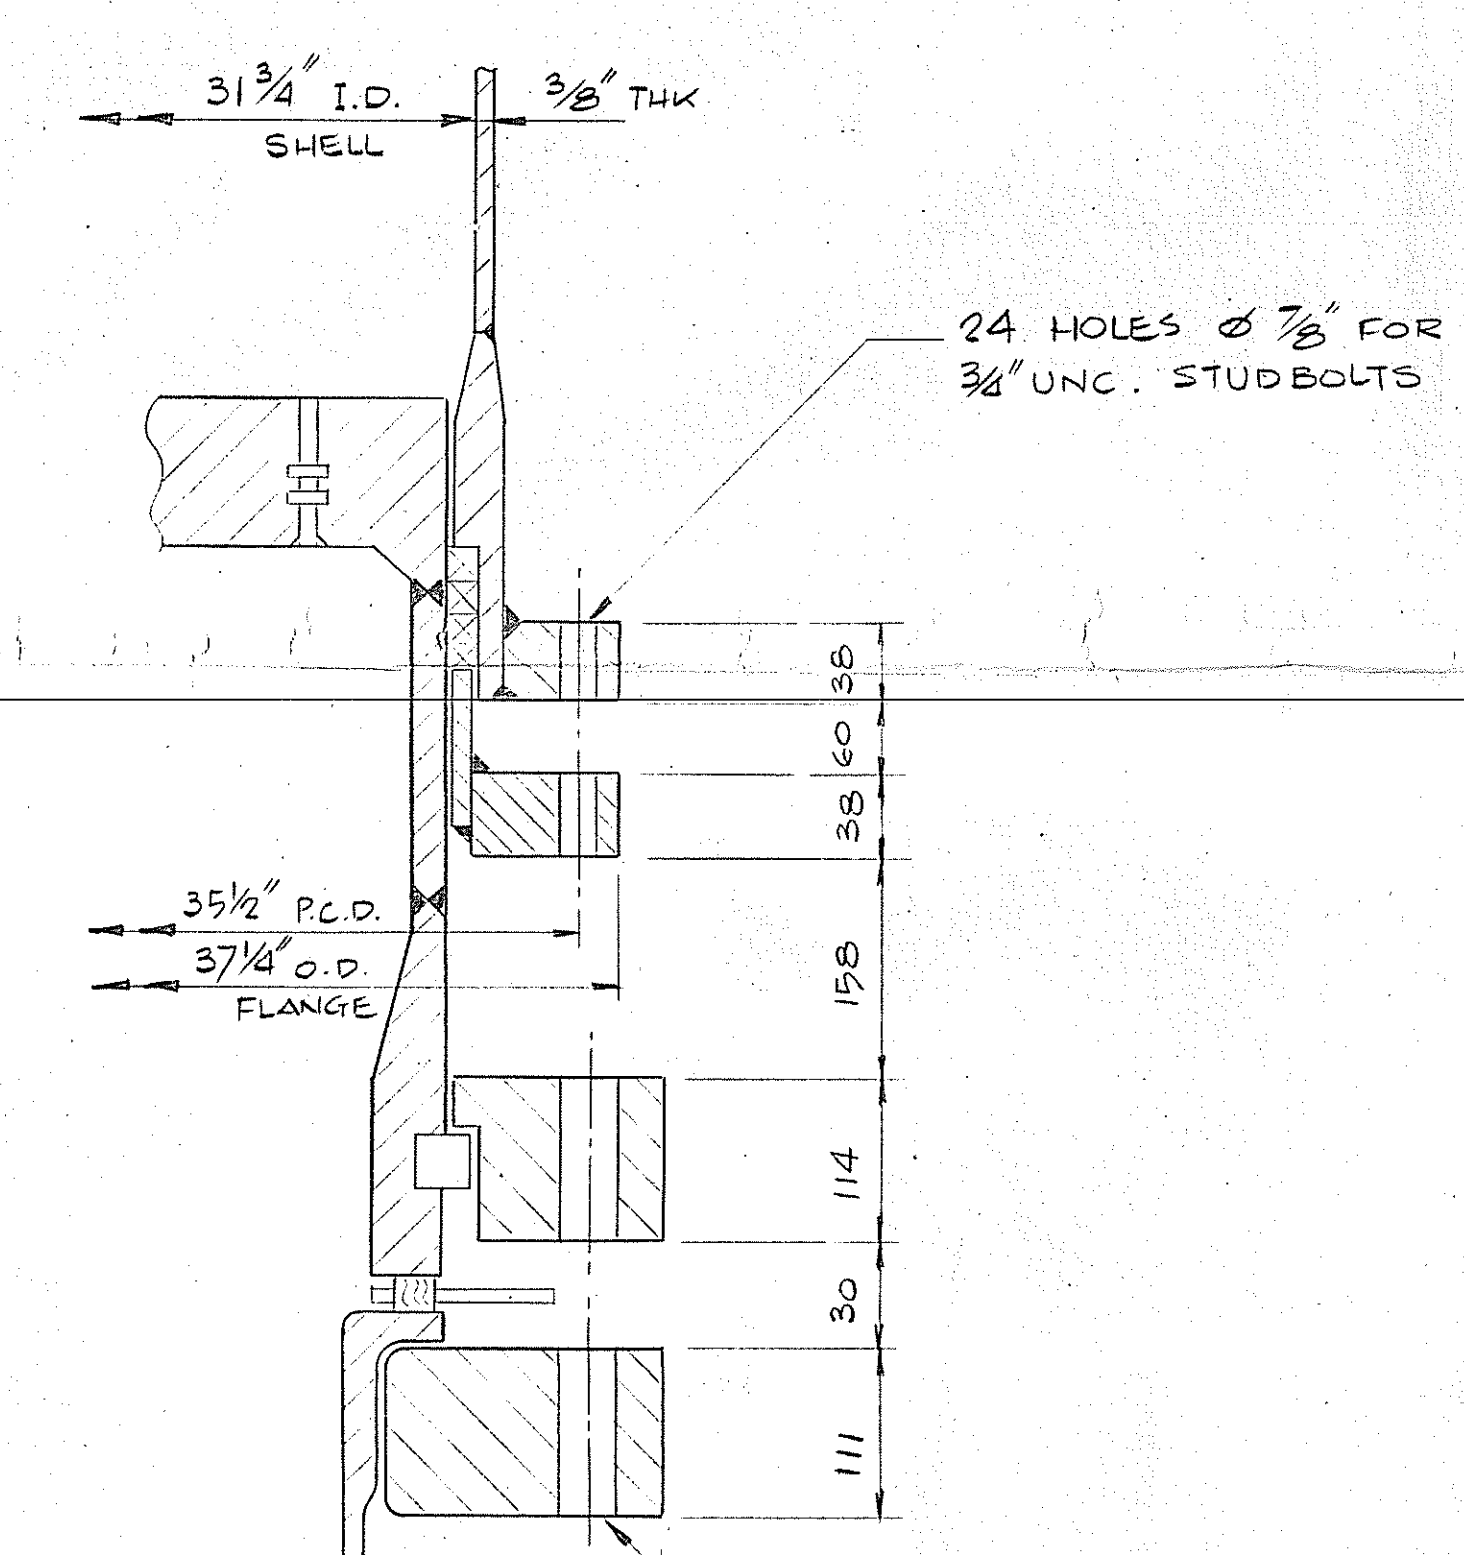


DETAIL 2

8 NO SLOTTED HOLES
Ø 22 x 45 LG FOR
M20 HEX. HEAD BOLTS

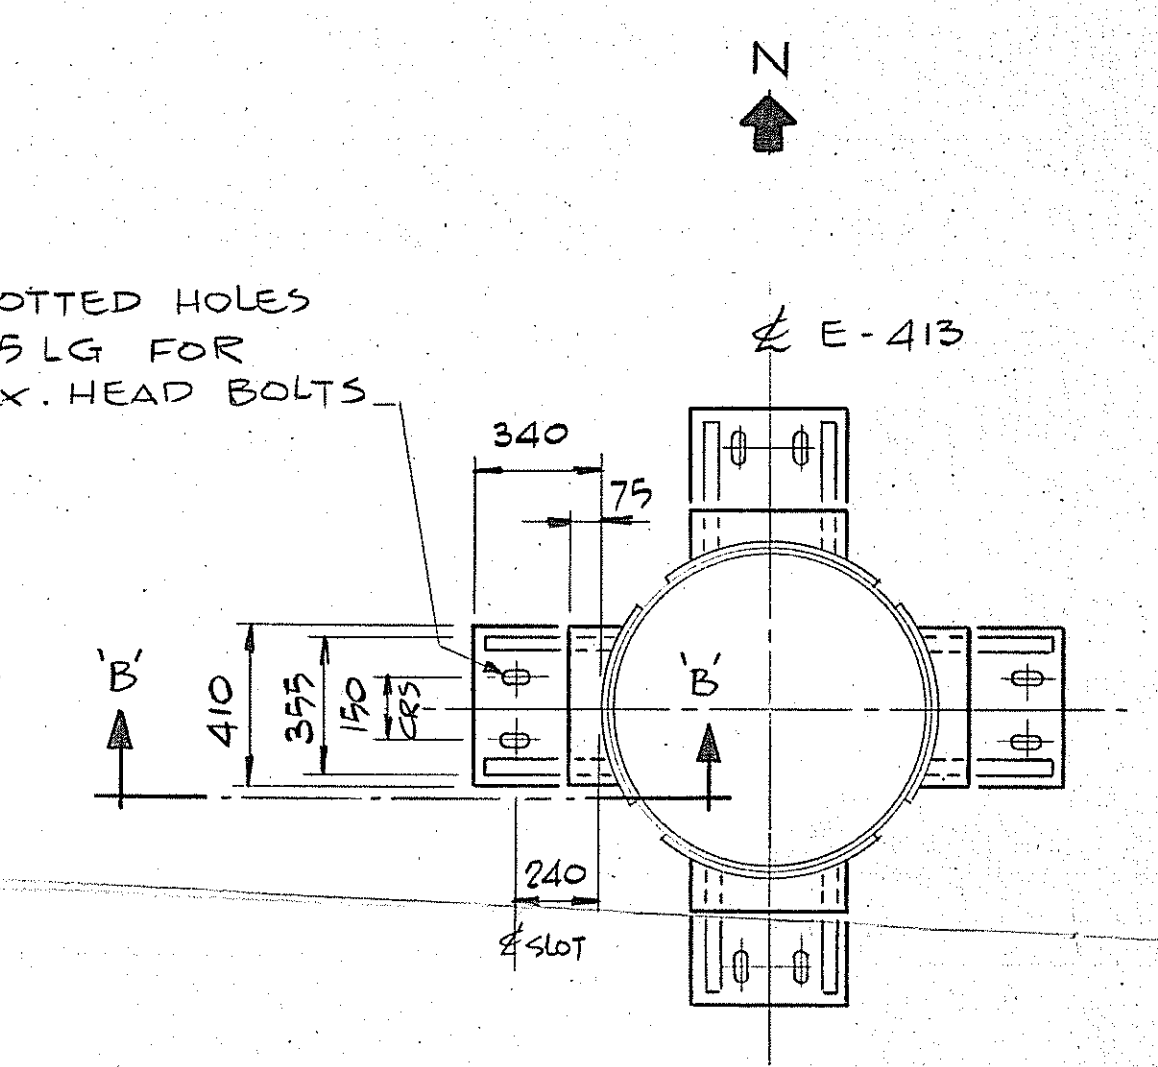

SECTION 'A'-'A'

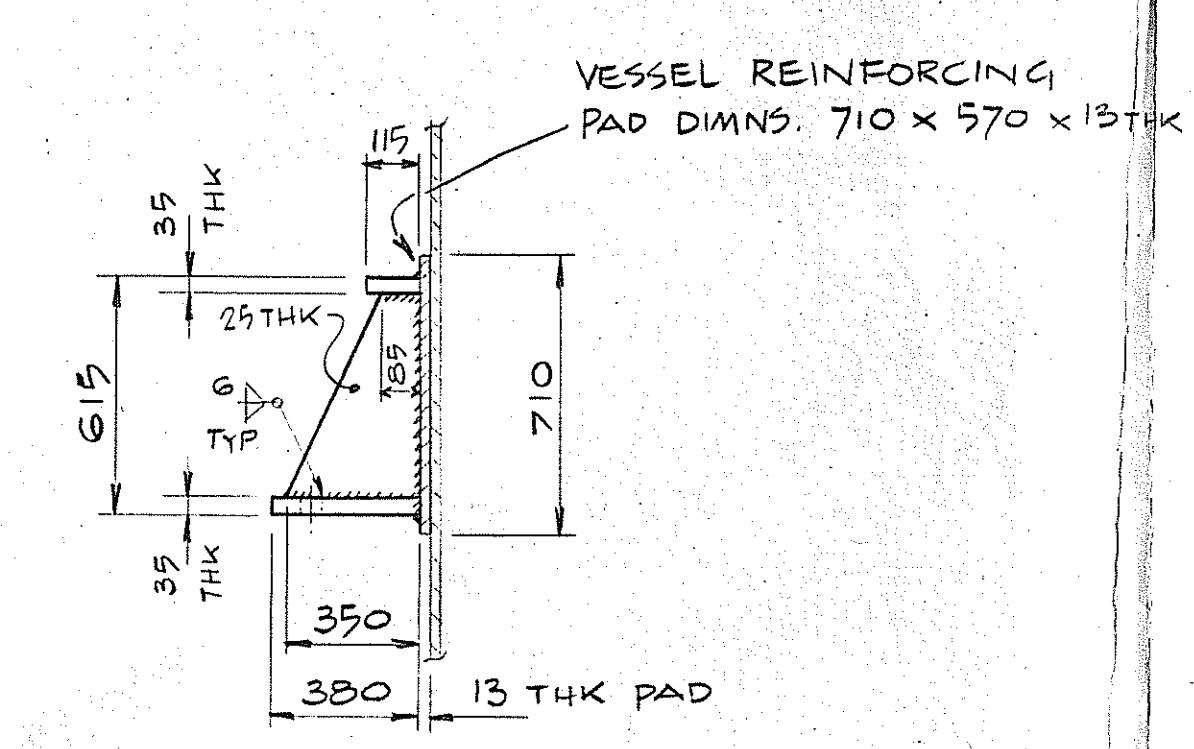

SECTION 'B'-'B'
(TYPICAL FOR VERTICAL GUSSET PLATES)


GENERAL NOTES

- ALL DIMENSIONS GIVEN ON THIS DRAWING REFLECT THE 'AS BUILT' STATUS OF VESSEL E-413
- VESSEL BODY FLANGES ARE SHOWN WITH O.D. AND P.C.D. IN IMPERIAL DIMENSIONS FOR PURPOSES OF RE-MATCHING

NOZZLE DATA

MARK	SIZE	RATING	FACING	WALL THK	SERVICE
A	10"NB	300#	L.J.	EX-STG	PROCESS IN
B	3"NB	300#	R.F.	SCH 40	PROCESS OUT
C	8"NB	150#	R.F.	SCH 40	CONDENSATE IN
D	4"NB	150#	R.F.	SCH 40	STEAM & WATER OUT
E	1/2"NB	150#	R.F.	SCH 40	BLOWDOWN CONN. (BLANKED)
G	1"NB	300#	L.J.	SCH 160	CAUSTIC CONN. (BLANKED)
M1	6"NB	150#	R.F.	PAD	INSPECTION (BLANKED)
M2	6"NB	150#	R.F.	PAD	INSPECTION (BLANKED)
X1	1"NB	150#	R.F.	SCH 80	RELIEF
X2	1"NB	150#	R.F.	SCH 80	VENT (BLANKED)
K	1"NB	150#	R.F.	SCH 80	DRAIN CONN. (BLANKED)
Y	3"NB	300#	R.F.	SCH 40	WATER INLET
Z	8"NB	300#	R.F.	SCH 40	INSPECTION (BLANKED)

PRELIMINARY

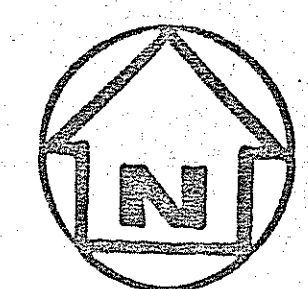

ICI. CHEMICALS & POLYMERS LTD. - TEESIDE OPERATIONS - ENGINEERING - WILTON, MIDDLESBROUGH, CLEVELAND.

THIS DRAWING IS A PRIVATE AND CONFIDENTIAL COMMUNICATION AND THE PROPERTY OF IMPERIAL CHEMICAL INDUSTRIES C & P LTD. IT MUST NOT BE COPIED OR LOANED WITHOUT THE CONSENT OF ICI AND MUST BE RETURNED.


JOB No. / E.W.D. No. DRAWN: A. PAISLEY 2/9/90
D.O. REF. No. 300 167 CHECKED: D. NASSAU 20/9/90
CALC. No. APPROVED:
SCALE 1:20

PLANT TA-T7
BUSINESS AREA OXIDATION
MATERIAL LIST
PROJECT No.

TITLE 'AS BUILT' G.A. OF E-413 REACTOR CONDENSER
DRG. No. D/A7/14/5922
ISSUE PI

ISSUE	REVISIONS	INTL.	DATE	DRAWING No.	REFERENCE DRAWINGS

DRG. No. D/A7/14/5922

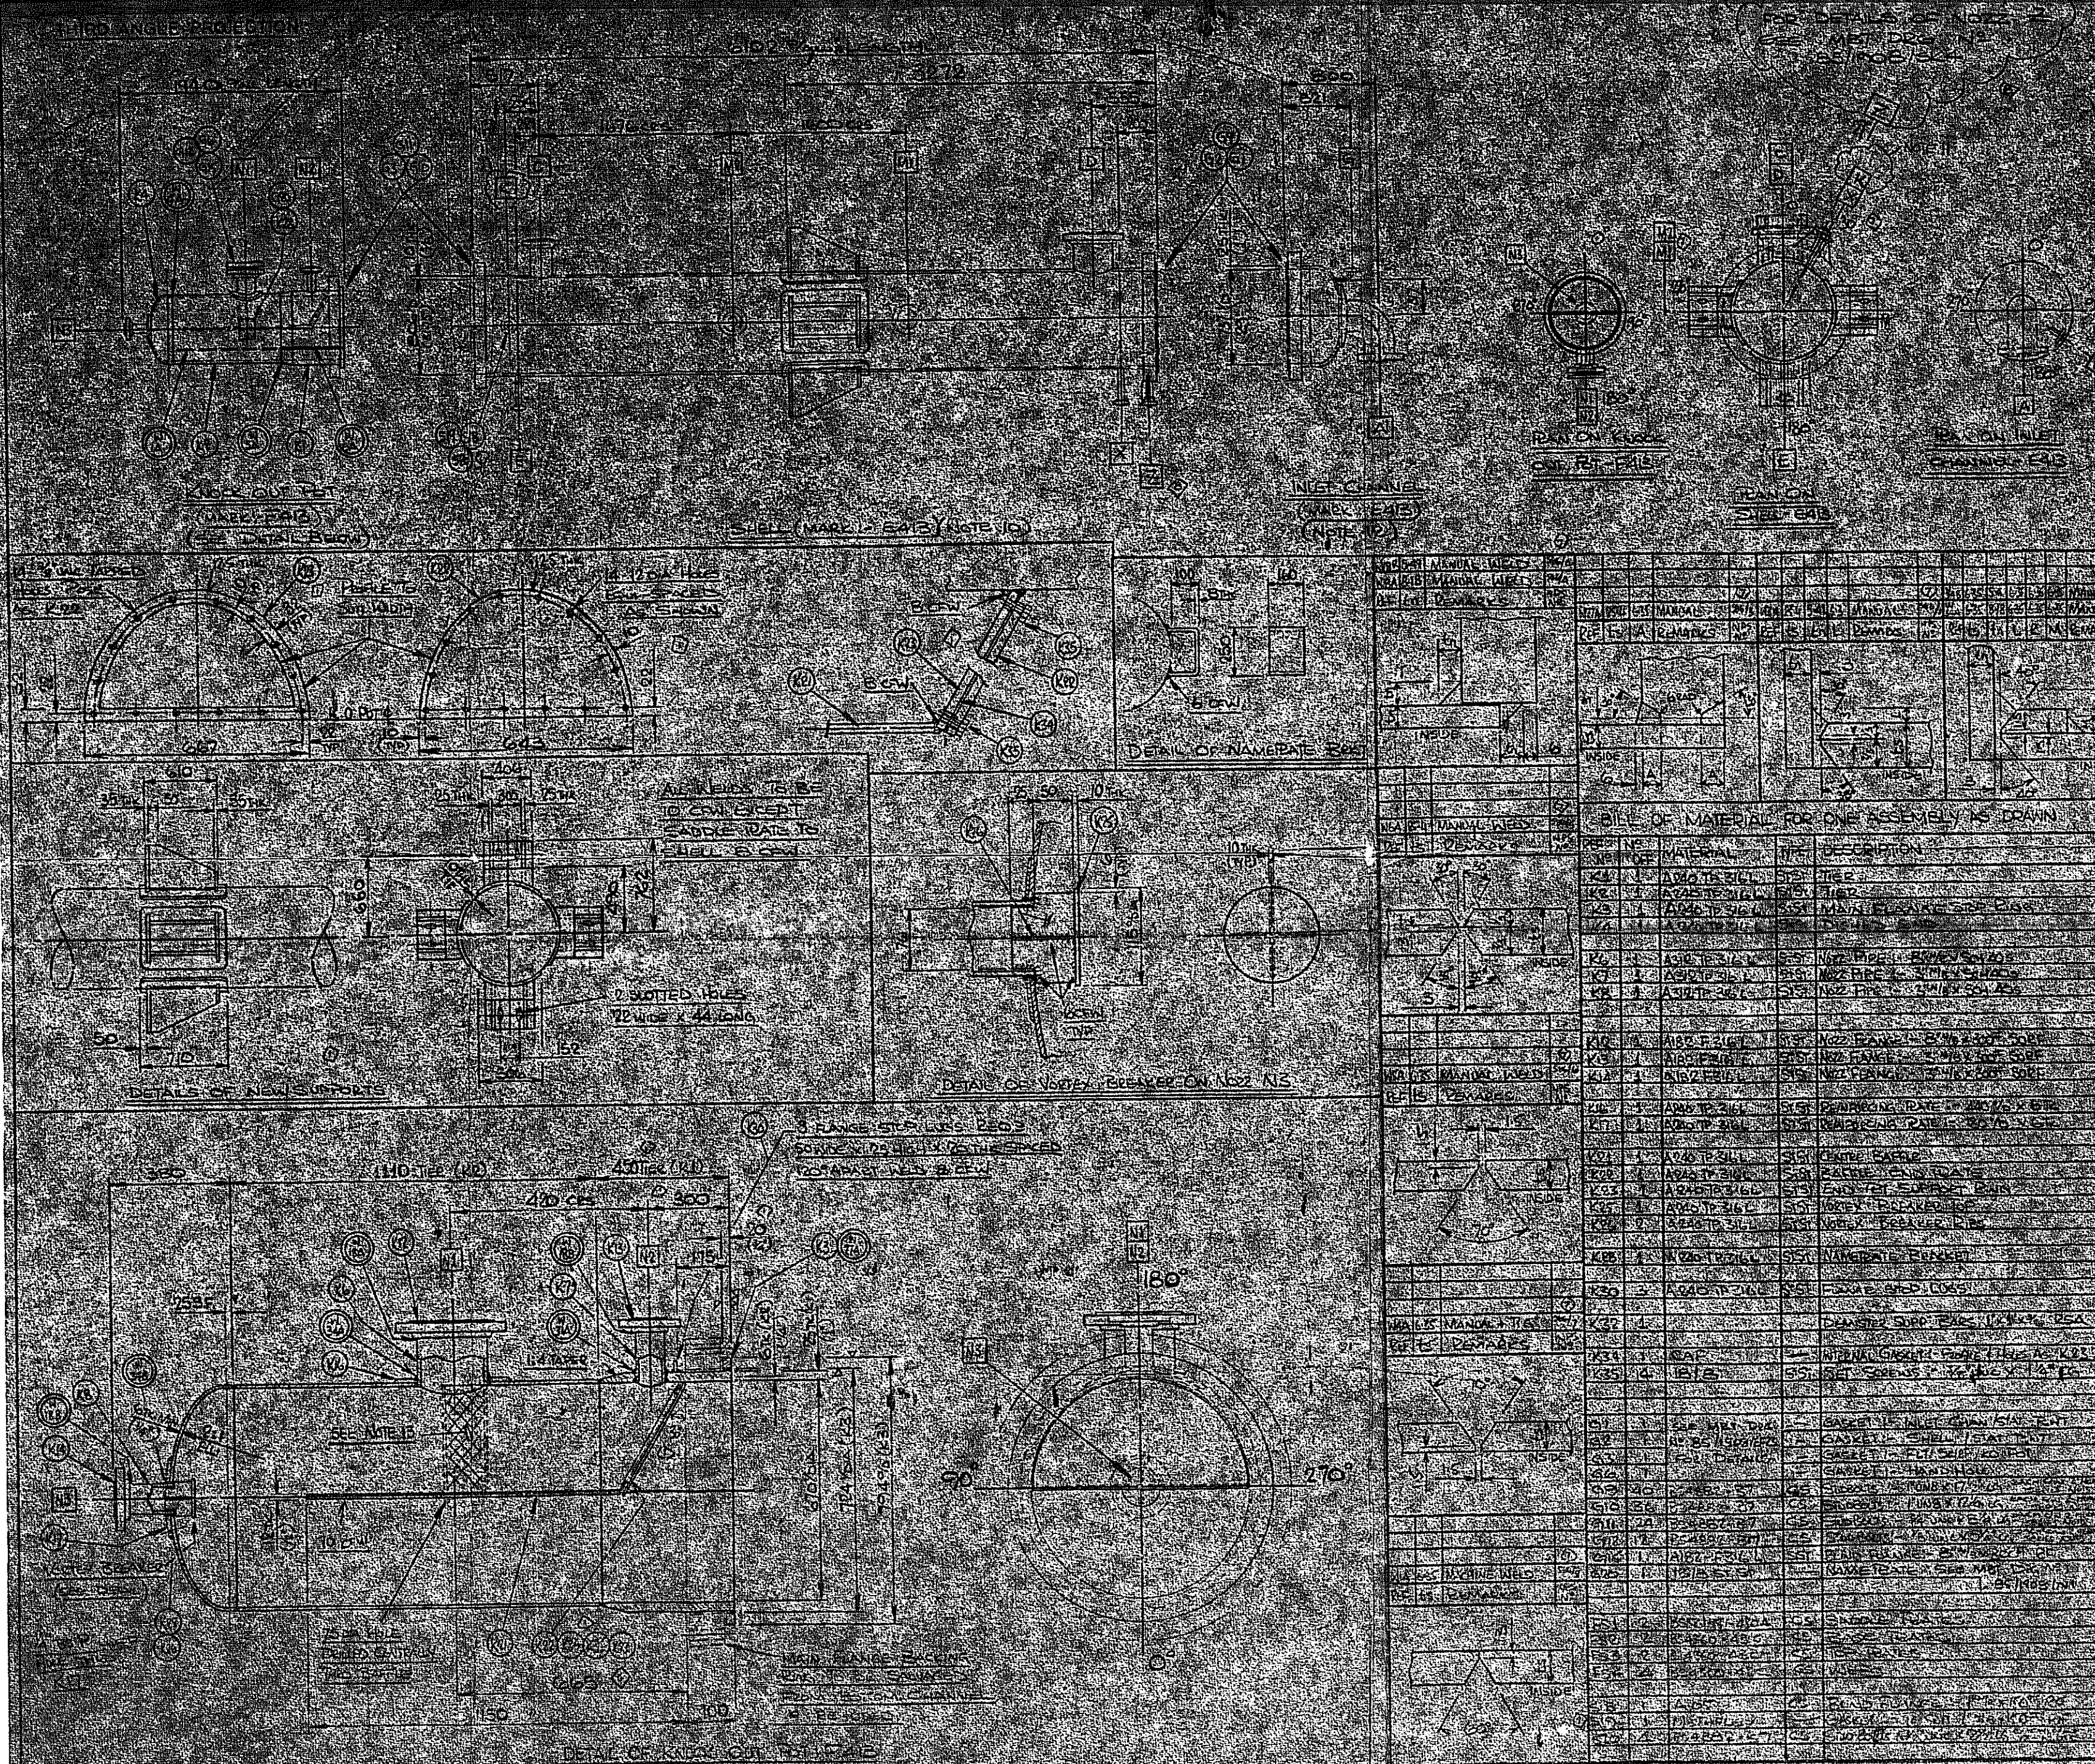

BILL OF MATERIALS FOR ONE ASSEMBLY AS DRAWN

NO.	QTY	MATERIAL	SIZE	DESCRIPTION	REF.
1	1	SAFETY VALVE	1/2"	SAFETY VALVE	1
2	1	SAFETY VALVE	1/2"	SAFETY VALVE	2
3	1	SAFETY VALVE	1/2"	SAFETY VALVE	3
100	1	SAFETY VALVE	1/2"	SAFETY VALVE	100

GENERAL NOTES

1. ALL DIMENSIONS ARE IN INCHES UNLESS OTHERWISE SPECIFIED.

2. MATERIALS TO BE AS PER SPECIFICATION.

3. SURFACE FINISH TO BE AS PER SPECIFICATION.

4. WELDING TO BE AS PER SPECIFICATION.

5. PAINTING TO BE AS PER SPECIFICATION.

6. ALL PARTS TO BE IDENTIFIED BY MARKING.

7. ALL PARTS TO BE CHECKED FOR DEFECTS BEFORE ASSEMBLY.

8. ALL PARTS TO BE CHECKED FOR DIMENSIONS BEFORE ASSEMBLY.

9. ALL PARTS TO BE CHECKED FOR FINISH BEFORE ASSEMBLY.

10. ALL PARTS TO BE CHECKED FOR WEIGHT BEFORE ASSEMBLY.

11. ALL PARTS TO BE CHECKED FOR BALANCE BEFORE ASSEMBLY.

12. ALL PARTS TO BE CHECKED FOR STRENGTH BEFORE ASSEMBLY.

13. ALL PARTS TO BE CHECKED FOR DURABILITY BEFORE ASSEMBLY.

14. ALL PARTS TO BE CHECKED FOR RELIABILITY BEFORE ASSEMBLY.

15. ALL PARTS TO BE CHECKED FOR SAFETY BEFORE ASSEMBLY.

16. ALL PARTS TO BE CHECKED FOR QUALITY BEFORE ASSEMBLY.

17. ALL PARTS TO BE CHECKED FOR PERFORMANCE BEFORE ASSEMBLY.

18. ALL PARTS TO BE CHECKED FOR EFFICIENCY BEFORE ASSEMBLY.

19. ALL PARTS TO BE CHECKED FOR EFFECTIVENESS BEFORE ASSEMBLY.

20. ALL PARTS TO BE CHECKED FOR PRODUCTIVITY BEFORE ASSEMBLY.

21. ALL PARTS TO BE CHECKED FOR PROFITABILITY BEFORE ASSEMBLY.

22. ALL PARTS TO BE CHECKED FOR CUSTOMER SATISFACTION BEFORE ASSEMBLY.

23. ALL PARTS TO BE CHECKED FOR MARKET ACCEPTANCE BEFORE ASSEMBLY.

24. ALL PARTS TO BE CHECKED FOR COMPETITIVE ADVANTAGE BEFORE ASSEMBLY.

25. ALL PARTS TO BE CHECKED FOR INNOVATION BEFORE ASSEMBLY.

26. ALL PARTS TO BE CHECKED FOR SUSTAINABILITY BEFORE ASSEMBLY.

27. ALL PARTS TO BE CHECKED FOR SOCIAL RESPONSIBILITY BEFORE ASSEMBLY.

28. ALL PARTS TO BE CHECKED FOR ENVIRONMENTAL FRIENDLINESS BEFORE ASSEMBLY.

29. ALL PARTS TO BE CHECKED FOR ETHICAL BEHAVIOR BEFORE ASSEMBLY.

30. ALL PARTS TO BE CHECKED FOR LEGAL COMPLIANCE BEFORE ASSEMBLY.

31. ALL PARTS TO BE CHECKED FOR REGULATORY COMPLIANCE BEFORE ASSEMBLY.

32. ALL PARTS TO BE CHECKED FOR INDUSTRY STANDARDS BEFORE ASSEMBLY.

33. ALL PARTS TO BE CHECKED FOR BEST PRACTICES BEFORE ASSEMBLY.

34. ALL PARTS TO BE CHECKED FOR CONTINUOUS IMPROVEMENT BEFORE ASSEMBLY.

35. ALL PARTS TO BE CHECKED FOR LEADERSHIP BEFORE ASSEMBLY.

36. ALL PARTS TO BE CHECKED FOR EXCELLENCE BEFORE ASSEMBLY.

37. ALL PARTS TO BE CHECKED FOR PERFECTION BEFORE ASSEMBLY.

38. ALL PARTS TO BE CHECKED FOR HONESTY BEFORE ASSEMBLY.

39. ALL PARTS TO BE CHECKED FOR INTEGRITY BEFORE ASSEMBLY.

40. ALL PARTS TO BE CHECKED FOR COURAGE BEFORE ASSEMBLY.

41. ALL PARTS TO BE CHECKED FOR KINDNESS BEFORE ASSEMBLY.

42. ALL PARTS TO BE CHECKED FOR PATIENCE BEFORE ASSEMBLY.

43. ALL PARTS TO BE CHECKED FOR HUMILITY BEFORE ASSEMBLY.

44. ALL PARTS TO BE CHECKED FOR GRACE BEFORE ASSEMBLY.

45. ALL PARTS TO BE CHECKED FOR FAITH BEFORE ASSEMBLY.

46. ALL PARTS TO BE CHECKED FOR HOPE BEFORE ASSEMBLY.

47. ALL PARTS TO BE CHECKED FOR CHARITY BEFORE ASSEMBLY.

48. ALL PARTS TO BE CHECKED FOR LOVE BEFORE ASSEMBLY.

49. ALL PARTS TO BE CHECKED FOR PEACE BEFORE ASSEMBLY.

50. ALL PARTS TO BE CHECKED FOR JOY BEFORE ASSEMBLY.

66. ALL PARTS TO BE CHECKED FOR HOPE BEFORE ASSEMBLY.

67. ALL PARTS TO BE CHECKED FOR CHARITY BEFORE ASSEMBLY.

68. ALL PARTS TO BE CHECKED FOR LOVE BEFORE ASSEMBLY.

69. ALL PARTS TO BE CHECKED FOR PEACE BEFORE ASSEMBLY.

70. ALL PARTS TO BE CHECKED FOR JOY BEFORE ASSEMBLY.

71. ALL PARTS TO BE CHECKED FOR KINDNESS BEFORE ASSEMBLY.

72. ALL PARTS TO BE CHECKED FOR PATIENCE BEFORE ASSEMBLY.

73. ALL PARTS TO BE CHECKED FOR HUMILITY BEFORE ASSEMBLY.

74. ALL PARTS TO BE CHECKED FOR GRACE BEFORE ASSEMBLY.

75. ALL PARTS TO BE CHECKED FOR FAITH BEFORE ASSEMBLY.

76. ALL PARTS TO BE CHECKED FOR HOPE BEFORE ASSEMBLY.

77. ALL PARTS TO BE CHECKED FOR CHARITY BEFORE ASSEMBLY