


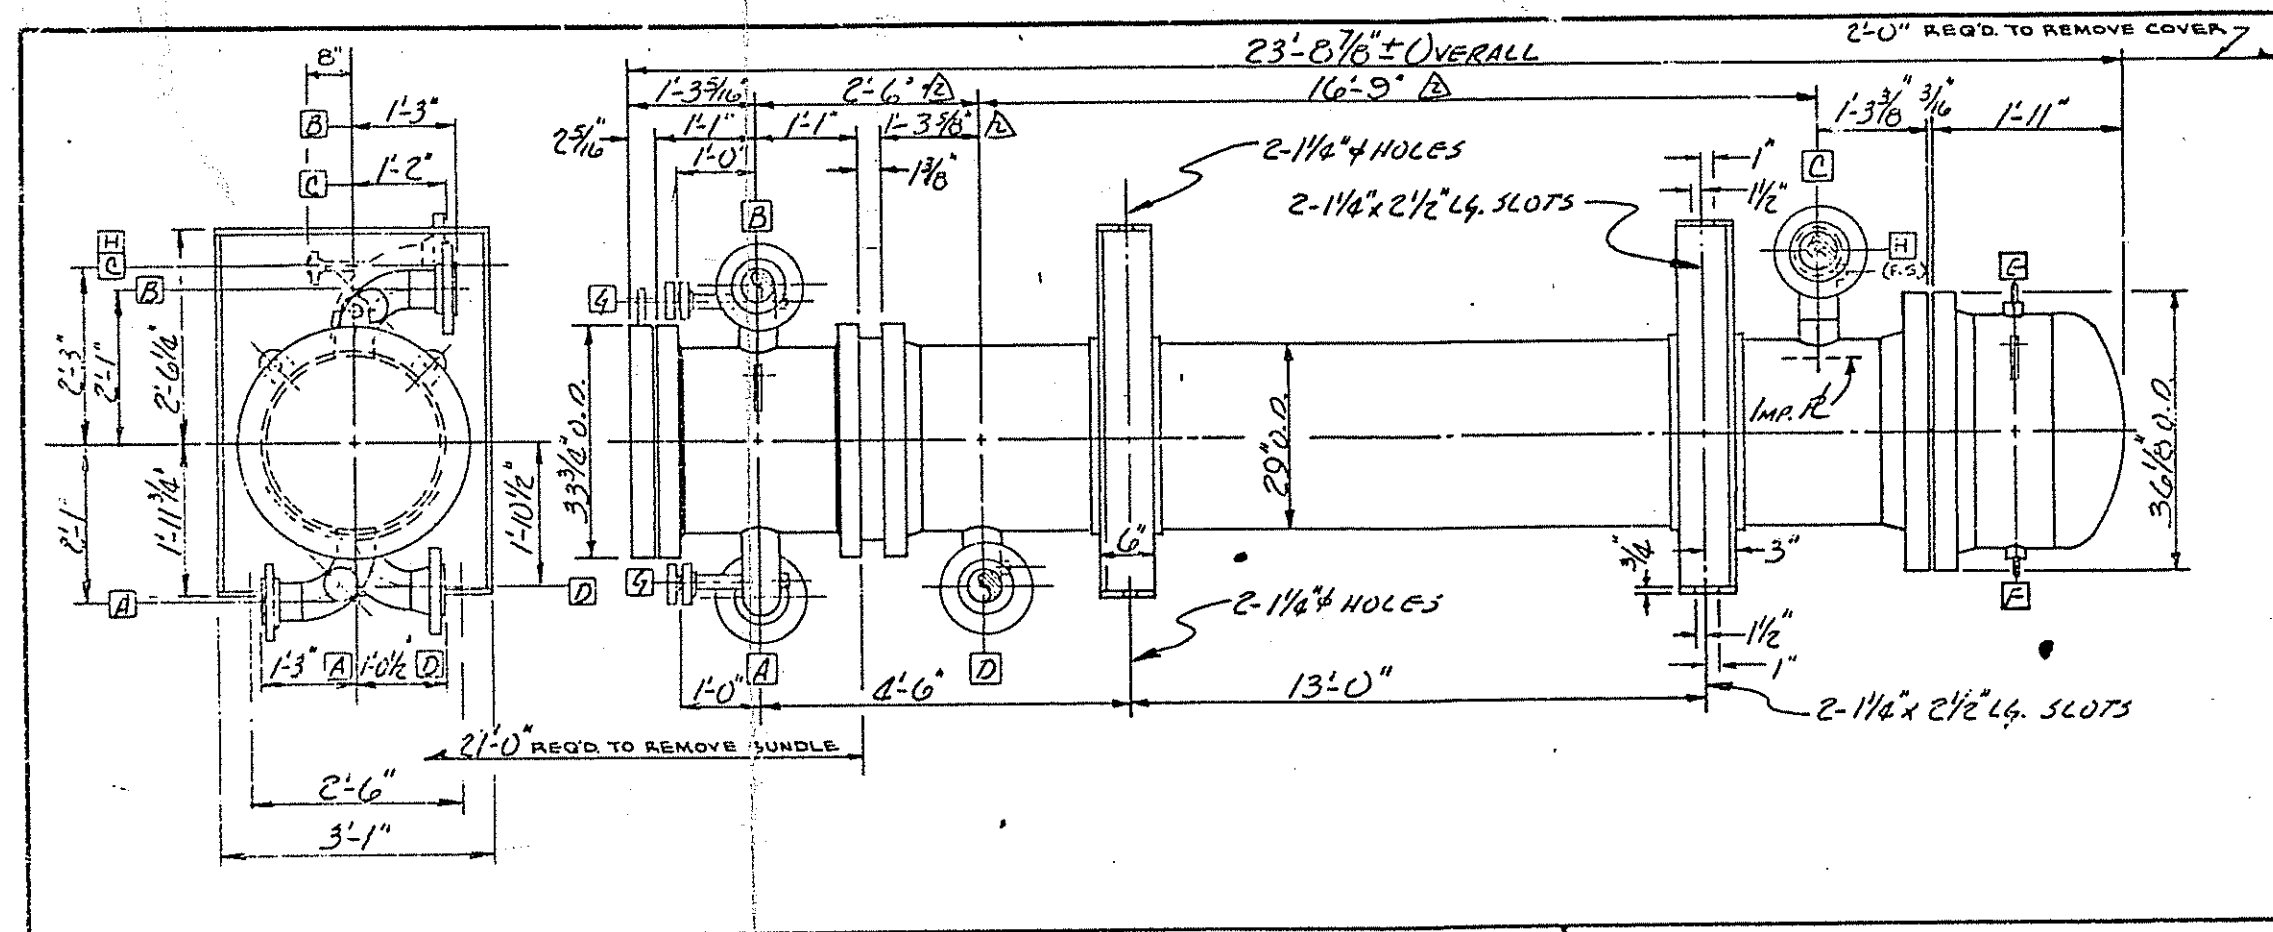

DESIGN DATA				NOZZLE DATA				GENERAL NOTES		CERTIFIED CORRECT FOR FABRICATION						
	SHELL	TUBES		MARK	SIZE	RATING	FACING	SERVICE	1. DESIGN & CONSTRUCTION SHALL BE IN ACCORDANCE WITH: Δ		BY: J. D. Harrison	DATE: 9/23/80				
DESIGN PRESSURE	150 PSI	75 PSI		A	8"	150#	R.F.	INLET	(A) SECTION VIII 1930 EDITION OF THE ASME CODE, DIV. 1 & SO STAMPED BY NATIONAL BOARD.		CUST.: AMOCO OIL COMPANY					
* TEST PRESS.	225 PSI	115 PSI		B	6"	150#	R.F.	OUTLET	(B) TEMA "R".		DEST.: YORKTOWN, VIRGINIA					
				C	10"	150#	R.F.	INLET	(C) CUST. SPEC'S.		CUST. PO.: 815-3-9706 PROJECT # 7720					
DESIGN TEMPERATURE	350 °F	150 °F		D	6"	150#	R.F.	OUTLET	2. ALL BOLT HOLES TO STRADDLE R.S.		ITEM: C-112 APPH. # 0059					
CORROSION ALLOWANCE	1/8"	1/16"		E	3/4"	6,000#	CPLG	VENT 7/6" NIPPLE	3. SPOT RADIOGRAPH CHAU, SHELL & SHELL COV.		SERVICE: E-10 PFT OVHD. CONDENSER					
NUMBER OF PASSES	1"	4"		F	3/4"	6,000#	CPLG	DRW 7/6" NIPPLE	4. FURNISH ONE SET OF SPARE GASKETS.		SERIAL: 3725					
TUBE SURFACE (RFR)	1829 SQ. FT.			G(R)	2"	150#	R.F.	CHEM. CLEANING	5. FURNISH TEST RING.		FILE: 450-BU					
TUBES: 473 - 3/4" Φ x 185.46' (avg) 18B-33B-4P L				H	2"	150#	R.F.	RELIEF VALVE	6. COMMERCIAL BLAST / SSPC-SP6 & PAINT 2-STL. PARTS ONLY WITH 1-COAT OF CARBOZINE #11 3 MILS D.F.		HUGHES-ANDERSON ENGINEERING CORP. TULSA, OKLAHOMA					
ESTIMATED WEIGHT EACH				Δ				EACH NOZZLE TO HAVE 1-3/4"-6,000# CPLG. AS SHOWN (PLU44ED).								
DRY	9,600 LBS	WET	13,200 LBS	BUNDLE		3,700 LBS										
* MIN. TEST WATER TEMP = 60 °F.																
* * TITANIUM TUBES TO BE ANODIZED ON OUTSIDE SURFACE.																
								DRAWING TITLE OUTLINE DIMENSIONAL								
								WORK ORDER 3725		NUMBER REQ'D. ONE						
DR. KEN		DATE 9/23/80		SIZE 28" x 20"		DRAWING NUMBER		3725-01								
CK Jim		SCALE NONE		TYPE AES												


Δ ADDED 1" RELIEF VALVE By GCP 10-3-80 Δ 11/13/80 J.M.

C-112

05


67

3/2

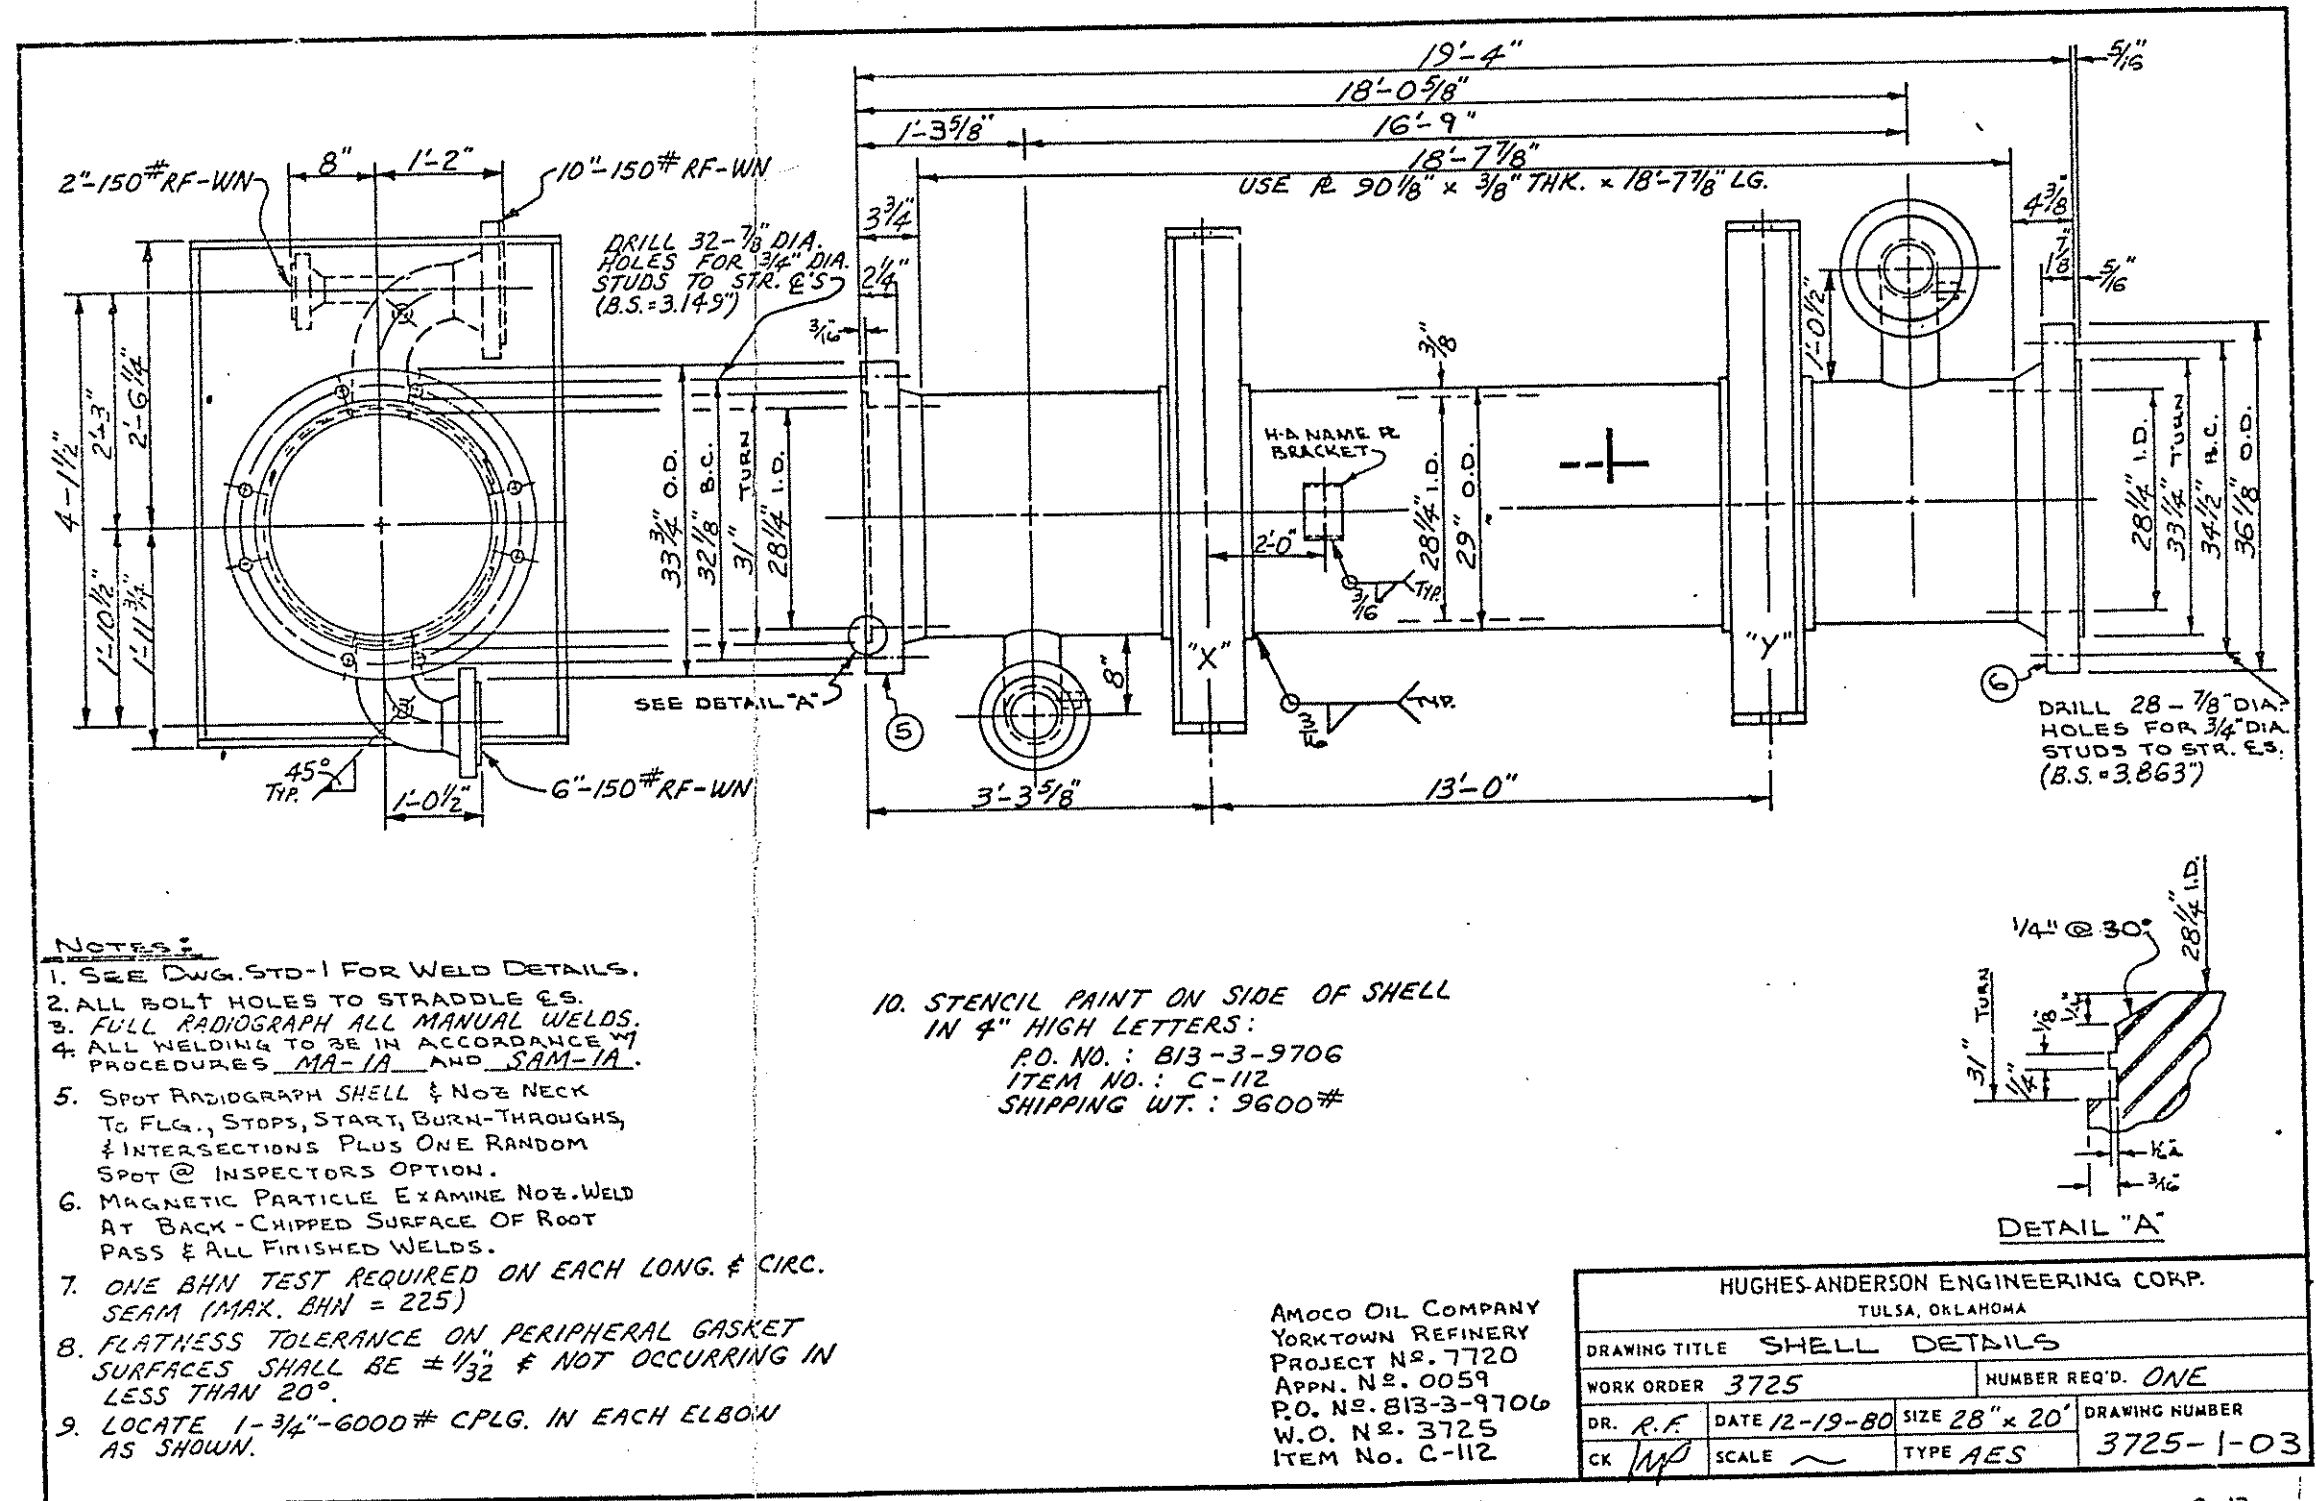

C-112

⊗ DENOTES TIE ROD LOCATIONS

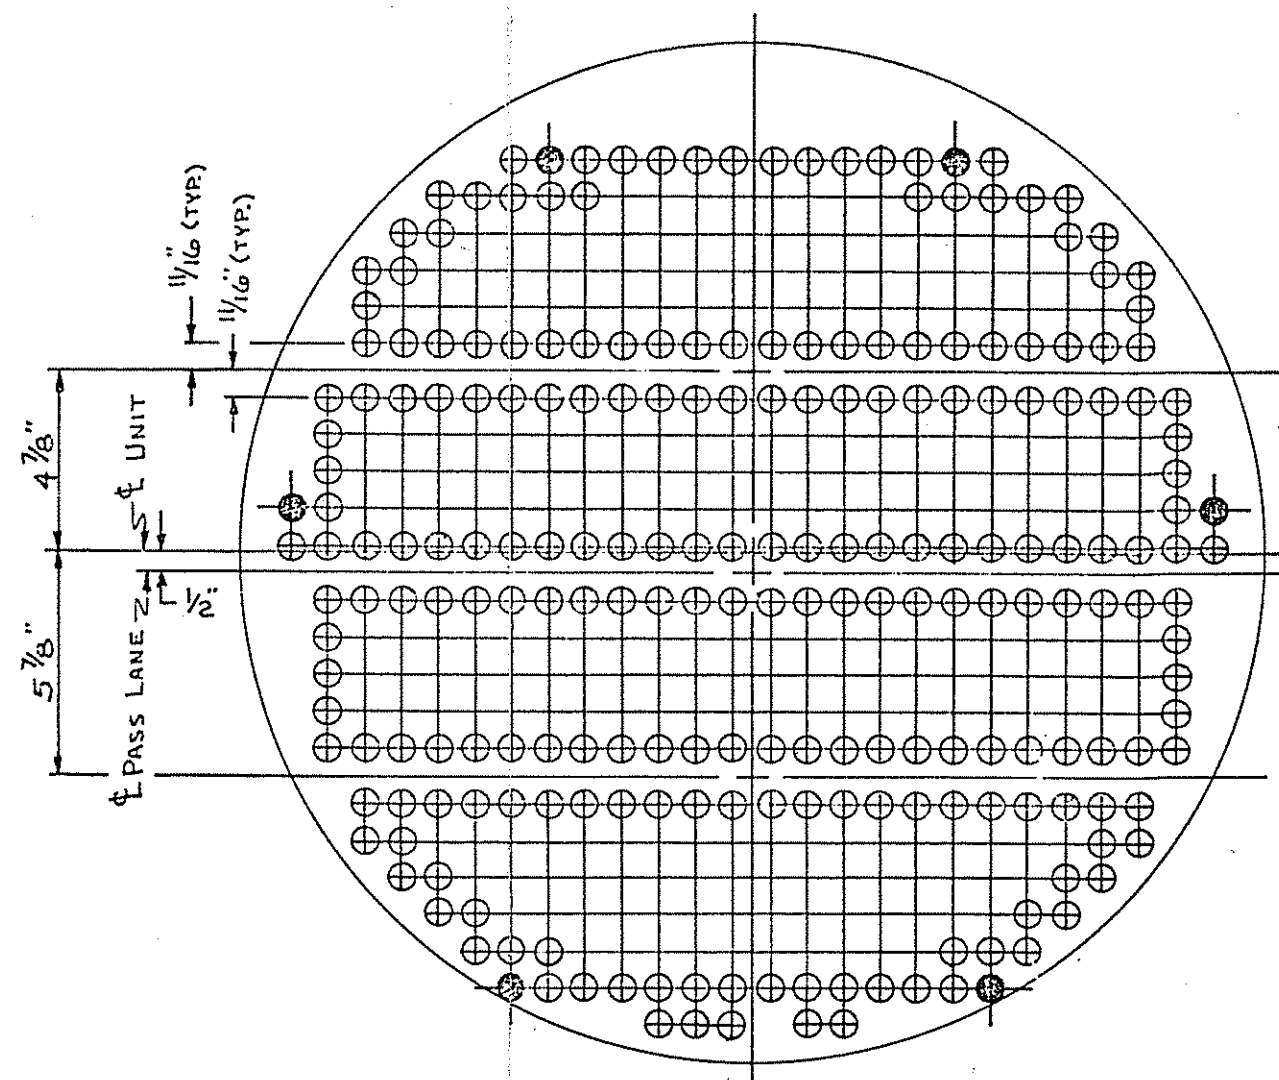

116
122
120
115

TUBES / PASS


AMOCO OIL COMPANY
YORKTOWN REFINERY
PROJECT NO. 7720
APPN. NO. 0059
P.O. NO. 813-3-9706
W.O. NO. 3725
ITEM NO. C-112

NOTE!
DRILL & REAM TUBE HOLES TO $.758 \pm .002$ "
FOR 473-3/4" O.D. TUBES ON 1" $\square$ PITCH &
26 1/16" T.C. GROOVE TUBE HL'S PER DET. "A"
DWG. 3725-06

VIEW LOOKING @ SHELL SIDE
OF # 4 TUBE SHT.

HUGHES-ANDERSON ENGINEERING CORP. TULSA, OKLAHOMA			
DRAWING TITLE TUBE LAYOUT			
WORK ORDER 3725		NUMBER REQ'D. ONE	
DR. GDS	DATE 12/18/80	SIZE 28"X20"	DRAWING NUMBER
CK MP	SCALE 1/4"	TYPE AES	3725-05


C-112

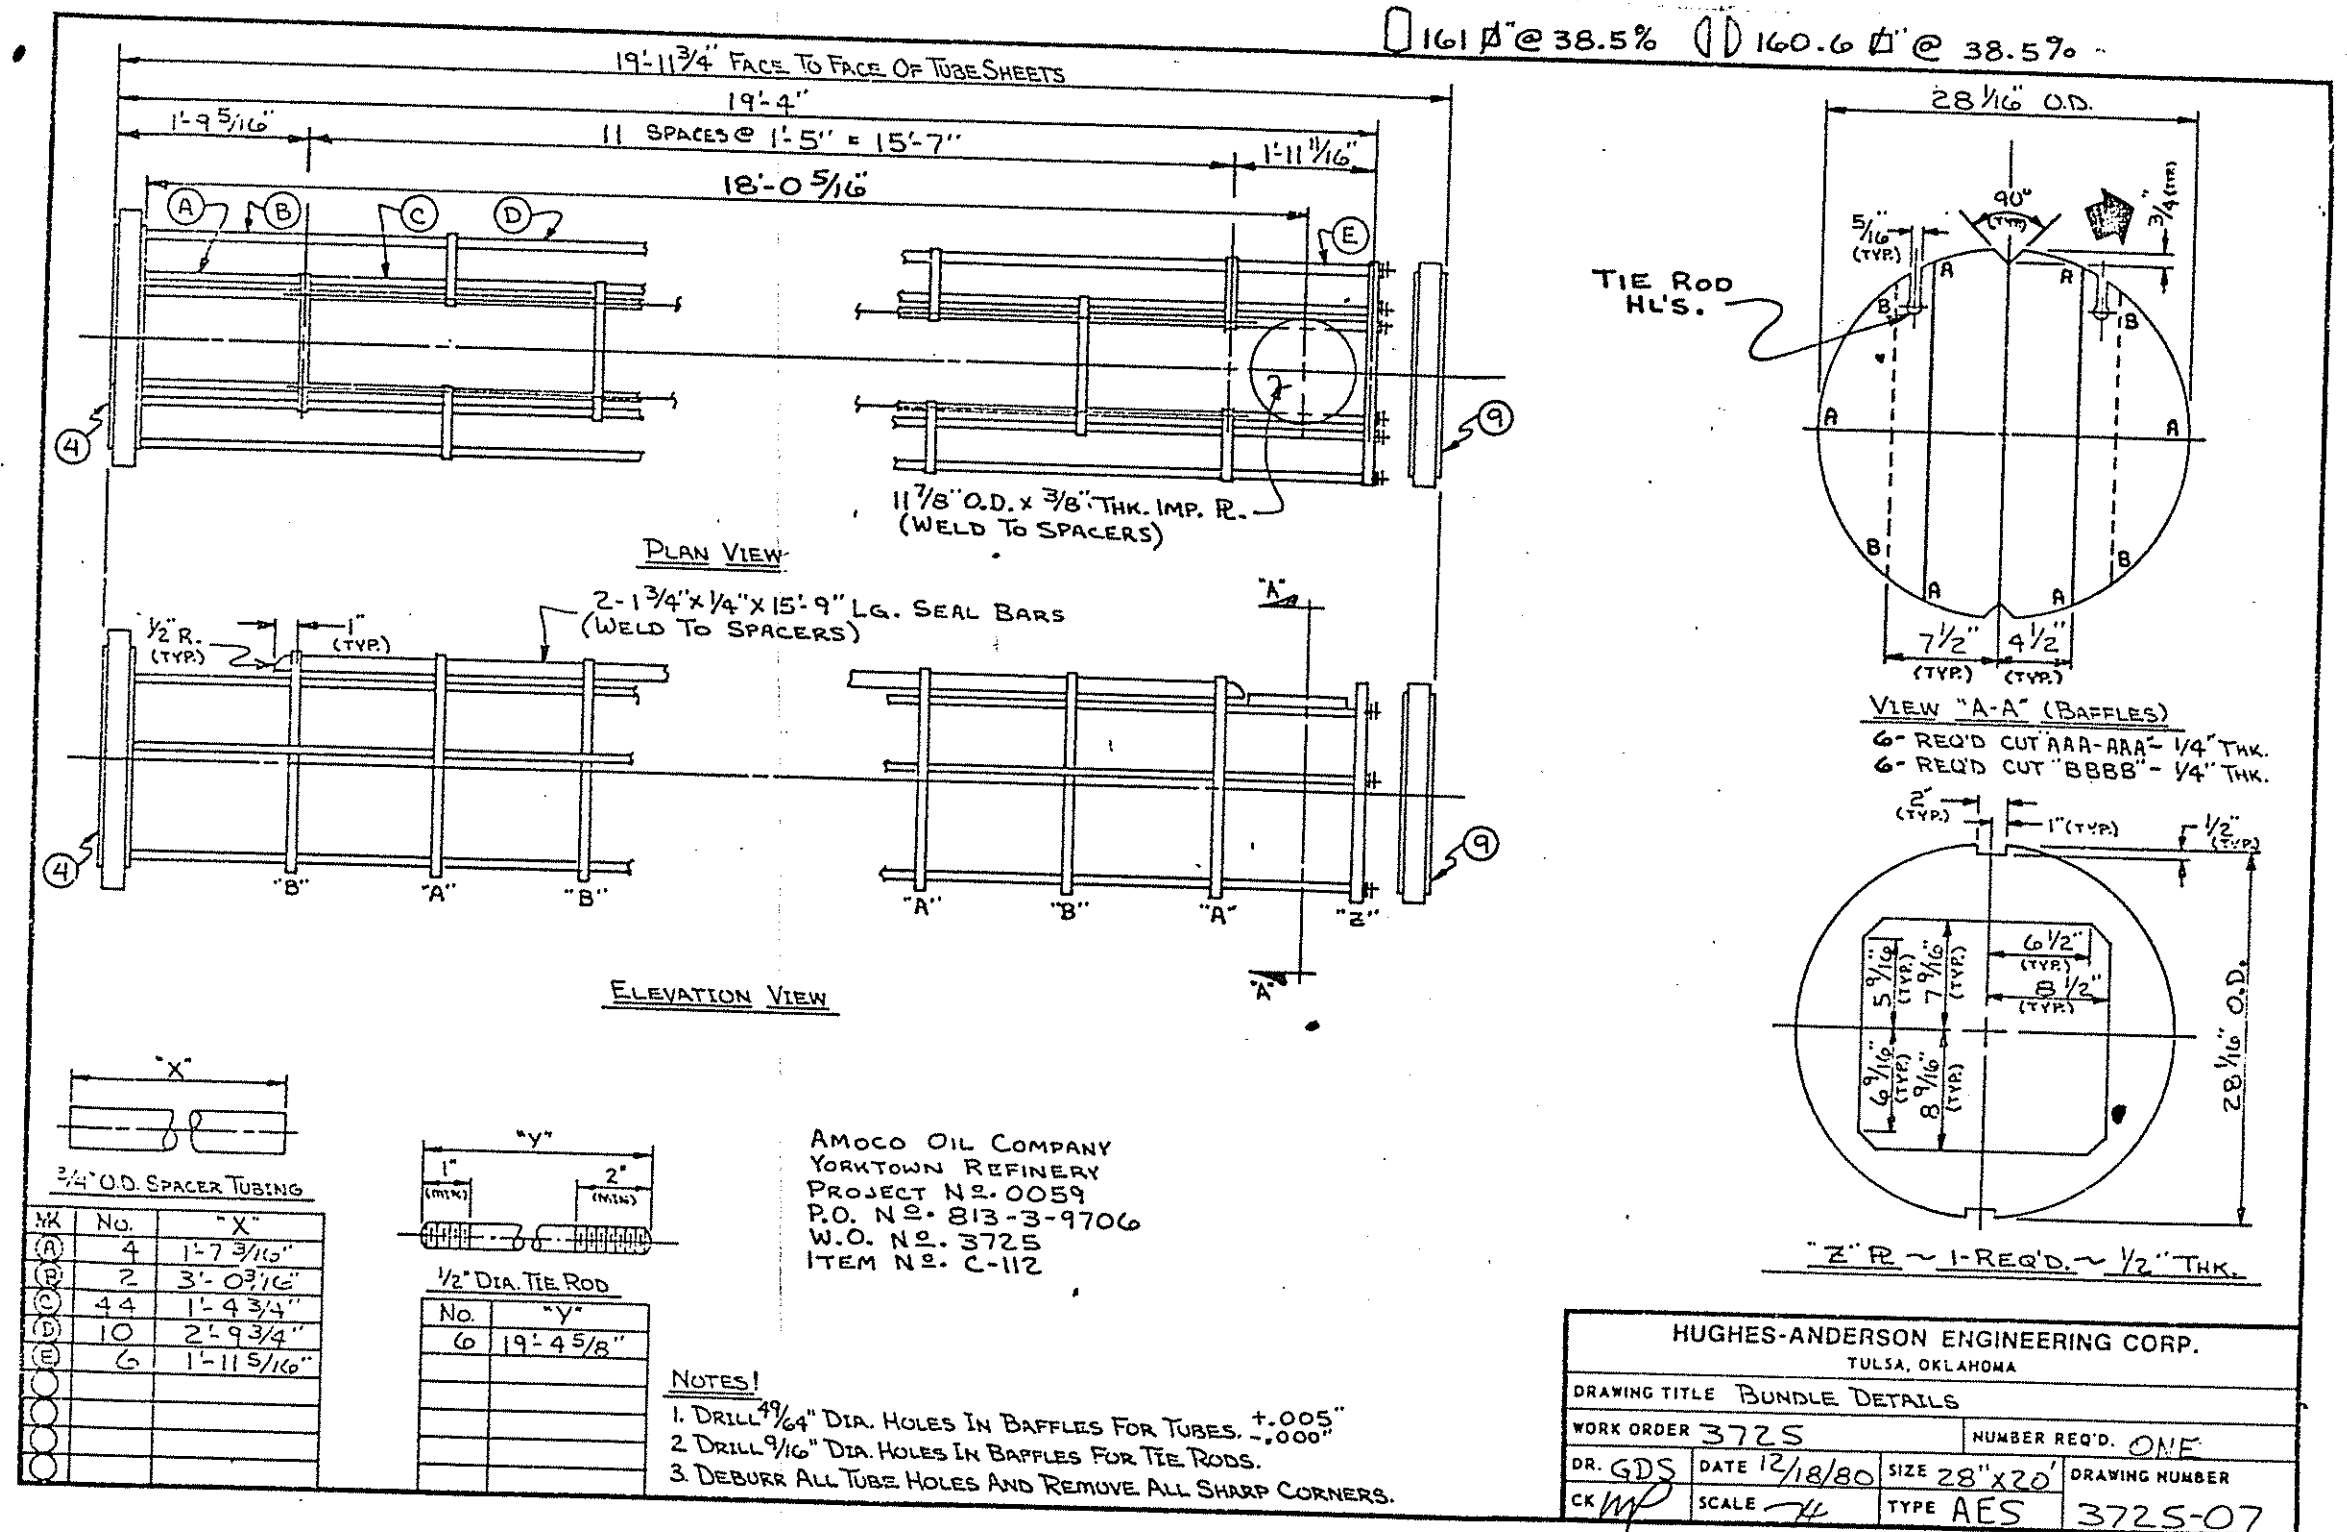

C-112


T6

13 $\frac{18}{2}$
13 $\frac{7}{10}$ $\frac{6}{10}$

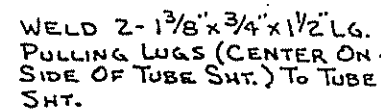

1. ALL O'LAY TO BE MONEL IN ACCORDANCE W/ WELD PROCEDURES UCL-43 (SS-42-H)
2. HEAT TREAT FOR 1 3/4 HR'S @ 1100°F.

STATIONARY: TUBE SHEET

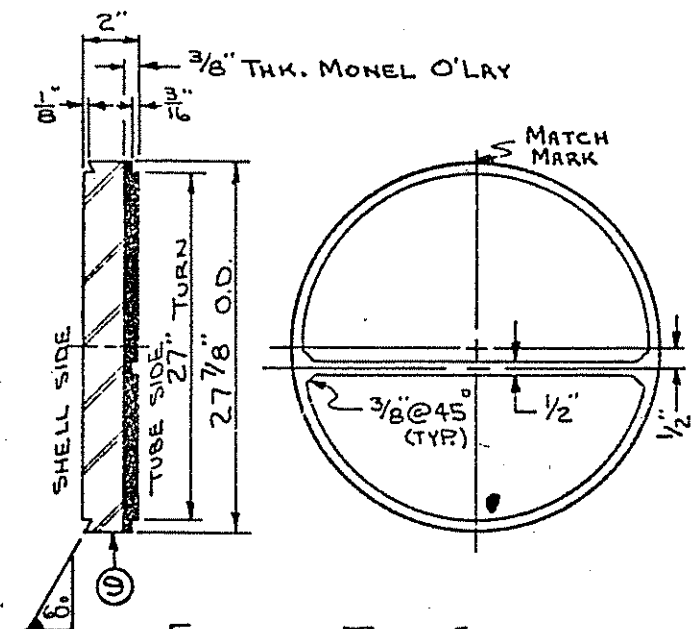

Technical drawing of a shell and tube heat exchanger detail 'A'. The drawing shows a cross-section of a tube sheet with three tubes. Dimensions include: tube outer diameter of $1\frac{1}{8}$ inches, tube pitch of $1\frac{1}{2}$ inches, tube sheet thickness of $\frac{3}{8}$ inch, and a maximum roll area of $1\frac{7}{8}$ inches. The drawing is labeled 'SHELL SIDE' and 'TUBE SIDE'. A note indicates a $\frac{1}{32} \times 45^\circ$ chamfer to remove burrs. The material is specified as MONEL O'LAY.

DRILL & REAM TUBE HOLES TO $758 \pm .002$
FOR 473 $-3/4"$ O.D. TUBES ON $1" \square$ PITCH &
 $26 \frac{11}{16}"$ T.C.. GROOVE TUBE HOLES PER DETAIL "A".

C-112

C-112

FORM U-1 MANUFACTURERS' DATA REPORT FOR PRESSURE VESSELS
As Required by the Provisions of the ASME Code Rules, Section VIII, Division 1

1. Manufactured by Hughes-Anderson Engr. Corp. Tulsa, Oklahoma
(Name and address of manufacturer)

2. Manufacturer for Standard Oil Company (Indiana) Chicago, Illinois
(Name and address of purchaser)

3. Location of installation Amoco Oil Company Yorktown, Virginia
(Name and address)

4. Type Horiz. Vessel No. 3725 (Mfr's Serial No.) (CRN) (Drawing) (Nat'l Bld No.) Year Built 1981
(Horiz., or vert. tank)

5. The chemical and physical properties of all parts meet the requirements of material specifications of the ASME BOILER AND PRESSURE VESSEL CODE. The design, construction, and workmanship conform to ASME Rules, Section VIII, Division 1 1980 and Addenda to (Year)

Summer 80 and Code Case no. _____ Special service per UG-120(d) _____
(Date)

Manufacturers' Partial Data Reports properly identified and signed by Commissioned Inspectors have been furnished for the following items of the report: _____
(Name of part, item number, mfr's name and identifying stamp)

Items 6-11 incl. to be completed for single walled vessels, jackets of jacketed vessels, or shells of heat exchangers

6. Shell: Material SA-516-70 Nominal Thickness 3/8 in. Corrosion Allowance 1/8 in. Diam. 2 ft 5 in. Length 18 ft 7 in. 7/8
(Spec. No., Grade)

7. Seams: Longitudinal Db1. Butt R.T. Spot Efficiency 85 % H.T. Temp _____ F
(Welded, Db1., Sngl., Lap, Butt) (Spot or Full)

Time Girth Db1. Butt R.T. Spot No. of Courses 2
(Welded Db1., Dngl., Lap, Butt) (Spot, Partial or Full)

8. Heads: (a) Material SA-516-70 (b) Material SA-516-70
(Spec. No., Grade) (Spec. No., Grade)

	Location (Top, Bottom, Ends)	Minimum Thickness	Corrosion Allowance	Crown Radius	Knuckle Radius	Elliptical Ratio
(a)	End	3/8"	1/8"			2:1
(b)	Cvr. Cyl.	32" OD x 7/16" x 9" Lg	R & W Cyl.			
	Conical Apex Angle	Hemispherical Radius		Flat Diameter	Side to Pressure (Convex or Concave)	
(a)					Concave	
(b)						

If removable, bolts used (describe other fastenings) SA-193-B7 3/4" Ø, 28
(Material, Spec. No., Gr., Size, No.)

9. Type of Jacket _____ Proof Test _____ If bolted, describe or sketch.

10. Jacket Closure _____ If bar, give dimensions _____

11. Constructed for max. allowable working pressure 150 psi at max. temp. 350 F Min. temp. (when less than -20 F) _____ F.
Hydrostatic, pneumatic, or combination test pressure 225 psi

Items 12 and 13 to be completed for tube sections.

12. Tubesheets: Stationary—Material SA-516-70* Diam. 30-3/8 in. Nominal Thickness 2 in. Corrosion
(Spec. No., Gr.) (Subject to pressure)

Allowance 1/2 in. Attachment Bolted Floating—Material SA-516-70* Diam. 27-1/2 in.
(Welded, Bolted) (Spec. No., Grade)

Nominal Thickness 2 in. Corrosion Allowance 1/2 in. Attachment Bolted

13. Tubes: Material SB-338-Gr. 2 O.D. 3/4 in. Nominal Thickness 18 or gauge Number 473 Type Straight
(Spec. No., Gr.) (Straight or "U")

Items 14-17 incl. to be completed for inner chambers of jacketed vessels or channels of heat exchangers

14. Shell: Material SA-240-316L Nominal Thickness 3/8 in. Corrosion Allowance 1/16 in. Diam. 2 ft 5 in. Length 2 ft 2 in.
(Spec. No., Gr.)

15. Seams: Longitudinal Db1. Butt R.T. Spot Efficiency 85 % H.T. Temp _____ F Time _____
(Welded, Db1., Sngl., Lap, Butt) (Spot or Full)

Girth Db1. Butt R.T. Spot No. of courses 1
(Welded, Db1., Sngl., Lap, Butt) (Spot, Partial, or Full)

16. Heads: (a) Material SA-516-70** (b) Material SA-516-70**
(Spec. No., Grade) (Spec. No., Gr.)

	Location (Top, Bottom, Ends)	Minimum Thickness	Corrosion Allowance	Crown Radius	Knuckle Radius	Elliptical Ratio
(a)	End	2-5/8"	3/8"			
(b)	SA-516-70	2-1/8"	3/8"			
	Conical Apex Angle	Hemispherical Radius		Flat Diameter	Side to Pressure (Convex or Concave)	
(a)				30-3/8"	Flat	
(b)				27-1/2"	Hogged Out	

If removable, bolts used (describe other fastenings) SA-193-B7 3/4" Ø, 32 SA-193-B7 - 5/8" Ø, 32
(Material, Spec. No., Gr., Size, No.) 3725

Constructed for max. allowable working pressure 115 psi at max temp. 150 F. Min. temp. (when less than -20 F) F.
Hydrostatic test pressure 115 psi.

Items below to be completed for all vessels where applicable

Safety Valve Outlets: Number 1 Size 2"-150# - RF Location Shell side

Nozzles:

Purpose (Inlet, Outlet, Drain)	Number	Diam. or Size	Type	Material	Nominal Thickness	Reinforcement Material	How Attached
Chan. in-out	1-1	8"-150#	RF-SO	SA403WP316L	Sch. 80S	none	Welded
Shell in	1	10"-150#	RF-WN	SA-234WPB	X-Stg	none	Welded
Shell out	1	6"-150#	RF-WN	SA-234WPB	Sch. 80	none	Welded

Inspection Openings:

Manholes No. Size Location
Handholes No. Size Location
Threaded No. Size Location

Supports: Skirt (Yes or no) Lugs (No.) Legs (No.) Other 2 Saddles Attached Welded to shell
(Describe) (Where and how)

Remarks: E-110 PFT OVHD CONDENSER *- INCLUDES 3/8" thk. monel o'lay **-includes 3/8" thk
Stn. Stl o'lay

CERTIFICATE OF COMPLIANCE

We certify that the statements made in this report are correct and that all details of design, material, construction, and workmanship of this vessel conform to the ASME Code for Pressure Vessels, Section VIII, Division 1.

Date 3-18-81 Signed Hughes-Anderson Engr. Corp. by Gary Roe
(Manufacturer) (Representative)

"U" Certificate of Authorization No. 11979 expires December 31, 19 82

CERTIFICATE OF SHOP INSPECTION

Vessel made by Hughes-Anderson Engr. Corp. at Tulsa, Oklahoma

I, the undersigned, holding a valid commission issued by the National Board of Boiler and Pressure Vessel Inspectors and/or the State or Province of Illinois and employed by Comm. Union Ins. Co.
of Boston, Mass. have inspected the pressure vessel described in this Manufacturers' Data Report on 3-18-1981
and state that, to the best of my knowledge and belief, the Manufacturer has constructed this pressure vessel in accordance with ASME Code, Section VIII, Division 1.

By signing this certificate neither the inspector nor his employer makes any warranty, expressed or implied, concerning the pressure vessel described in the Manufacturers' Data Report. Furthermore, neither the Inspector nor his employer shall be liable in any manner for any personal injury or property damage or a loss of any kind arising from or connected with this inspection.

Date 3-19-81
Signed B. L. Crocker Commissions N.B. #5745
(Inspector) (Nat'l Board, State, Province and No.)

CERTIFICATE OF COMPLIANCE FOR FIELD WORK

We certify that the statements made in this report are correct and that all details of design, material, construction, and workmanship of this vessel conform to the ASME Code for Pressure Vessels, Section VIII, Division 1.

Date Signed by
(Manufacturer) (Representative)

"U" Certificate of Authorization No. expires , 19

CERTIFICATE OF FIELD ASSEMBLY INSPECTION

I, the undersigned, holding a valid commission issued by the National Board of Boiler and Pressure Vessel Inspectors and/or the State or Province of and employed by
of have compared the statements in this Manufacturers' Data Report with the described pressure vessel and state that parts referred to as data items , not included in the certificate of shop inspection, have been inspected by me and that, to the best of my knowledge and belief, the Manufacturer has constructed and assembled this pressure vessel in accordance with ASME Code, Section VIII, Division 1.

The described vessel was inspected and subjected to a hydrostatic test of psi.

By signing this certificate neither the Inspector nor his employer makes any warranty, expressed or implied, concerning the pressure vessel described in this Manufacturers' Data Report. Furthermore, neither the Inspector nor his employer shall be liable in any manner for any personal injury or property damage or a loss of any kind arising from or connected with this inspection.

Date
Signed Commissions
(Authorized Inspector) (Nat'l Board, State, Province and No.)

E-110 PFT OVHD. CONDENSER

U

W
RT-3

CU

1190

C-112

813-3-9706

3725

28" X 20"

PISTON

AES

1829

1829

SPOT CHAN. SHELL & SHELL COV

3-1001

225

115

150

350

225

75

150

115

473-374" O.D. X 18 B I G AVG. X 20" O.D. LG. SB-338-GR2