

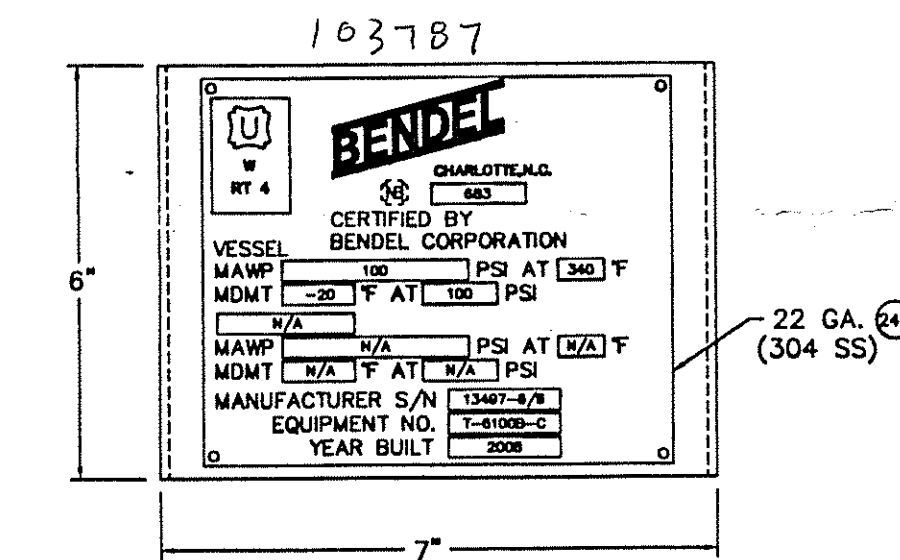
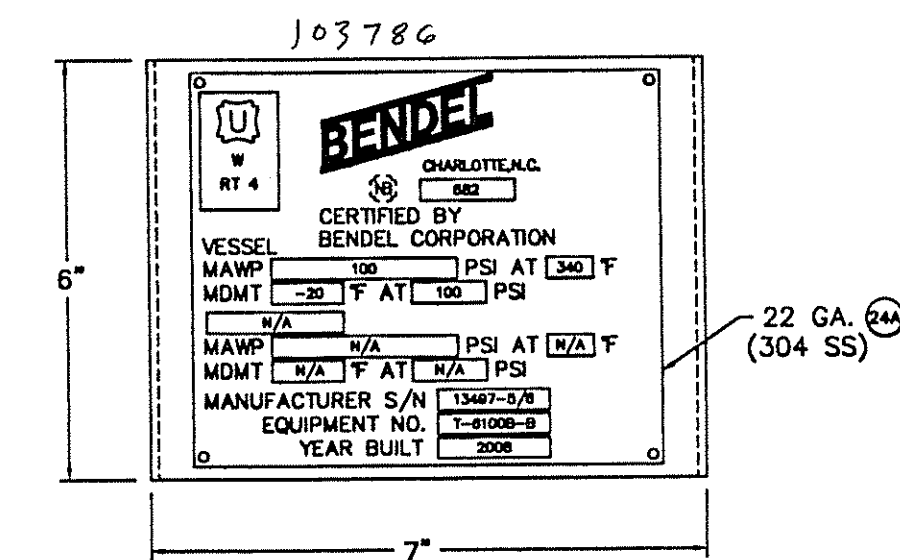
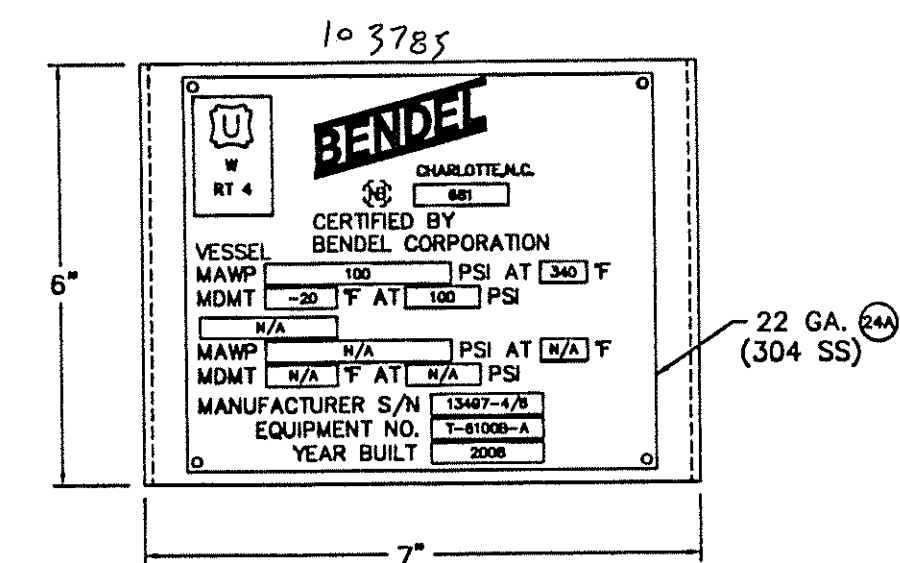
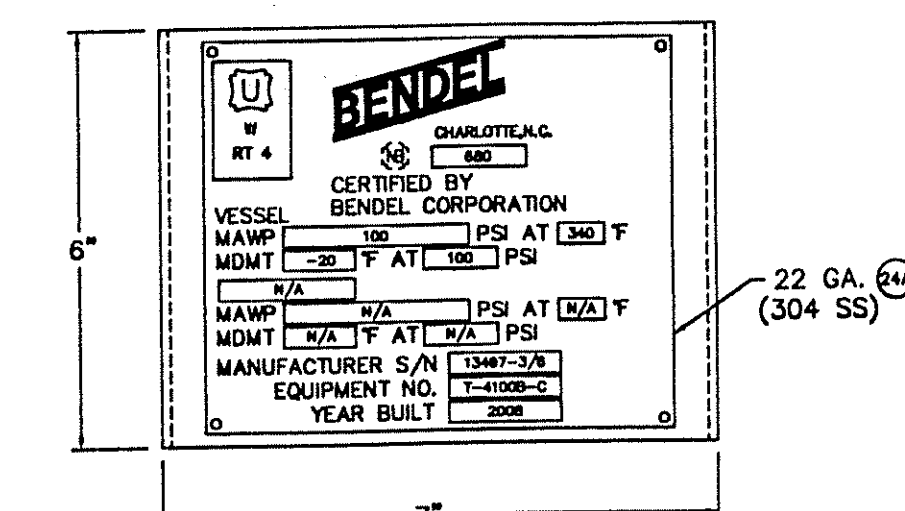
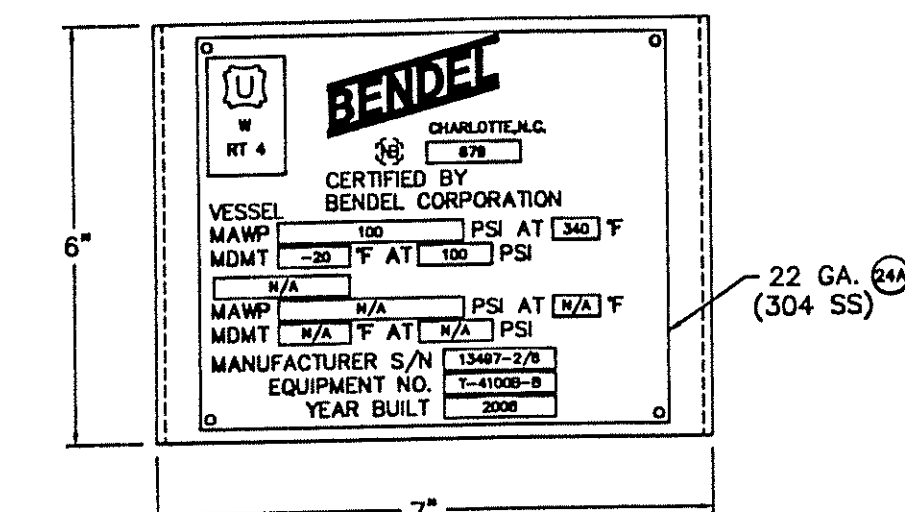
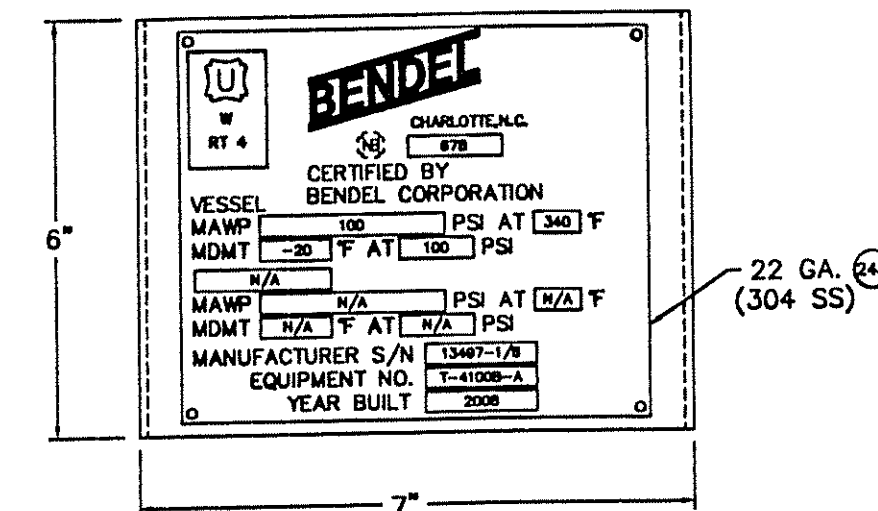
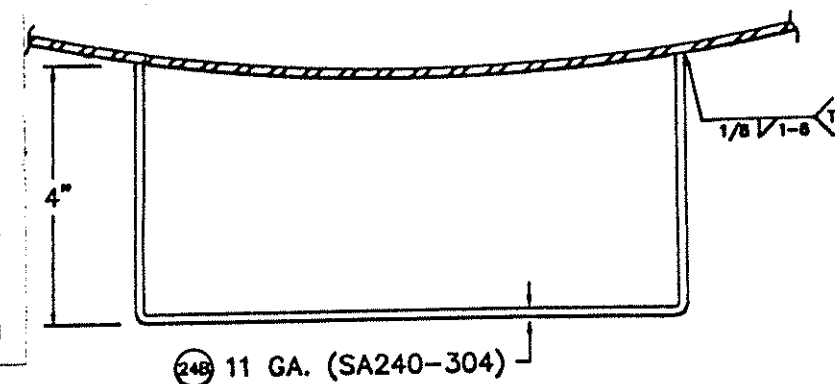


Vendor Print File: 39255WN	Date: 03/09/09
Sheet(s): 6 of 6	Equipment Number: T-41008A/B/C
Project Number: 147-7685	Account Number: 2025
Purchase Order No.: 4800280826	
Plant: 0147	
Reviewed	
Drafting Design: JB	
Approved	
Project Engineer: L. E. Lee	
Approved	
Reliability Engineer:	

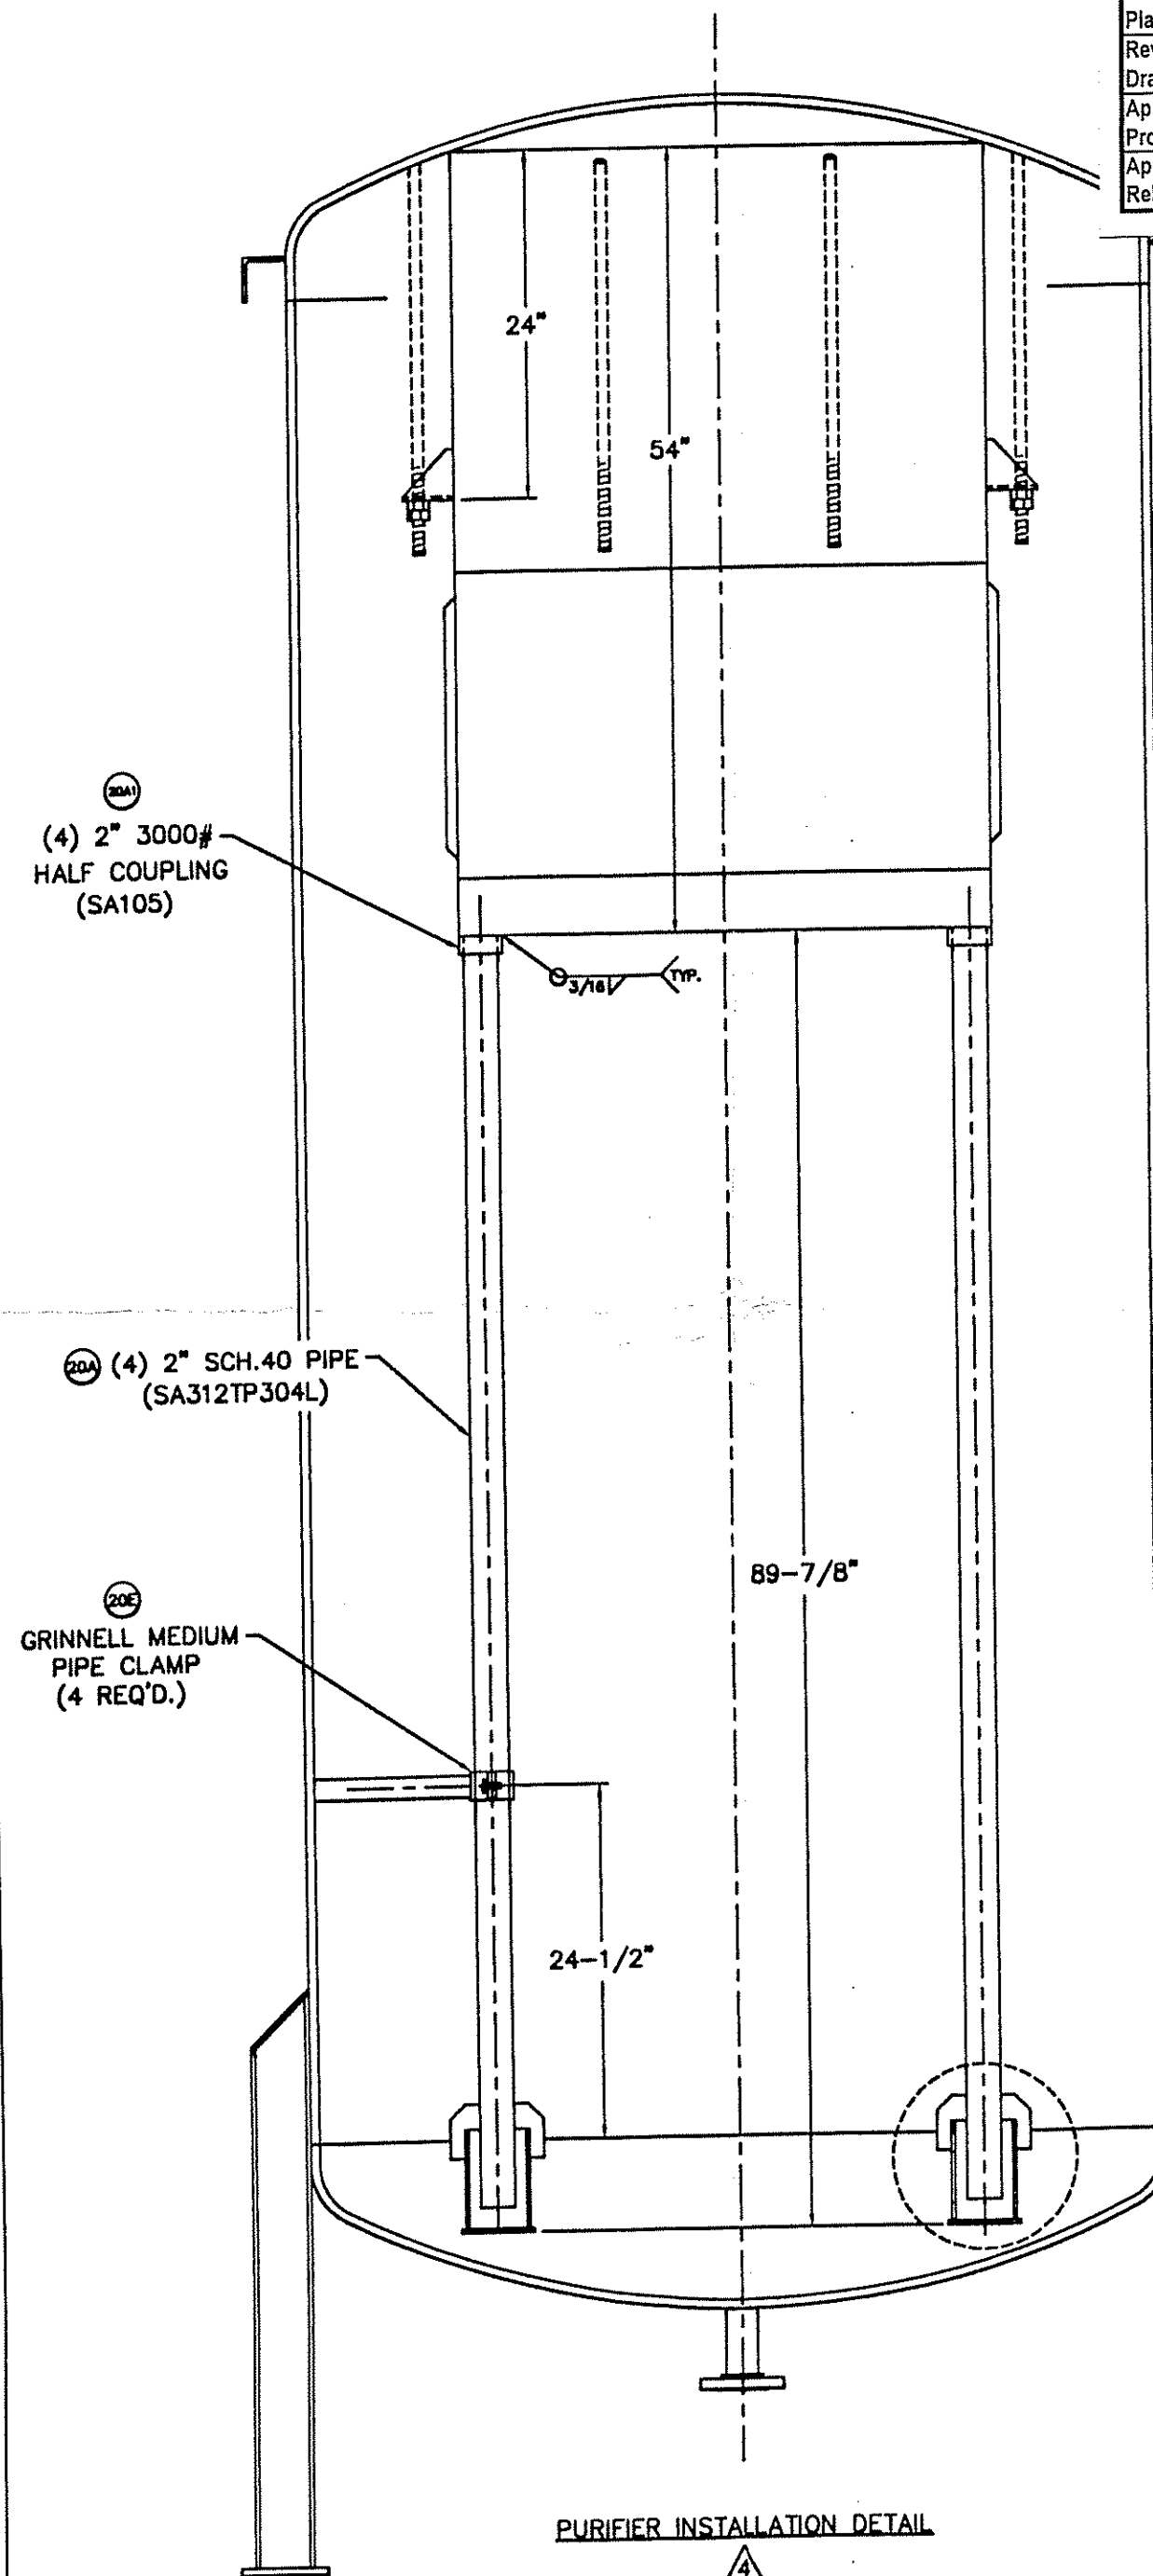

ASME NAMEPLATE & BRACKET DETAIL (M)

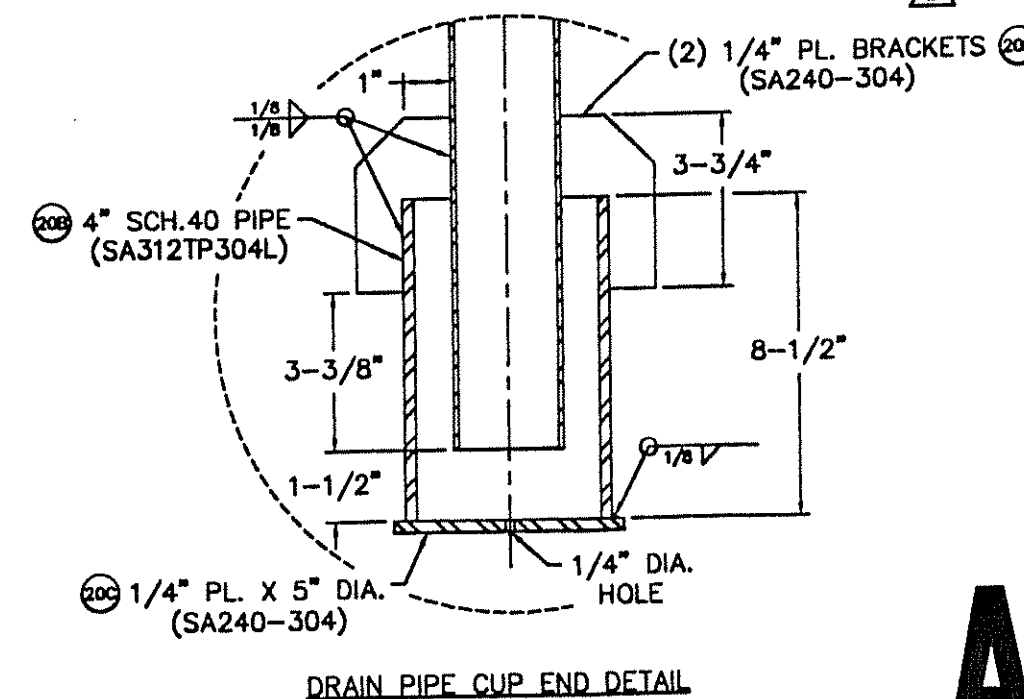

DATE	REVISION	BY
6-10-08	FOR CUSTOMER APPROVAL	C.M.
7-1-08	REVISED PER CUSTOMER COMMENTS, FOR CUSTOMER APPROVAL	M.S.
7-17-08	REVISED PER CUSTOMER COMMENTS, FOR CUSTOMER APPROVAL	C.M.
9-3-08	REVISED PER CUSTOMER COMMENTS, FOR CUSTOMER APPROVAL	C.M.
9-22-08	REVISED PER CUSTOMER COMMENTS, RELEASED FOR FABRICATION	C.M.
1-8-09	AS BUILT	J.C.
SUBJECT		
DETAILS		
CUSTOMER		
INVISTA WILMINGTON, NC		
SCALE: NONE		
S.O. NO. 13497		
JOB NO. 3605		
DWG. NO. 061349708		
SH. NO. 6 OF 6		

BENZEL
CHARLOTTE, N.C.

ASME