




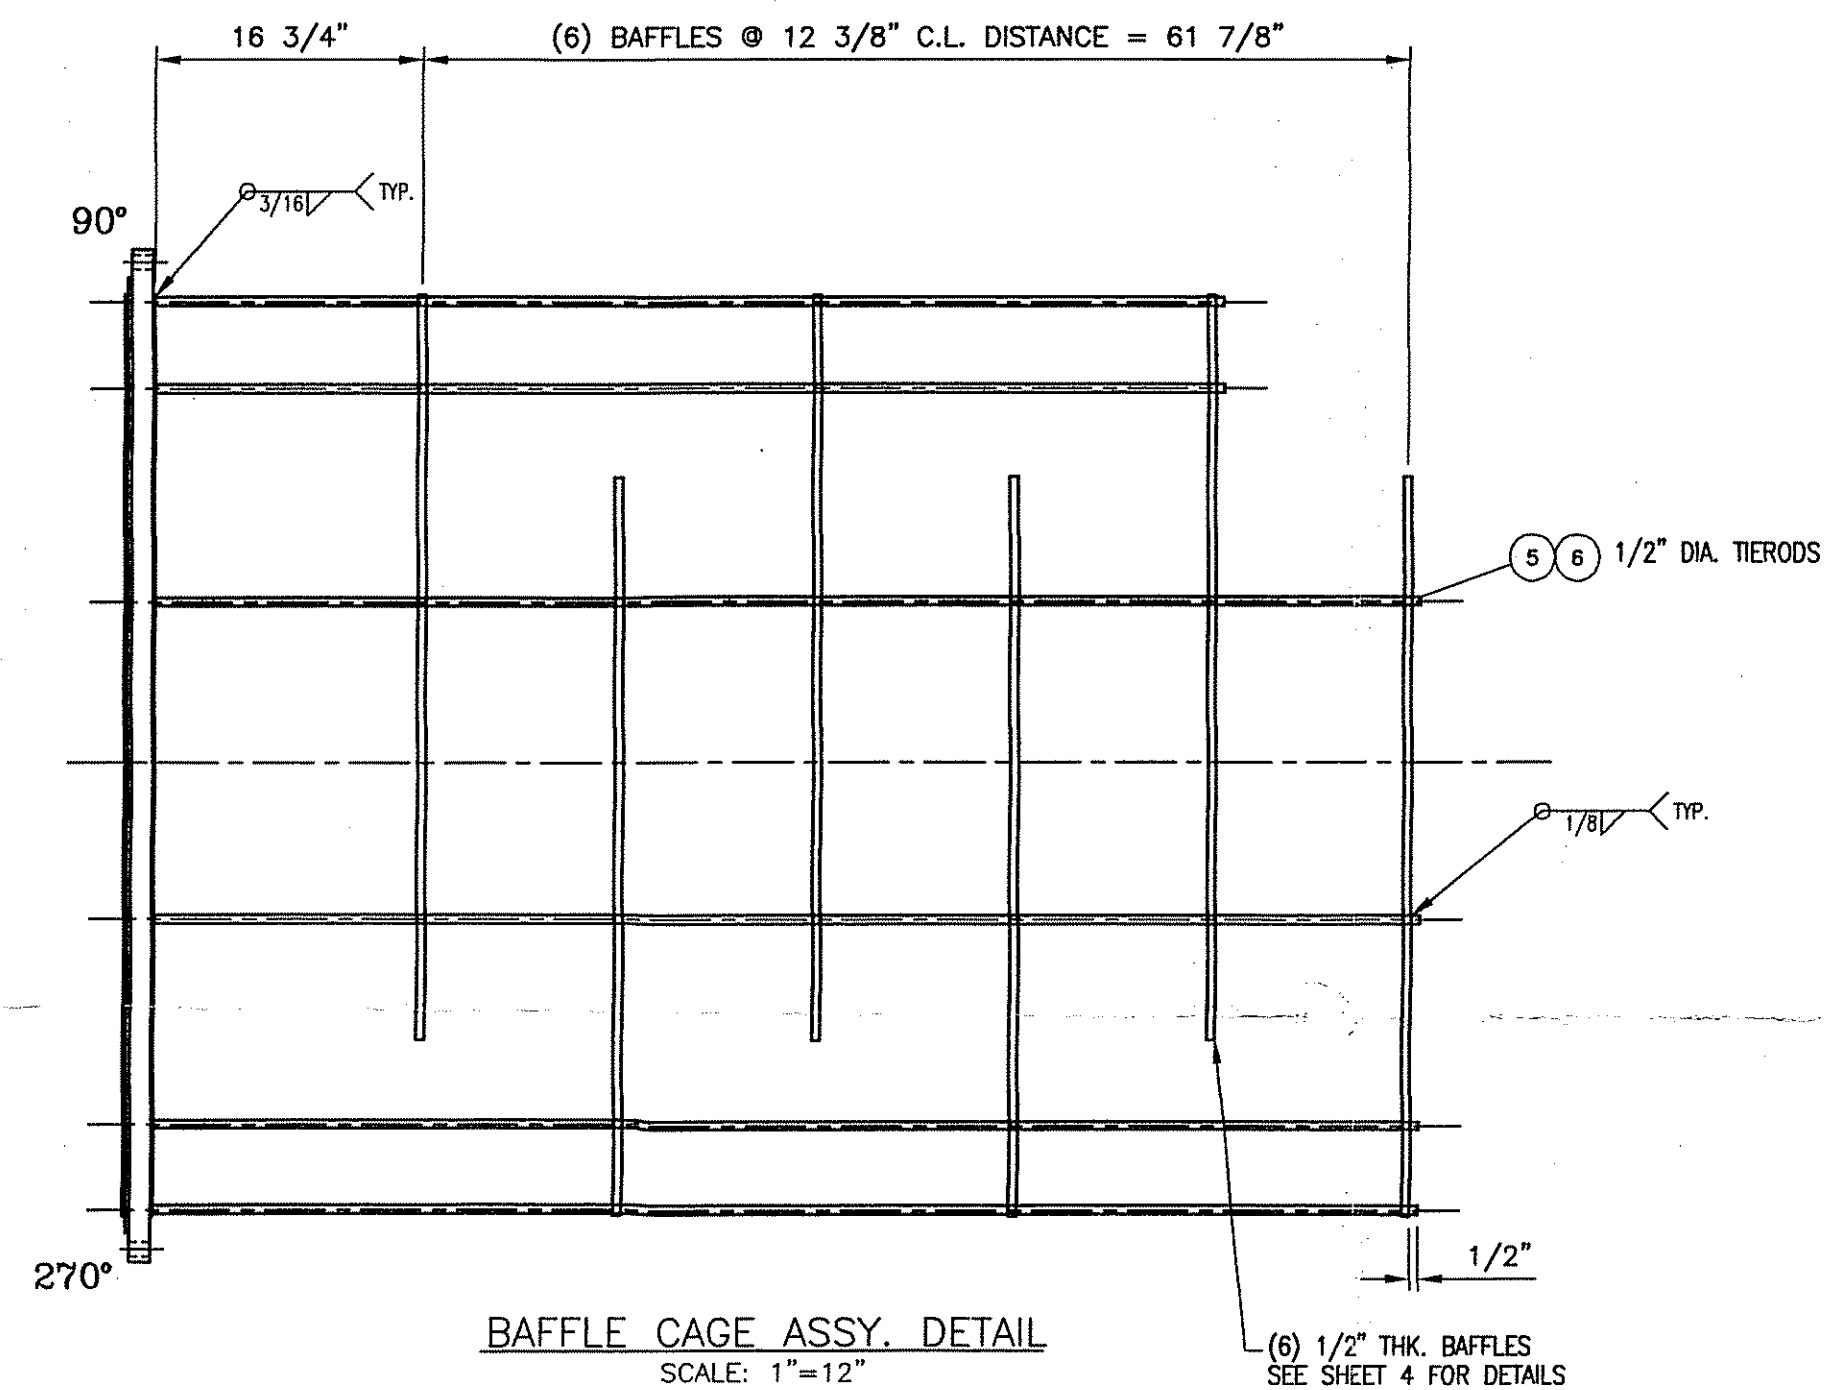


BAFFLE CAGE ASSY. DETAIL
SCALE: 1"=12"

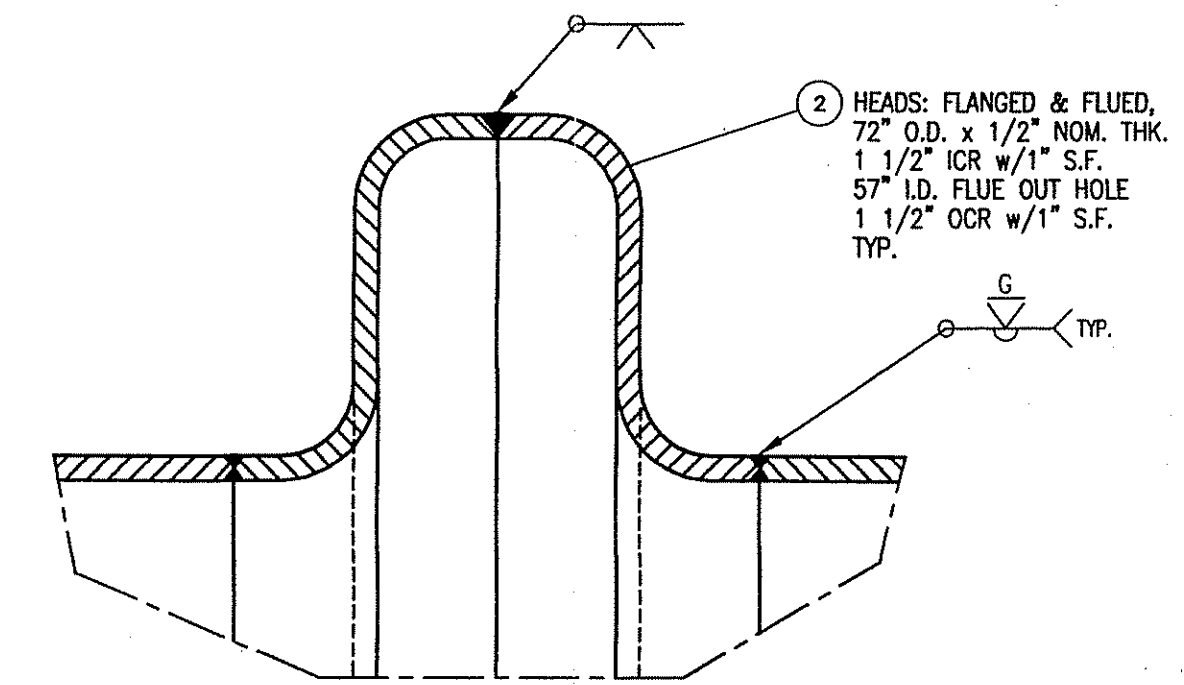


EXPANSION JOINT DETAIL
SCALE: 3"=12"

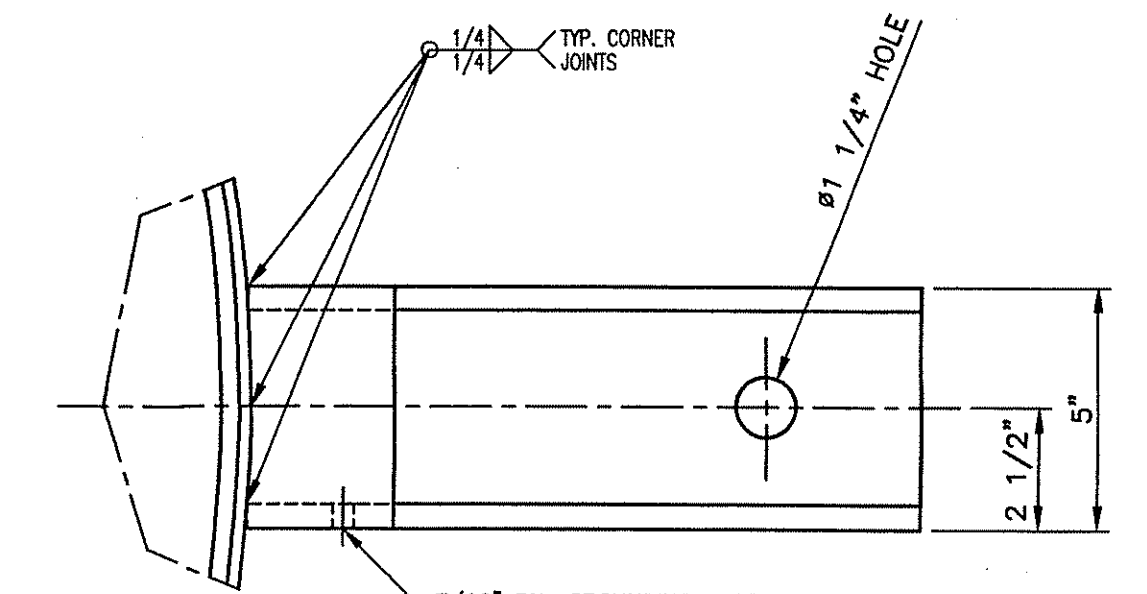


SUPPORT DETAIL
TYP. (4) PLACES
SCALE: 3"=12"

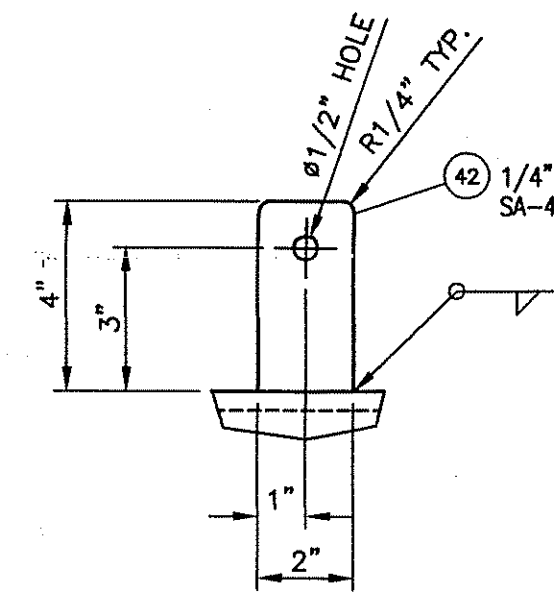

GROUNDING LUG DETAIL
SCALE: 3"=12"

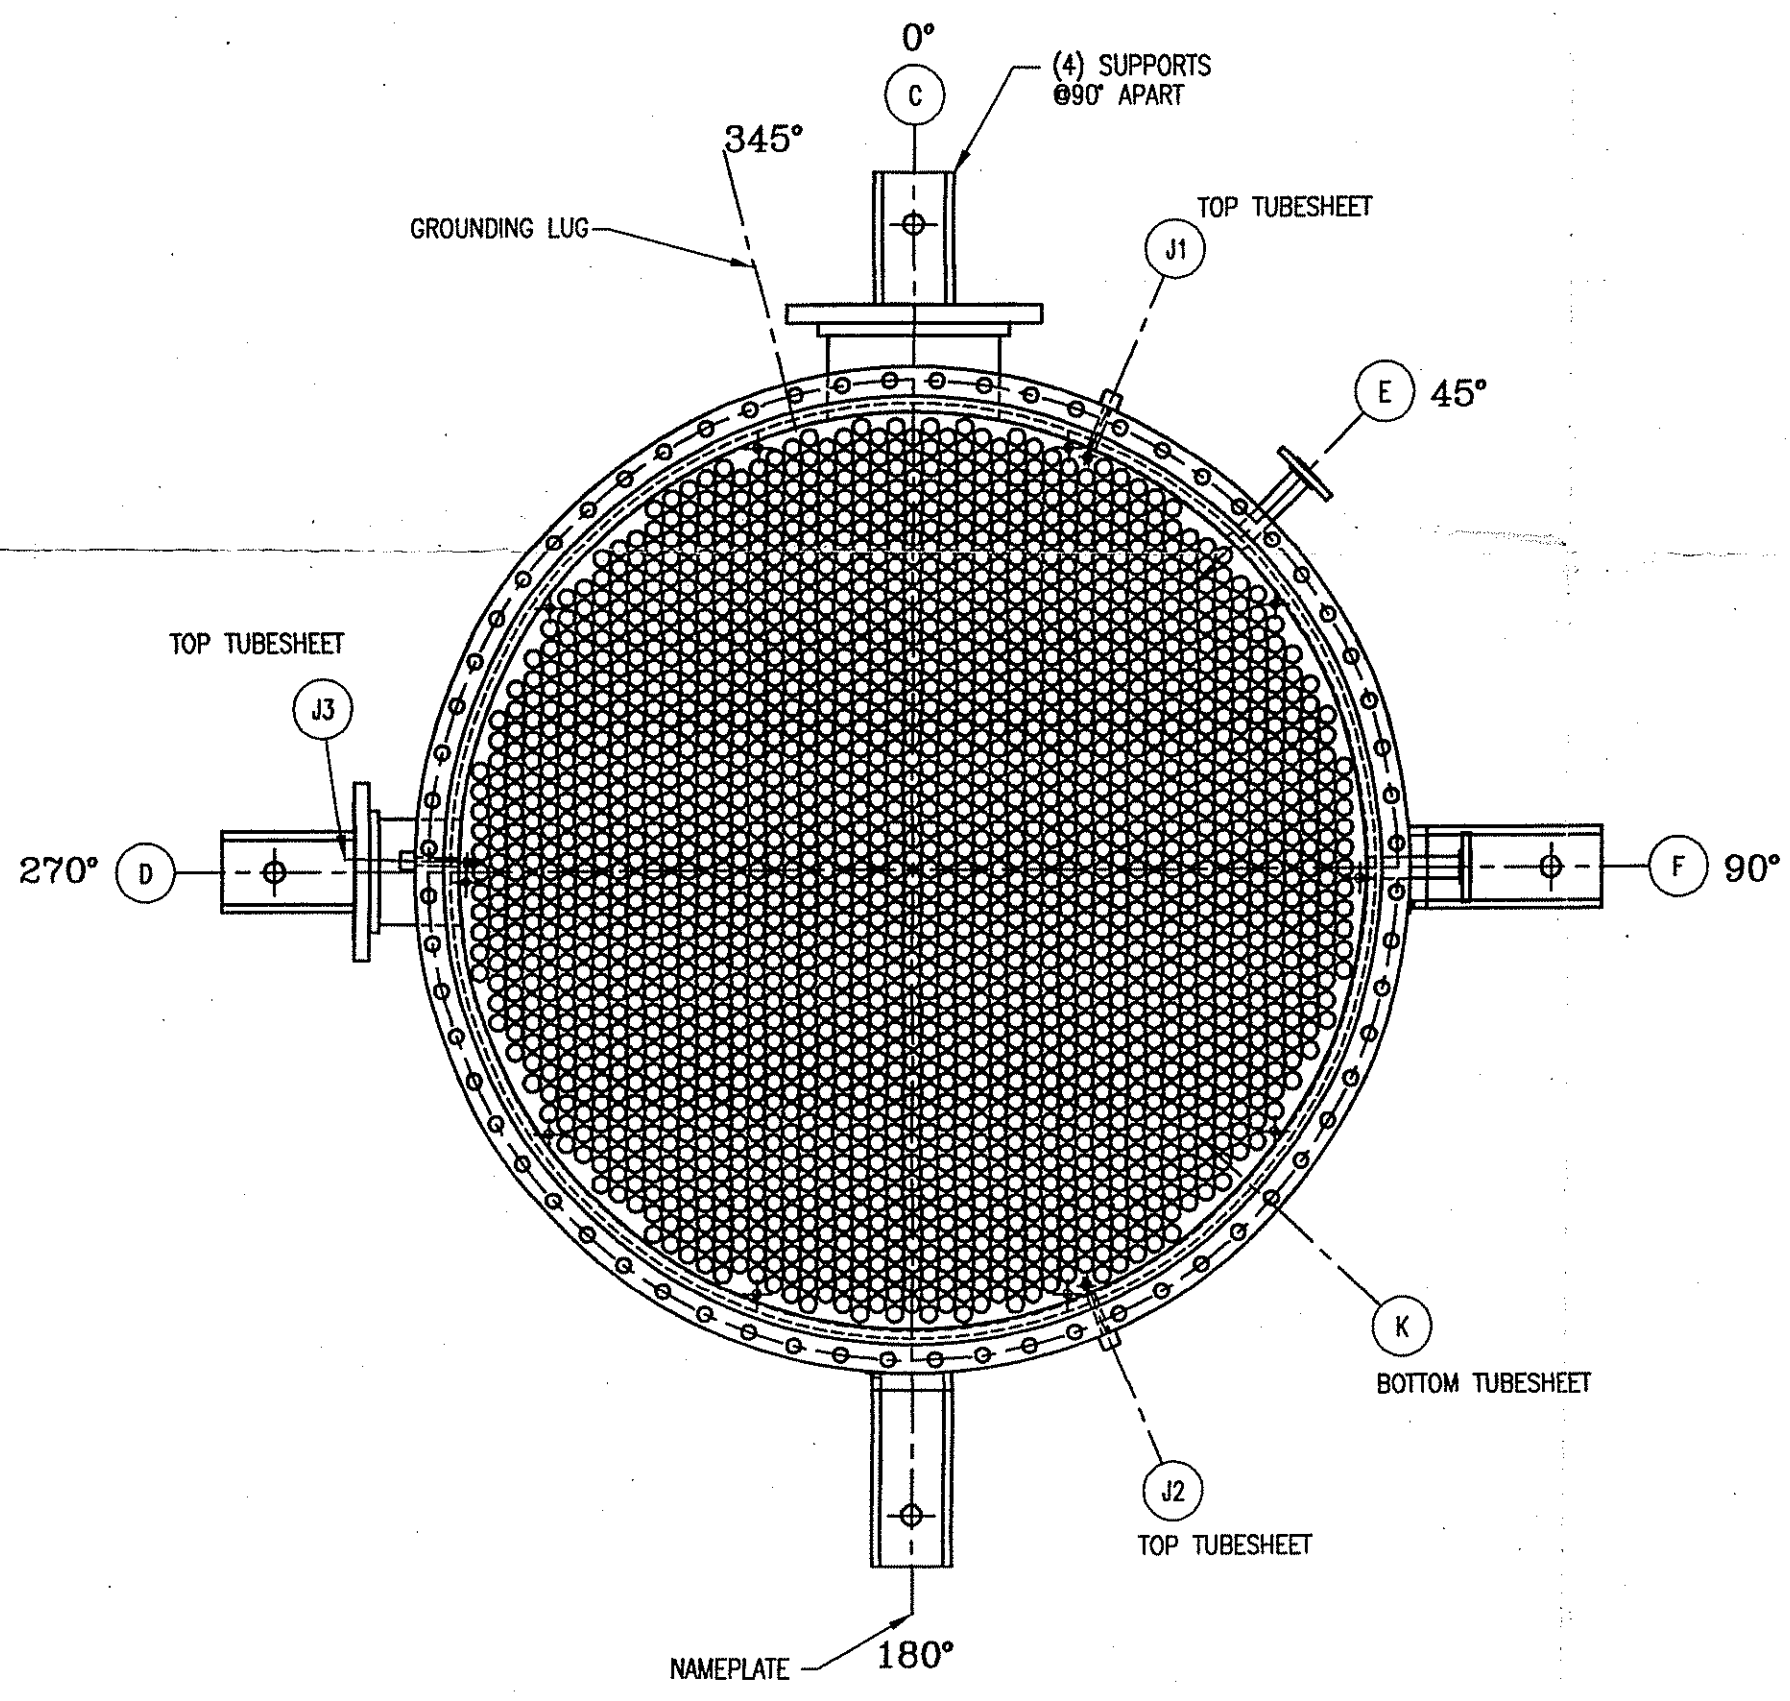

SHELL SECTION PLAN VIEW
TRUE ORIENTATION
SCALE: 1"=12"

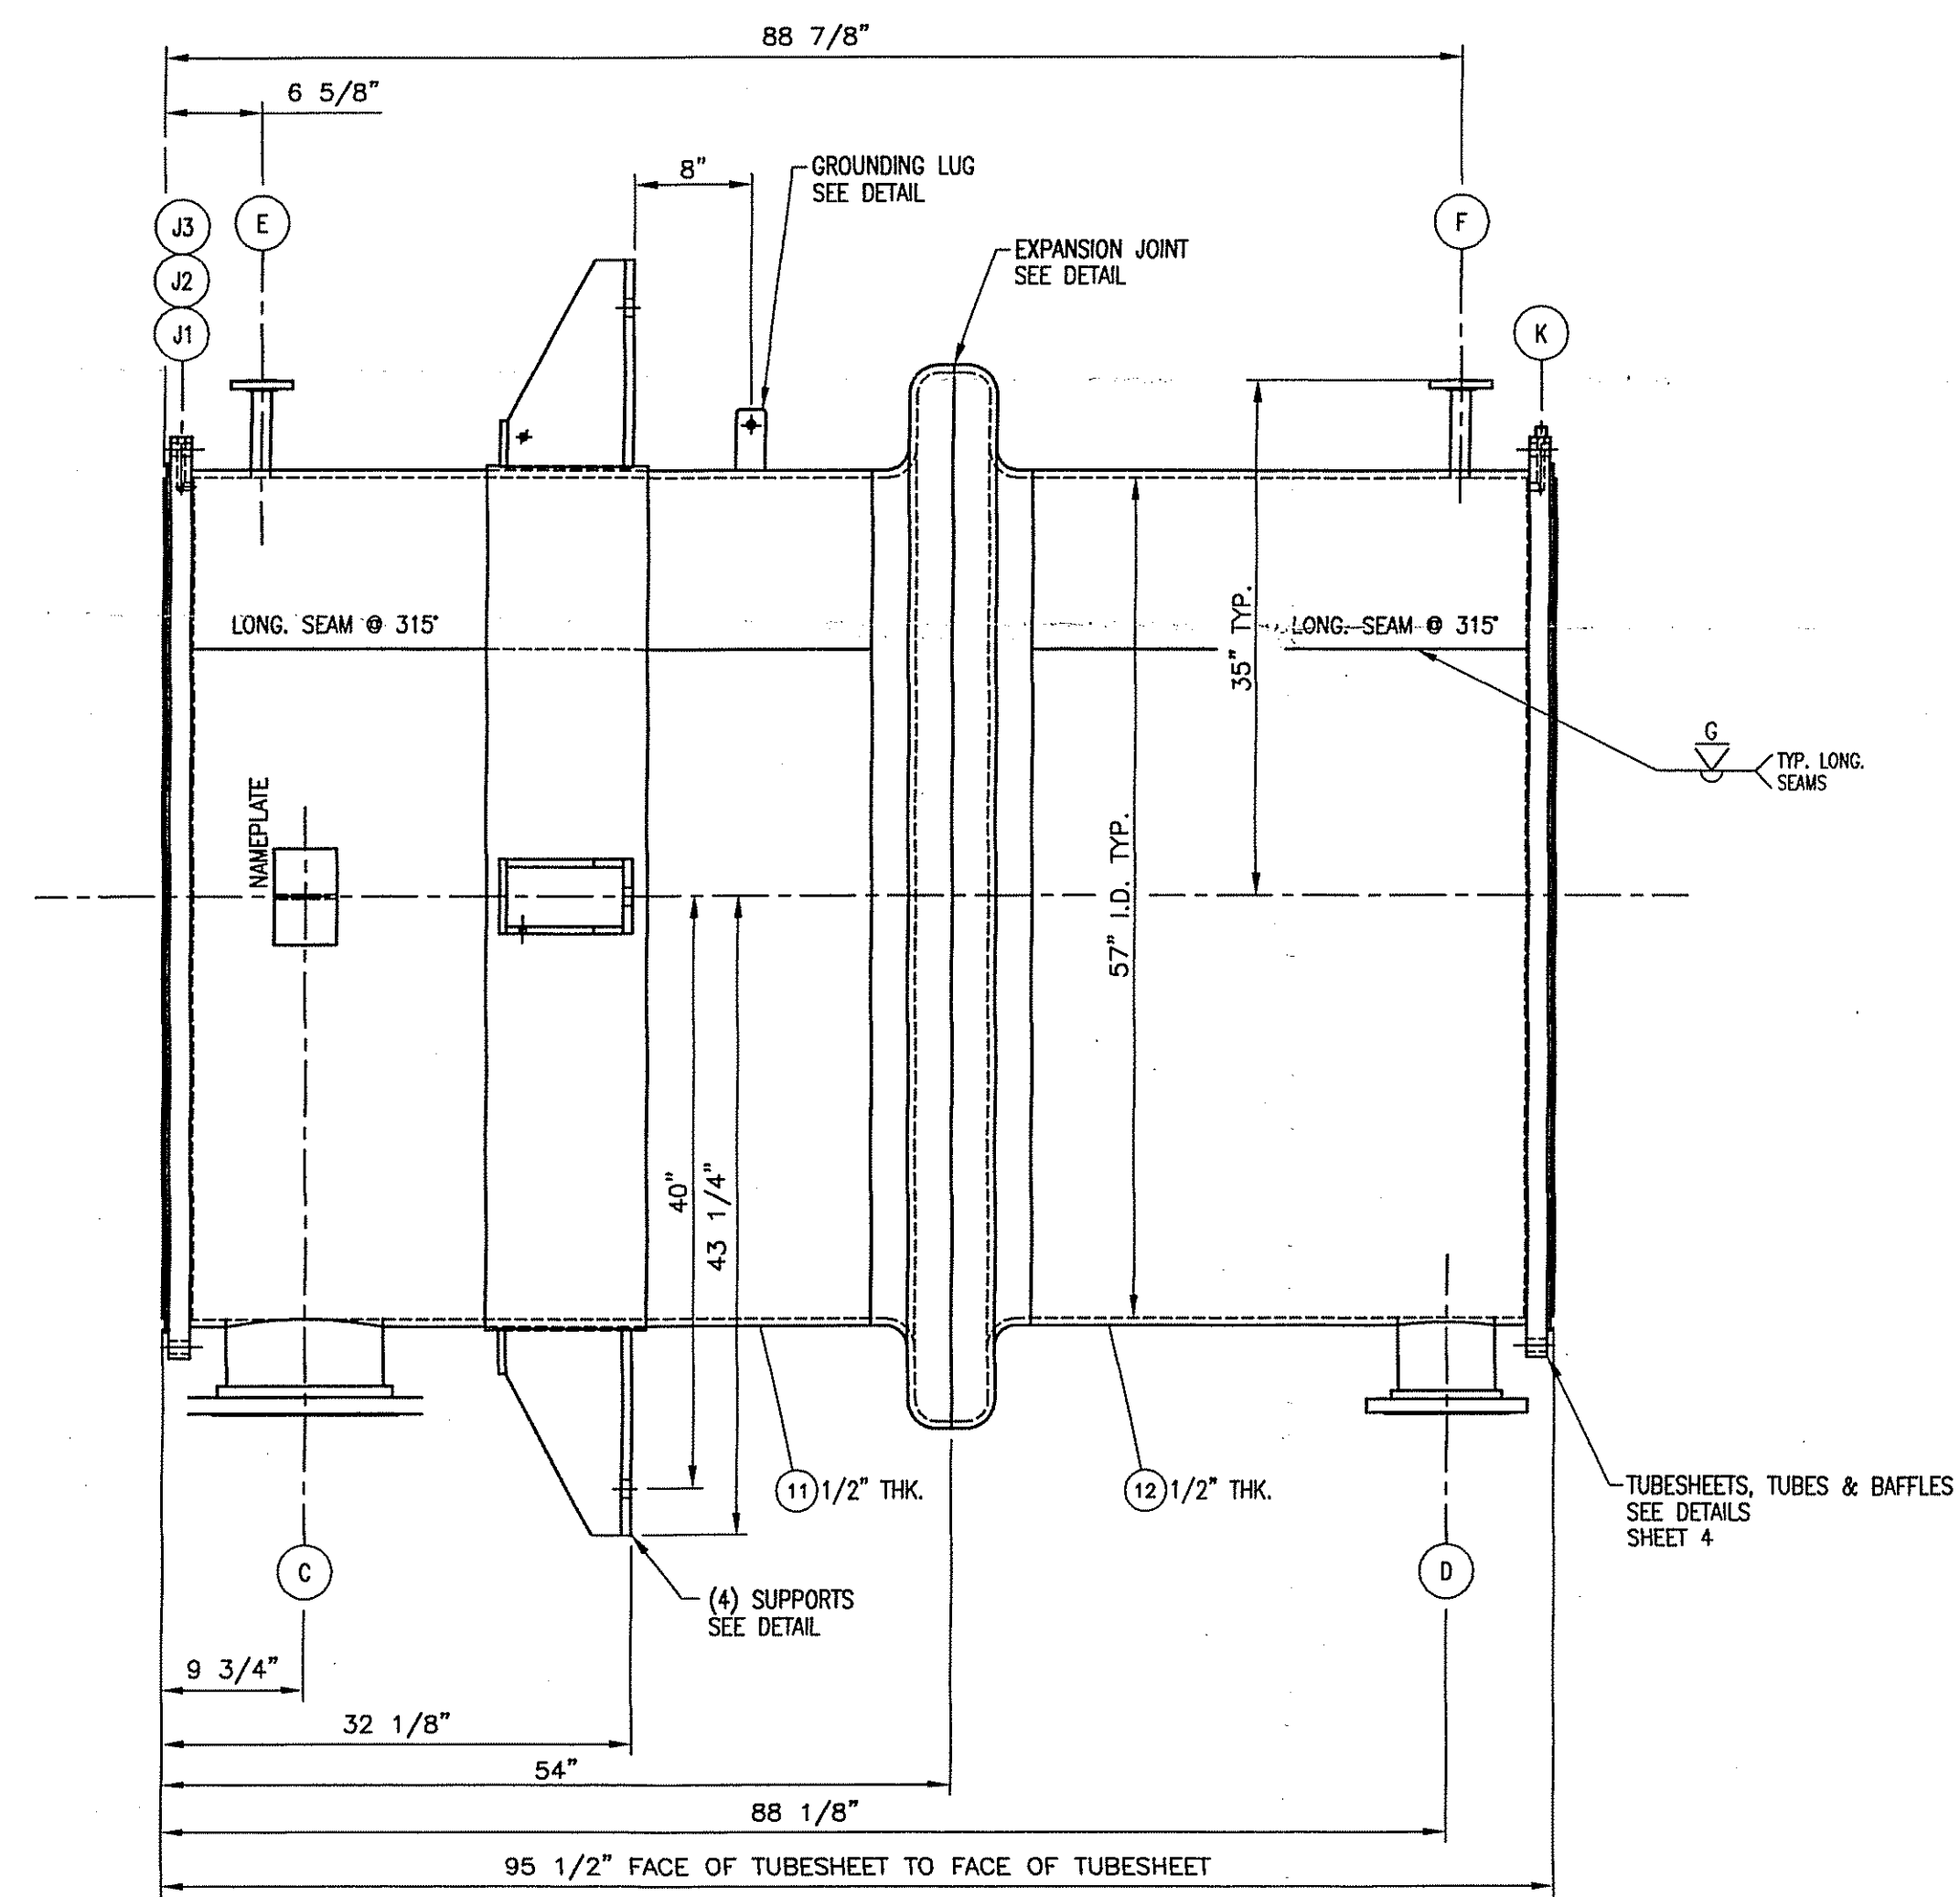

SHELL SECTION ELEVATION VIEW
SEE PLAN VIEW FOR TRUE ORIENTATION
SCALE: 1"=12"

AS-BUILT PRINT
WARD TANK AND
HEAT EXCHANGER CORP.
By: J.J. Whalen
Date: 9/25/2003

Vendor	Print File: 39151122	Date: 4/3/03
Equipment	Number: E-4220-7R	Account: 4025
Project	Number: 147-2512	Order No.: 4800105039
Purchase	Plant: 0147	Reviewed
Order No.	Drafting Design:	Approved
Plant	Project Engineer:	Approved
Reviewed	Reliability Engineer:	

WARD TANK AND
HEAT EXCHANGER CORP.
6670 E. HARRIS BLVD.
CHARLOTTE, NC 28215

2	3/25/2003	AS-BUILT	DMB	CUSTOMER	KOSA - WILMINGTON PLANT WILMINGTON, NC	PURCHASE ORDER NUMBER	4800105039
1	11/7/2002	REVISED PER CUSTOMERS COMMENTS/RELEASED FOR FABRICATION	DMB	TITLE	#57-96 BEM HEAT EXCHANGER		
0	9/30/2002	FOR CUSTOMER APPROVAL	DMB	EQUIPMENT NO.	E-4220-7R	SCALE	AS NOTED
REV NO.	DATE	DESCRIPTION	BY	APPROVED BY	DATE	DRAWING NUMBER	REV. NO.
2	3/25/2003	AS-BUILT	DMB	7W	3/25/03	2002-HC-4981	2
0	9/30/2002	FOR CUSTOMER APPROVAL	DMB	BRADSHAW	9/20/2002		4

THIS DRAWING IS THE PROPERTY OF WARD TANK AND HEAT EXCHANGER CORP AND IS ONLY TO BE USED IN REFERENCE TO WORK PROPOSED OR CONTRACTED BY THIS COMPANY. IT MUST NOT BE REPRODUCED OR SUBMITTED TO OUTSIDE PARTIES WITHOUT THE WRITTEN PERMISSION OF WARD TANK AND HEAT EXCHANGER CORP.