




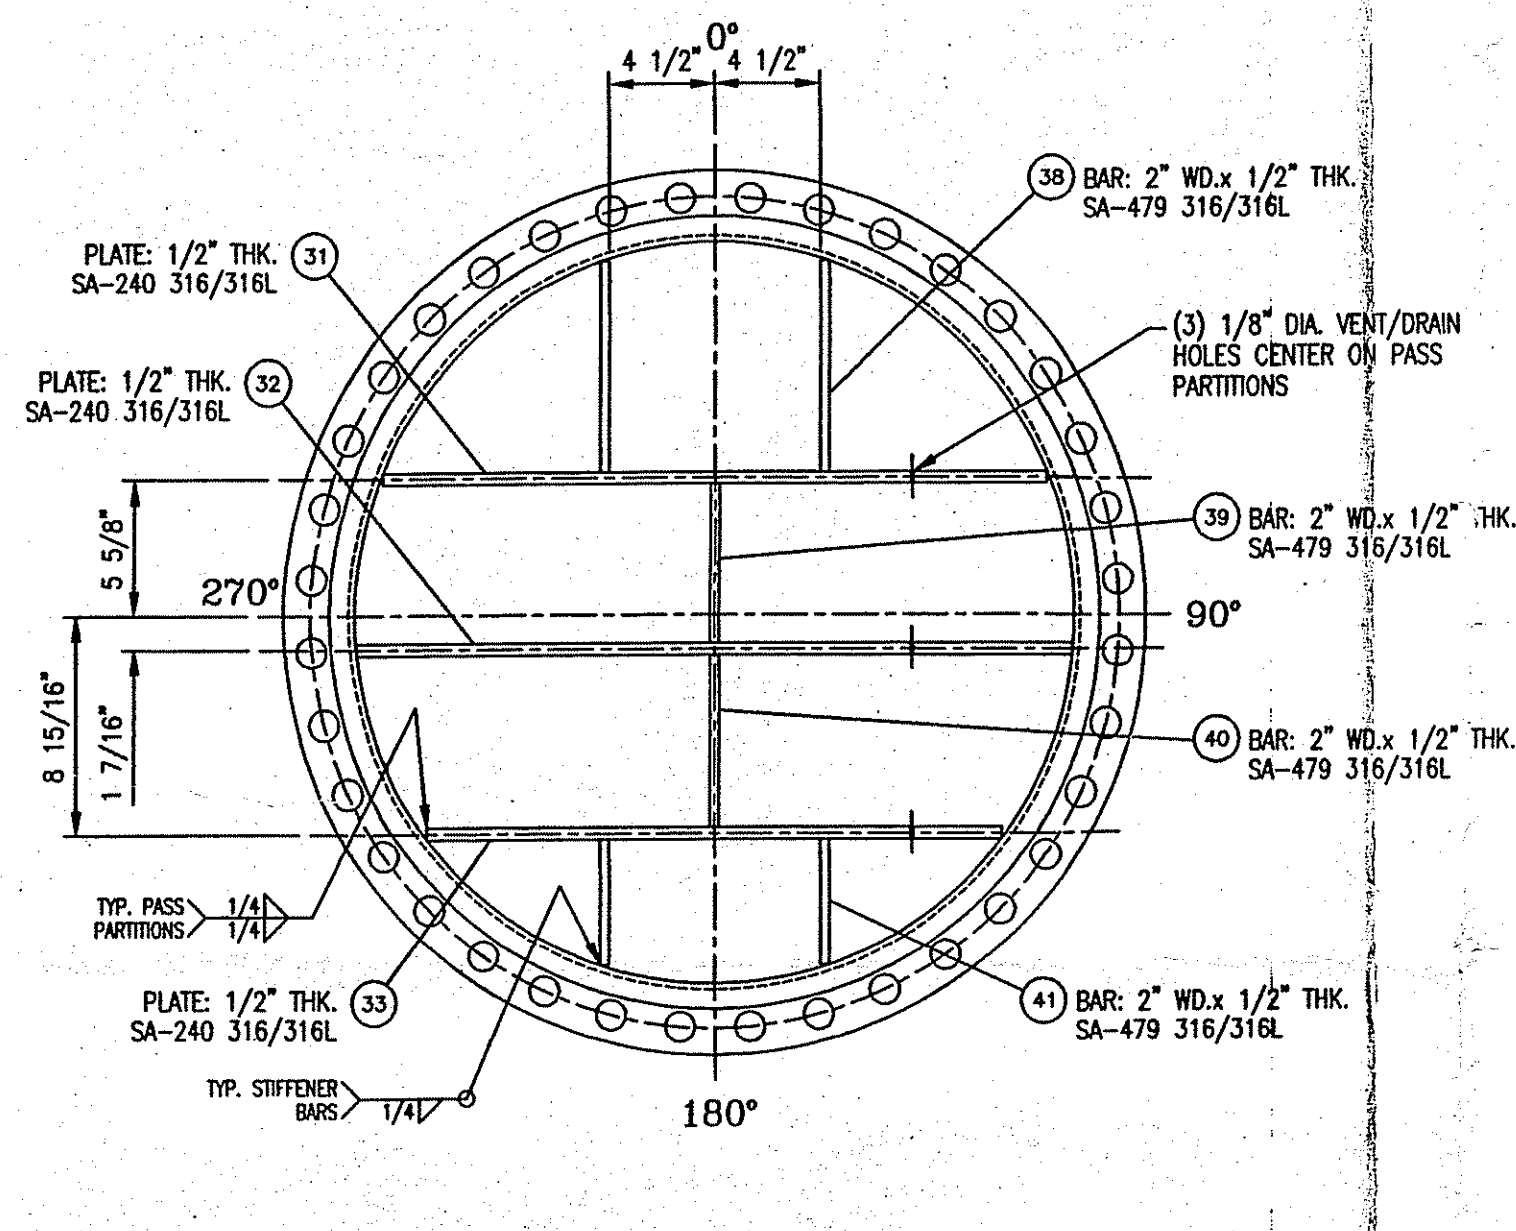


FRONT CHANNEL PASS PARTITION DETAIL
SCALE: 1 1/2"=12"

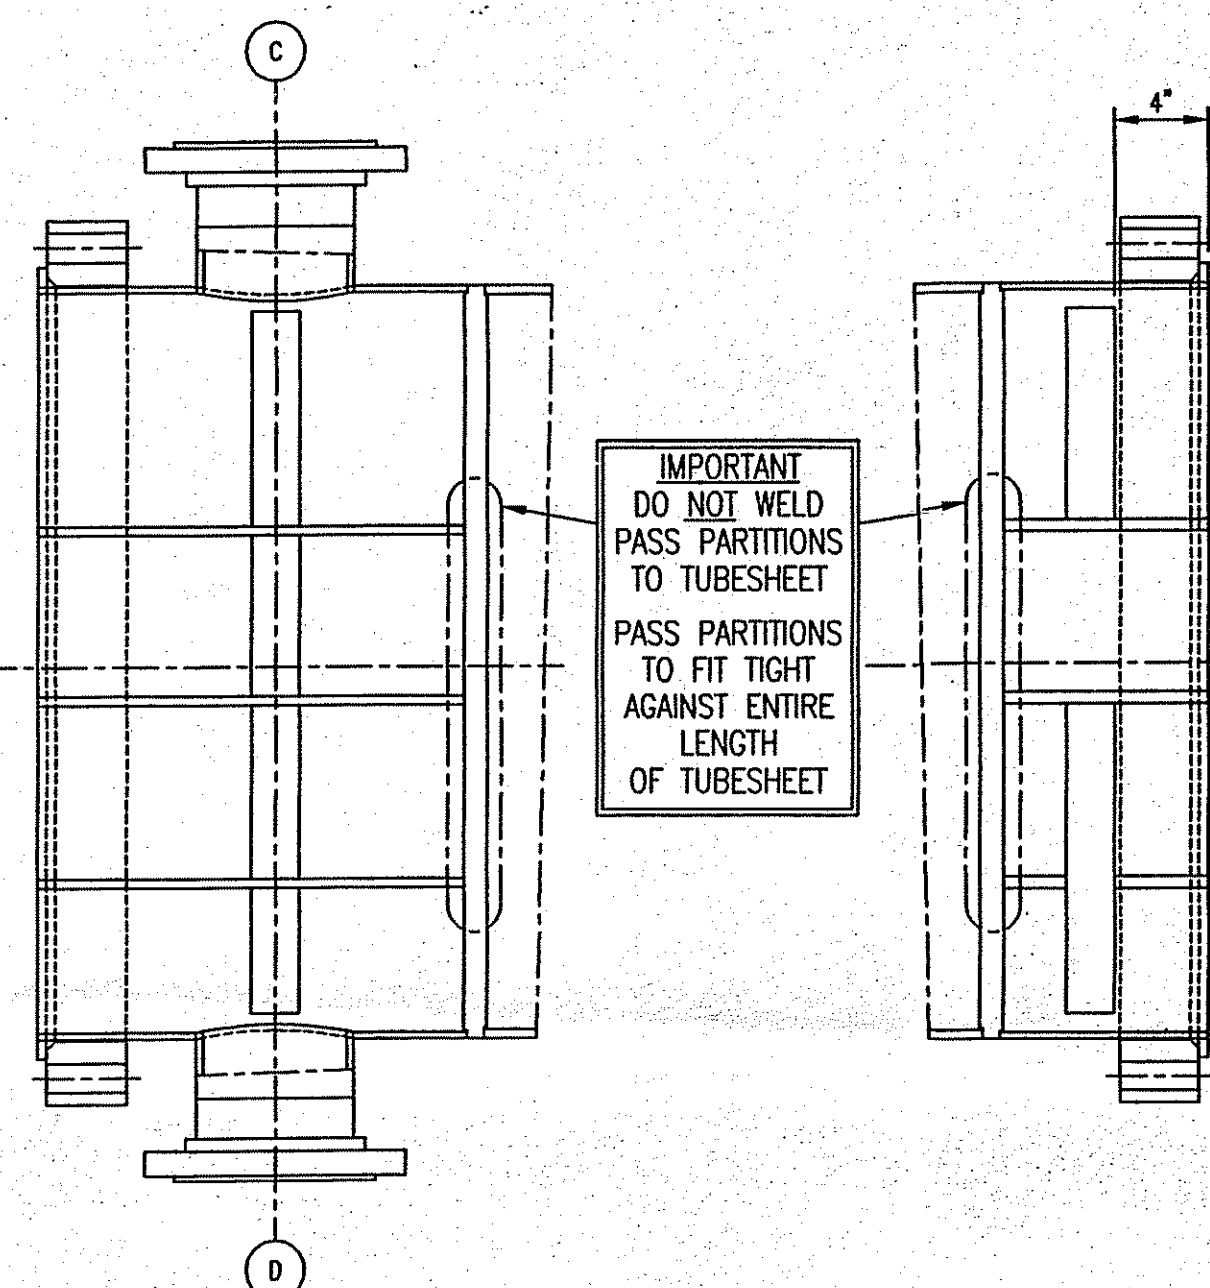


REAR CHANNEL PASS PARTITION DETAIL
SCALE: 1 1/2"=12"

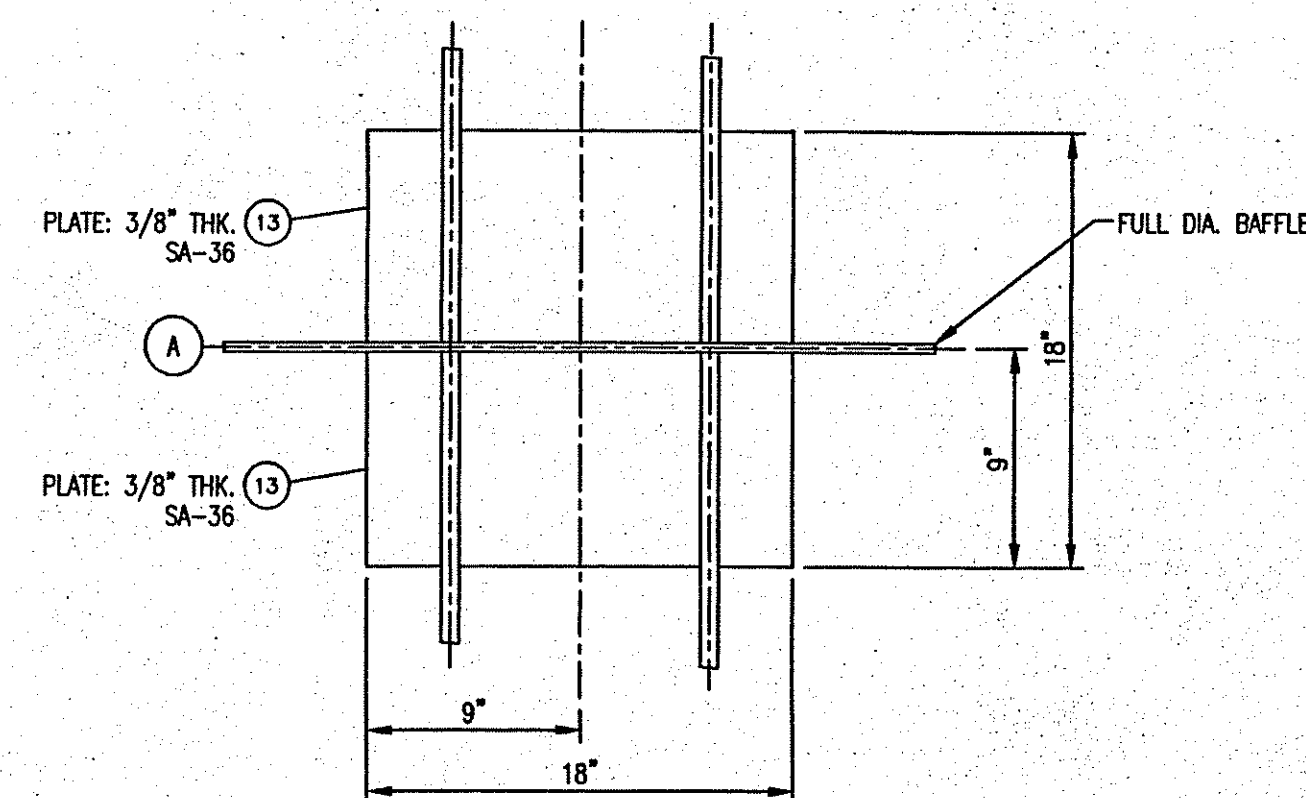


IMPINGEMENT PLATE
SCALE: 1 1/2"=12"

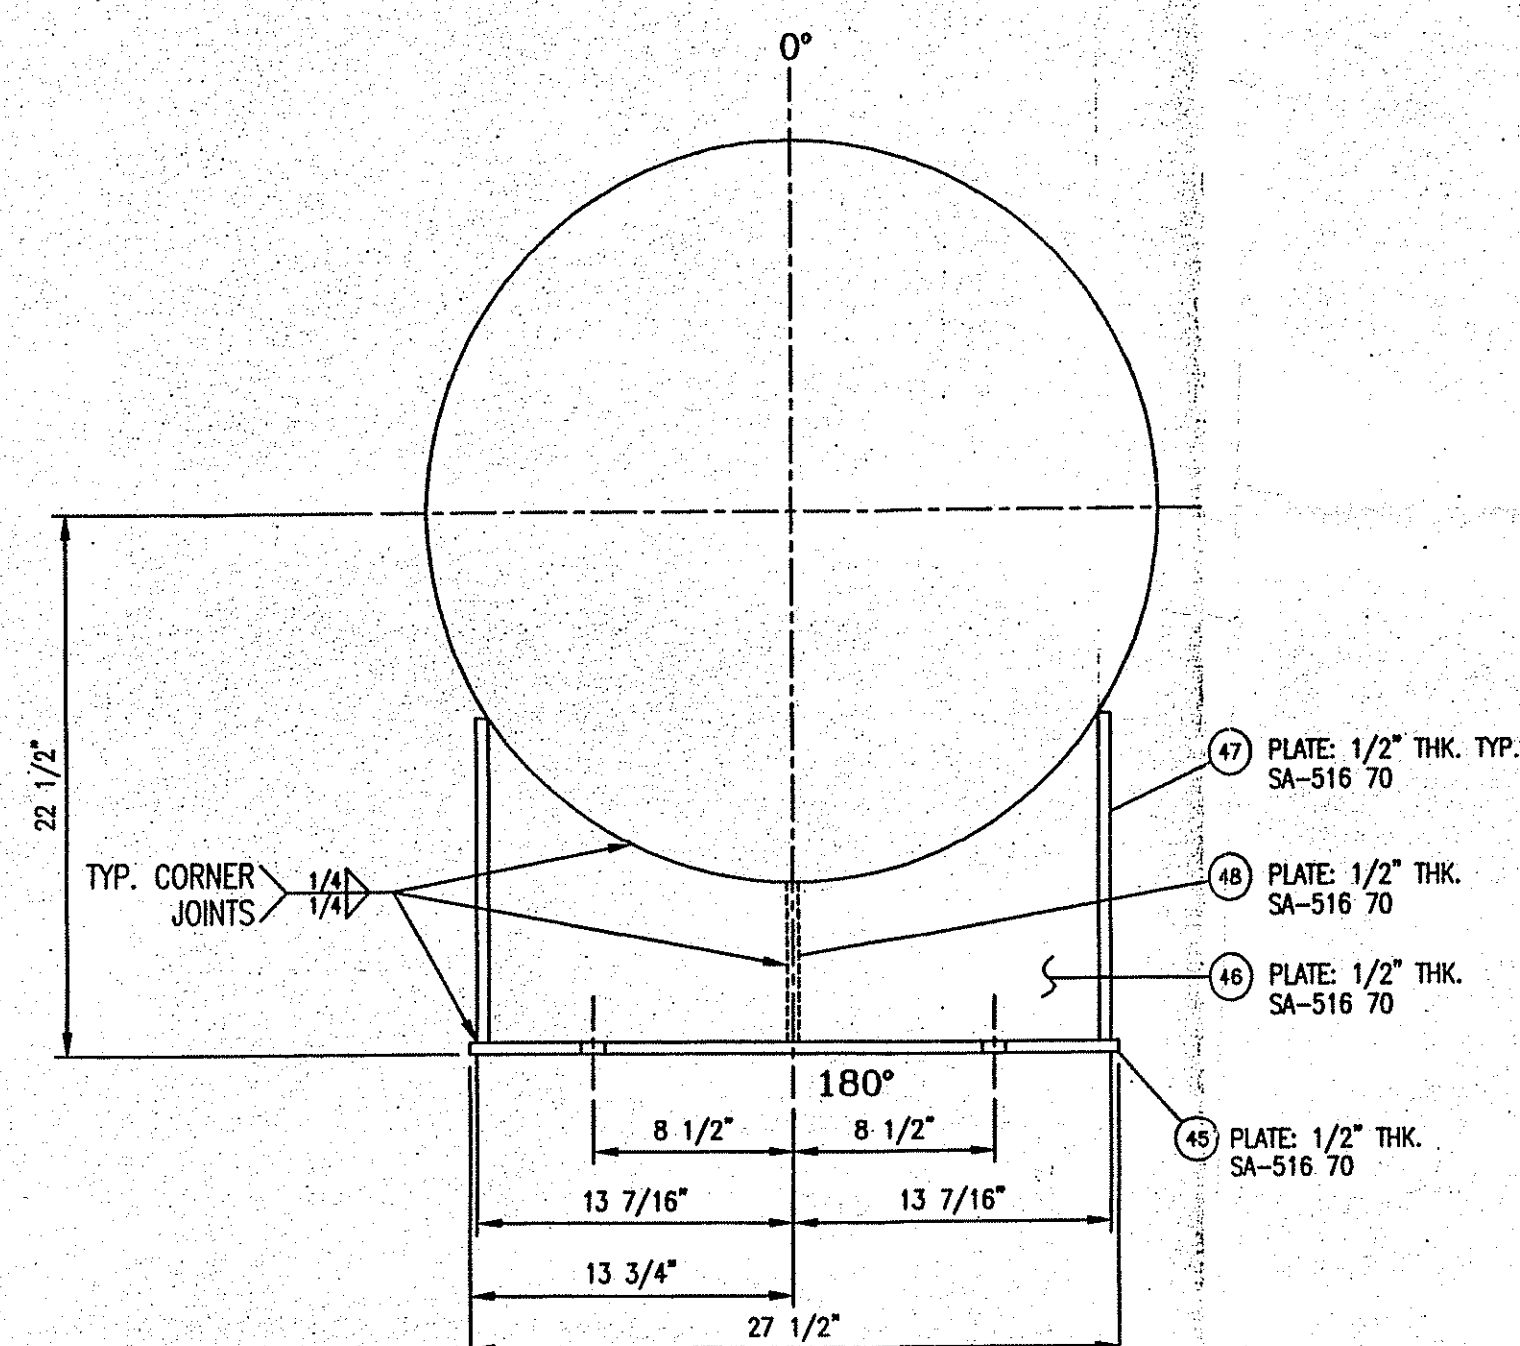


FRONT GASKET DETAIL
SCALE: 1 1/2"=12"

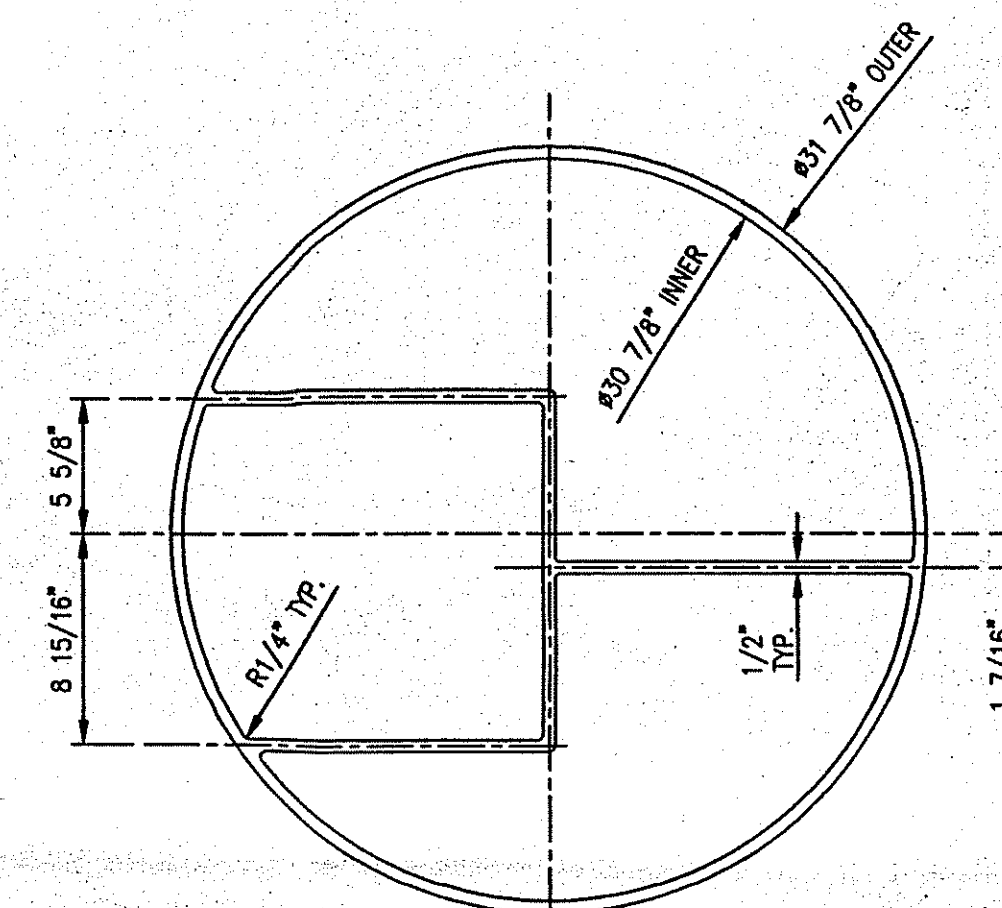

REAR GASKET DETAIL
SCALE: 1 1/2"=12"

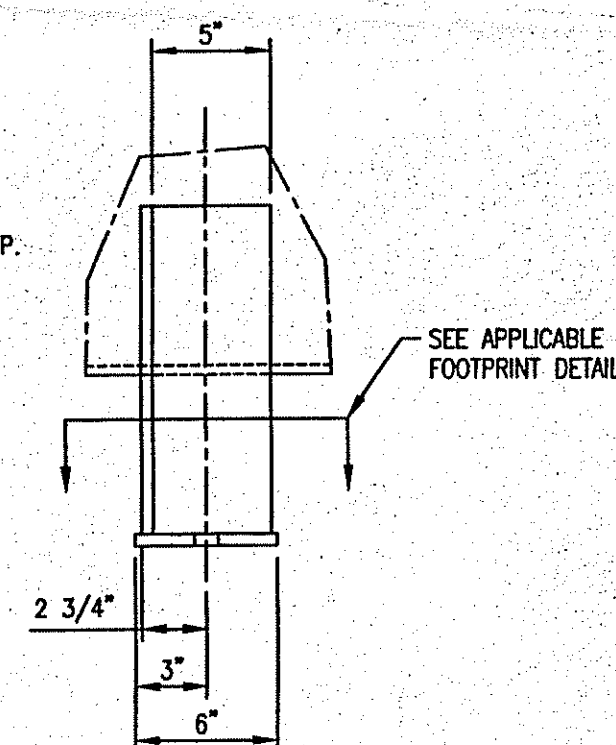


FIXED SUPPORT
FOOTPRINT DETAIL
SCALE: 1 1/2"=12"

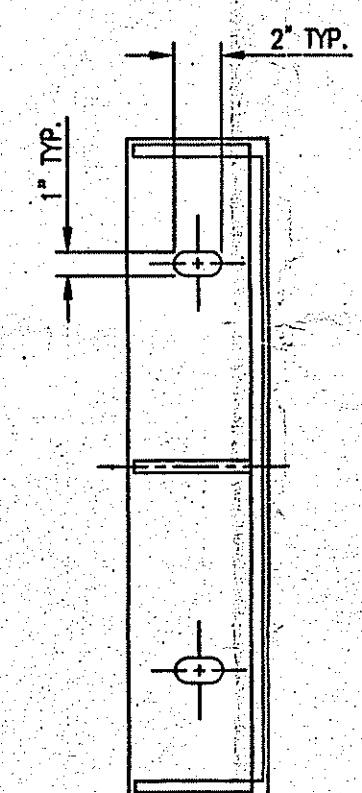

SLIDING SUPPORT
FOOTPRINT DETAIL
SCALE: 1 1/2"=12"

AS-BUILT PRINT
WARD TANK AND
HEAT EXCHANGER CORP
By: B. HUFFMAN
Date: 7/1/03

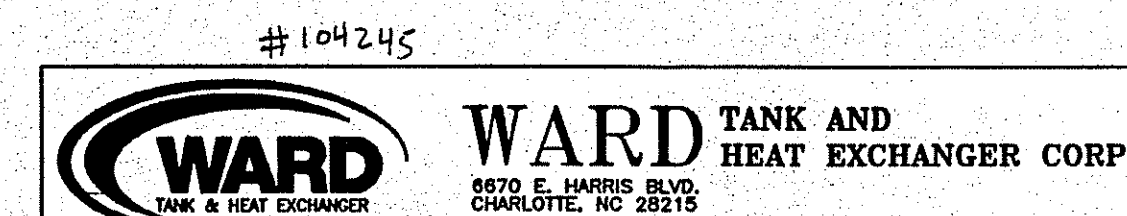

3	7/1/03	AS BUILT	BH	CUSTOMER	KOSA	PURCHASE ORDER NUMBER	4800122878
2	6/20/03	REVISED GASKET DIMENSIONS	BH	TITLE	WILMINGTON, NC		
1	3/27/2003	REVISED PER CUSTOMERS COMMENTS/RELEASED FOR FABRICATION	DMB				
0	3/21/2003	FOR CUSTOMER APPROVAL	DMB				
REV. NO.	DATE	DESCRIPTION	BY	EQUIPMENT NO.	E-6511-2R	SCALE	AS NOTED
APPROVED BY	DATE	7/1/03	DRAWING NUMBER	2003-HC-5155	NO. REQ'D	1	
DRAWN BY	BRADSHAW	DATE	3/20/2003		REV. NO.	3	

THIS DRAWING IS THE PROPERTY OF WARD TANK AND HEAT EXCHANGER CORP AND IS ONLY TO BE USED IN REFERENCE TO WORK PROPOSED OR CONTRACTED BY THIS COMPANY. IT MUST NOT BE REPRODUCED OR SUBMITTED TO OUTSIDE PARTIES WITHOUT THE WRITTEN PERMISSION OF WARD TANK AND HEAT EXCHANGER CORP.

SHEET 2 OF 3