


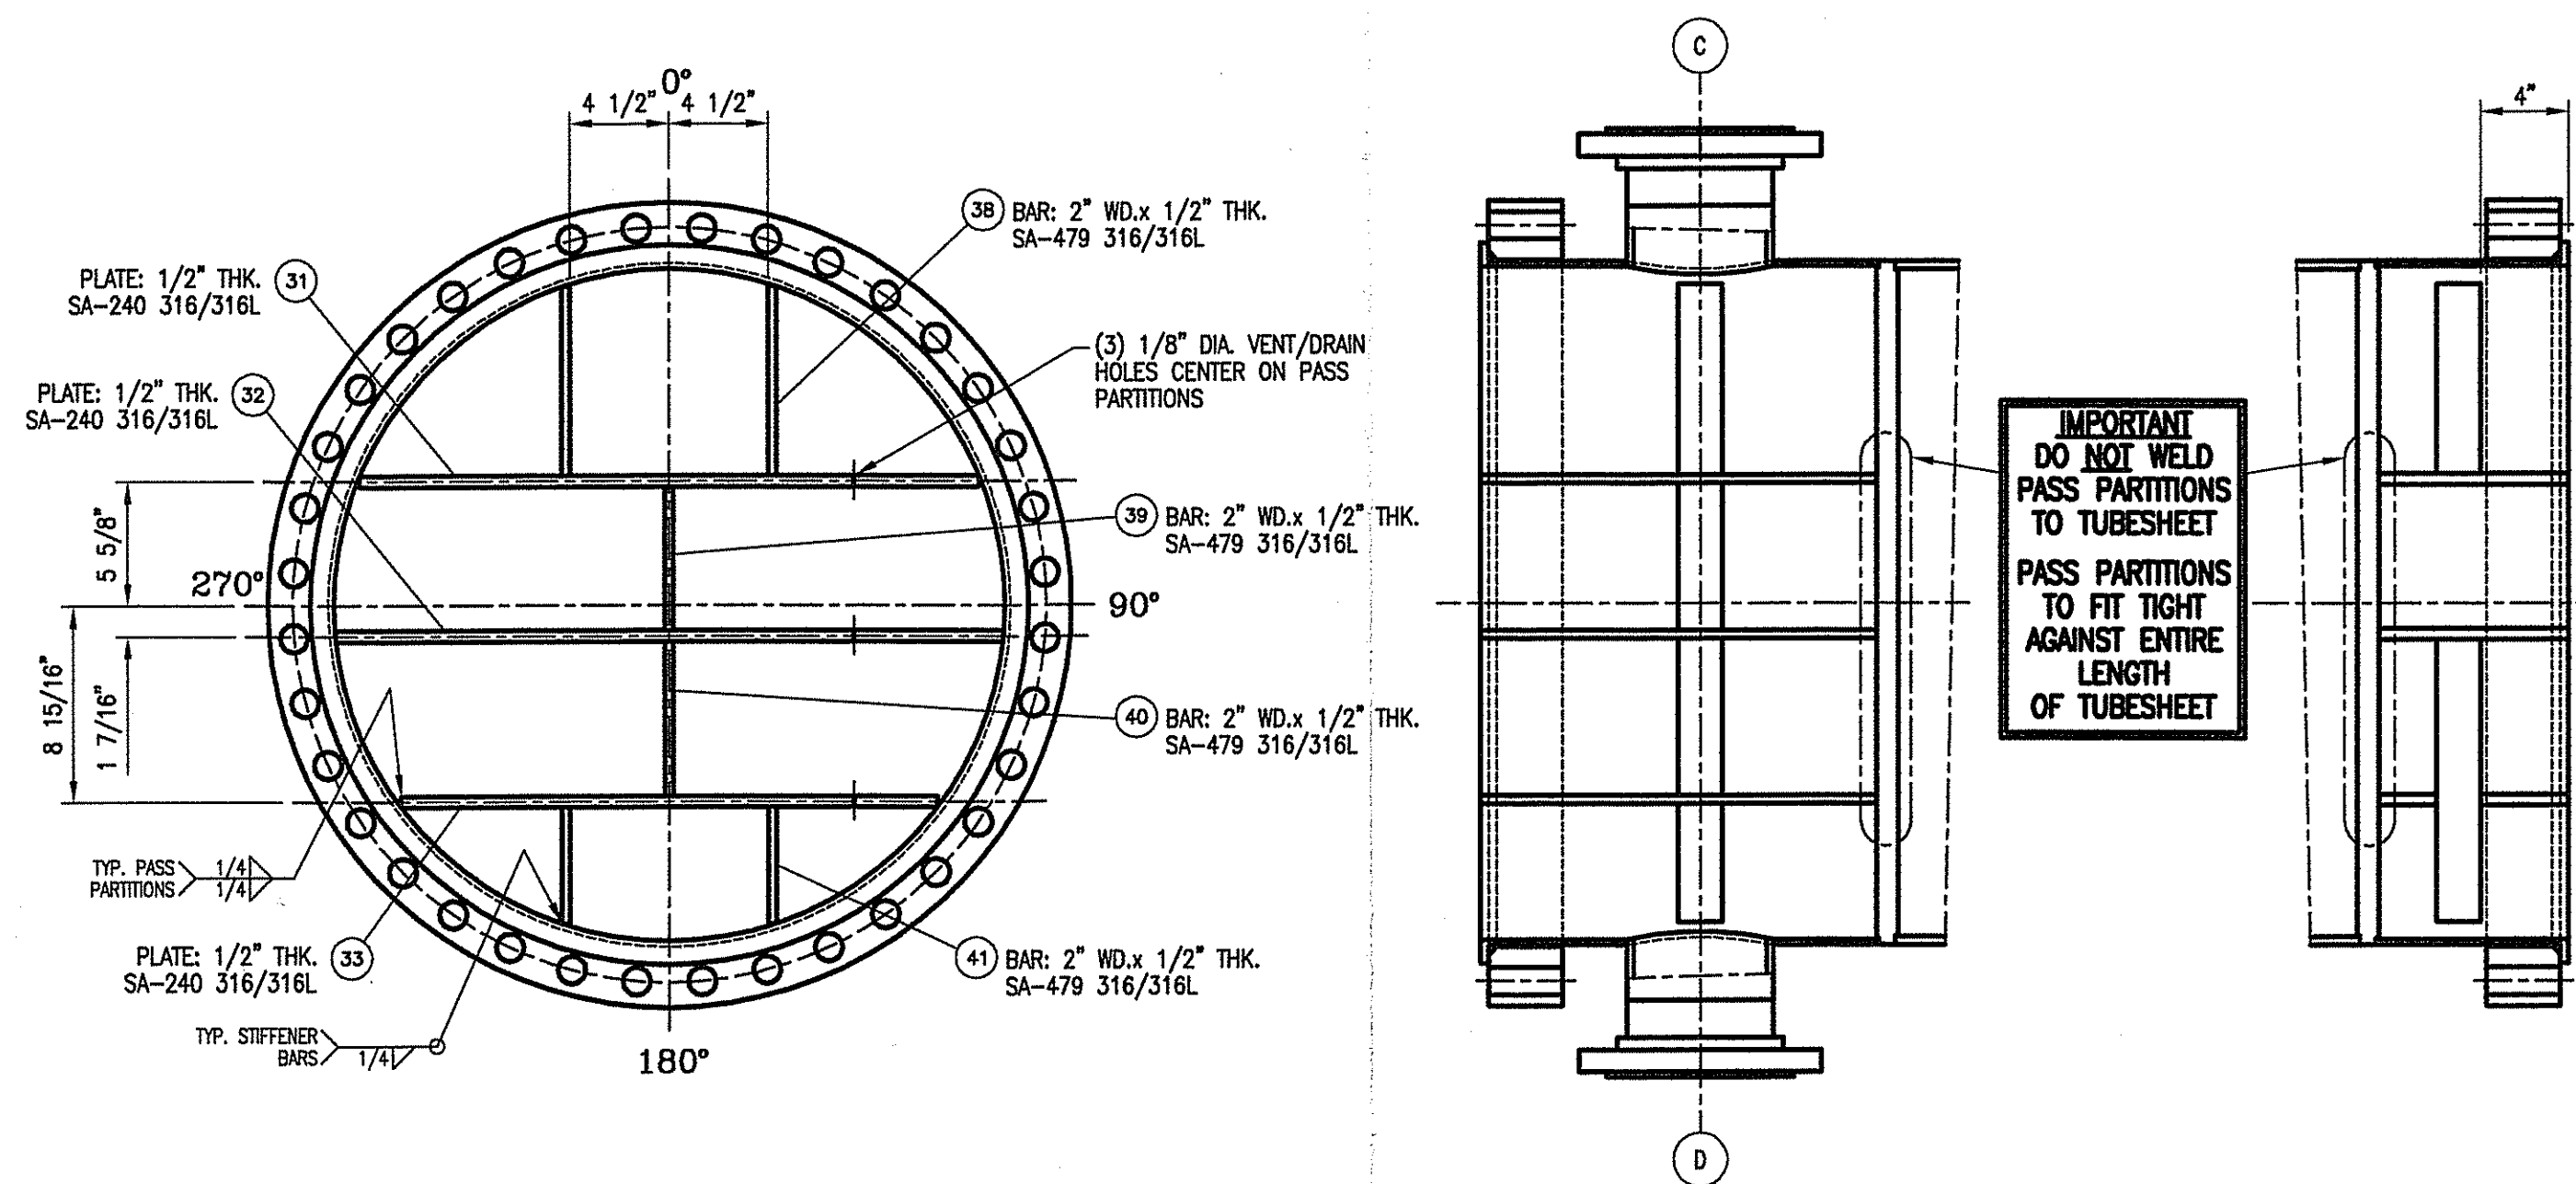


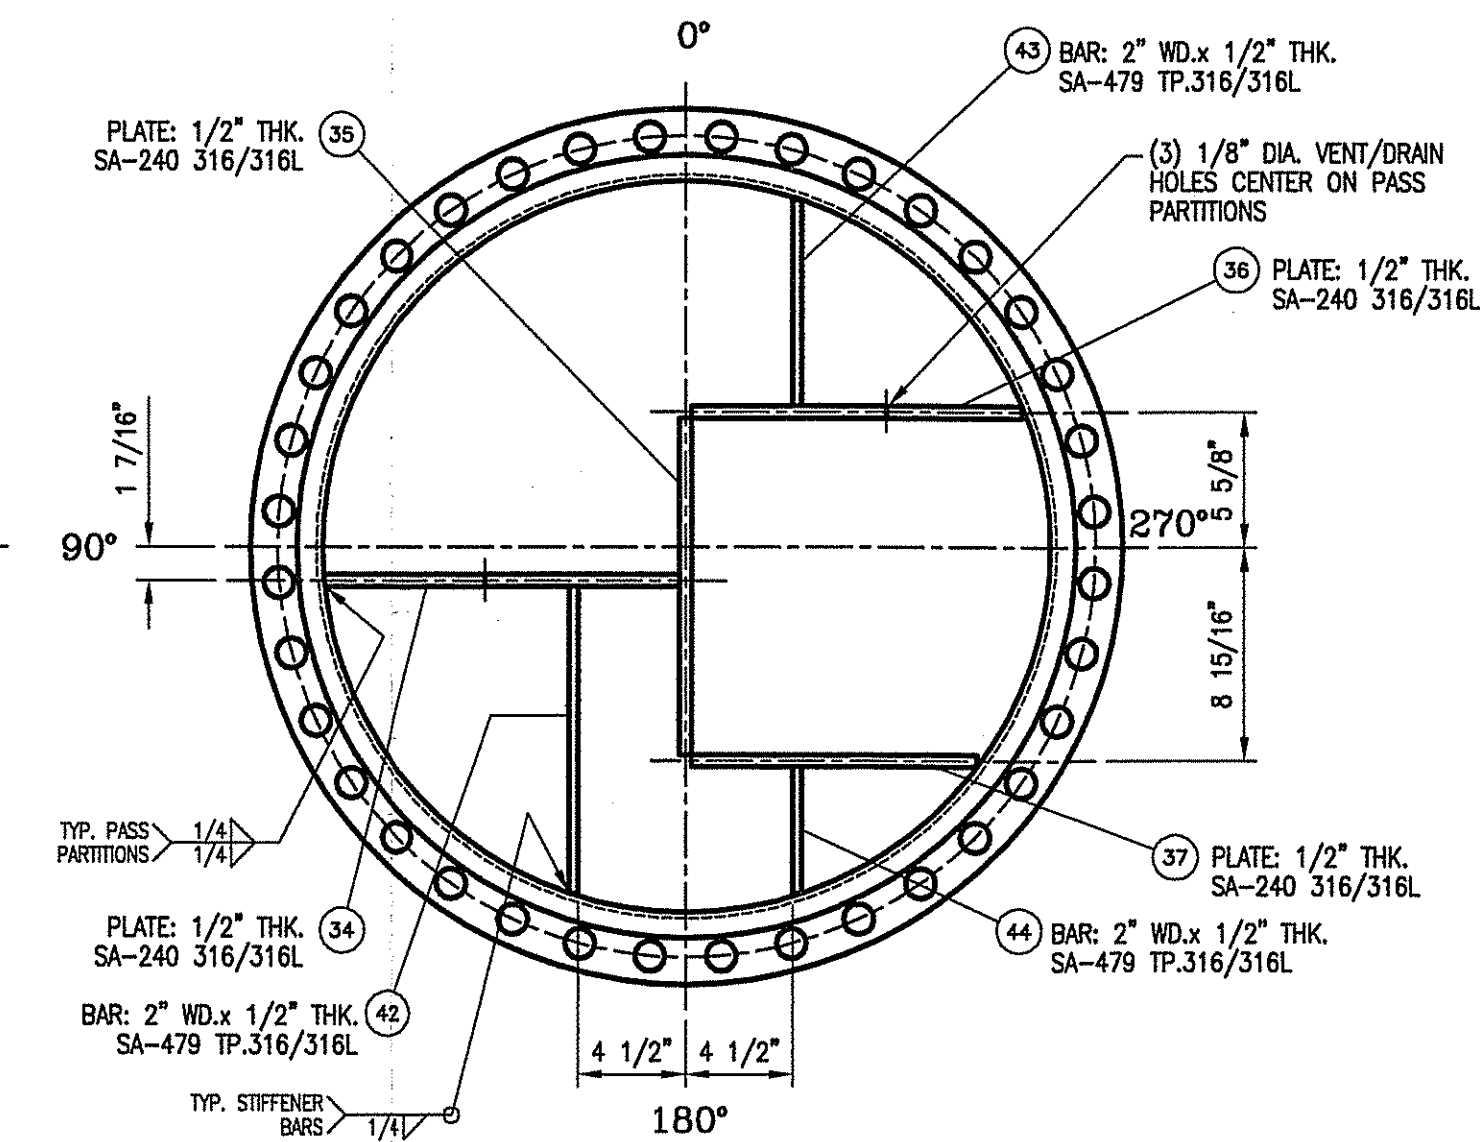


FRONT CHANNEL PASS PARTITION DETAIL
SCALE: 1 1/2"=12"

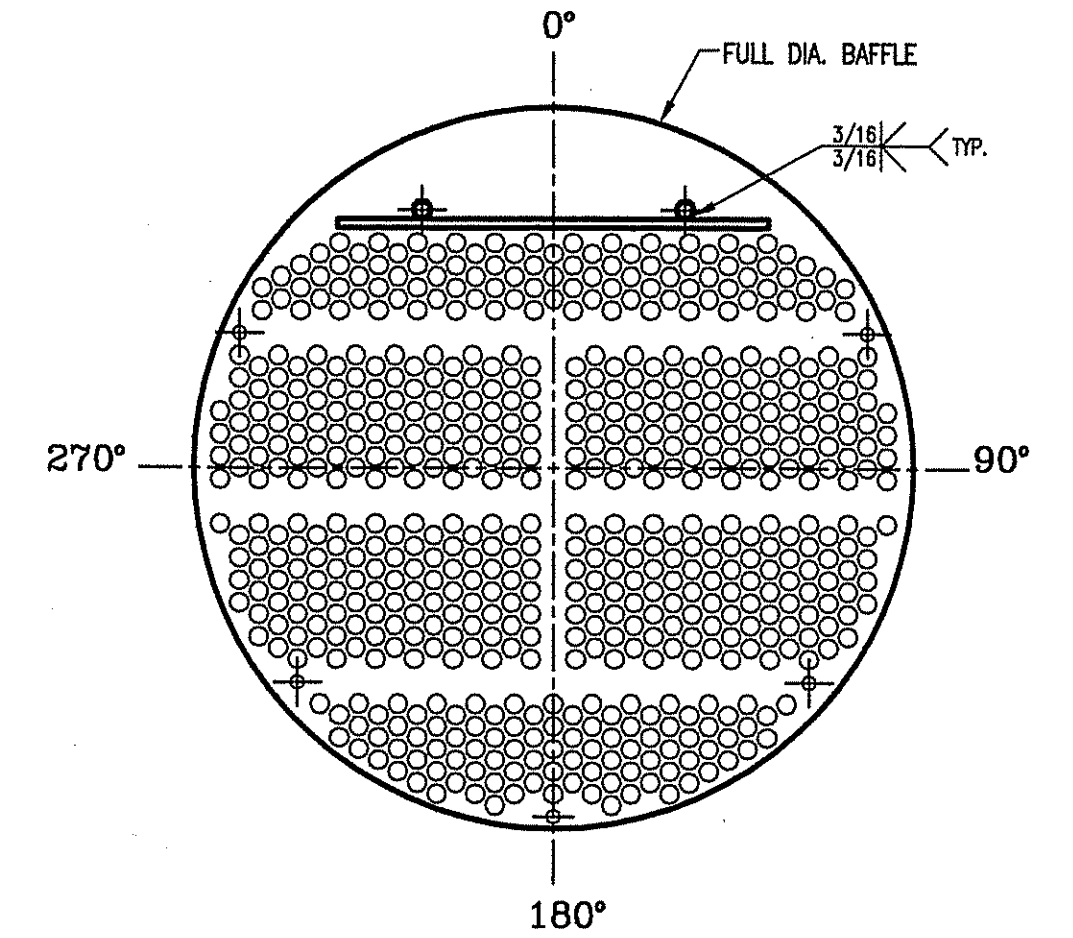


REAR CHANNEL PASS PARTITION DETAIL
SCALE: 1 1/2"=12"

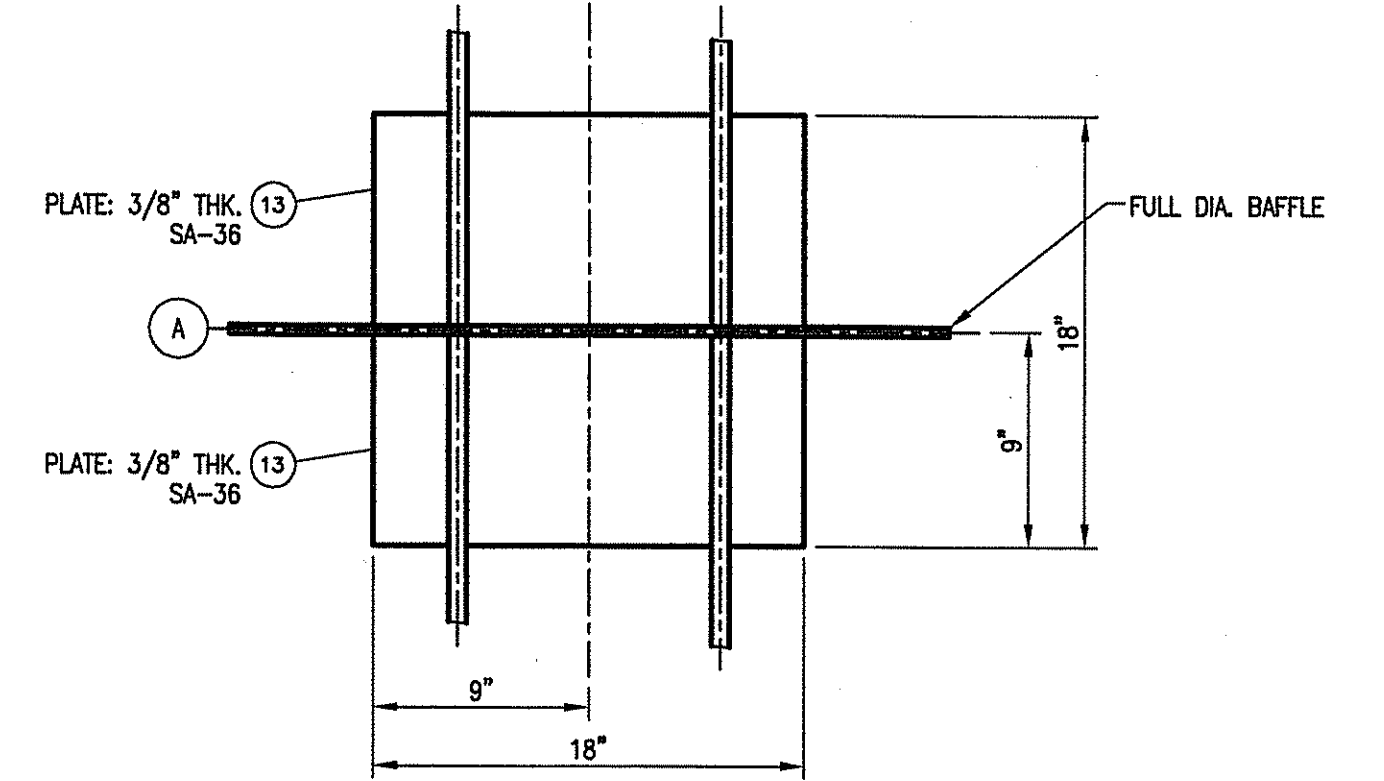


IMPINGEMENT PLATE
SCALE: 1 1/2"=12"

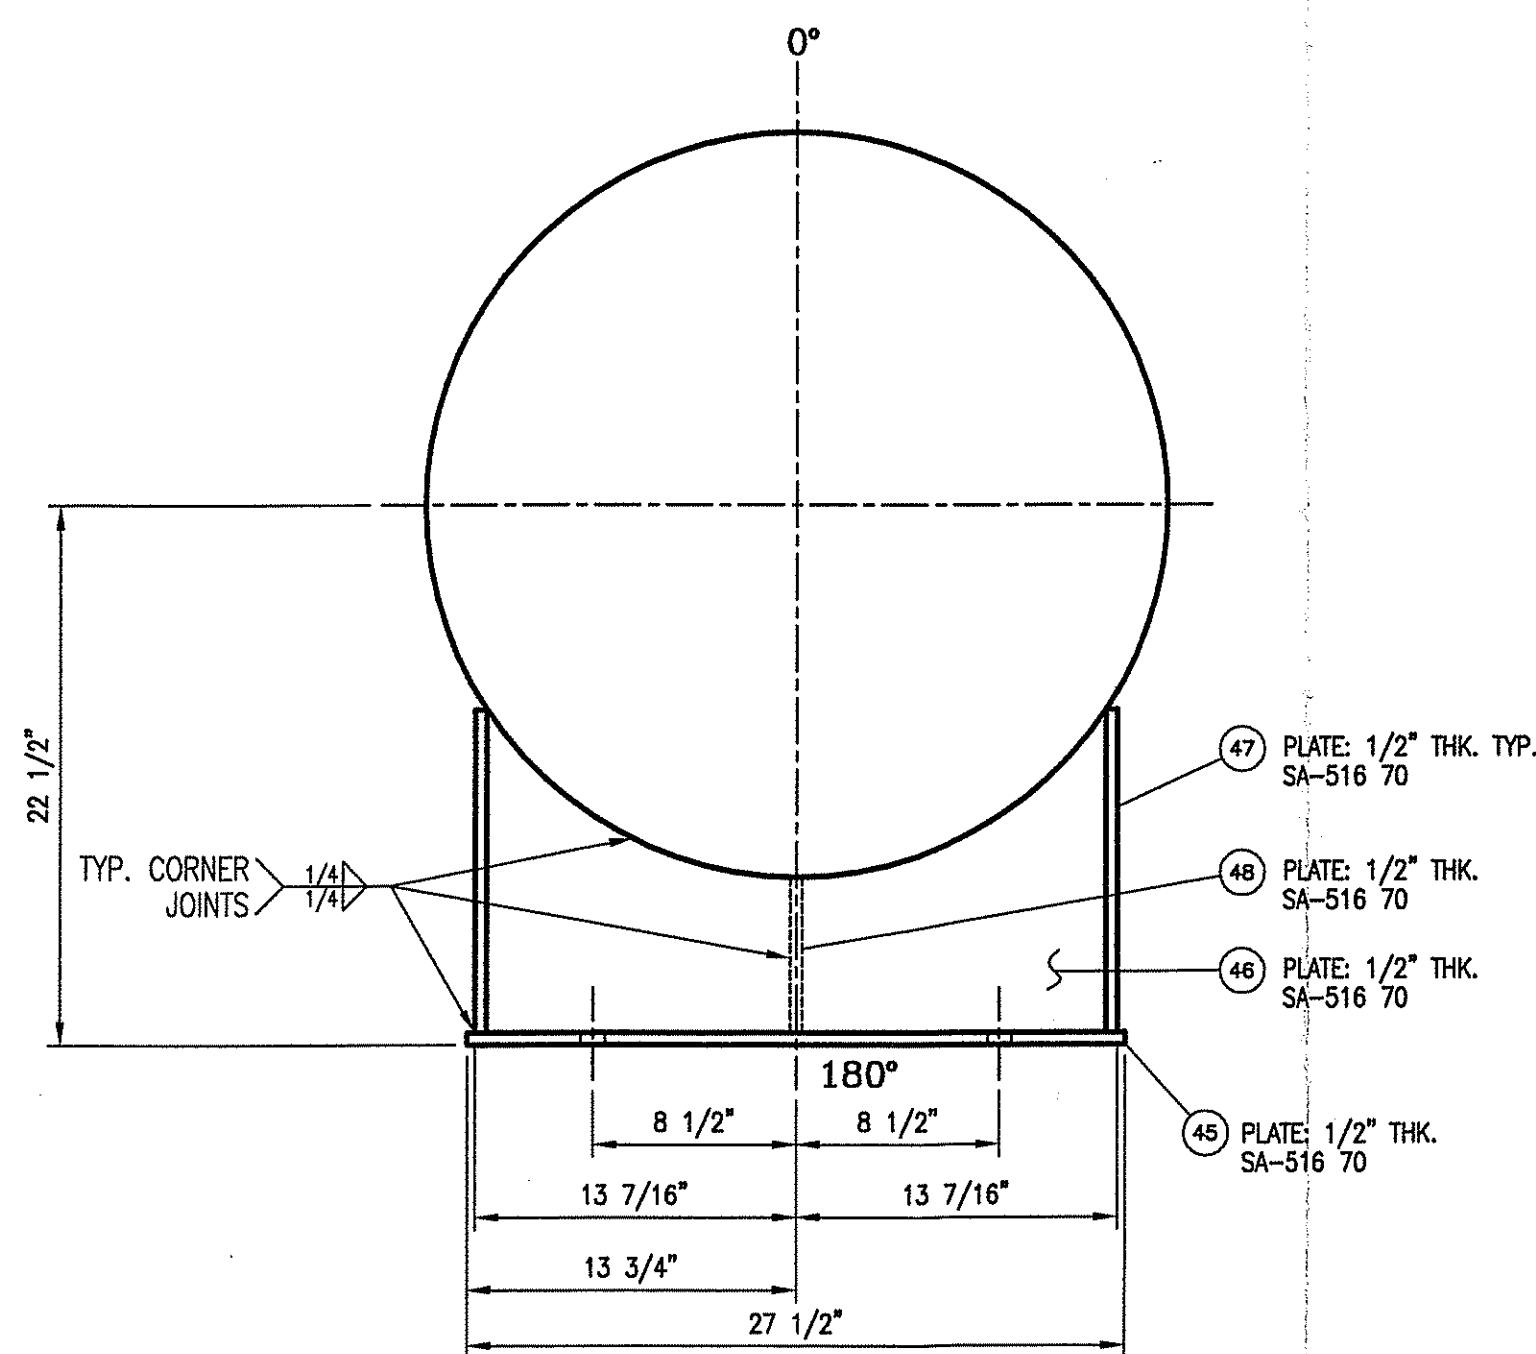


FRONT GASKET DETAIL
SCALE: 1 1/2"=12"

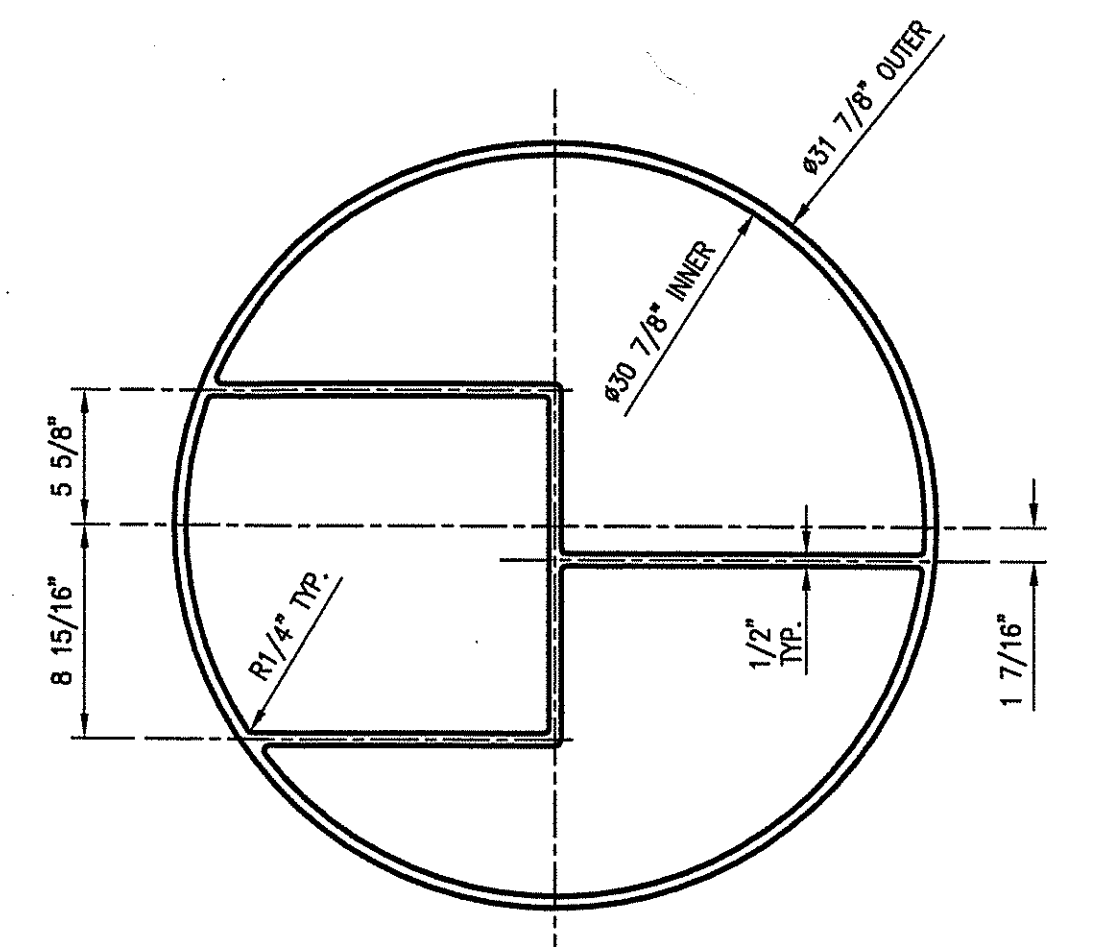

REAR GASKET DETAIL
SCALE: 1 1/2"=12"

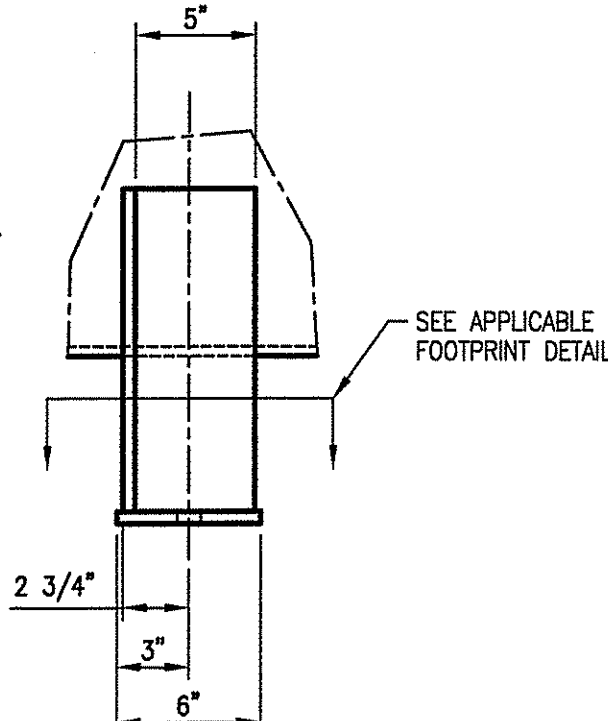

FIXED SUPPORT
FOOTPRINT DETAIL
SCALE: 1 1/2"=12"

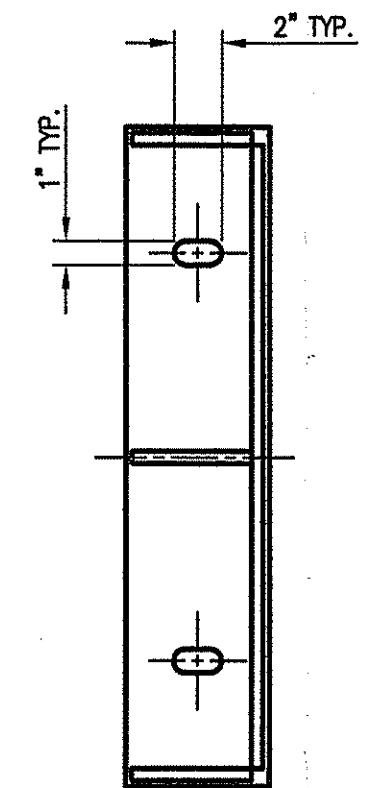








SLIDING SUPPORT
FOOTPRINT DETAIL
SCALE: 1 1/2"=12"

AS-BUILT PRINT
WARD TANK AND
HEAT EXCHANGER CORP
By: B. HUFFMAN
Date: 8/13/2003

2	12/16/03	AS BUILT	BH	CUSTOMER	KOSA WILMINGTON, NC	PURCHASE ORDER NUMBER	4800136994
1	8/19/03	RELEASED FOR FABRICATION	BH	TITLE	#30-240 NJN HEAT EXCHANGER		
0	8/13/03	FOR CUSTOMER APPROVAL	BH	EQUIPMENT NO.	E-6511-2R2	SCALE	AS NOTED
REV NO.	DATE	DESCRIPTION	BY	APPROVED BY	DATE	DRAWING NUMBER	REV. NO.
				HUFFMAN	8/13/2003	2003-HC-5292	2

THIS DRAWING IS THE PROPERTY OF WARD TANK AND HEAT EXCHANGER CORP AND IS ONLY TO BE USED IN REFERENCE TO WORK PROPOSED OR CONTRACTED BY THIS COMPANY. IT MUST NOT BE REPRODUCED OR SUBMITTED TO OUTSIDE PARTIES WITHOUT THE WRITTEN PERMISSION OF WARD TANK AND HEAT EXCHANGER CORP.

WARD TANK AND
HEAT EXCHANGER CORP
8670 E. HARRIS BLVD.
CHARLOTTE, NC 28215

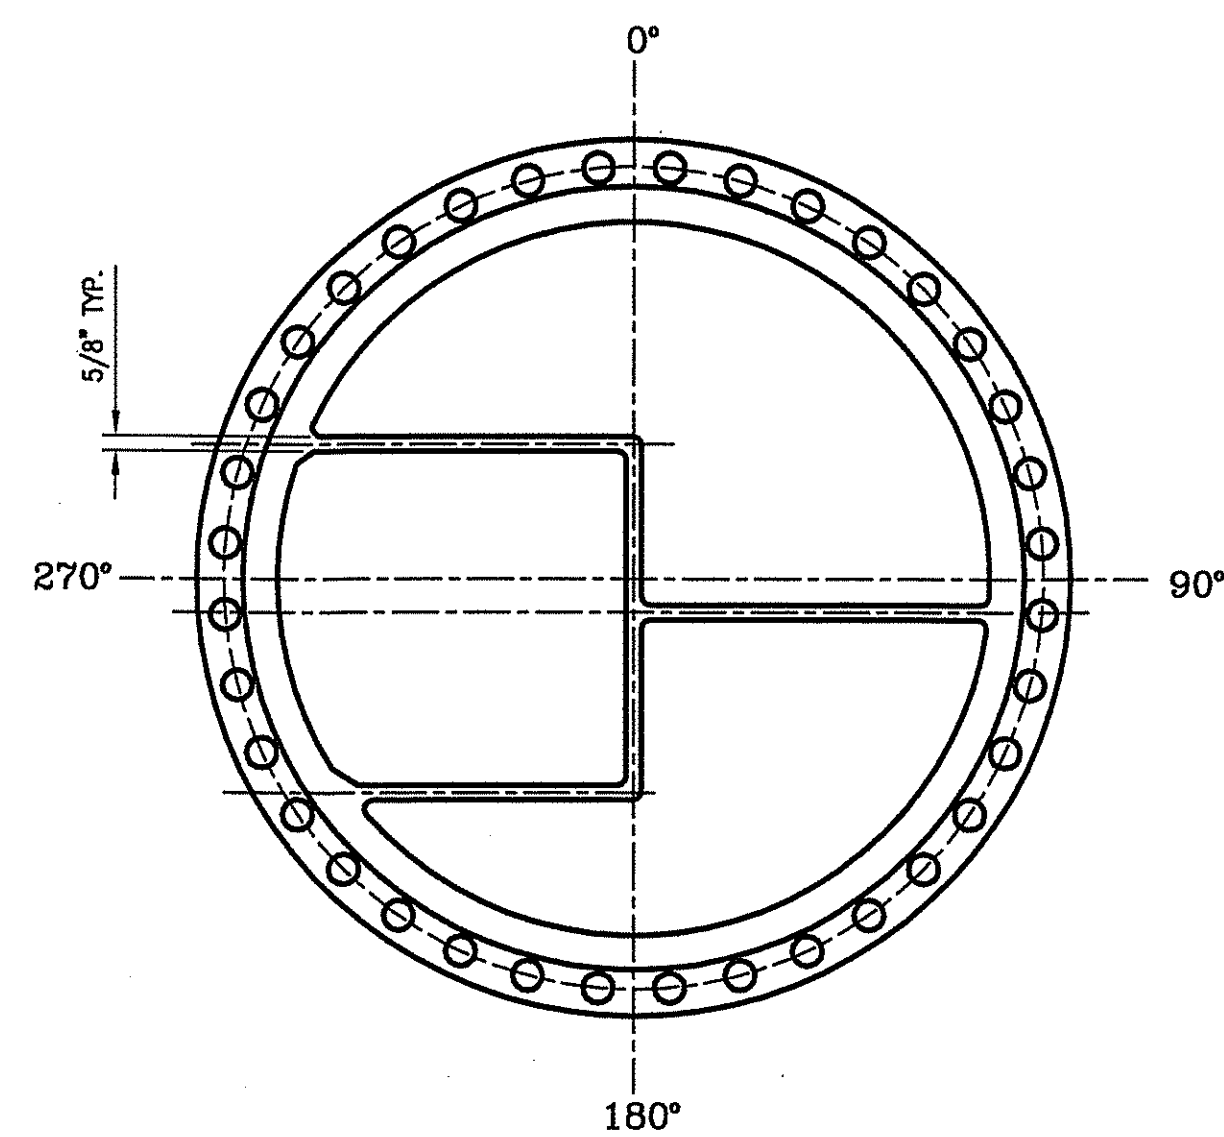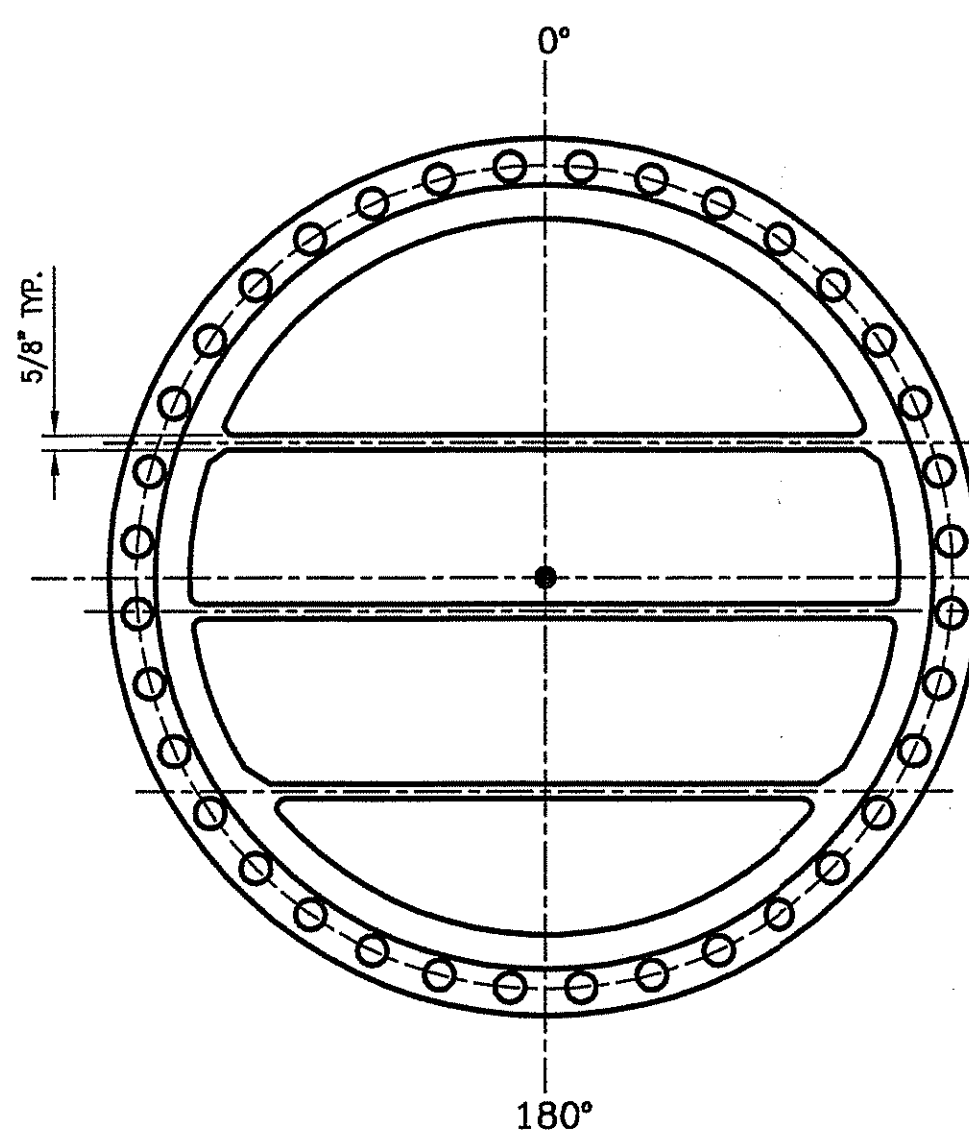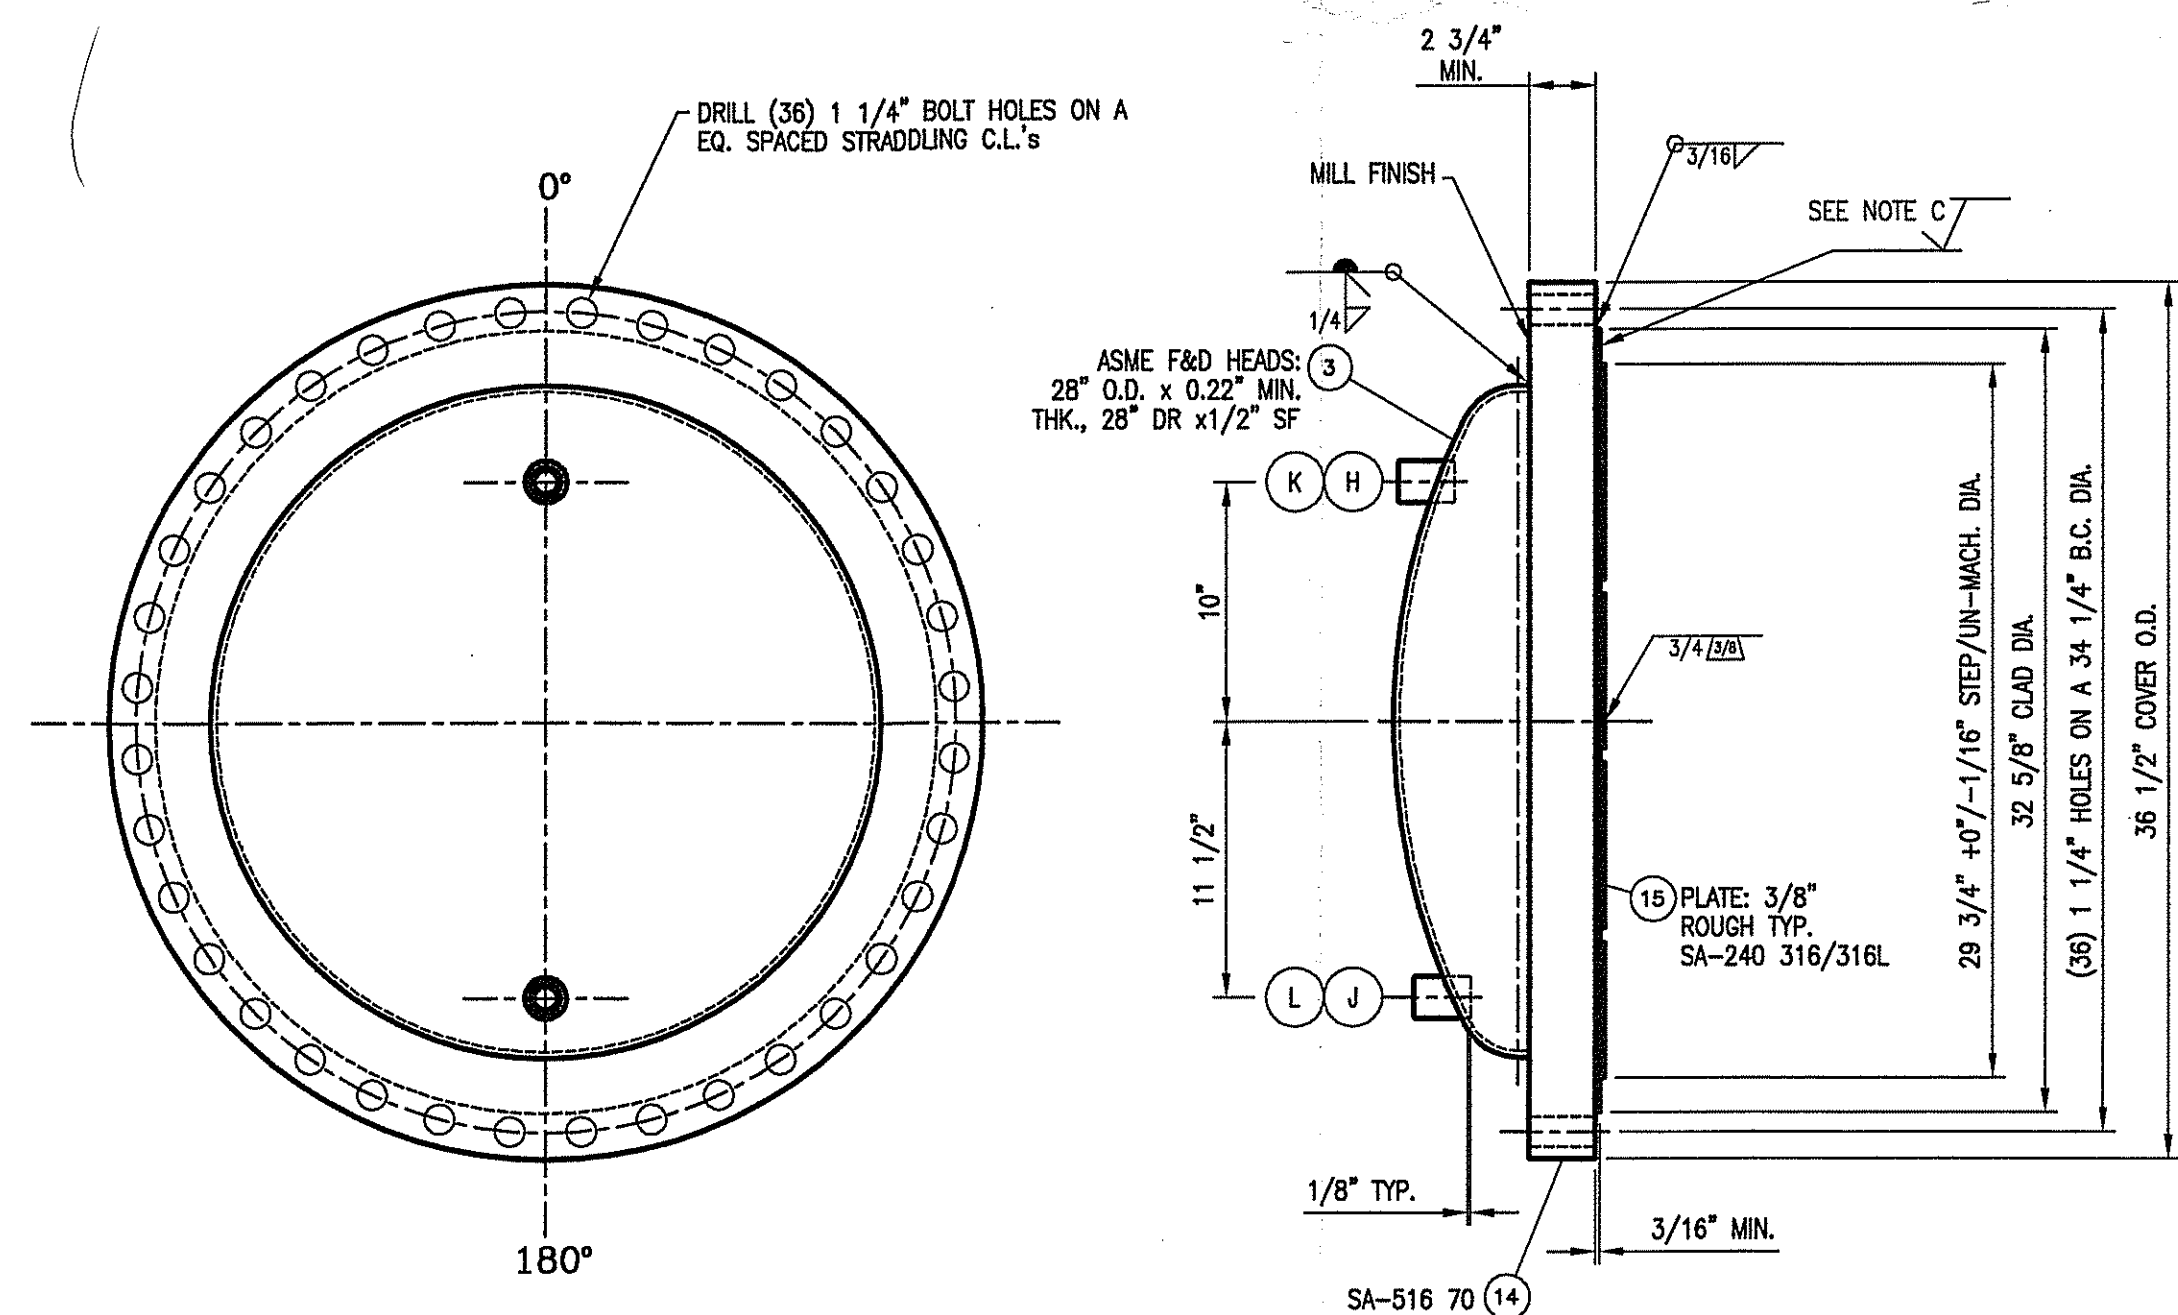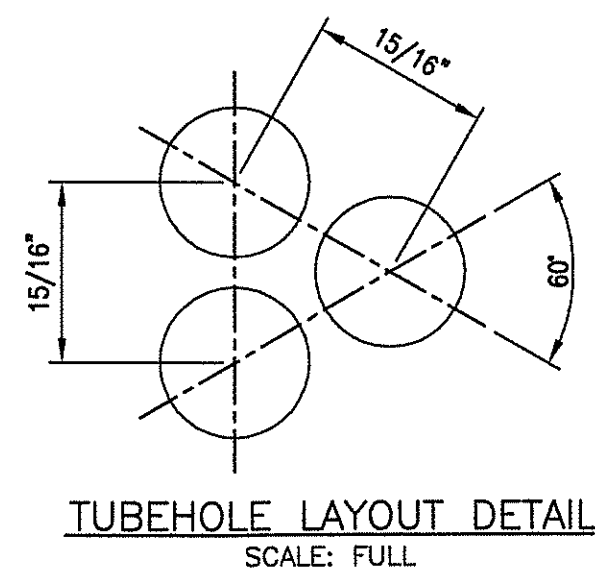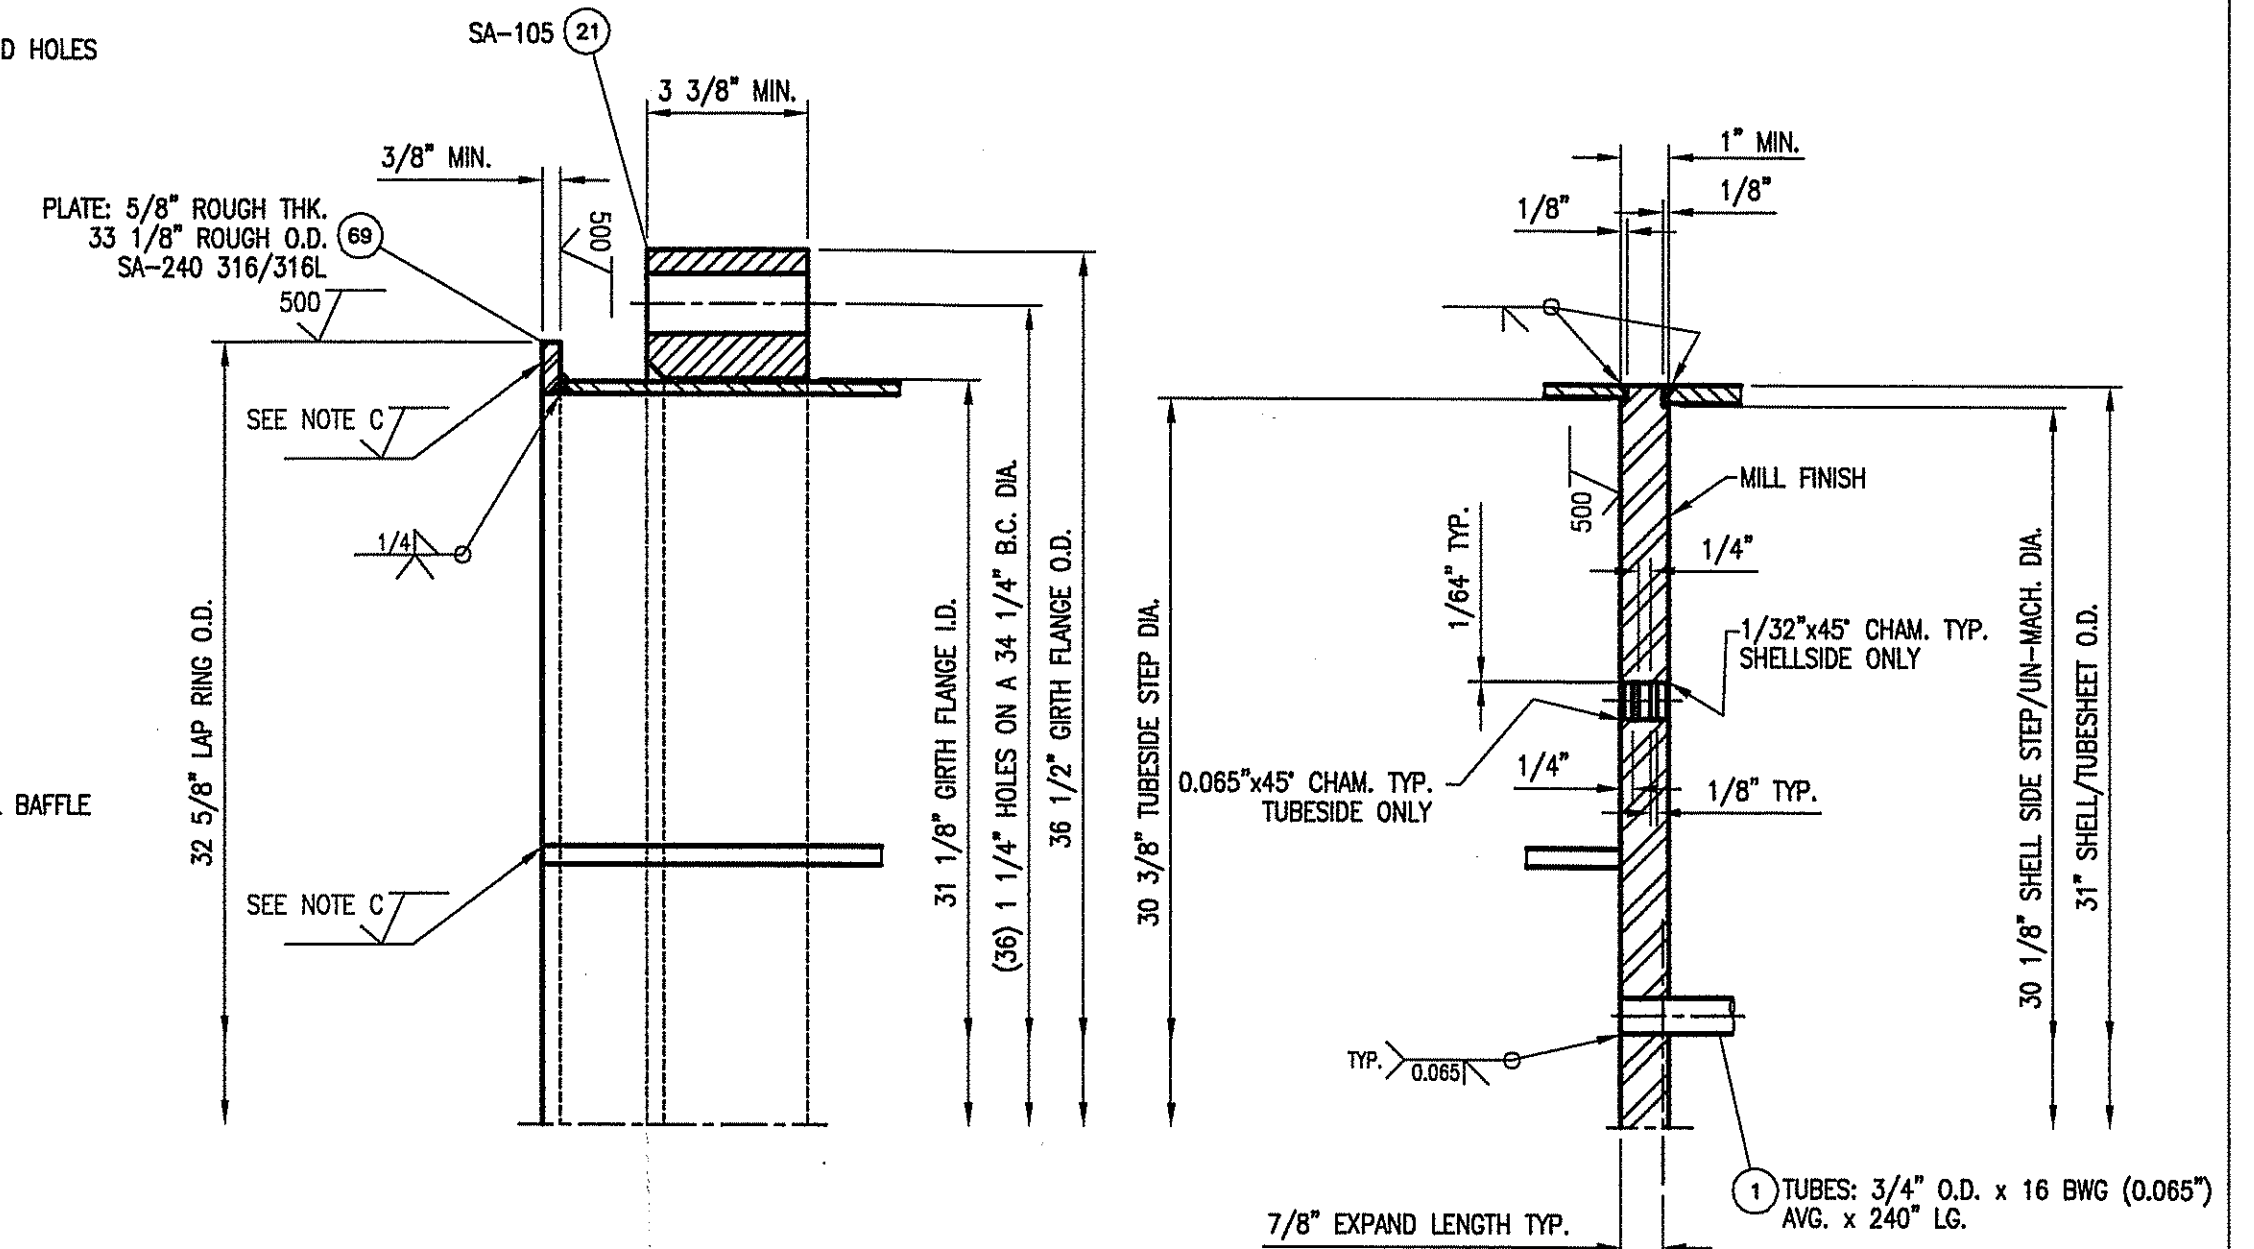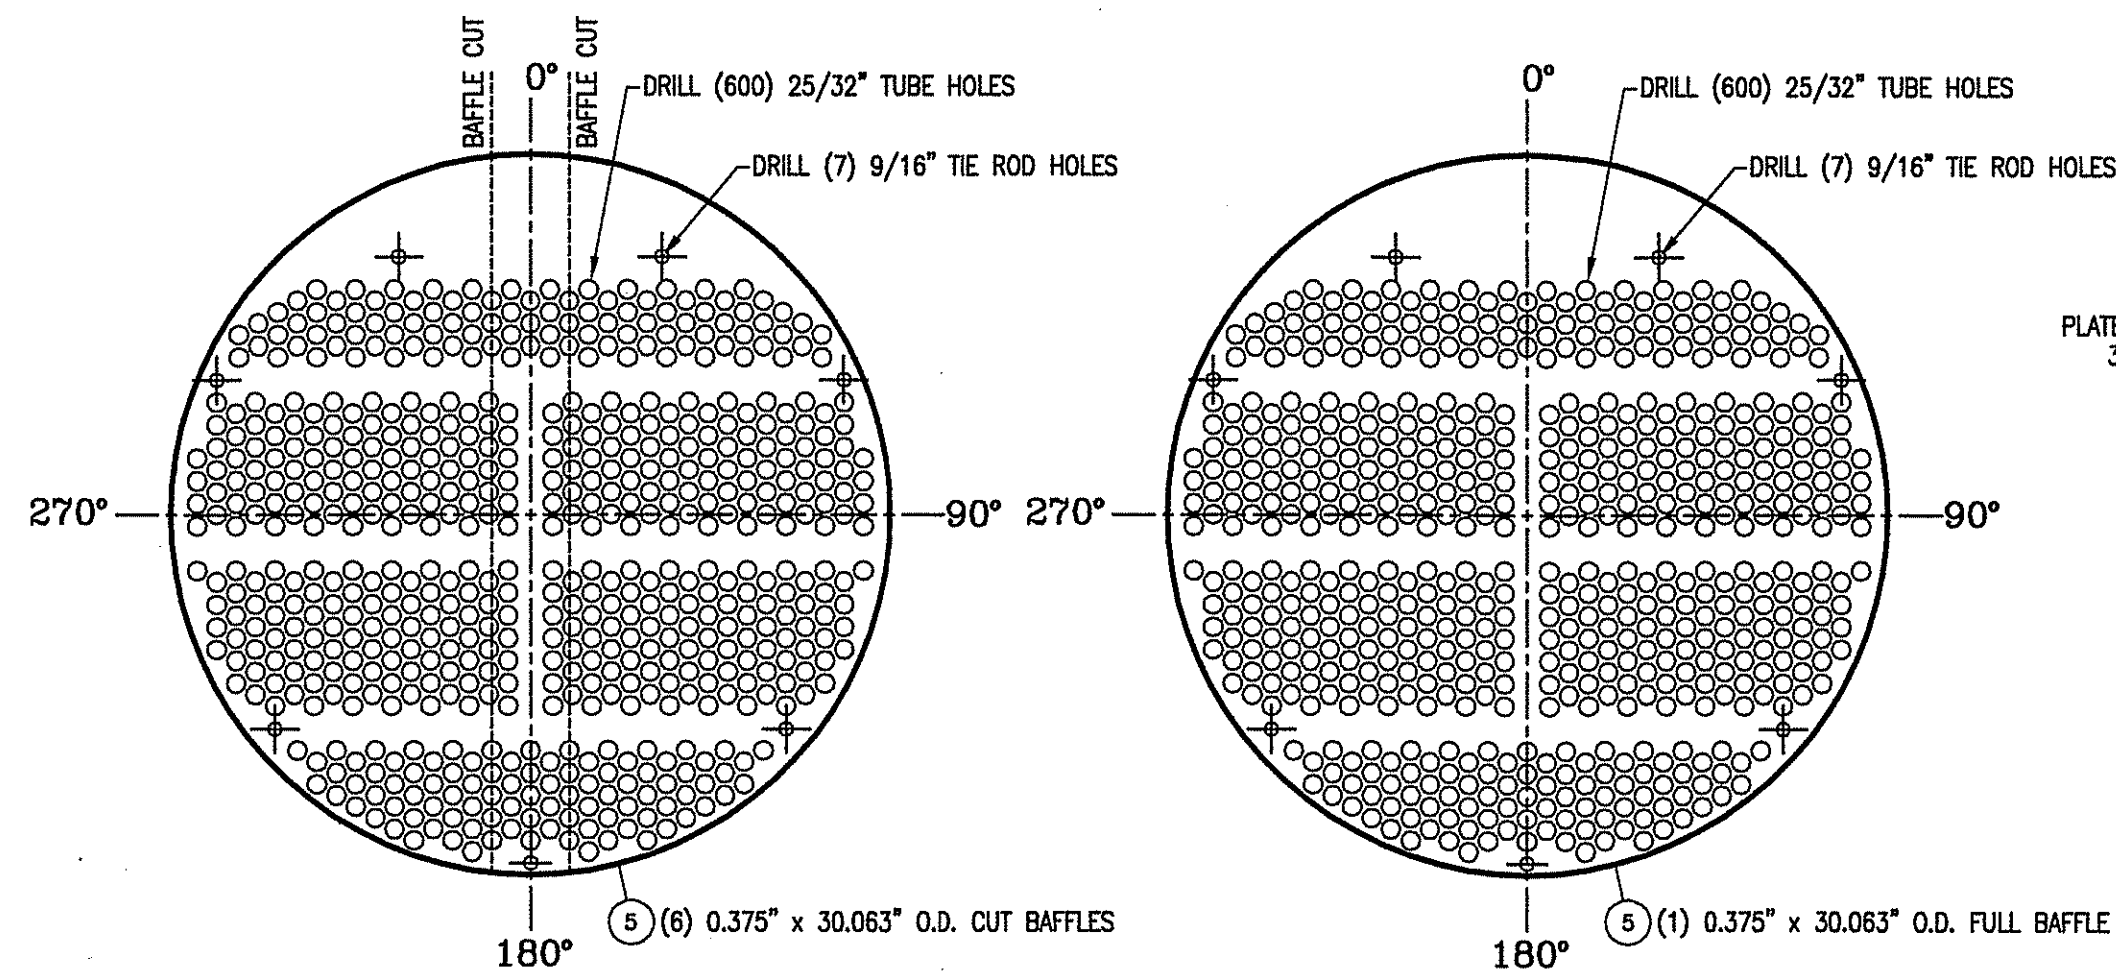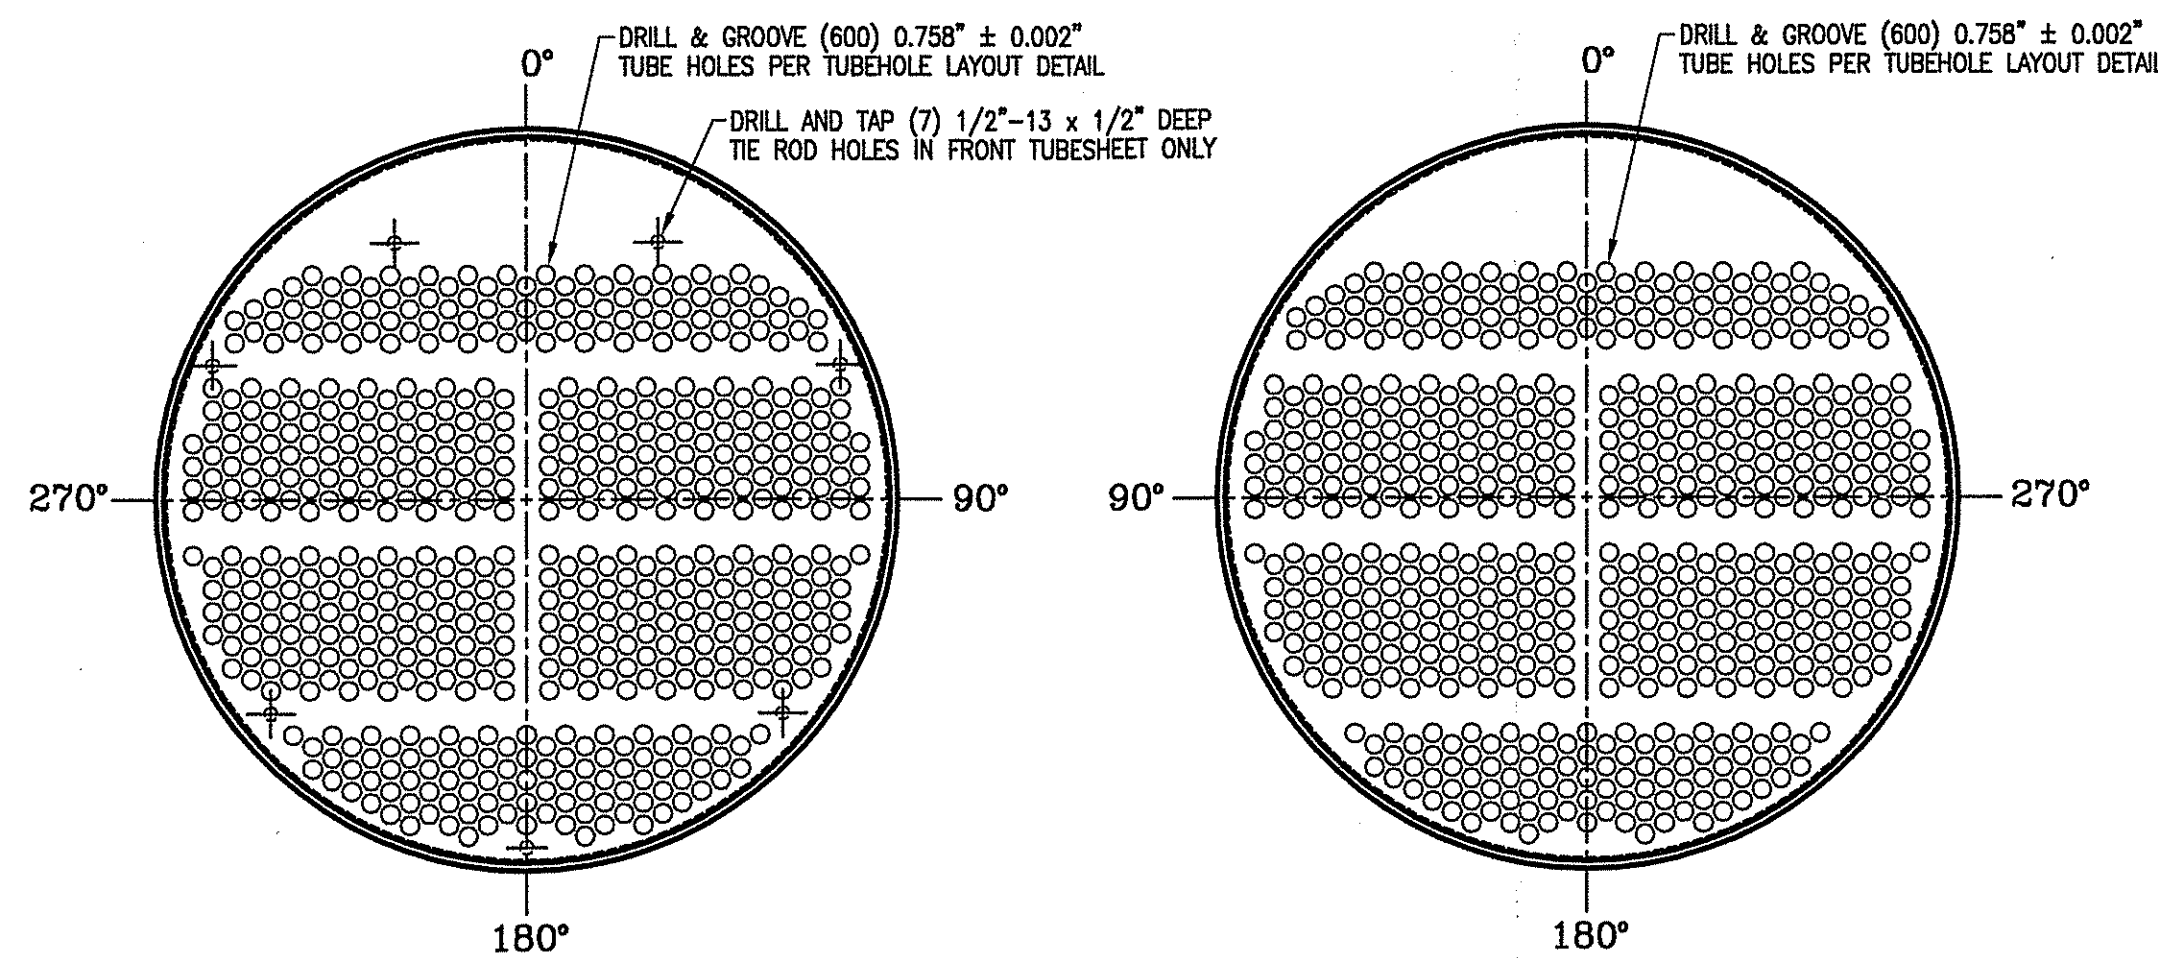

AS-BUILT PRINT
WARD TANK AND
HEAT EXCHANGER CORP.
By: B. HUFFMAN
Date: 12/16/03

		WARD TANK AND HEAT EXCHANGER CORP 6670 E. HARRIS BLVD. CHARLOTTE, NC 28215	
CUSTOMER KOSA WILMINGTON, NC		PURCHASE ORDER NUMBER 4800136994	
TITLE #30-240 NJN HEAT EXCHANGER			
EQUIPMENT NO. E-4511-2R2		SCALE AS NOTED	NO REQ'D 1
APPROVED BY HUFFMAN	DATE 8/13/2003	DRAWING NUMBER 2003-HC-5292	REV. NO. 2 SHEET 3 OF 3

2	12/16/03	AS BUILT	BH
1	8/19/03	RELEASED FOR FABRICATION	BH
0	8/13/03	FOR CUSTOMER APPROVAL	BH
REV. NO.	DATE	DESCRIPTION	BY
THIS DRAWING IS THE PROPERTY OF WARD TANK AND HEAT EXCHANGER CORP. AND IS ONLY TO BE USED IN REFERENCE TO WORK PROPOSED OR CONTRACTED BY THIS COMPANY. IT MUST NOT BE REPRODUCED OR SUBMITTED TO OUTSIDE PARTIES WITHOUT THE WRITTEN PERMISSION OF WARD TANK AND HEAT EXCHANGER CORP.			