

E-6220-7

Manufactured and certified by FABSCO, INC., 186 NORTH LANSING, TULSA, OKLAHOMA

(name and address of manufacturer)

2. Manufactured for Fluor Daniel, Inc., Greenville, SC

(name and address of purchaser)

#104556

3. Location of installation Cape Industries, Wilmington, NC

(name and address)

4. Type: Vertical 90-5084-5 -- 90-5084-5-1 1982 1990

(horiz. or vert., tank)

(mfr's serial no.)

(CRN)

(drawing no.)

(Nat'l. Bd. no.)

(year built)

5. The chemical and physical properties of all parts meet the requirements of material specifications of the ASME BOILER AND PRESSURE VESSEL CODE. The design, construction and workmanship conform to ASME Code, Section VIII, Division 1: 1989

(year)

(addenda (Date))

(Code Case no.)

(special service per UG-120(d))

Items 6-11 inclusive to be completed for single wall vessels; jackets of jacketed vessels, or shells of heat exchangers.

6. Shell: SA 516-70 1/2 1/16 4'-9" 6'-6-1/4"

(mat'l. (spec. no., grade))

(nom. thickness (in.))

(corr. allow. (in.))

(dia. ID (ft. & in.))

(length (overall) (ft. & in.))

7. Seams: Dbl. Butt Spot 85 None -- Dbl. Butt Spot 2

(long. (dbl., sngl.))

(RT (spot or full))

(eff. (%))

(HT temp. (°F))

(time)

(girth (dbl., sngl.))

(RT (spot, partial, or full))

(no. of courses)

8. Heads: (a) SA 516-70 (b) SA 516-70

(mat'l. (spec. no., grade))

(mat'l. (spec. no., grade))

	Location (top, bottom, ends)	Minimum Thickness	Corrosion Allowance	Crown Radius	Knuckle Radius	Elliptical Ratio	Conical Apex Angle	Hemispherical Radius	Flat Diameter	Side to Pressure (convex or concave)
(a)	Intergal	7/16"	1/16"		1-1/2"	71" ID	x 57" ID	x 6" Lg.	Flg. & Flued	Concave
(b)	Intergal	7/16"	1/16"		1-1/2"	71" ID	x 57" ID	x 6" Lg.	Flg. & Flued	Concave

If removable, bolts used (describe other fastenings):

(mat'l. spec. no., gr., size, no.)

9. Type of jacket: _____ Proof test: _____

10. Jacket closure: _____ If bar, give dimensions: _____ If bolted, describe or sketch (describe as ogee & weld, bar, etc.)

11. MAWP: 150* at max. temp. 375 Min design metal temp.: -10 at 150 Hydro. ~~xxxxxxx~~ test pressure 225

(psi)

(°F)

(°F)

(psi)

(psi)

Items 12 and 13 to be completed for tube sections.

12. Tubesheets: (2) SA 182-F316 57 2-3/4 0 Welded

(stationary mat'l. (spec. no., gr.))

(dia. (in.) (subject to pressure))

(nom. thickness (in.))

(corr. allow. (in.))

(attachment (welded, bolted))

(floating mat'l. (spec. no., gr.))

(dia. (in.))

(nom. thickness (in.))

(corr. allow. (in.))

(attachment)

13. Tubes: SA 249-TP316 1 16 BWG 1794 Straight

(mat'l. (spec. no., gr.))

(OD (in.))

(nom. thickness (in. or gauge))

(no.)

(type (straight or U))

Items 14-17 inclusive to be completed for inner chambers of jacketed vessels or channels of heat exchangers.

14. Shell: SA 240-316 3/8 0 4'-9-1/2" 1'-8-1/8"

(mat'l. (spec. no., gr.))

(nom. thickness (in.))

(corr. allow. (in.))

(dia. ID (ft. & in.))

(length (overall) (ft. & in.))

15. Seams: Dbl. Butt Spot 85 None -- Dbl. Butt Spot 2

(long (dbl., sngl.))

(RT (spot or full))

(eff. (%))

(HT temp. (°F))

(time)

(girth (dbl., sngl.))

(RT (spot, partial, or full))

(no. of courses)

16. Heads: (a) SA 240-316 (b) SA 240-316

(mat'l. (spec. no., grade))

(mat'l. (spec. no., grade))

	Location (top, bottom, ends)	Minimum Thickness	Corrosion Allowance	Crown Radius	Knuckle Radius	Elliptical Ratio	Conical Apex Angle	Hemispherical Radius	Flat Diameter	Side to Pressure (convex or concave)
(a)	Top	3/8"	0	23 1/2" ID	x 57 1/2" ID	x 30 1/2" Lg.	Conc. Cone			Concave
(b)	Bottom	3/8"	0	15 1/2" ID	x 57 1/2" ID	x 37-3/4" Lg.	Conc. Cone			Concave

If removable, bolts used (describe other fastenings): 128 - 3/4" SA 193-B7 Studs w/ SA 194-2H Hex Nuts

(mat'l. spec. no., gr., size, no.)

17. MAWP: 100 ** at max. temp. 400 Min design metal temp.: -20 at 100 Hydro. ~~xxxxxxx~~ test pressure 150

(psi)


(°F)

(°F)

(psi)

(psi)

#104556

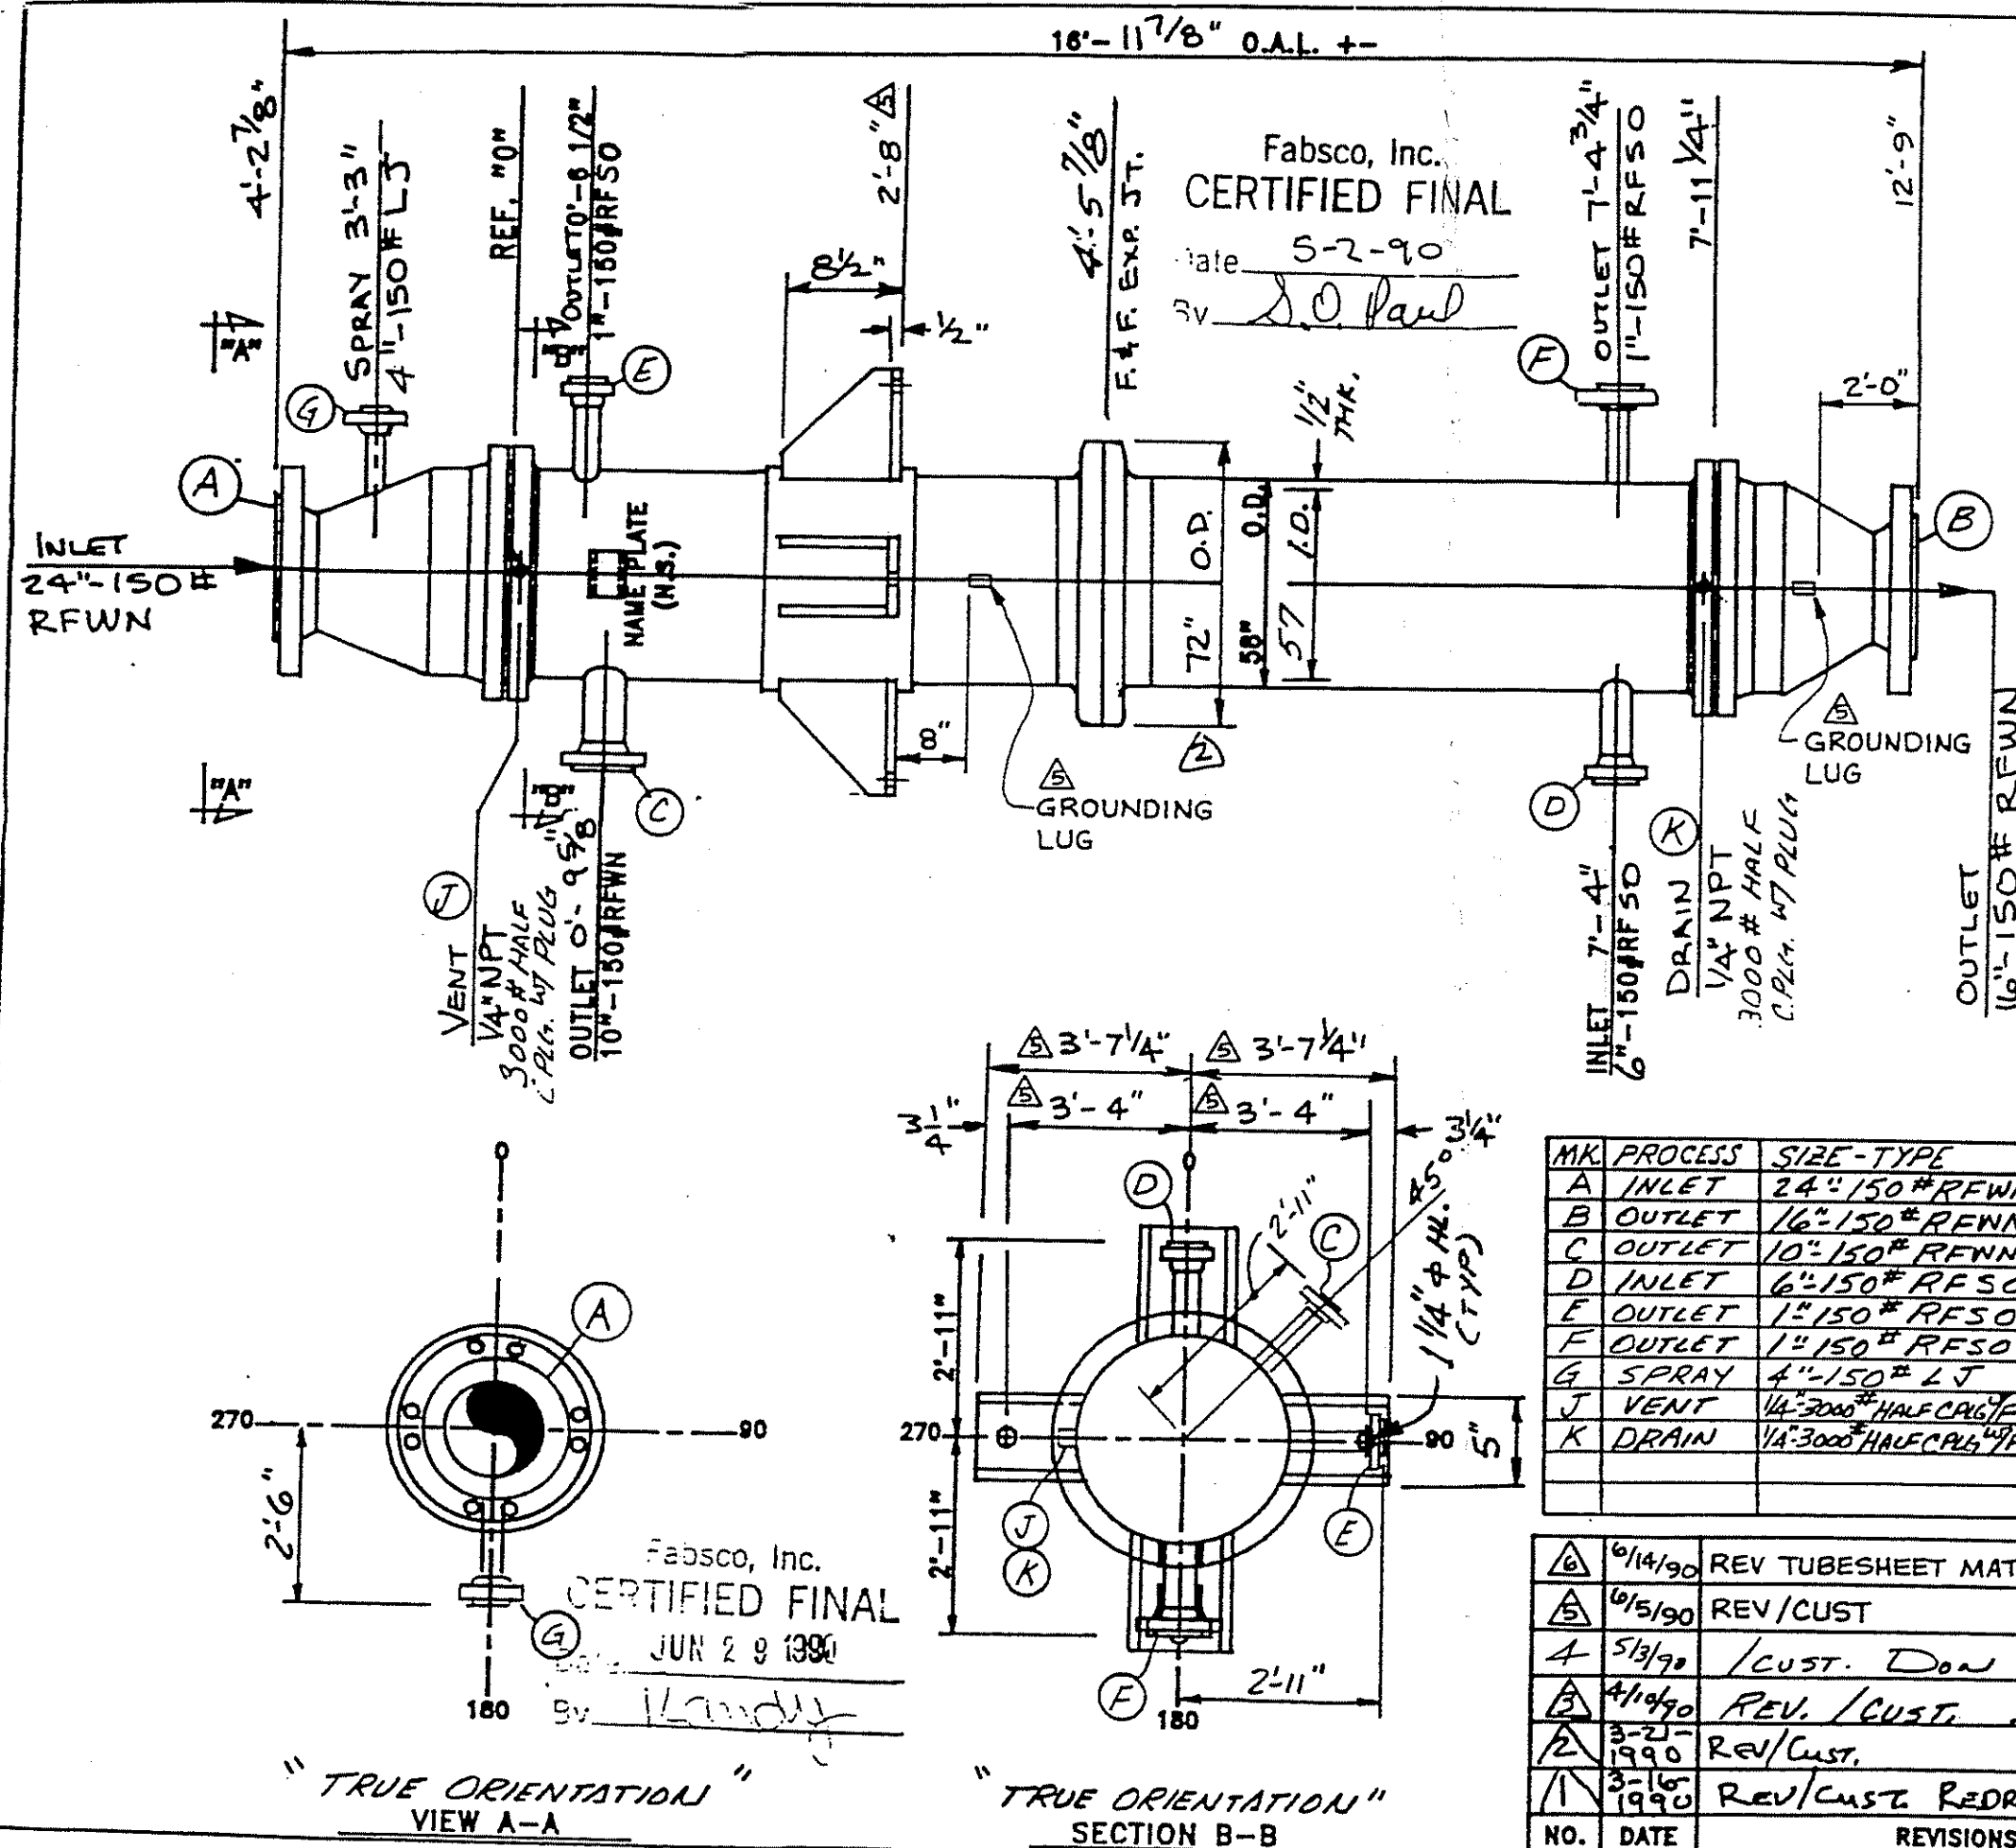

DESIGN DATA	SHELL	TUB
DESIGN PRESSURE P.S.I.G.	150 /EV	100 /F
TEST PRESSURE P.S.I.G.	225	150
DESIGN TEMPERATURE DEG. F. /MDMT	375 /-10	400 /-
CORROSION ALLOWANCE	.0625"	.0000"
NUMBER OF PASSES	1	1
RADIOGRAPHIC EXAMINATION	SPOT	SPOT
HEAT TREAT REQUIRED	NO	NO

ESTIMATED WEIGHTS, LBS.		
DRY: 19600	BUNDLE: 0	WET: 28500

SPECIFICATIONS
A.S.M.E. SEC.V111 DIV.1 1989 EDITN. STAMP YES
TEMA CLASS B
NATIONAL BOARD REGISTRATION REQUIRED
5DE-451G INSUL. CLIPS

MATERIAL		
CHANNEL:	SA-240-316	
SHELL:	SA-516-70	
TUBESHEETS:	SA-182-F316	
BAFFLES:	SA-516-70	
TUBES:	SA-249TP316	
(1794) 1"	O.D.X .065" Avg.	X 8'-0" L
TUBE PITCH 1 1/4"		SURFACE 3542 SQ.F

GENERAL NOTES
ALL BOLT HOLES TO STRADDLE NATURAL CENTER LINES.
STRENGTH WELD & ROLL TUBES
2 1/2" INSUL BY OTHERS

JUN 18 1990
FLUOR DANIEL
ENGINEERING

GASKETS: .175" THK. S.S. FLEXITALLIC w/ 1/8" C.G.
1 SET OF SPARE GASKETS REQUIRED.
PAINT: SEE JOB NOTE SHEET.

CUST: FLUOR DANIEL INC.

P.O. NO.: 0027-D1-50001
ITEM NO.: E-6220-7
SERVICE: VACUUM STRIPPER CONDENSER
SHIP TO:

MK	PROCESS	SIZE-TYPE
A	INLET	24"-150# RFWN
B	OUTLET	16"-150# RFWN
C	OUTLET	10"-150# RFWN
D	INLET	6"-150# RFWN
E	OUTLET	1"-150# RFWN
F	OUTLET	1"-150# RFWN
G	SPRAY	4"-150# LTJ
J	VENT	1/4"-3000# HALF C.P.L.H. W/ PLUG
K	DRAIN	1/4"-3000# HALF C.P.L.H. W/ PLUG

NO.	DATE	REVISIONS
6	6/14/90	REV TUBESHEET MATL CWR/MLP
5	6/5/90	REV/CUST CWR/MLP
4	5/3/90	/CUST. DON
3	4/14/90	REV./CUST. DON
2	3-2-1990	REV/CUST.
1	3-16-1990	REV/CUST. REDRAWN


ASSEMBLY AND SPECIFICATIONS FOR
ONE 57-96 BEM

DWN. BY
GDP
DATE
2-24-90
CKD. BY
D.G.

DWG. NO.
00-5084-5-1


FABSCO, INC.
SAPULPA, OKLAHOMA

#104556

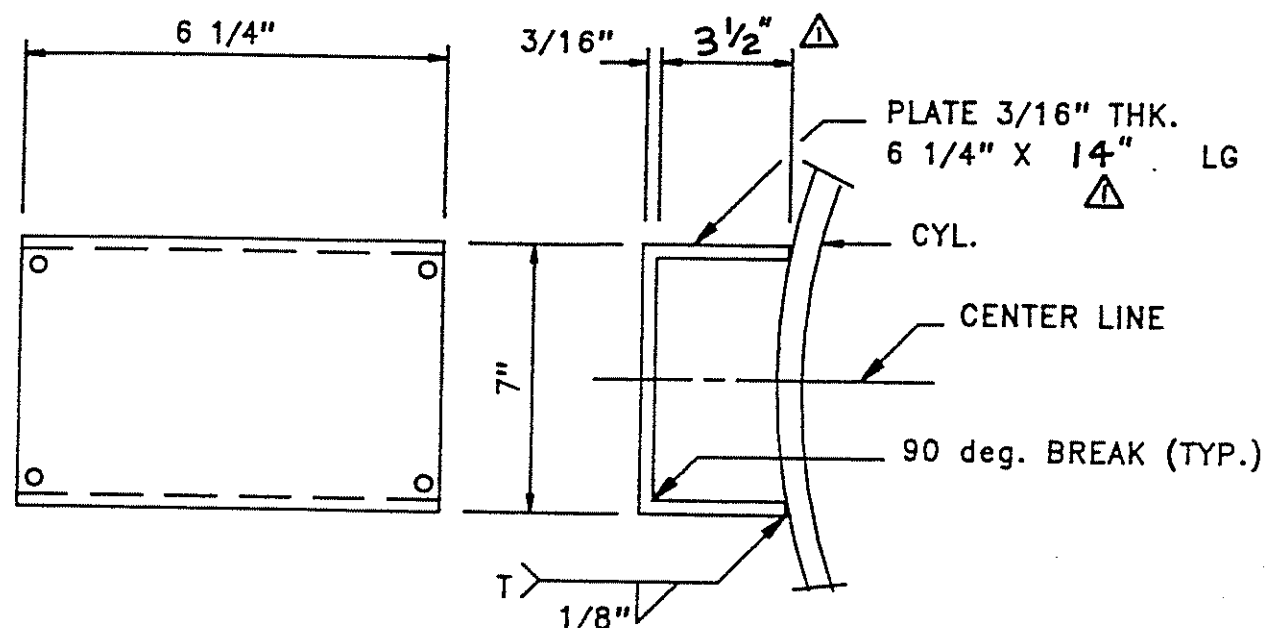


(ONE) REQ'D.

NAME PLATE BRACKET DETAIL

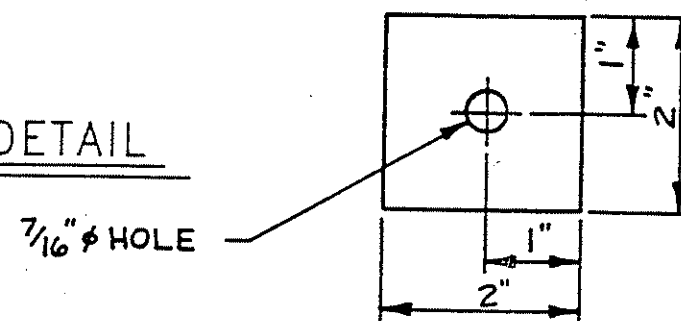

Δ GROUNDING LUG

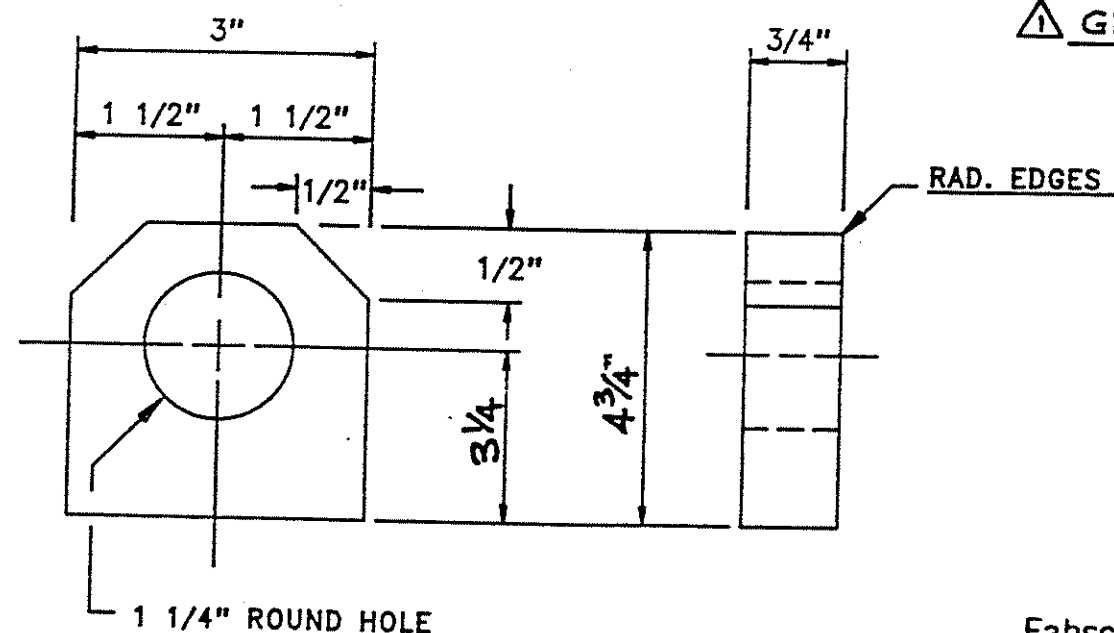

NO. REQUIRED: (2)

LIFTING LUG DETAIL

Fabscos, Inc.
CERTIFIED FINAL
Date JUN 29 1990
By *[Signature]*

MATERIAL: 18-8 STN. STL.(16 GA)

NATL. BD. NO. *	
CERTIFIED BY FABSCO INC. SAPULPA, OKLAHOMA	
W	MAWP
RT-3	SHELL SIDE 150 ⊗
	MDMT
	SHELL SIDE -10
	MAWP
	TUBE SIDE 100 ⊗
	MDMT
	TUBE SIDE -20
SERIAL NO.	YEAR BUILT
90-5084-5	1990
P.O. NO.	HEATING SURFACE
0027-D1-50001	3542 SQ.FT.
TEST PRESS.	SHELL SIDE
225	PSI
ITEM NO.	TUBE SIDE
E-6220-7	150 PSI
SIZE	TEMA TYPE
57-96	B E M
SERVICE VACUUM STRIPPER CONDENSER	
⊗ IS PSI EXTERNAL PRESS.	

* TO BE ASSIGNED AT TIME OF SHIPMENT

RECEIVED

JUN 18 1990

FLUOR DANIEL
ENGINEERING

JUL 20 1990
PO # 0027-D1-50001
ITEM # E-6220-7

NAME PL., BRKT. & LIFT LUGS				
DWN. BY SDG	FABSCO, INC. SAPULPA, OKLAHOMA			
DATE 4-29-90				
CKD. BY DA	DWG. NO. 90-5084-5-11			
NO.	DATE	REVISIONS	REV/CUST	CWR/AM
Δ	6/5/90			

7'-11 1/2" FACE TO FACE OF TUBESHEETS

2 3/4"

15 7/8"

5 SPACES AT 12 3/8" = 5'-1 7/8"

12 1/4"

2 3/4"

1 1/2" (TYP)

1

2

3

4

A

B

23 B

19

$\frac{1}{16}'' \begin{matrix} -0 \\ +\frac{1}{16}'' \end{matrix}$

ELEVATION VIEW


 $7/16" \begin{matrix} -1/16" \\ +0 \end{matrix}$
 TUBE PROJECTION

RECEIVED
JUN 18 1990
10001
FLOR DANIEL
ENGINEERING

A technical drawing of a bolt and nut assembly. The bolt is shown on the left, and the nut is on the right. The bolt has a hexagonal head and a threaded shank. The nut is a hexagonal nut with a threaded bore. Dimensions are indicated: 'A' is the total length of the assembly, '1"' is the length of the bolt head, and '3"' is the length of the nut.

1/2' O.D. TIE RODS (i

	REQ'D.	"A"
①	A 7.	6'-8 5/16
②	B 3.	5'-7 15/16
	C	
	D	

A diagram of a rectangular plate with a central hole. A dimension line above the plate indicates the width, labeled 'B'.

3/4" O.D. SPACER TUBING

	REQ'D.	"B"
①	7.	15 5/8"
②	3.	28"
③	20.	11 7/8"
④	12.	24 1/4"
⑤		
⑥		
⑦		

JUL 20 1990

1) SEE DWG. NO. 90-5084-5-8 FOR SECTION AND VIEW DETAILS.
2) TUBES ARE STRENGTH & ROLLED TO TUBESHEET.

P.O.# 0027-D1-50001
ITEM# E-6220-7

Fabsco, Inc.
CERTIFIED FINAL

Date JUN 29 1990

By Ward

⚠	6/5/90	REV / CUST.
		CWR / M

DWN BY

S.D.G.

DATE

4-24-90

OKD BY

URGENT

BUNDLE DETAILS



FABSCO, INC.
SAPULPA, OKLAHOMA

JUL 20 1990

RE

TIE RODS.
1/2" O.D.
10 REQD. TOTAL

#104556

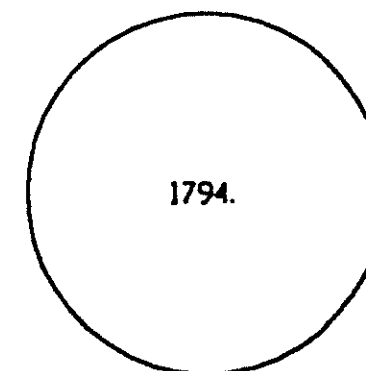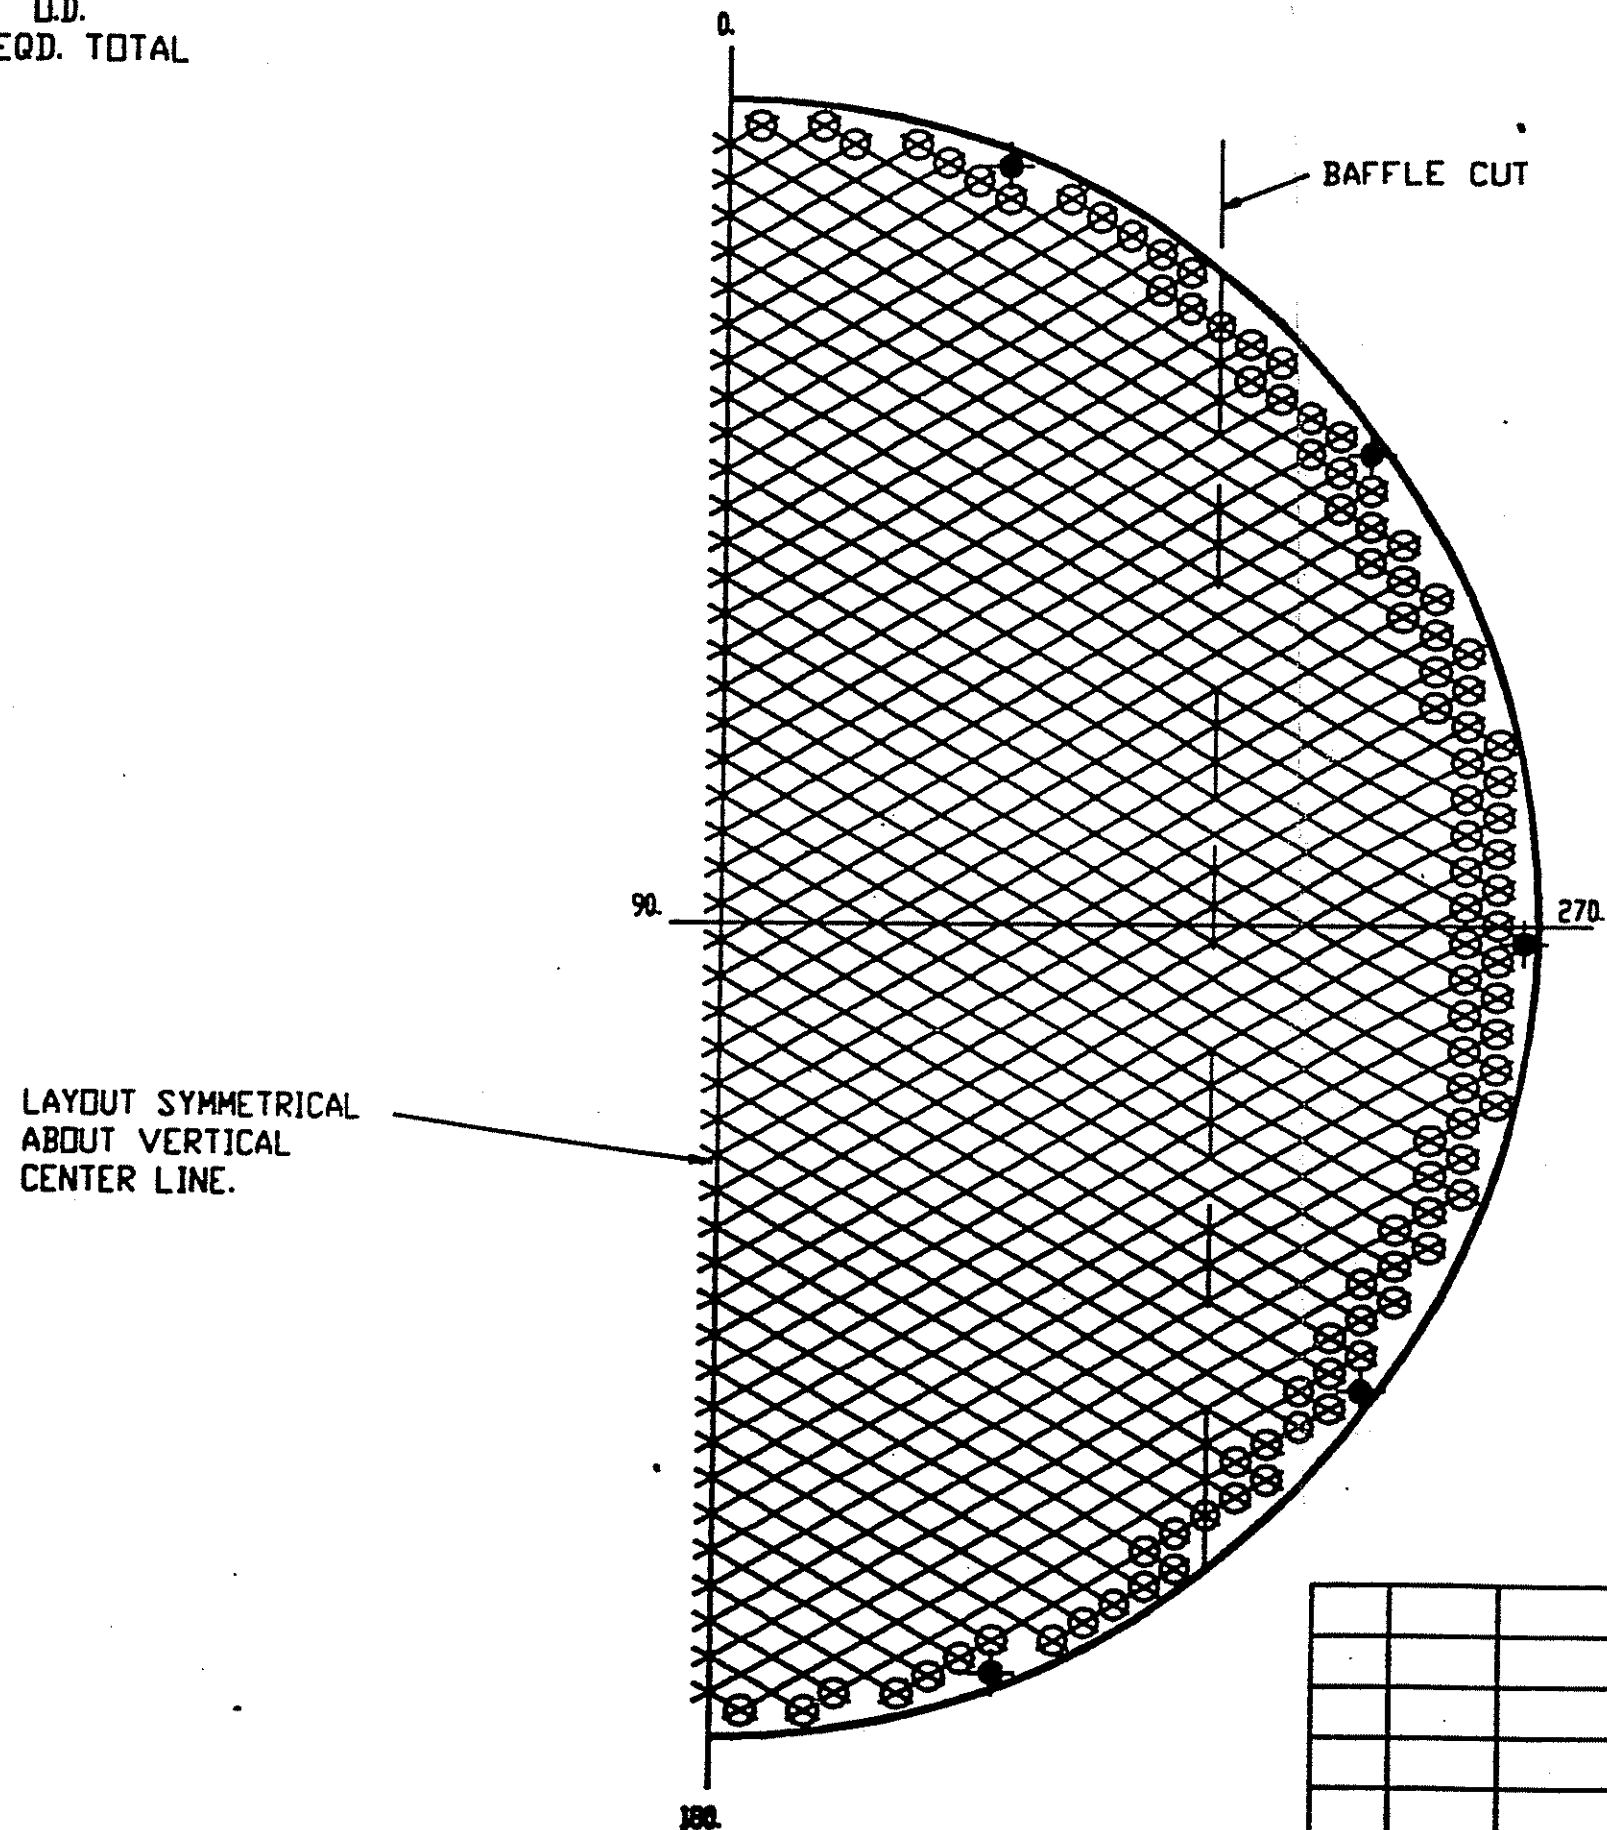

TUBE DISTRIBUTION

RECEIVED

JUN 18 1990

ELMER DANIEL
ENGINEERING

NOTES:

- 1) DRILL AND REAM TUBE HOLES IN TUBESHEETS TO 1.0100" $\pm$.002" DIA. FOR 1794 - 1" O.D. TUBES.
- 2) TUBE PITCH = 1 1/4" ROT. TRIANGLE.
- 3) NUMBER OF PASSES = 1
- 4) SEE DRAWING 90-5084-5-5 FOR TUBE GROOVING DETAILS.
- 5) BAFFLE O.D. = 56 3/4"
- 6) O.T.L. = 56 9/16"

RECEIVED
JUL 20 1990
Fabsco, Inc.

P.O.# 0027-D1-50001
ITEM# E-6220-7

CERTIFIED FINAL

Date JUN 29 1990
By Randy

VIEW LOOKING AT SHELL SIDE OF NO. 19 TUBESHEET

			TUBE LAYOUT		
			DWN. BY S.D.G.		FABSCD, INC. SAPULPA, OKLAHOMA
			DATE 4-24-90		
			CKD. BY D.G.		
NO.	DATE	REVISIONS	DVGND.	90-5084-5-6	REV. 0



FABSCO, INC.
SAPULPA, OKLAHOMA

90-5084-5-6