

105751

Energy Exchanger Company

HEAT EXCHANGER SPECIFICATION SHEET




P.O. No.: 56603-P-12-04

REV. 0 AS PURCHASED

REV	LN #		
0	1		
0	2		
1	3	Customer	SHAW STONE & WEBSTER (GIANT)
1	4	Address	HOUSTON, TX
	5	Plant Location	GRAFTON, VA
	6	Service of Unit	REACTOR FEED/EFFLUENT EXCHANGER
	7	Size	59-264
	8	Type	AFU
	9	Horizontal	Connected In
	10	Surf./Unit	Gross / ☒ Eff
	11	13140. ft ² ; Shells/Unit	2
	12	Surf./Shell	Gross / ☒ Eff
	13	6570. ft ²	
	14	Job No.:	X-7262 "AS BUILT"
	15	Rev.:	1
	16	Date:	3/13/07
	17	File:	06-6102
	18	Item:	E-641 A/B
	19	Parallel	2
	20	Series	
	21	PERFORMANCE OF ONE UNIT	
	22	Fluid Allocation	Shell Side
	23	Fluid Name	REACTOR EFFLUENT
	24	Fluid Quantity, Total	lb/hr
	25	Vapor (In/Out)	
	26	Liquid	
	27	Steam	
	28	Water	
	29	Noncondensable	
	30	Temperature (In/Out)	°F
	31	Density (Vapor/Liquid)	Lb/Ft ³
	32	Viscosity	cP
	33	Molecular Weight	
	34	Molecular Weight, Noncondensable	
	35	Specific Heat	Btu/lb-F
	36	Thermal Conductivity	Btu/hr-ft-F
	37	Latent Heat	Btu/lb
	38	Inlet Pressure	psia
	39	Velocity	ft/sec
	40	Pressure Drop, Allow./Calc.	psi
	41	Fouling Resistance (Min.)	Hr-Ft-°F/Btu
	42	Heat Exchanged	Btu/hr; M.T.D. (Corrected)
	43	Transfer Rate, Service	Btu/hr-ft ² -F; Clean
	44		Btu/hr-ft ² -F
	45	CONSTRUCTION OF ONE SHELL	
	46	Design/Test Pressure	psig
	47	Design Temperature (Max/Min)	°F
	48	No. Passes Per Shell	2
	49	Corrosion Allowance	inch
	50	Connections	In
	51	Size & Rating	Intermediate
	52	Shell Side	Tube Side
	53	Sketch (Bundle/Nozzle Orientation)	
	54	Tube No.	785 U'S
	55	OD	.75 in; Thk.
	56	Min	✓
	57	Avg	0.083 in; Length
	58	22. ft; Pitch	1 in 90°
	59	Tube Type	PLAIN
	60	Material	SA-179
	61	Shell	SA-516-70
	62	ID	59 in; Shell Cover
	63	SA-350-LF2	✓
	64	Integ.	Remov.
	65	Channel or Bonnet	SA-516-70 (N)
	66	Channel Cover	SA-516-70 (N)
	67	Integ.	✓
	68	Remov.	
	69	Tubesheet-Stationary	SA-350-LF2
	70	Tubesheet - Floating	
	71	Floating Head Cover	Impingement Protection
	72	Circular Pla ON BUNDLE	
	73	Baffles-Cross	4 - SA-516-70
	74	Type	V-N.T.I.W.
	75	% Cut (✓) Dia. Area	20.6
	76	Spacing c/c	50.7
	77	Inlet	in
	78	Baffles-Long	SA-516-70
	79	Seal Type	LAMIFLEX
	80	Supports - Tube	SA-516-70
	81	U-Bend	YES
	82	Type	FULL
	83	Bypass Seal Arrangement	SA-516-70
	84	Tube-Tubesheet Joint	EXPANDED AND WELDED
	85	Expansion Joint	Type
	86	pv ² - Inlet Nozzle	Bundle Entrance
	87	Bundle Exit	
	88	Gaskets - Shell Side	S.S. D.J.F.G.F
	89	Tube Side	S.S. D.J.F.G.F
	90	- Floating Head	
	91	Code Requirements	ASME SECTION VIII, DIV. 1
	92	CODE STAMP	TEMA Class
	93	Weight/Shell	76,700 lb. EACH
	94	Filled With Water	109,250 lb. EACH
	95	Bundle	33,250 lb. EACH
	96	REMARKS	
	97	(1) SHELLS A & B	
	98	(2) TWO INTERMEDIATE SUPPORTS PER BAFFLE SPACE (4) FOUR ROW PARTIAL SUPPORTS AT SHELL NOZZLE CENTERLINES	
	99	(3) PROVIDE (2) 1-1/2" X 60# RFLWN ON EACH OF INLET AND OUTLET (TUBESIDE AND SHELLSIDE) NOZZLES OF EACH INDIVIDUAL SHELL (EXCHANGER).	
	100	(4) TIE ROD SPACER SLEEVES SHALL BE SCH. 40 PIPE THICKNESS.	

#105751

Energy Exchanger Company

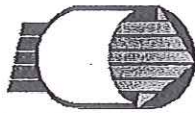


HEAT EXCHANGER SPECIFICATION SHEET

OVERALL FOR 6 SHELLS


P.O. No.: 56603-P-12-04

REV. 0 AS PURCHASED

REV	L N #		
0	1		
0	2		
1	3	Customer	SHAW STONE & WEBSTER (GIANT)
1	4	Address	HOUSTON, TX
	5	Plant Location	GRAFTON, VA
	6	Service of Unit	REACTOR FEED/EFFLUENT EXCHANGER
	7	Size	59-264 Type AFU Horizontal
	8	Surf./Unit	Gross / ☒ Eff 38872. ft ² ; Shells/Unit 6
	9	PERFORMANCE OF ONE UNIT	
	10	Fluid Allocation	Shell Side Tube Side
	11	Fluid Name	REACTOR EFFLUENT REACTOR FEED
	12	Fluid Quantity, Total	lb/hr 319572 317508
	13	Vapor (In/Out)	319572 25693 4682 317508
	14	Liquid	293879 312826
	15	Steam	
	16	Water	
	17	Noncondensable	
	18	Temperature (In/Out)	°F 799. 235.0 108. 699.
	19	Density (Vapor/Liquid)	Lb/Ft ³ 2.0700 0.8700 39.02 0.3300 43.45 2.7600
	20	Viscosity	cP 0.0220 0.0150 0.199 0.0090 0.353 0.0200
	21	Molecular Weight	
	22	Molecular Weight, Noncondensable	
	23	Specific Heat	Btu/lb-F 0.7490 0.7620 0.599 1.8410 0.5050 0.7170
	24	Thermal Conductivity	Btu/hr-ft-F 0.0380 0.0430 0.056 0.0790 0.0680 0.0340
	25	Latent Heat	Btu/lb
	26	Inlet Pressure	psia 409.7 498.7
	27	Velocity	ft/sec 9.68
	28	Pressure Drop, Allow./Calc.	psi 25.00 / 26.00 25.00 / 13.00
	29	Fouling Resistance (Min.)	Hr-Ft-°F/Btu 0.002 0.005
	30	Heat Exchanged	148230000 Btu/hr; M.T.D. (Corrected) 80.73 °F
	31	Transfer Rate, Service	47.23 Btu/hr-ft ² -F; Clean Btu/hr-ft ² -F
	32	CONSTRUCTION OF ONE SHELL	
	33	Shell Side Tube Side	Sketch (Bundle/Nozzle Orientation)
	34	Design/Test Pressure	psig
	35	Design Temperature (Max/Min)	°F
	36	No. Passes Per Shell	
	37	Corrosion Allowance	inch
	38	Connections	In
	39	Size & Rating	Out
	40	Rating	Intermediate
	41	Tube No.	OD in; Thk. Min Avg in; Length ft; Pitch in
	42	Tube Type	Material
	43	Shell	ID OD in Shell Cover Integ. Remov.
	44	Channel or Bonnet	Channel Cover Integ. Remov.
	45	Tubesheet-Stationary	Tubesheet - Floating
	46	Floating Head Cover	Impingement Protection
	47	Baffles-Cross	Type % Cut (Dia. Area) Spacing c/c Inlet in
	48	Baffles-Long	Seal Type
	49	Supports - Tube	U-Bend Type
	50	Bypass Seal Arrangement	Tube-Tubesheet Joint
	51	Expansion Joint	Type
	52	pv ² - Inlet Nozzle	Bundle Entrance Bundle Exit
	53	Gaskets - Shell Side	Tube Side
	54	- Floating Head	
	55	Code Requirements	TEMA Class
	56	Weight/Shell	Filled With Water Bundle
	57	REMARKS	
	58	(1) OVERALL PERFORMANCE SHEET FOR SIX EXCHANGERS IN SERIES. SHELLS "E" & "F" HAVE 752U'S TO ALLOW ROOM FOR DERESONATING BAFFLES.	
	59	PLACE DERESONATING BAFFLES IN ALL BAFFLE SPACES BUT INLET AND OUTLET JUST ABOVE AND BELOW THE CENTER OF EACH HALF.	
	60	(2) DESIGN SHELLSIDE AND TUBESIDE TO BE HYDROGEN SERVICE.	
	61		
	62		
	63		
	64		
	65		

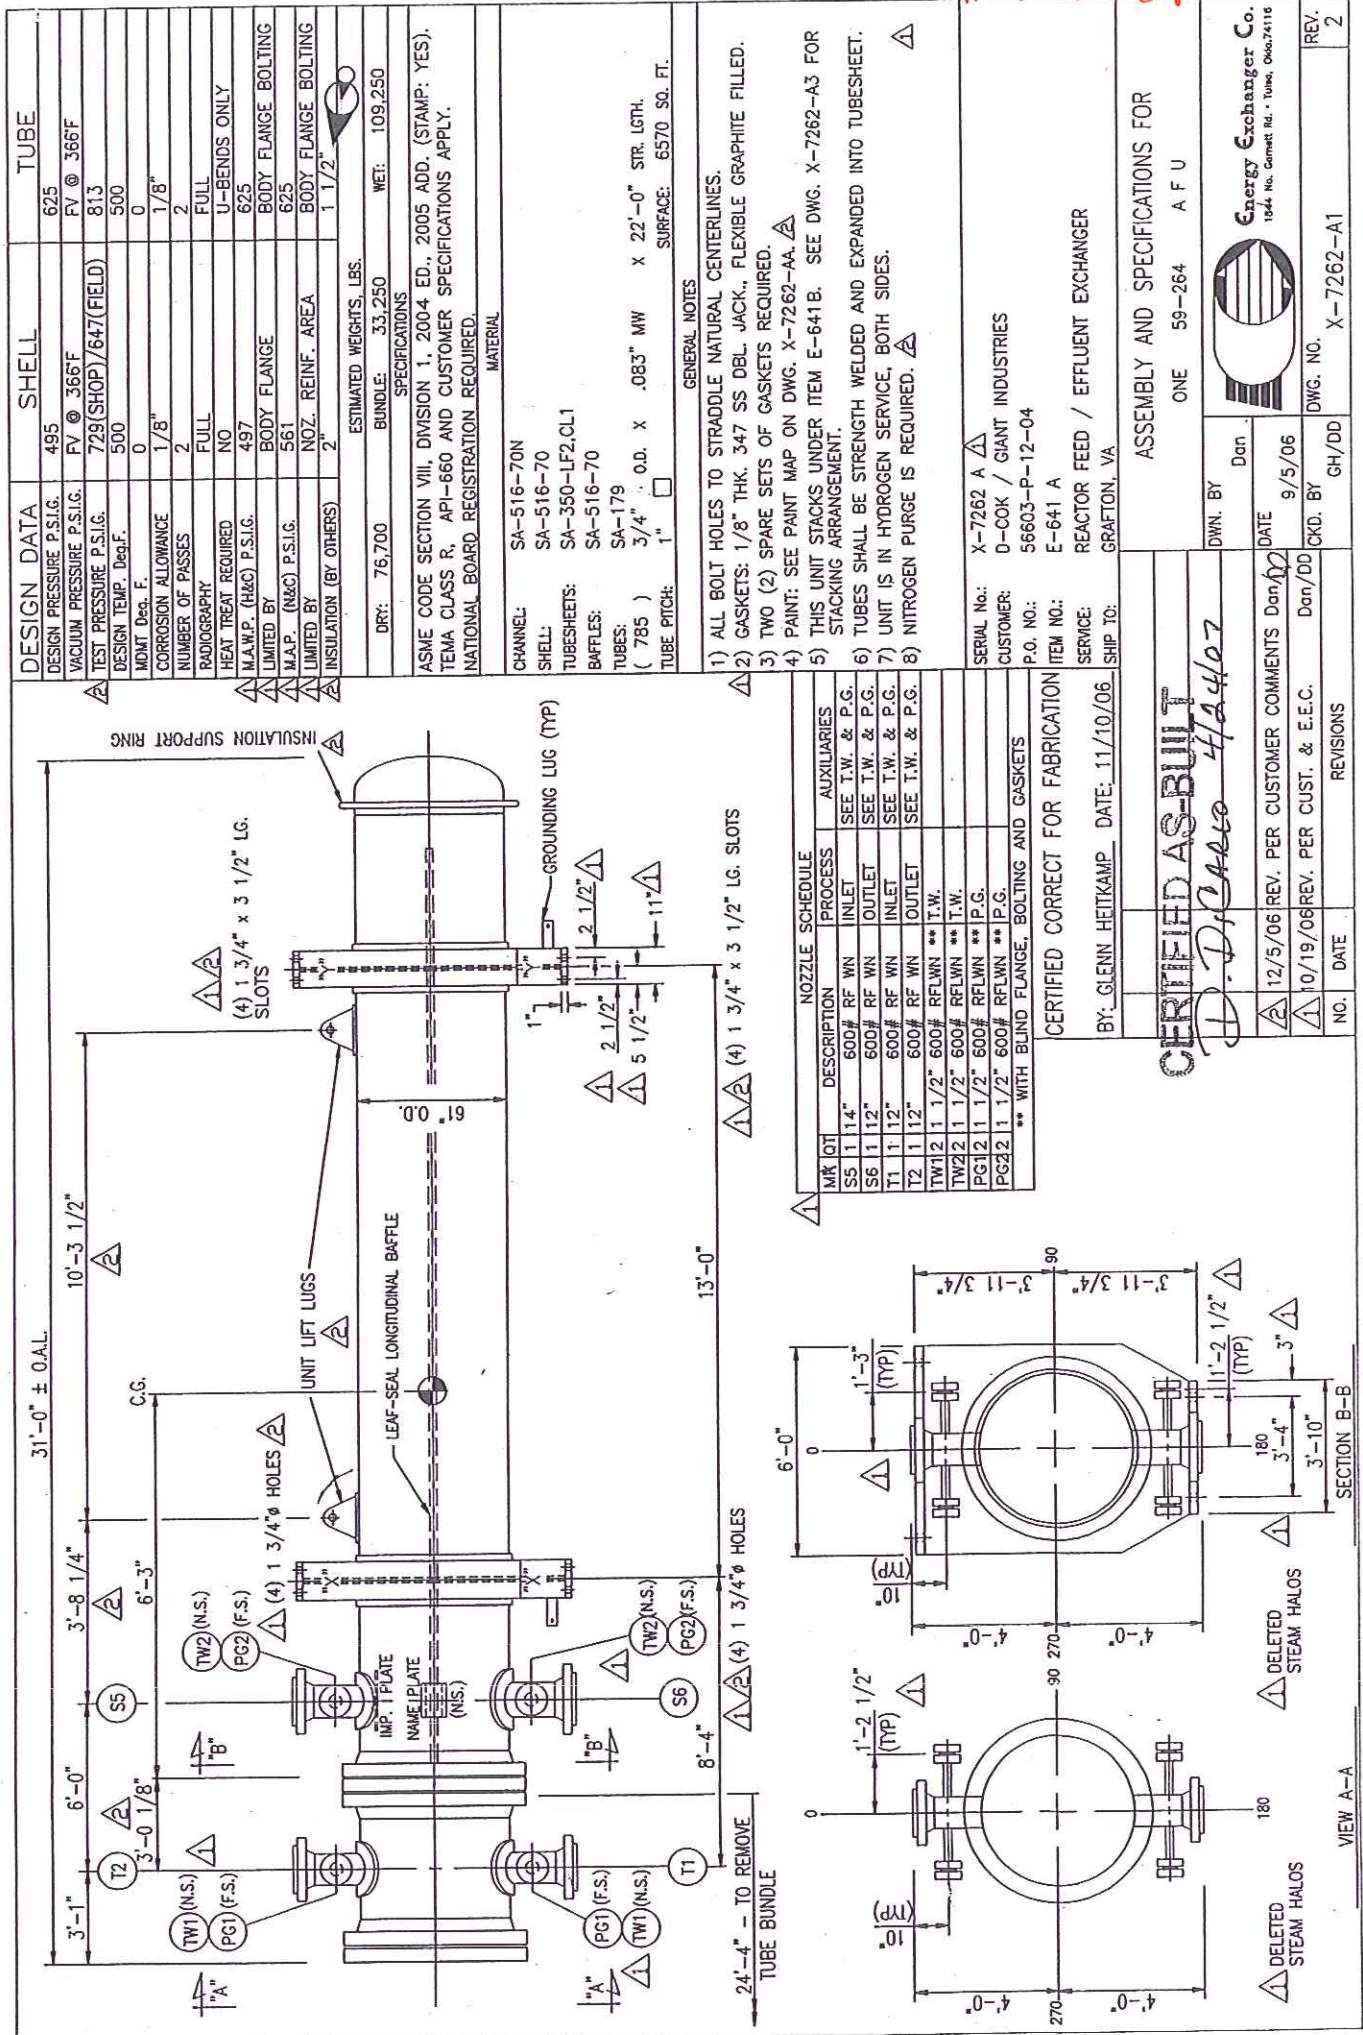

105731

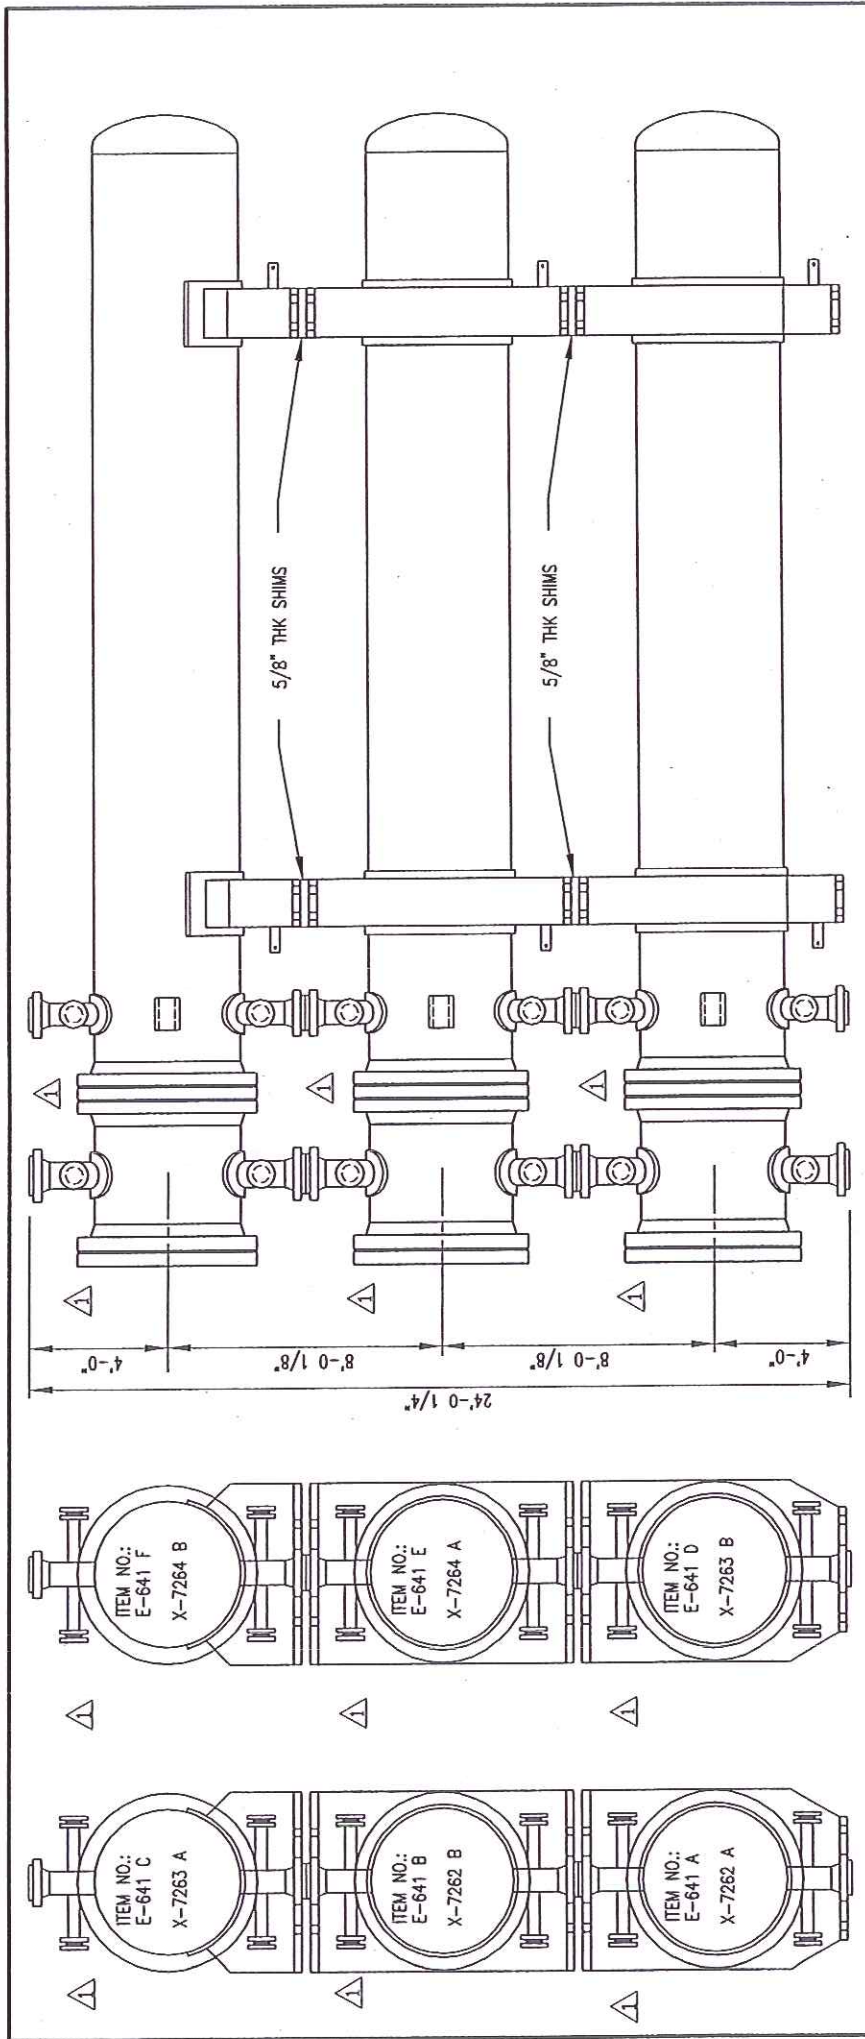

CERTIFIED AS-BUILT
D.D. Carlo 4/24/07

NOTES:

- 1) SHIM, GASKETS AND BOLTS FOR STACKING SHALL BE FURNISHED BY ENERGY.
- 2) HYDROTEST IN THE STACKED POSITION.

SERIAL NO.: X-7262-A/B
CUSTOMER: D-COK / GIANT INDUSTRIES
P. O. NO.: 56603-P-12-04
ITEM NO.: E-641 A/B/C/D/E/F
SERVICE: REACTOR FEED/EFFLUENT EXCHANGER
SHIP TO: GRAFTON, VA



DWN. BY Don		DATE 10/19/06	CKD. BY GH	DWG. NO. X-7262-A3	REV. 2
REV. PER CUSTOMER COMMENTS Don/DD		REV. PER CUSTOMER COMMENTS Don/DD			
NO.		DATE			
REVISONS					

STACKING ARRANGEMENT


Stone & Webster, Inc.	PROJECT TITLE: GIANT S ZORB
SSN: 120653-P-12-04 (1110-01)	JOB No: 120653
EQUIPMENT No.: 56603-P-12-04 (1110-01)	ISSUE 1
☐ FOR INFORMATION ☐ ACCEPTED FOR CIVIL AND PIPING IFC	
☐ ACCEPTED ☐ ACCEPTED AS CERTIFIED	
☐ ACCEPTED AS NOTED ☐ REVISE AND RESUBMIT	
SIGNED _____	
DATE _____	
THE ACCEPTANCE OF THIS DATA BY SHAW STONE & WEBSTER DOES NOT RELIEVE THE CONTRACTOR OR SUPPLIER FROM THE OBLIGATIONS IMPOSED BY THE PURCHASER ORDER OR CONTRACT.	



Energy Exchanger Co.
1044 No. Garrett Rd., Tulsa, Okla. 74118

#105751

PROJECT TITLE: GRANT S ZONE	
JOB No. 10653	
ISSUE 1	
SSV 10653-P-12-04 (1110-01)	
EQUIPMENT No. 56603-P-12-04 (1110-01)	
☐ FOR INFORMATION	☐ ACCEPTED FOR CIVIL AND PIPING IFC
☐ ACCEPTED	☐ ACCEPTED AS CERTIFIED
☐ REVISED AND RESUBMIT	☐ ACCEPTED AS NOTED
SIGNED _____	
DATE _____	
THE ACCEPTANCE OF THIS DATA BY SHAW STONE & WEBSTER DOES NOT RELIEVE THE CONTRACTOR OR SUPPLIER FROM THE OBLIGATIONS IMPOSED BY THE PURCHASER ORDER OR CONTRACT.	

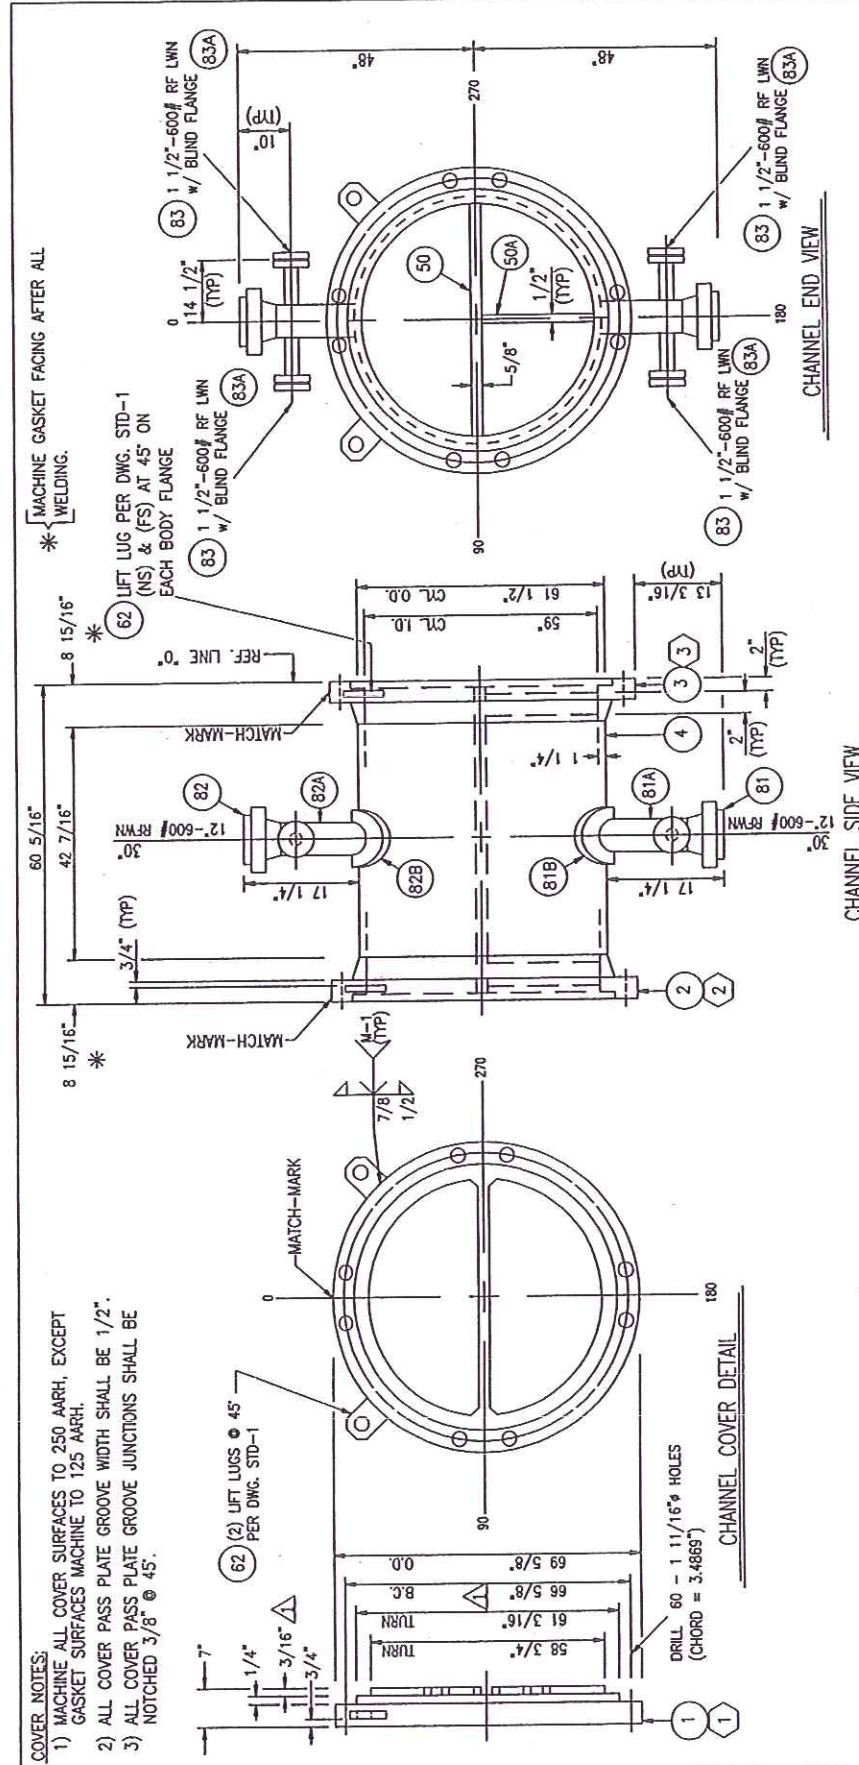

SERIAL NO.: X-7262-A/B
CUSTOMER: D-COK / GIANT INDUSTRIES
P. O. NO.: 56603-P-12-04
ITEM NO.: E-641 A/B
SERVICE: REACTOR FEED/EFFLUENT EXCHANGER
SHIP TO: GRAFTON, VA

CERTIFIED AS-BUILT
D.D. CARLO 4/24/07

CHANNEL DETAILS	
DWN. BY Don	REV. 1
DATE 10/19/06	DWG. NO. X-7262-B
CKD. BY DCarlo	
NO.	DATE
REVISIONS	
12/6/06 REV. PER E.E.C. DCarlo	

NOTES:

- 1) FOR WELD & BEVEL DETAILS, SEE DWG STD-1.
- 2) FOR BODY FLANGE DETAILS, SEE DWG. X-7262-M.
- 3) FOR FABRICATION NOTES, SEE DWG. X-7262-N.
- 4) MILL PASS PLATES TO 3/8". BOTH ENDS.

REQUIRED AS SHOWN FOR ONE UNIT;
TWO-UNITS REQUIRED.



Energy Exchanger Co.
1044 N. Cornwell Rd. • Tulsa, Okla. 74116

NOTES:

- 1) FOR VIEW DETAILS, SEE X-7262-J1 & J2.
- 2) STRENGTH WELD TUBE TO TUBESHEET.
REMOVE OIL AND GREASE OR OTHER FOREIGN MATTER FROM TUBESHEET, TUBE HOLES & TUBE ENDS PRIOR TO WELDING OF TUBES. HELIARC WITH FILLER METAL. WELD EACH TUBE INDIVIDUALLY WITH TWO (2) OR MORE PASSES. WPS = SW-1. DYE CHECK TUBE-TO-TUBESHEET WELDS BEFORE AND AFTER TUBE ROLLING. TEST TUBE-TO-TUBESHEET WELDS WITH 25 PSIG AIR PRESSURE AND SOAP SOLUTION, PRIOR TO FINAL TUBE ROLLING.

BUNDLE DETAILS

REQ'D	"A"	"B"
4	3'-2 3/8"	102 7/8"
16	21'-5 1/2"	100 7/8"

* ALL SEAL BARS AND SKID BARS SHALL BE 15'-8" LG.

SERIAL NO.: X-7262-A/B
CUSTOMER: D-COK / GIANT INDUSTRIES
P.O. NO.: 56603-P-12-04
ITEM NO.: E-641 A/B
SERVICE: REACTOR FEED/EFFLUENT EXCHANGER
SHIP TO: GRAFTON, VA

DWN. BY Don
DATE 10/23/06
CKD. BY DiCarlo

CERTIFIED AS-BUILT
Don DiCarlo 1/24/07


REV. PER CUST. COMMENTS REVISIONS
NO. DATE
12/6/06 REV. PER CUST. COMMENTS
10/23/06

X-7262-H1

Energy Exchanger Co.
1244 No. Cornett Rd., Tulsa, Okla. 74116

REV. 1

105751

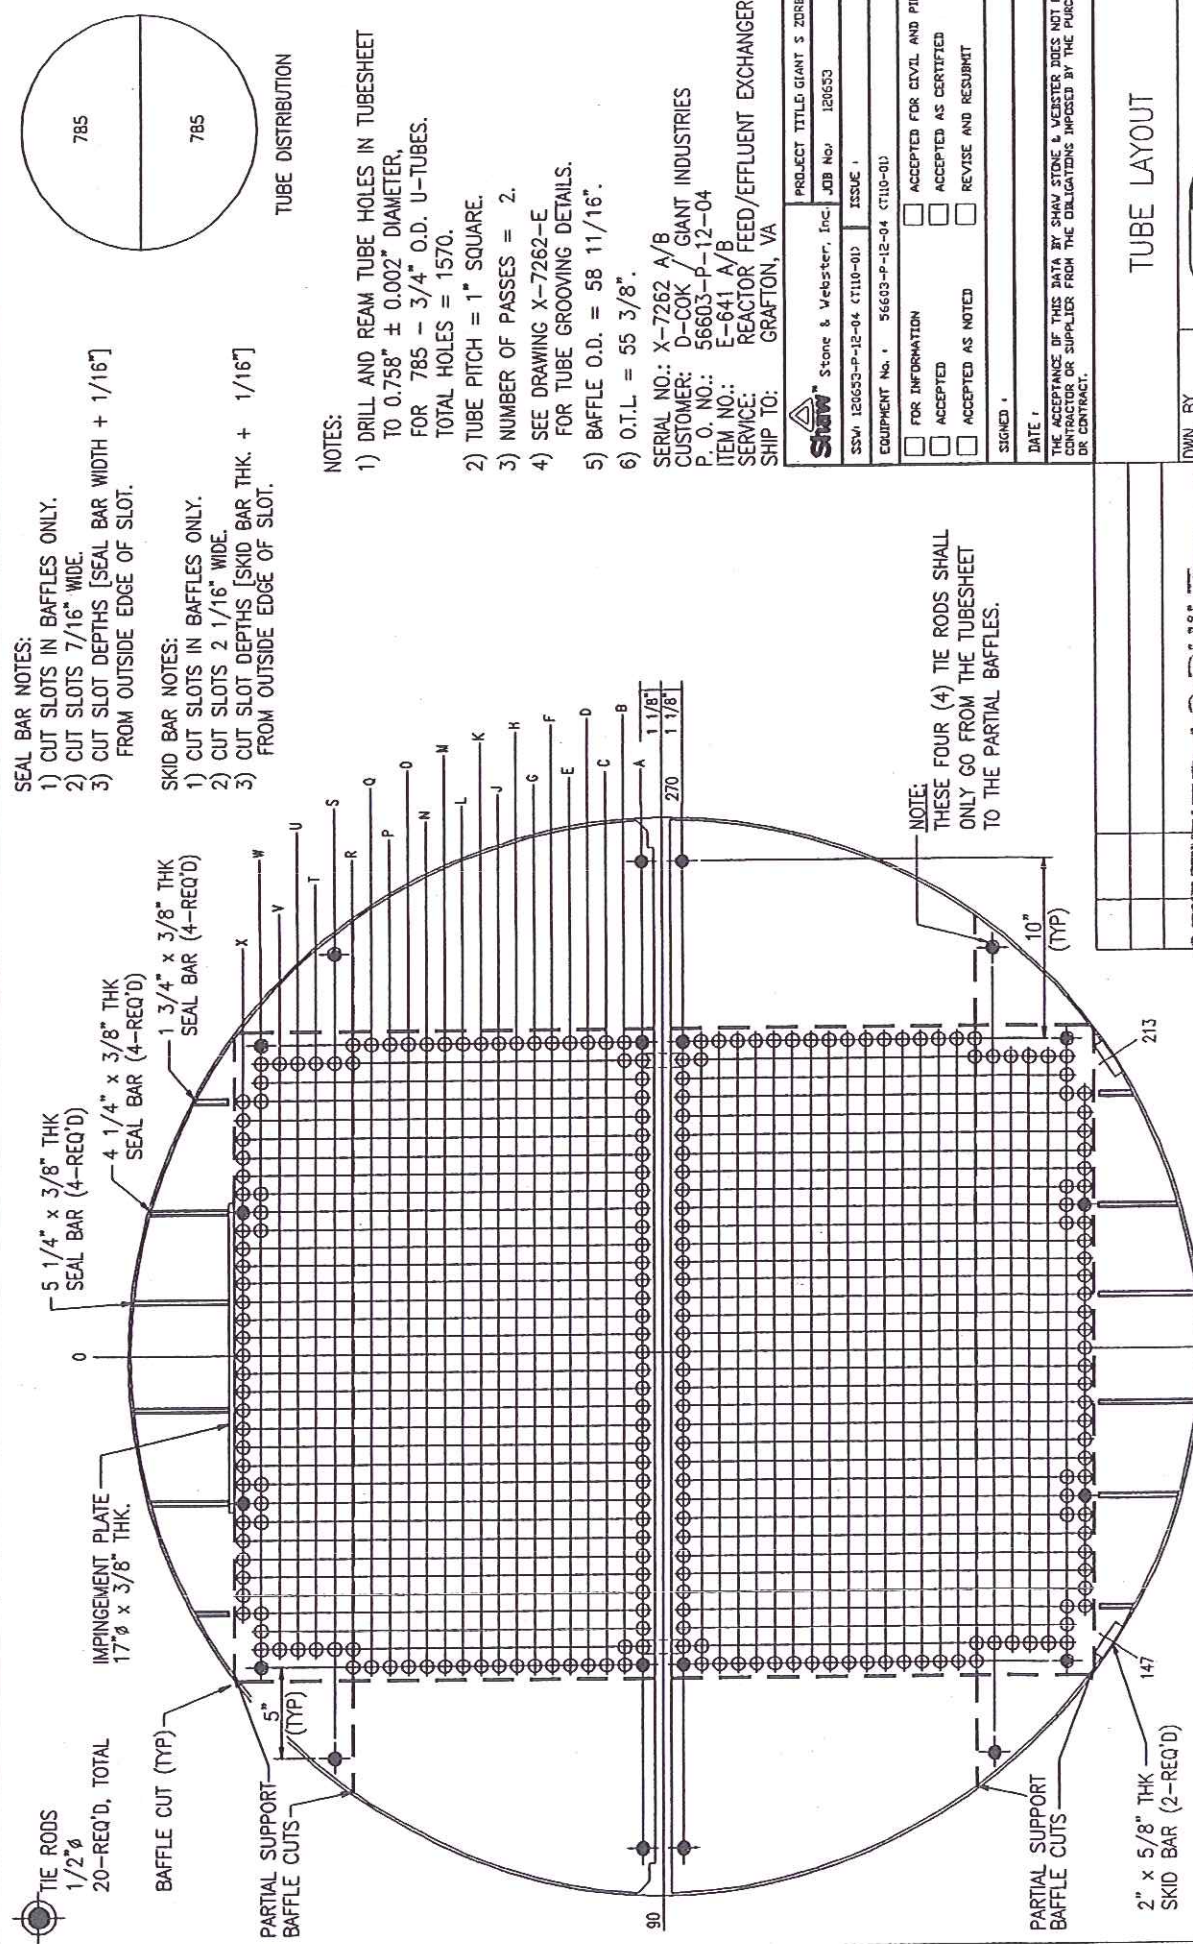

- SEAL BAR NOTES:
- 1) CUT SLOTS IN BAFFLES ONLY.
 - 2) CUT SLOTS 7/16" WIDE.
 - 3) CUT SLOT DEPTHS [SEAL BAR WIDTH + 1/16"] FROM OUTSIDE EDGE OF SLOT.
- SKID BAR NOTES:
- 1) CUT SLOTS IN BAFFLES ONLY.
 - 2) CUT SLOTS 2 1/16" WIDE.
 - 3) CUT SLOT DEPTHS [SKID BAR THK. + 1/16"] FROM OUTSIDE EDGE OF SLOT.


NOTES:

- 1) DRILL AND REAM TUBE HOLES IN TUBESHEET TO 0.758" ± 0.002" DIAMETER, FOR 785 - 3/4" O.D. U-TUBES. TOTAL HOLES = 1570.
 - 2) TUBE PITCH = 1" SQUARE.
 - 3) NUMBER OF PASSES = 2.
 - 4) SEE DRAWING X-7262-E FOR TUBE GROOVING DETAILS.
 - 5) BAFFLE O.D. = 58 11/16".
 - 6) O.T.L. = 55 3/8".
- SERIAL NO.: X-7262 A/B
CUSTOMER: D-COK / GIANT INDUSTRIES
P. O. NO.: 56603-P-12-04
ITEM NO.: E-641 A/B
SERVICE: REACTOR FEED/EFFLUENT EXCHANGER
SHIP TO: GRAFTON, VA

Shaw Stone & Webster, Inc.		PROJECT TITLE: GIANT S ZORB
SSW 120653-P-12-04 (1110-01)	JOB No. 120653	
EQUIPMENT No. 56603-P-12-04 (1110-01)	ISSUE 1	
☐ FOR INFORMATION	☐ ACCEPTED FOR CIVIL AND PIPING IFC	
☐ ACCEPTED	☐ ACCEPTED AS CERTIFIED	
☐ ACCEPTED AS NOTED	☐ REVISE AND RESUBMIT	
SIGNED:		
DATE:		
THE ACCEPTANCE OF THIS DATA BY SHAW STONE & WEBSTER DOES NOT RELIEVE THE CONTRACTOR OR SUPPLIER FROM THE OBLIGATIONS IMPOSED BY THE PURCHASER ORDER OR CONTRACT.		

DWN. BY Don	DATE 10/10/06	CKD. BY D. DiCarlo	DWG. NO. X-7262-F	REV. 0
-------------	---------------	--------------------	-------------------	--------

TUBE LAYOUT

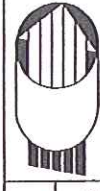


Energy Exchanger Co.
1844 No. Granite Rd. • Tulsa, Okla. 74116

CERTIFIED AS-BUILT
D. DiCarlo 4/24/07

VIEW LOOKING AT SHELL SIDE OF NO. 4 TUBESHEET

#105751

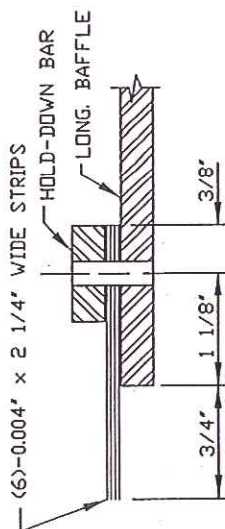

NOTE:
SEAL STRIPS, BOLTS & HOLD-DOWN
BARS SHALL BE ASSEMBLED TO THE
LONG. BAFFLE AFTER BOTTOM HALF
OF BUNDLE HAS BEEN TUBED.

ASSEMBLY DETAIL

CERTIFIED AS-BUILT
D.D. CARLO 4/24/07

SERIAL NO.: X-7262-A/B
CUSTOMER: D-COK / GIANT INDUSTRIES
P. O. NO.: 56603-P-12-04
ITEM NO.: E-641 A/B
SERVICE: REACTOR FEED/EFFLUENT EXCHANGER
SHIP TO: GRAFTON, VA

LONGITUDINAL BAFFLE DETAILS






Energy Exchanger Co.
1244 No. Cornett Rd. • Tulsa, Okla. 74116

DWN. BY Don
DATE 10/23/06
CKD. BY DiCarlo

REV. 1

DWG. NO. X-7262-H2

REQUIRED AS SHOWN FOR ONE UNIT;
TWO-UNITS REQUIRED.

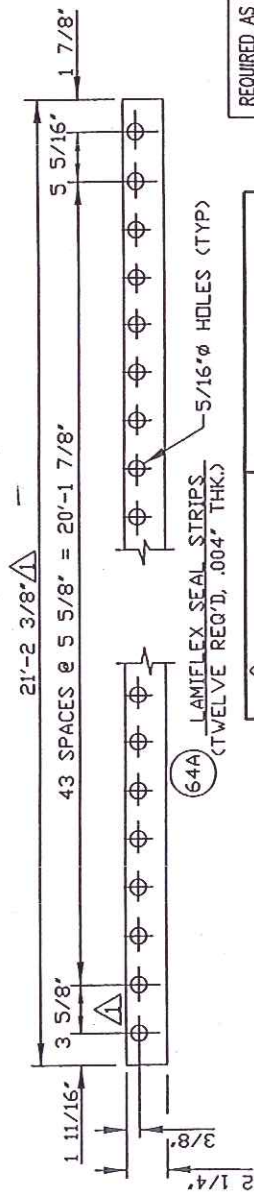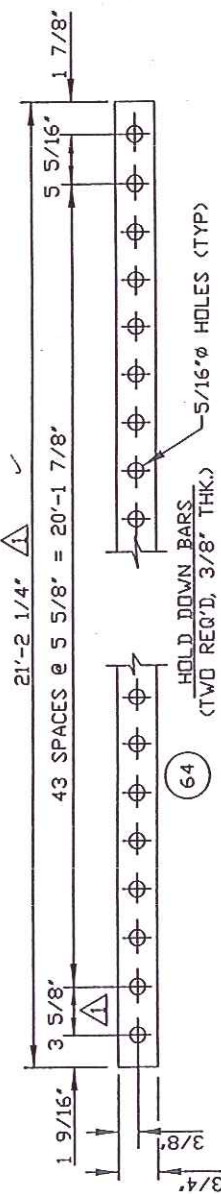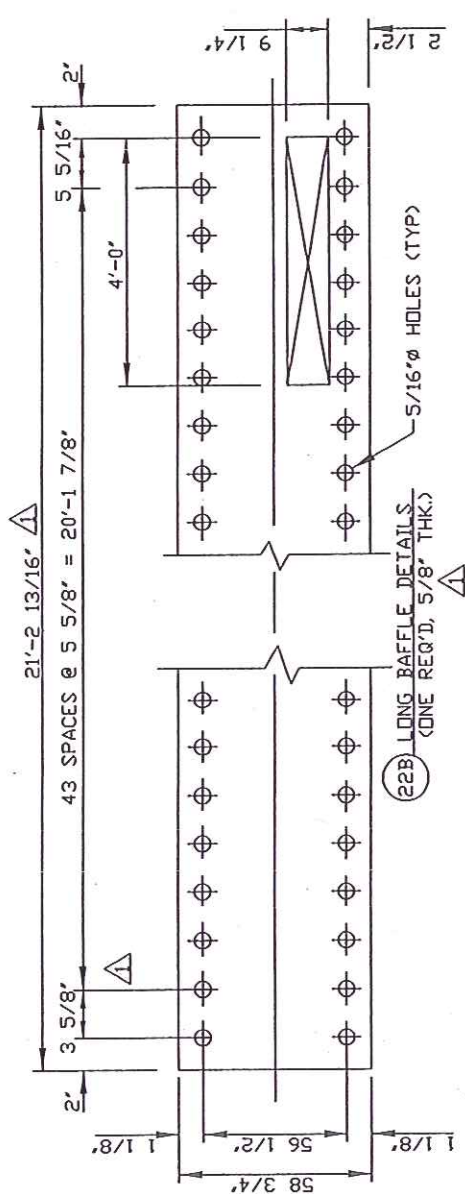


Shaw Stone & Webster, Inc. PROJECT TITLE: GIANT S 2008	
JOB No. 120653	
ISSUE 1	
EQUIPMENT No. 56603-P-12-04 (T110-01)	
FOR INFORMATION	
☐ ACCEPTED	☐ ACCEPTED FOR CIVIL AND PIPING IFC
☐ ACCEPTED AS NOTED	☐ ACCEPTED AS CERTIFIED
☐ SIGNED	☐ REVISE AND RESUBMIT
DATE 12/6/06	
THE ACCEPTANCE OF THIS DATA BY SHAW STONE & WEBSTER DOES NOT RELIEVE THE CONTRACTOR OF SUPPLIER FROM THE OBLIGATIONS IMPOSED BY THE PURCHASER ORDER OR CONTRACT.	

REV. PER E.E.C. & CUST. Don/

REVISIONS

NO. DATE

SHOP TO ASSIGN AT COMPLETION OF FABRICATION

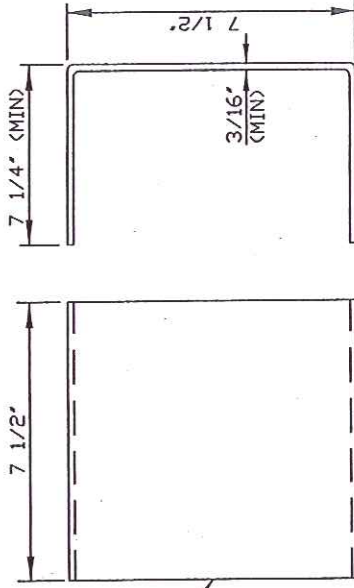

NAME PLATE BRACKET DETAIL
2-REQUIRED

SERIAL NO.: X-7262-A/B
CUSTOMER: D-COK / GIANT INDUSTRIES
P. O. NO.: 56603-P-12-04
ITEM NO.: E-641 A/B
SERVICE: REACTOR FEED/EFFLUENT EXCHANGER
SHIP TO: GRAFTON, VA

Shaw Stone & Webster, Inc.		PROJECT TITLE: GIANT S 20R8
SSW 120653-P-12-04 (T110-01)	JOB No. 120653	
EQUIPMENT No. 56603-P-12-04 (T110-01)		
ISSUE 1		
☐ FOR INFORMATION	☐ ACCEPTED FOR CIVIL AND PIPING IFC	
☐ ACCEPTED	☐ ACCEPTED AS CERTIFIED	
☐ ACCEPTED AS NOTED	☐ REVISE AND RESUBMIT	
SIGNED :		
DATE :		

THE ACCEPTANCE OF THIS DATA BY SHAW STONE & WEBSTER DOES NOT RELIEVE THE CONTRACTOR OR SUPPLIER FROM THE OBLIGATIONS IMPOSED BY THE PURCHASER ORDER OR CONTRACT.

NAME PLATE DETAILS

OWN. BY Don
DATE 10/23/06
CHKD. BY DiCarlo
DWG. NO. X-7262-L
REV. 1



CERTIFIED AS-BUILT
D. DiCarlo 4/24/07

60

61

1 X-7262 A
X-7262 B

2 E-641 A
E-641 B

CERTIFIED BY		Energy Exchanger Company		TULSA, OKLAHOMA	
MAWP SHELL	497 *	PSI. @	500 *	*F	729
MAWP TUBE	625 *	PSI. @	500 *	*F	813
MIN. DESIGN METAL TEMP.		SHELL	0	*F @	497 *
		TUBE	0	*F @	625 *
SERIAL NO.	RT-1	①	YEAR BUILT	2007	
P.O. NO.	56603-P-12-04	SERVICE REACTOR FEED/EFFLUENT EXCHANGER			
ITEM ②	SIZE 59-264	TYPE	AFU		
* MAX. ALLOW. EXT. PRESS. = 15 PSIG @ 366°F.					
FIELD TEST PRESS. : SHELL = 647 PSIG ; TUBE = 813 PSIG					

NAME PLATE DETAIL
2-REQUIRED

NOTE
CLIP CORNERS AND SEAL WELD NAMEPLATE TO BRACKET.