


# 105756

## Energy Exchanger Company

## HEAT EXCHANGER SPECIFICATION SHEET

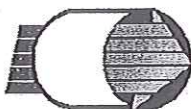


P.O. No.: 56603-P-12-04

REV. 0 AS PURCHASED


|    |                                                                                                                                        |                                                 |                                        |                 |                                                                                  |                                        |                                               |                                            |        |                 |      |
|----|----------------------------------------------------------------------------------------------------------------------------------------|-------------------------------------------------|----------------------------------------|-----------------|----------------------------------------------------------------------------------|----------------------------------------|-----------------------------------------------|--------------------------------------------|--------|-----------------|------|
| 3  | Customer                                                                                                                               | SHAW STONE & WEBSTER (GIANT)                    |                                        |                 |                                                                                  | Job No.: X-7265 "AS BUILT"             |                                               |                                            |        |                 |      |
| 4  | Address                                                                                                                                | HOUSTON, TX                                     |                                        |                 |                                                                                  | Rev.: 1                                | Date: 3/13/07                                 |                                            |        |                 |      |
| 5  | Plant Location                                                                                                                         | GRAFTON, VA                                     |                                        |                 |                                                                                  | File:                                  | 06-6102                                       |                                            |        |                 |      |
| 6  | Service of Unit                                                                                                                        | DEBUTANIZER FEED/BOTTOMS EXCHANGER              |                                        |                 |                                                                                  | Item: E-645 A/B/C/D/E                  |                                               |                                            |        |                 |      |
| 7  | Size                                                                                                                                   | 34-240                                          | Type                                   | AEU             | Horizontal                                                                       | Connected In                           | 1                                             | Parallel                                   | 5      | Series          |      |
| 8  | Surf./Unit                                                                                                                             | Gross / <input checked="" type="checkbox"/> Eff | 14164.78 ft <sup>2</sup> ; Shells/Unit |                 | 5                                                                                | Surf./Shell                            | Gross <input checked="" type="checkbox"/> Eff | 2832.96                                    |        | ft <sup>2</sup> |      |
| 9  | PERFORMANCE OF ONE UNIT                                                                                                                |                                                 |                                        |                 |                                                                                  |                                        |                                               |                                            |        |                 |      |
| 10 | Fluid Allocation                                                                                                                       | Shell Side                                      |                                        |                 |                                                                                  | Tube Side                              |                                               |                                            |        |                 |      |
| 11 | Fluid Name                                                                                                                             | DEBUTANIZER FEED                                |                                        |                 |                                                                                  | DEBUTANIZER BOTTOMS                    |                                               |                                            |        |                 |      |
| 12 | Fluid Quantity, Total                                                                                                                  | lb/hr                                           | 312999                                 |                 |                                                                                  |                                        | 297443                                        |                                            |        |                 |      |
| 13 | Vapor (In/Out)                                                                                                                         |                                                 | 19071                                  |                 |                                                                                  |                                        |                                               |                                            |        |                 |      |
| 14 | Liquid                                                                                                                                 |                                                 | 312999                                 | 293928          |                                                                                  |                                        |                                               | 297443                                     | 297443 |                 |      |
| 15 | Steam                                                                                                                                  |                                                 |                                        |                 |                                                                                  |                                        |                                               |                                            |        |                 |      |
| 16 | Water                                                                                                                                  |                                                 |                                        |                 |                                                                                  |                                        |                                               |                                            |        |                 |      |
| 17 | Noncondensable                                                                                                                         |                                                 |                                        |                 |                                                                                  |                                        |                                               |                                            |        |                 |      |
| 18 | Temperature (In/Out)                                                                                                                   | °F                                              | 121.                                   | 349.0           |                                                                                  |                                        |                                               | 406.                                       | 170.   |                 |      |
| 19 | Density (Vapor/Liquid)                                                                                                                 | Lb/Ft <sup>3</sup>                              | 42.95                                  | 2.3600          | 34.11                                                                            | 31.47                                  |                                               |                                            |        | 41.97           |      |
| 20 | Viscosity                                                                                                                              | cP                                              | 0.331                                  | 0.0130          | 0.124                                                                            | 0.10                                   |                                               |                                            |        | 0.284           |      |
| 21 | Molecular Weight                                                                                                                       |                                                 |                                        |                 |                                                                                  |                                        |                                               |                                            |        |                 |      |
| 22 | Molecular Weight, Noncondensable                                                                                                       |                                                 |                                        |                 |                                                                                  |                                        |                                               |                                            |        |                 |      |
| 23 | Specific Heat                                                                                                                          | Btu/lb-F                                        | 0.5160                                 | 0.5930          | 0.714                                                                            | 0.7960                                 |                                               |                                            |        | 0.5430          |      |
| 24 | Thermal Conductivity                                                                                                                   | Btu/hr-ft-F                                     | 0.0660                                 | 0.0200          | 0.047                                                                            | 0.0440                                 |                                               |                                            |        | 0.0610          |      |
| 25 | Latent Heat                                                                                                                            | Btu/lb                                          |                                        |                 |                                                                                  |                                        |                                               |                                            |        |                 |      |
| 26 | Inlet Pressure                                                                                                                         | psia                                            | 291.7                                  |                 |                                                                                  |                                        | 269.7                                         |                                            |        |                 |      |
| 27 | Velocity                                                                                                                               | ft/sec                                          |                                        |                 |                                                                                  |                                        | 3.41                                          |                                            |        |                 |      |
| 28 | Pressure Drop, Allow./Calc.                                                                                                            | psi                                             | 25.00                                  | /               | 19.00                                                                            | 25.00                                  |                                               |                                            |        | /               | 8.00 |
| 29 | Fouling Resistance (Min.)                                                                                                              | Hr-Ft <sup>2</sup> -°F/Btu                      | 0.002                                  |                 |                                                                                  |                                        | 0.002                                         |                                            |        |                 |      |
| 30 | Heat Exchanged                                                                                                                         | 45260000                                        | Btu/hr; M.T.D. (Corrected)             |                 |                                                                                  |                                        | 43.25 °F                                      |                                            |        |                 |      |
| 31 | Transfer Rate, Service                                                                                                                 | 73.87                                           | Btu/hr-ft <sup>2</sup> -F; Clean       |                 |                                                                                  |                                        | Btu/hr-ft <sup>2</sup> -F                     |                                            |        |                 |      |
| 32 | CONSTRUCTION OF ONE SHELL                                                                                                              |                                                 |                                        |                 |                                                                                  | Sketch (Bundle/Nozzle Orientation)     |                                               |                                            |        |                 |      |
| 33 |                                                                                                                                        |                                                 | Shell Side                             |                 | Tube Side                                                                        |                                        |                                               |                                            |        |                 |      |
| 34 | Design/Test Pressure                                                                                                                   | psig                                            | 310/FV/408                             |                 | 300/FV/391                                                                       |                                        |                                               |                                            |        |                 |      |
| 35 | Design Temperature (Max/Min)                                                                                                           | °F                                              | 450/366/0                              |                 | 480/366/0                                                                        |                                        |                                               |                                            |        |                 |      |
| 36 | No. Passes Per Shell                                                                                                                   |                                                 | 1                                      |                 | 2                                                                                |                                        |                                               |                                            |        |                 |      |
| 37 | Corrosion Allowance                                                                                                                    | inch                                            | 0.125                                  |                 | 0.125                                                                            |                                        |                                               |                                            |        |                 |      |
| 38 | Connections                                                                                                                            | In                                              | 1 - 8" 300RF                           |                 | 1 - 8" 300RF                                                                     |                                        |                                               |                                            |        |                 |      |
| 39 | Size & Rating                                                                                                                          | Out                                             | 1 - 8" 300RF                           |                 | 1 - 8" 300RF                                                                     |                                        |                                               |                                            |        |                 |      |
| 40 |                                                                                                                                        | Intermediate                                    | (2) 1 - 10" 300RF                      |                 | 1 - 8" 300RF                                                                     |                                        |                                               |                                            |        |                 |      |
| 41 | Tube No.                                                                                                                               | 365 U'S                                         | OD                                     | 0.75 in; Thk.   | <input checked="" type="checkbox"/> Min                                          | Avg                                    | 0.083 in; Length                              | 20. ft; Pitch                              | 1 in   | 90°             |      |
| 42 | Tube Type                                                                                                                              | BARE                                            |                                        | Material        |                                                                                  | SA-179                                 |                                               |                                            |        |                 |      |
| 43 | Shell                                                                                                                                  | SA-516-70                                       | <input checked="" type="checkbox"/> ID | OD              | 34. in                                                                           | Shell Cover                            | SA-516-70                                     | <input checked="" type="checkbox"/> Integ. |        | Remov.          |      |
| 44 | Channel or Bonnet                                                                                                                      | SA-516-70                                       | Channel Cover                          |                 | SA-516-70 N                                                                      |                                        | <input checked="" type="checkbox"/> Integ.    | <input checked="" type="checkbox"/>        | Remov. |                 |      |
| 45 | Tubesheet-Stationary                                                                                                                   | SA-516-70 N                                     |                                        |                 |                                                                                  | Tubesheet - Floating                   |                                               |                                            |        |                 |      |
| 46 | Floating Head Cover                                                                                                                    |                                                 |                                        |                 |                                                                                  | Impingement Protection PLATE ON BUNDLE |                                               |                                            |        |                 |      |
| 47 | Baffles-Cross                                                                                                                          | 16 - SA-516-70                                  | Type                                   | V SEG           | % Cut ( <input checked="" type="checkbox"/> Dia. <input type="checkbox"/> Area ) | 20.                                    | Spacing c/c                                   | 12.94                                      | Inlet  | in              |      |
| 48 | Baffles-Long                                                                                                                           |                                                 |                                        |                 |                                                                                  | Seal Type                              |                                               |                                            |        |                 |      |
| 49 | Supports - Tube                                                                                                                        | SA-516-70                                       | U-Bend                                 | YES             | Type                                                                             |                                        |                                               |                                            | FULL   |                 |      |
| 50 | Bypass Seal Arrangement                                                                                                                |                                                 |                                        |                 |                                                                                  | Tube-Tubesheet Joint                   |                                               | ROLLED                                     |        |                 |      |
| 51 | Expansion Joint                                                                                                                        |                                                 |                                        |                 |                                                                                  | Type                                   |                                               |                                            |        |                 |      |
| 52 | pv <sup>2</sup> - Inlet Nozzle                                                                                                         | Bundle Entrance                                 |                                        |                 |                                                                                  | Bundle Exit                            |                                               |                                            |        |                 |      |
| 53 | Gaskets - Shell Side                                                                                                                   | S.I. D.J.F.G.F.                                 |                                        |                 |                                                                                  | Tube Side                              |                                               | S.I. D.J.F.G.F.                            |        |                 |      |
| 54 | - Floating Head                                                                                                                        |                                                 |                                        |                 |                                                                                  |                                        |                                               |                                            |        |                 |      |
| 55 | Code Requirements                                                                                                                      | ASME SECTION VIII, DIV. 1 CODE STAMP            |                                        |                 |                                                                                  | TEMA Class                             |                                               | R                                          |        |                 |      |
| 56 | Weight/Shell                                                                                                                           | 19,000 lb. EACH                                 | Filled With Water                      | 27,550 lb. EACH |                                                                                  | Bundle                                 | 11,100 lb. EACH                               |                                            |        |                 |      |
| 57 | REMARKS                                                                                                                                |                                                 |                                        |                 |                                                                                  |                                        |                                               |                                            |        |                 |      |
| 58 | (1) DELETED.                                                                                                                           |                                                 |                                        |                 |                                                                                  |                                        |                                               |                                            |        |                 |      |
| 59 | (2) 10" OUTLET ON SHELL "D". 10" INLET AND OUTLET ON SHELL "E"                                                                         |                                                 |                                        |                 |                                                                                  |                                        |                                               |                                            |        |                 |      |
| 60 | (3) 5 ROW PARTIAL SUPPORT AT SHELL NOZZLE CENTERLINES                                                                                  |                                                 |                                        |                 |                                                                                  |                                        |                                               |                                            |        |                 |      |
| 61 | (4) PROVIDE (2) 1-1/2" X 300# RFLWN ON EACH OF INLET AND OUTLET (TUBESIDE AND SHELLSIDE) NOZZLES OF EACH INDIVIDUAL SHELL (EXCHANGER). |                                                 |                                        |                 |                                                                                  |                                        |                                               |                                            |        |                 |      |
| 62 | (5) TIE ROD SPACER SLEEVES SHALL BE SCH. 40 PIPE THICKNESS.                                                                            |                                                 |                                        |                 |                                                                                  |                                        |                                               |                                            |        |                 |      |
| 63 | (6) SHELLSIDE SHALL BE DESIGNED FOR HYDROGEN SERVICE.                                                                                  |                                                 |                                        |                 |                                                                                  |                                        |                                               |                                            |        |                 |      |



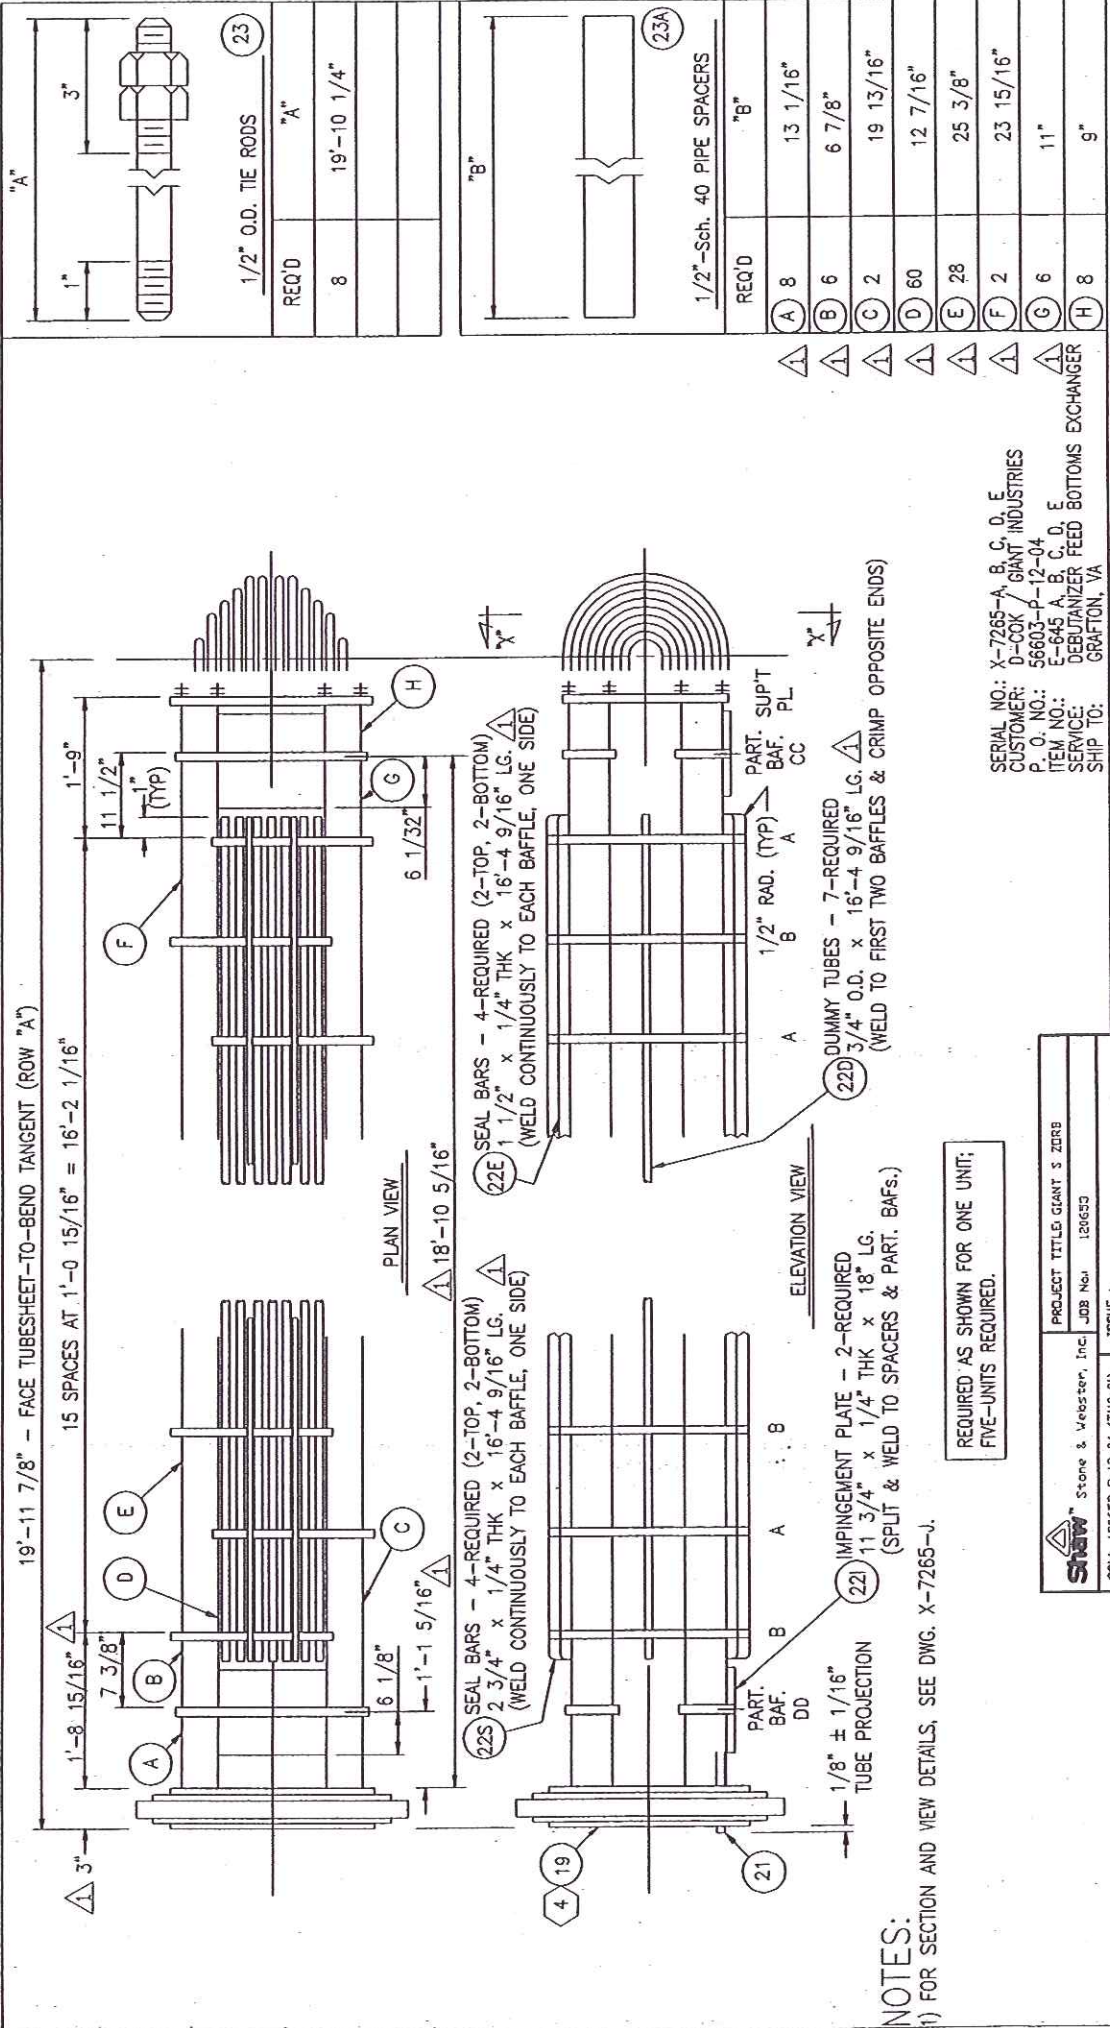

|                                                                                                                                                                  |  |                                                                                                                                                              |  |                                          |  |                                                                  |  |
|------------------------------------------------------------------------------------------------------------------------------------------------------------------|--|--------------------------------------------------------------------------------------------------------------------------------------------------------------|--|------------------------------------------|--|------------------------------------------------------------------|--|
| <b>Shaw</b> Stone & Webster, Inc. JOB No. 120653                                                                                                                 |  | PROJECT TITLE: GIANT S ZORB<br>EQUIPMENT No. 56603-P-12-04 CT110-01 ISSUE 1                                                                                  |  | DWN. BY Dan<br>DATE 10/10/06             |  | DWG. NO. X-7265-H<br>REV. 1                                      |  |
| <input type="checkbox"/> FOR INFORMATION<br><input type="checkbox"/> ACCEPTED<br><input type="checkbox"/> ACCEPTED AS NOTED                                      |  | <input type="checkbox"/> ACCEPTED FOR CIVIL AND PIPING IFC<br><input type="checkbox"/> ACCEPTED AS CERTIFIED<br><input type="checkbox"/> REVISE AND RESUBMIT |  | CERTIFIED AS BUILT<br>D. DiCarlo 4/24/07 |  | Energy Exchanger Co.<br>1544 N. Cornett Rd. • Tulsa, Okla. 74116 |  |
| SIGNED:                                                                                                                                                          |  | DATE:                                                                                                                                                        |  | 12/7/06                                  |  | REV. PER CUSTOMER & E.E.C.                                       |  |
| THE ACCEPTANCE OF THIS DATA BY SHAW STONE & WEBSTER DOES NOT RELIEVE THE CONTRACTOR OR SUPPLIER FROM THE OBLIGATIONS IMPOSED BY THE PURCHASER ORDER OR CONTRACT. |  | NO.                                                                                                                                                          |  | DATE                                     |  | REVISIONS                                                        |  |
| 1) FOR SECTION AND VIEW DETAILS, SEE DWG. X-7265-J.                                                                                                              |  | 12/7/06                                                                                                                                                      |  | 10/10/06                                 |  | X-7265-H                                                         |  |



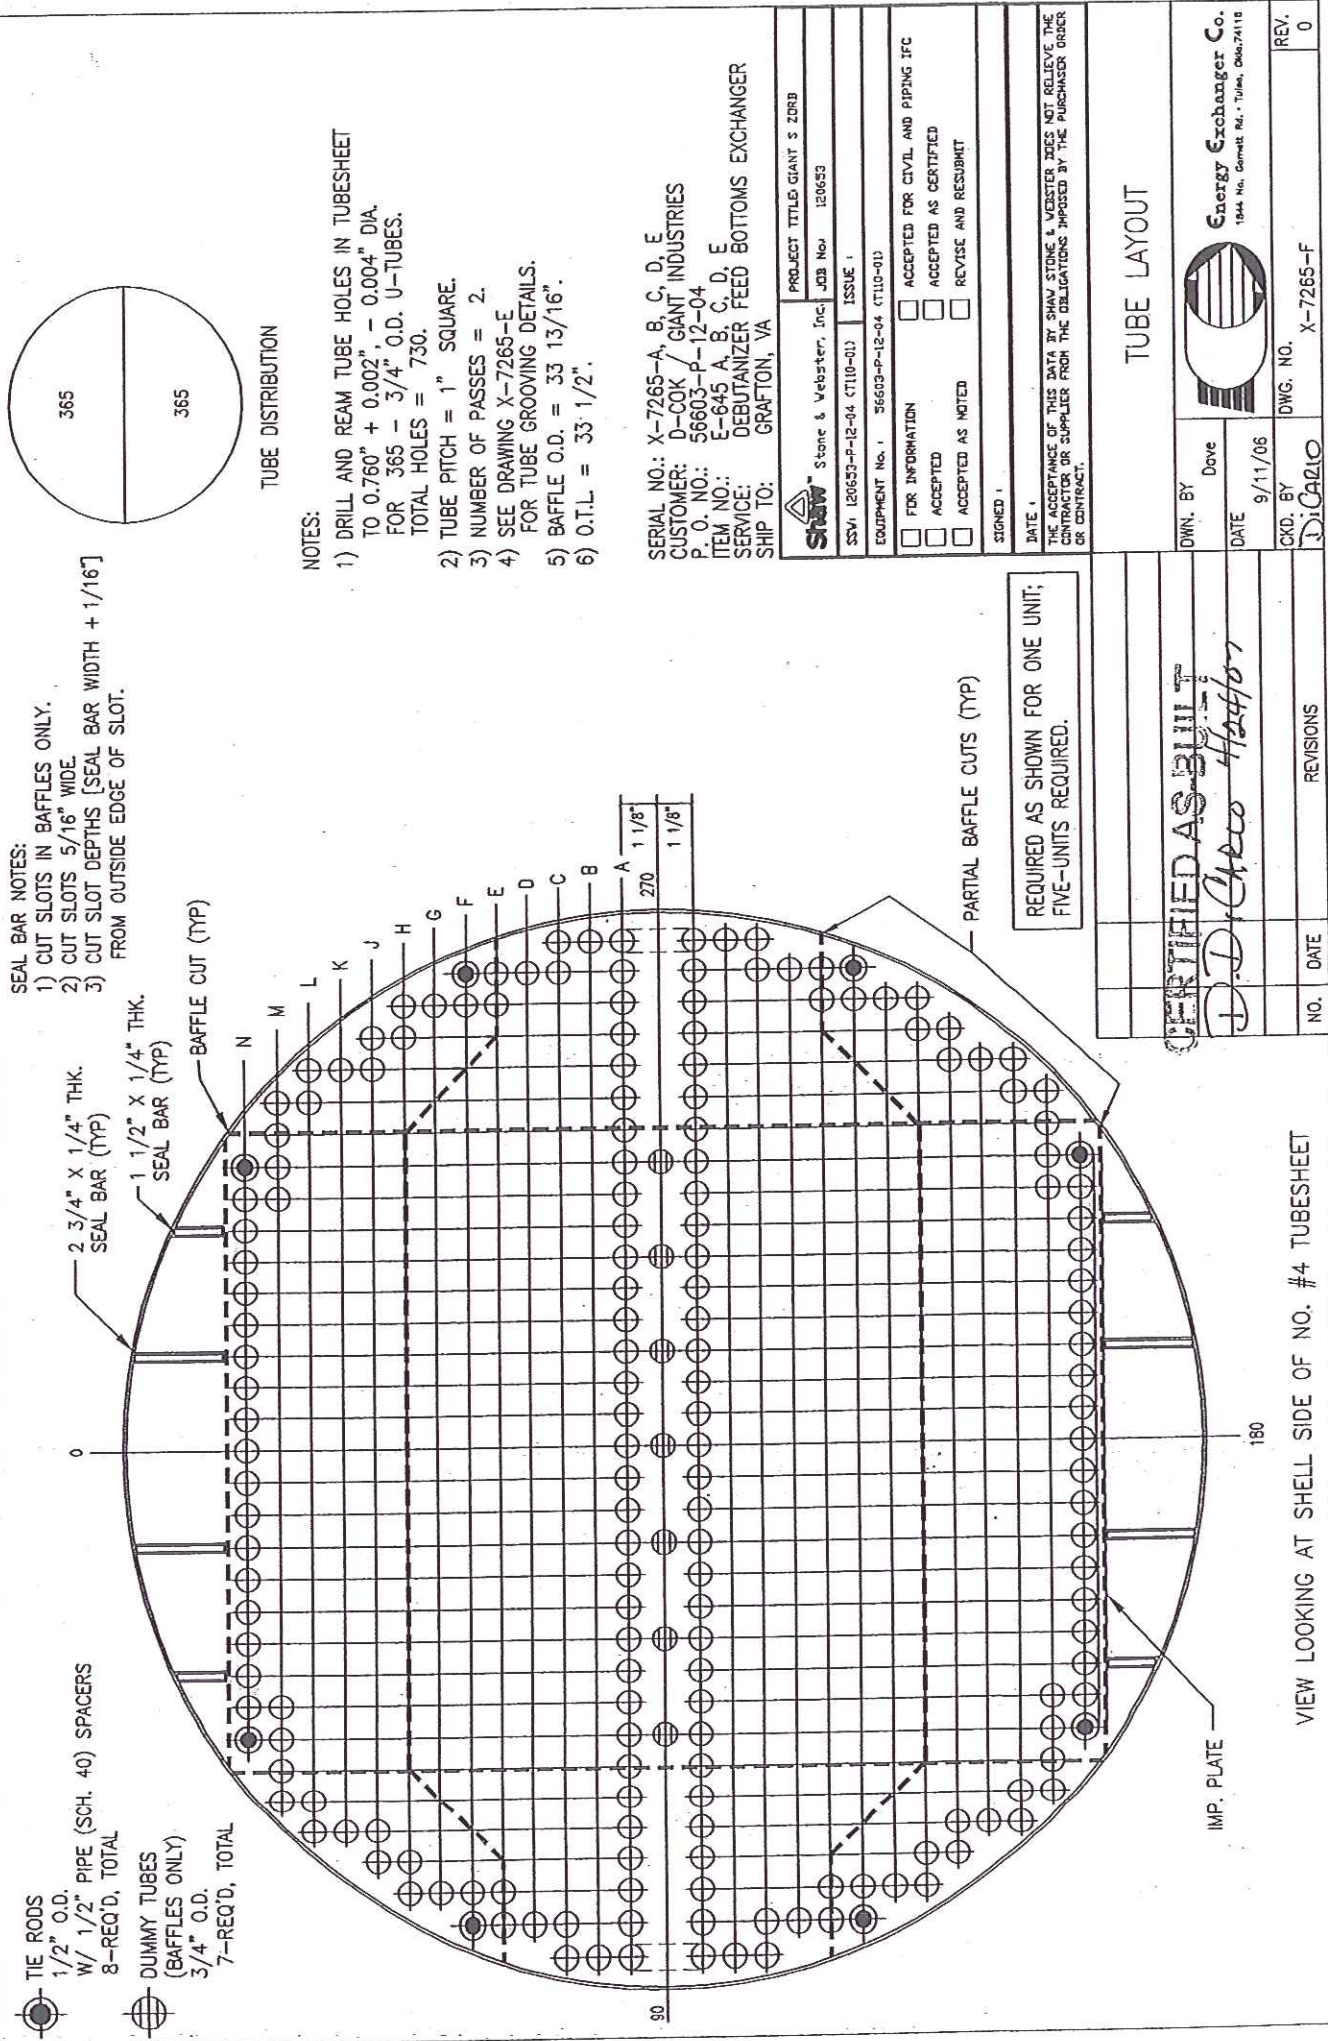











**FORM U-1 MANUFACTURER'S DATA REPORT FOR PRESSURE VESSELS**  
As Required by the Provisions of the ASME Code Rules, Section VIII, Division 1

1. Manufactured and certified by ENERGY EXCHANGER COMPANY, 1844 NORTH GARNETT ROAD TULSA, OK 74116  
(Name and address of Manufacturer)

Manufactured for D-COK LLC, 3657 BRIAR PARK DRIVE, HOUSTON, TEXAS 77042-5205  
(Name and address of Purchaser)

3. Location of installation GIANT INDUSTRIES, GRAFTON, VIRGINIA  
(Name and address)

4. Type: HORIZONTAL HEAT EXCHANGER X-7265-A X-7265-A1 REV. 3 5257 2007  
(Horiz., vert., or sphere) (Tank, separator, jkt. vessel, heat exh., etc.) (Mfg's serial No.) (CRN) (Drawing No.) (Nat'l. Bd. No.) (Year built)

5. ASME Code, Section VIII, Div. 1 2004 EDITION, 2005 ADDENDA 2519  
Edition and Addenda (date) Code Case No. Special Service per UG-120(d)

Items 6 - 11 incl. to be completed for single wall vessels, jackets of jacketed vessels, shell of heat exchangers, or chamber of multi-chamber vessels.

6. Shell (a) No. of course(s): 3 (b) Overall length (ft & in.): 20'-11 1/8"

| Course(s) |               |                   | Material            | Thickness |       | Long. Joint (Cat. A) |       |       | Circum. Joint (Cat. A, B & C) |      |      | Heat Treatment |       |       |      |       |      |
|-----------|---------------|-------------------|---------------------|-----------|-------|----------------------|-------|-------|-------------------------------|------|------|----------------|-------|-------|------|-------|------|
| No.       | Diameter, in. | Length (ft & in.) | Spec./Grade or Type | Nom.      | Corr. | Type                 | Full. | Spot. | None.                         | Eff. | Type | Full.          | Spot. | None. | Eff. | Temp. | Time |
| 2         | 34" I.D.      | 8'-0"             | SA-516-70           | 1/2"      | 1/8"  | 1                    |       | SPOT  |                               | .85  | 1    |                | SPOT  |       | .85  | ---   | ---  |
| 1         | 34" I.D.      | 4'-11 1/8"        | SA-516-70           | 1/2"      | 1/8"  | 1                    |       | SPOT  |                               | .85  | 1    |                | SPOT  |       | .85  | ---   | ---  |

7. Heads: (a) SA-516-70 (b)   
(Mat'l Spec. No., Grade or Type) H.T. - Time & Temp (Mat'l Spec. No., Grade or Type) H.T. - Time & Temp

|     | Location (Top, Bottom, Ends) | Thickness |       | Radius |         | Elliptical Ratio | Conical Apex Angle | Hemispherical Radius | Flat Diameter | Side to Pressure |         | Category A |                  |      |
|-----|------------------------------|-----------|-------|--------|---------|------------------|--------------------|----------------------|---------------|------------------|---------|------------|------------------|------|
|     |                              | Min.      | Corr. | Crown  | Knuckle |                  |                    |                      |               | Convex           | Concave | Type       | Full, Spot, None | Eff. |
| (a) | END                          | 7/16"     | 1/8"  |        |         | 2:1              |                    |                      |               |                  | X       | S          | NONE             | 1.0  |
| (b) |                              |           |       |        |         |                  |                    |                      |               |                  |         |            |                  |      |

If removable, bolts used (describe other fastening)   
(Mat'l Spec. No., Grade, size, No.)

8. Type of jacket  Jacket closure   
(Describe as ogee & weld, bar, etc.)

If bar, give dimensions  If bolted, describe or sketch.

9. MAWP 314 15 psi at max. temp. 450 366 °F Min. design metal temp. 0 °F at 314 psi.  
(internal) (external) (internal) (external)

10. Impact test NO; SHELL SIDE DESIGNED PER UCS-66(a)(c)(g) & UG-20(f) at test temperature of ... °F  
(Indicate yes or no and the component(s) impact tested)

11. Hydro., ~~pressure~~, test press. 408 PSIG Proof test ...

Items 12 and 13 to be completed for tube sections.

12. Tubesheet: SA-516-70N 34 3/4 3" 5/16 BOLTED  
Stationary (Mat'l Spec. No.) Dia., in. (subject to press.) Nom. thk., in. Corr. Allow., in. Attachment (welded or bolted)

Floating (Mat'l Spec. No.) Dia., in. Nom. thk., in. Corr. Allow., in. Attachment

13. Tubes: SA-179 3/4 .083" (MIN) 365 U  
Mat'l Spec. No., Grade or Type O.D., in. Nom. thk., in. or gauge Number Type (Straight or U)

Items 14 - 18 incl. to be completed for inner chambers of jacketed vessels or channels of heat exchangers.

14. Shell (a) No. of course(s): 1 (b) Overall length (ft & in.): 1'-11"

| Course(s) |               |                   | Material            | Thickness |       | Long. Joint (Cat. A) |      |      | Circum. Joint (Cat. A, B & C) |      |      | Heat Treatment |      |      |      |       |      |
|-----------|---------------|-------------------|---------------------|-----------|-------|----------------------|------|------|-------------------------------|------|------|----------------|------|------|------|-------|------|
| No.       | Diameter, in. | Length (ft & in.) | Spec./Grade or Type | Nom.      | Corr. | Type                 | Full | Spot | None                          | Eff. | Type | Full           | Spot | None | Eff. | Temp. | Time |
| 1         | 34" I.D.      | 1'-11"            | SA-516-70           | 1/2"      | 1/8"  | 1                    |      | SPOT |                               | .85  | 1    |                | SPOT |      | .85  | ...   | ...  |
|           |               |                   |                     |           |       |                      |      |      |                               |      |      |                |      |      |      |       |      |

15. Heads: (a) SA-516-70N (b)   
(Mat'l Spec. No., Grade or Type) H.T. - Time & Temp (Mat'l Spec. No., Grade or Type) H.T. - Time & Temp

|     | Location (Top, Bottom, Ends) | Thickness |       | Radius |         | Elliptical Ratio | Conical Apex Angle | Hemispherical Radius | Flat Diameter | Side to Pressure |         | Category A |                  |      |
|-----|------------------------------|-----------|-------|--------|---------|------------------|--------------------|----------------------|---------------|------------------|---------|------------|------------------|------|
|     |                              | Min.      | Corr. | Crown  | Knuckle |                  |                    |                      |               | Convex           | Concave | Type       | Full, Spot, None | Eff. |
| (a) | END                          | 3 1/8"    | 3/16" |        |         |                  |                    |                      | 34 3/4"       |                  |         |            |                  |      |
| (b) |                              |           |       |        |         |                  |                    |                      |               |                  |         |            |                  |      |

If removable, bolts used (describe other fastening) (a) SA-193-B7, 3/4", 48.; CHAN-TO-SHELL: SA-193-B7, 3/4", 48  
(Mat'l Spec. No., Grade, Size, No.)



16. MAWP 301 15 psi at max. temp. 480 366 °F Min. design metal temp. 0 °F at 301 psi.  
(internal) (external) (internal) (external)

17. Impact test NO; CHANNEL SIDE DESIGNED PER UCS-66(a)(c)(g) & UG-20(f) at test temperature of ... °F  
(Indicate yes or no and the component(s) impact tested)

18. Hydro., ~~pressure~~, ~~testing~~ test press. 391 PSIG Proof test ...

19. Nozzles, inspection, and safety valve openings:

| Purpose (Inlet, Outlet, Drain, etc.) | No. | Diameter or Size | Flange Type | Material |        | Nozzle Thickness |       | Reinforcement Material | How Attached |        | Location (Inso. Open.) |
|--------------------------------------|-----|------------------|-------------|----------|--------|------------------|-------|------------------------|--------------|--------|------------------------|
|                                      |     |                  |             | Nozzle   | Flange | Nom.             | Corr. |                        | Nozzle       | Flange |                        |
| INLET/OUTLET                         | 1/1 | 8" 300#          | RFWN        | SA-106-B | SA-105 | .500"            | 1/8"  | SA-516-70              | WELDED       | WELDED | CHANNEL                |
| T.W./P.G.                            | 2/2 | 1 1/2" 300#      | RFLWN       | SA-105   | ...    | .630"            | 1/8"  | WELD                   | WELDED       | ...    | CH. NOZS.              |
| INLET/OUTLET                         | 1/1 | 8" 300#          | RFWN        | SA-106-B | SA-105 | .500"            | 1/8"  | SA-516-70              | WELDED       | WELDED | SHELL                  |
| T.W./P.G.                            | 2/2 | 1 1/2" 300#      | RFLWN       | SA-105   | ...    | .630"            | 1/8"  | WELD                   | WELDED       | ...    | SH. NOZS.              |
|                                      |     |                  |             |          |        |                  |       |                        |              |        |                        |
20. Supports: Skirt NO Lugs ... Legs ... Others (2) BELLY BANDS Attached SHELL; WELDED  
(Yes or No) (No.) (No.) (Describe) (Where and How)

21. Manufacturer's Partial Data Reports properly identified and signed by Commissioned Inspectors have been furnished for the following items of the report:  
(List the name of part, item number, mfg's. name and identifying number)

22. Remarks: SERVICE: DEBUTANIZER FEED BOTTOMS EXCHANGER, P.O. NO: 56603-P-12-04, ITEM NO: E-645 A, SIZE: 34-240, TYPE: AEU  
TUBES DESIGNED W/ 0" C.A. PRESSURE RELIEF DEVICES PROVIDED BY OTHERS.  
LINES 6-11 INCLUDE (1) 39 1/4 O.D. x 34 I.D. x 4 9/16" THK., SA-105N, RING  
LINES 14-18 INCLUDE (2) 39 1/4" O.D. x 34" I.D. x 4 9/16" THK., SA-105N, RING;

#### CERTIFICATE OF SHOP COMPLIANCE

We certify that the statements made in this report are correct and that all details of design, material, construction, and workmanship of this vessel conform to the ASME Code for Pressure Vessels, Section VIII, Division 1,

U Certificate of Authorization No. 12370 Expires 9/27/2007  
Date 3-8-07 Name ENERGY EXCHANGER COMPANY Signed Edgar O'Donoghue  
(Manufacturer) (Representative)

#### CERTIFICATE OF SHOP INSPECTION

I, the undersigned, holding a valid commission issued by The National Board of Boiler and Pressure Vessel Inspectors and the State or Province of OKLAHOMA and employed by OneBeacon America Insurance Company of BOSTON, MASS. have inspected the pressure vessel described in this Manufacturer's Data Report on 3-8-07, and state that, to the best of my knowledge and belief, the Manufacturer has constructed this pressure vessel in accordance with ASME Code, Section VIII, Division 1. By signing this certificate neither the Inspector nor his employer makes any warranty, expressed or implied, concerning the pressure vessel described in this Manufacturer's Data Report. Furthermore, neither the inspector nor his employer shall be liable in any manner for any personal injury or property damage or a loss of any kind arising from or connected with this inspection.

Date 3-8-07 Signed [Signature] Commissions N.B.# 11921 BA OKLA.# 823  
(Authorized Inspector) (Nat'l Board incl. endorsement, State, Province and No.)

#### CERTIFICATE OF FIELD ASSEMBLY COMPLIANCE

We certify that the statements on this report are correct and that the field assembly construction of all parts of this vessel conforms with the requirements of ASME Code, Section VIII, Division 1,

U Certificate of Authorization No. ... Expires ...  
Date ... Name ... Signed ...  
(Assembler) (Representative)


#### CERTIFICATE OF FIELD ASSEMBLY INSPECTION

I, the undersigned, holding a valid commission issued by The National Board of Boiler and Pressure Vessel Inspectors and the State or Province of ... and employed by ... of ... have compared the statements in this Manufacturer's Data Report with the described pressure vessel and state that parts referred to as data items ..., not included in the certificate of shop inspection, have been inspected by me and to the best of my knowledge and belief, the Manufacturer has constructed and assembled this pressure vessel in accordance with ASME Code, Section VIII, Division 1. The described vessel was inspected and subjected to a hydrostatic test of ... psi. By signing this certificate neither the Inspector nor his employer makes any warranty, expressed or implied, concerning the pressure vessel described in this Manufacturer's Data Report. Furthermore, neither the Inspector nor his employer shall be liable in any manner for any personal injury or property damage or a loss of any kind arising from or connected with this inspection.

Date ... Signed ... Commissions ...  
(Authorized Inspector) (Nat'l Board incl. endorsement, State, Province and No.)



5257

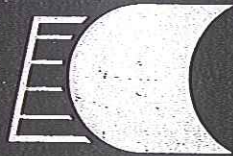

**CERTIFIED BY**  
**Energy Exchanger Company**  
**TULSA, OKLAHOMA**

U  
W  
RT-4

|                         |       |            |       |       |          |               |
|-------------------------|-------|------------|-------|-------|----------|---------------|
| MAWP SHELL              | 314 * | P.S.I.G. @ | 450 * | OF    | 408      | TEST P.S.I.G. |
| MAWP TUBE               | 301 * | P.S.I.G. @ | 480 * | OF    | 391      | TEST P.S.I.G. |
| MIN. DESIGN METAL TEMP. | SHELL | 0          | OF @  | 314 * | P.S.I.G. |               |
|                         | TUBE  | 0          | OF @  | 301 * | P.S.I.G. |               |

SERIAL NO. X-7265 A YEAR BUILT 2007

P.O. NO. 56603-P-12-04

SERVICE DEBUTANIZER FEED BOTTOMS EXCHANGER

ITEM E-645A SIZE 34-240 TYPE AEU

\*MAX. ALLOW. EXT. PRESS. = 15 PSIG @ 366° F.

*550 Janet Campbell*