

#105758

Energy Exchanger Company

HEAT EXCHANGER SPECIFICATION SHEET



P.O. No.: 56603-P-12-04

REV. 0 AS PURCHASED

Customer SHAW STONE & WEBSTER (GIANT)

Job No.: X-7265 "AS BUILT"

Address HOUSTON, TX

Rev.: 1

Date: 3/13/07

Plant Location GRAFTON, VA

File:

06-6102

Service of Unit DEBUTANIZER FEED/BOTTOMS EXCHANGER

Item: E-645 A/B/C/D/E

Size 34-240

Type AEU

Horizontal

Connected In 1

Parallel 5

Series

Surf./Unit

Gross / ☒ Eff14164.78 ft²; Shells/Unit

5

Surf./Shell

Gross

☒ Eff.

2832.96

ft²

PERFORMANCE OF ONE UNIT

Fluid Allocation

Shell Side

Tube Side

Fluid Name

DEBUTANIZER FEED

DEBUTANIZER BOTTOMS

Fluid Quantity, Total

lb/hr

312999

297443

Vapor (In/Out)

19071

Liquid

312999

293928

297443

297443

Steam

Water

Noncondensable

Temperature (In/Out)

°F

121.

349.0

406.

170.

Density (Vapor/Liquid)

Lb/Ft³

42.95

2.3600

34.11

31.47

41.97

Viscosity

cP

0.331

0.0130

0.124

0.10

0.284

Molecular Weight

Molecular Weight, Noncondensable

Specific Heat

Btu/lb-F

0.5160

0.5930

0.714

0.7960

0.5430

Thermal Conductivity

Btu/hr-ft-F

0.0660

0.0200

0.047

0.0440

0.0610

Latent Heat

Btu/lb

Inlet Pressure

psia

291.7

269.7

Velocity

ft/sec

3.41

Pressure Drop, Allow./Calc.

psi

25.00

/

19.00

25.00

/

8.00

Fouling Resistance (Min.)

Hr-Ft²-°F/Btu

0.002

0.002

Heat Exchanged

45260000

Btu/hr; M.T.D. (Corrected)

43.25

°F

Transfer Rate, Service

73.87

Btu/hr-ft²-F; CleanBtu/hr-ft²-F

CONSTRUCTION OF ONE SHELL

Sketch (Bundle/Nozzle Orientation)

Design/Test Pressure

psig

310/FV/408

300/FV/391

Design Temperature (Max/Min)

°F

450/366/0

480/366/0

No. Passes Per Shell

1

2

Corrosion Allowance

inch

0.125

0.125

Connections

In

1 - 8" 300RF

1 - 8" 300RF

Size &

Out

1 - 8" 300RF

1 - 8" 300RF

Rating

Intermediate

(2) 1 - 10" 300RF

1 - 8" 300RF

Tube No.

365 U'S

OD

0.75

in; Thk.

☒ Min

Avg

0.083

in; Length

20.

ft; Pitch

1

in

90°

Tube Type

BARE

Shell

SA-516-70

☒ ID

OD

34.

in; Shell Cover

SA-516-70

Channel or Bonnet

SA-516-70

Channel Cover

SA-516-70 N

☒ Integ.

Remov.

Tubesheet-Stationary

SA-516-70 N

Tubesheet - Floating

☒ Integ.

Remov.

Floating Head Cover

Impingement Protection

PLATE ON BUNDLE

Baffles-Cross

16 - SA-516-70

Type

V SEG

% Cut (☒ Dia. | Area)

20.

Spacing c/c

12.94

Inlet

in

Baffles-Long

Seal Type

Supports - Tube

SA-516-70

U-Bend

YES

Type

FULL

Bypass Seal Arrangement

Tube-Tubesheet Joint

Type

ROLLED

Expansion Joint

pv² - Inlet Nozzle

Bundle Entrance

Bundle Exit

Gaskets - Shell Side

S.I. D.J.F.G.F

Tube Side

S.I. D.J.F.G.F.

- Floating Head

Code Requirements

ASME SECTION VIII, DIV. 1

CODE STAMP

TEMA Class

R

Weight/Shell

19,000 lb. EACH

Filled With Water

27,550 lb. EACH

Bundle

11,100 lb. EACH

REMARKS

(1) DELETED.



(2) 10" OUTLET ON SHELL "D". 10" INLET AND OUTLET ON SHELL "E"

(3) 5 ROW PARTIAL SUPPORT AT SHELL NOZZLE CENTERLINES

(4) PROVIDE (2) 1-1/2" X 300# RFLWN ON EACH OF INLET AND OUTLET (TUBESIDE AND SHELLSIDE) NOZZLES OF EACH INDIVIDUAL SHELL (EXCHANGER).

(5) TIE ROD SPACER SLEEVES SHALL BE SCH. 40 PIPE THICKNESS.

(6) SHELLSIDE SHALL BE DESIGNED FOR HYDROGEN SERVICE.

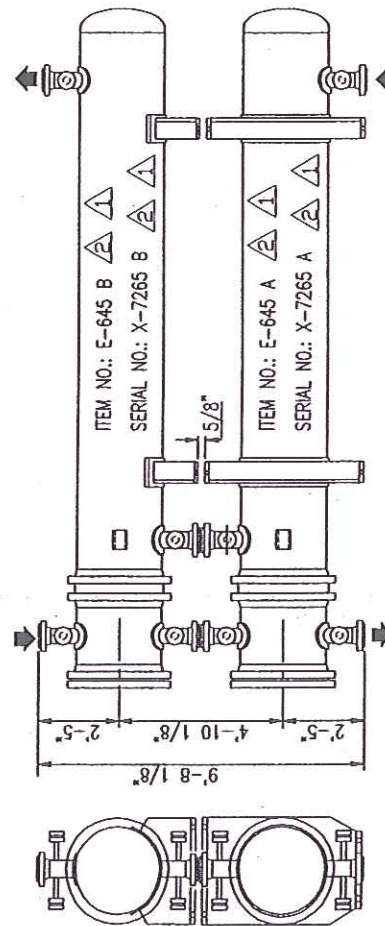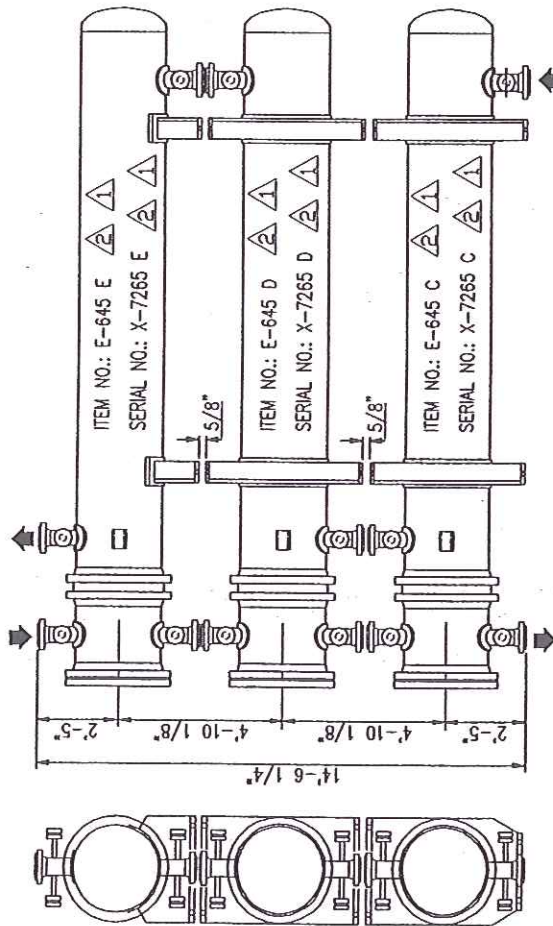

NOTE:
 1) SHIMS, GASKETS & BOLTING FOR STACKING SHALL BE FURNISHED BY ENERGY.
 2) HYDROTEST IN THE STACKED POSITION.

CERTIFIED AS-BUILT

D.D. CARLO 4/24/07

SERIAL NO.: X-7265-A, B, C, D, E
 CUSTOMER: D-COK / GIANT INDUSTRIES
 P. O. NO.: 56603-P-12-04
 ITEM NO.: E-645 A, B, C, D, E
 SERVICE: DEBUTANIZER FEED BOTTOMS EXCHANGER
 SHIP TO: GRAFTON, VA

Stone & Webster, Inc.		PROJECT TITLE	GIANT S ZDRB
SSN: 120653-P-12-04 (7110-01)	JOB No.	120653	
EQUIPMENT No. 1		56603-P-12-04 (7110-01)	ISSUE 1
☐ FOR INFORMATION	☐ ACCEPTED FOR CIVIL AND PIPING IFC		
☐ ACCEPTED	☐ ACCEPTED AS CERTIFIED		
☐ ACCEPTED AS NOTED	☐ REVISE AND RESUBMIT		
SIGNED 1			
DATE 1			
THE ACCEPTANCE OF THIS DATA BY SHAW STONE & WEBSTER DOES NOT RELIEVE THE CONTRACTOR OR SUPPLIER FROM THE OBLIGATIONS IMPOSED BY THE PURCHASER ORDER OR CONTRACT.			

STACKING ARRANGEMENTS


DWN. BY	Date	
DATE	8/12/06	
CKD. BY	GH	
DWG. NO.	X-7265-A6	A
REV.		2



Energy Exchanger Co.
 1544 No. Connet Rd. • Tulsa, OK 74116

REVISIONS	
NO.	DATE
2	12/18/06
1	10/10/06
REV. PER CUSTOMER COMMENTS Dan/DD	
REV. PER CUSTOMER COMMENTS Dan/DD	

- 1) MACHINE ALL COVER SURFACES TO 250 AARH, EXCEPT GASKET SURFACES MACHINE TO 125 AARH.
- 2) ALL COVER PASS PLATE GROOVE WIDTHS SHALL BE 1/2".
- 3) ALL COVER PASS PLATE GROOVE JUNCTIONS SHALL BE NOTCHED 3/8" @ 45°.

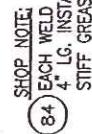

- 1) FOR WELD & BEVEL DETAILS, SEE DWG STD-1.
- 2) FOR BODY FLANGE DETAILS, SEE DWG. X-7265-M.
- 3) FOR FABRICATION NOTES, SEE DWG. X-7265-N.
- 4) MILL PASS PLATES TO 3/8", BOTH ENDS.

REQUIRED AS SHOWN FOR ONE UNIT;
FIVE-UNITS REQUIRED.

CERTIFIED AS-BUILT
D. D. Carr 4/24/07

4/24/07

NO.	DATE	REV. PER CUSTOMER COMMENTS	REVISIONS
1	12/18/06		Don't

CHANNEL DETAILS

OWN, BY

DATE _____ UNIT _____

10/10/06

DiCarlo

Energy Exchanger Co.
1844 Mc. Cormick Rd., Tulsa, Okla. 74118

REV.

11

DlCarlo | X-7265-B


REVISIONS

NO.	DATE

	JOB No. 120633 PROJECT TITLE: GALT & ZORA
	SSVA 120633-P-12-04 (1110-01) ISSUE 1
EQUIPMENT No. 1 56503-P-12-04 (1110-01)	
☐ FOR DETERMINATION ☐ ACCEPTED AS CERTIFIED ☐ REVISED AND RESUBMIT	SIGNED: _____ DATE: _____
THE ACCEPTANCE OF THIS DATA BY SHAW STONE & WEBSTER DOES NOT RELIEVE THE CONTRACTOR OF THE OBLIGATIONS IMPOSED BY THE PURCHASER ORDER & CONTRACT.	

- TIE RODS
1/2" O.D.
W/ 1/2" PIPE (SCH. 40) SPACERS
8-REQ'D, TOTAL
- DUMMY TUBES
(BAFFLES ONLY)
3/4" O.D.
7-REQ'D, TOTAL

- SEAL BAR NOTES:
- 1) CUT SLOTS IN BAFFLES ONLY.
 - 2) CUT SLOTS 5/16" WIDE
 - 3) CUT SLOT DEPTHS [SEAL BAR WIDTH + 1/16"] FROM OUTSIDE EDGE OF SLOT.

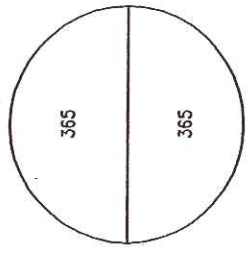


TUBE DISTRIBUTION

NOTES:

- 1) DRILL AND REAM TUBE HOLES IN TUBESHEET TO 0.760" + 0.002", - 0.004" DIA. FOR 365 - 3/4" O.D. U-TUBES. TOTAL HOLES = 730.
- 2) TUBE PITCH = 1" SQUARE.
- 3) NUMBER OF PASSES = 2.
- 4) SEE DRAWING X-7265-E FOR TUBE GROOVING DETAILS.
- 5) BAFFLE O.D. = 33 13/16".
- 6) O.T.L. = 33 1/2".

SERIAL NO.: X-7265-A, B, C, D, E
 CUSTOMER: D-COK / GIANT INDUSTRIES
 P. O. NO.: 56603-P-12-04
 ITEM NO.: E-645 A, B, C, D, E
 SERVICE: DEBUTANIZER FEED BOTTOMS EXCHANGER
 SHIP TO: GRAFTON, VA

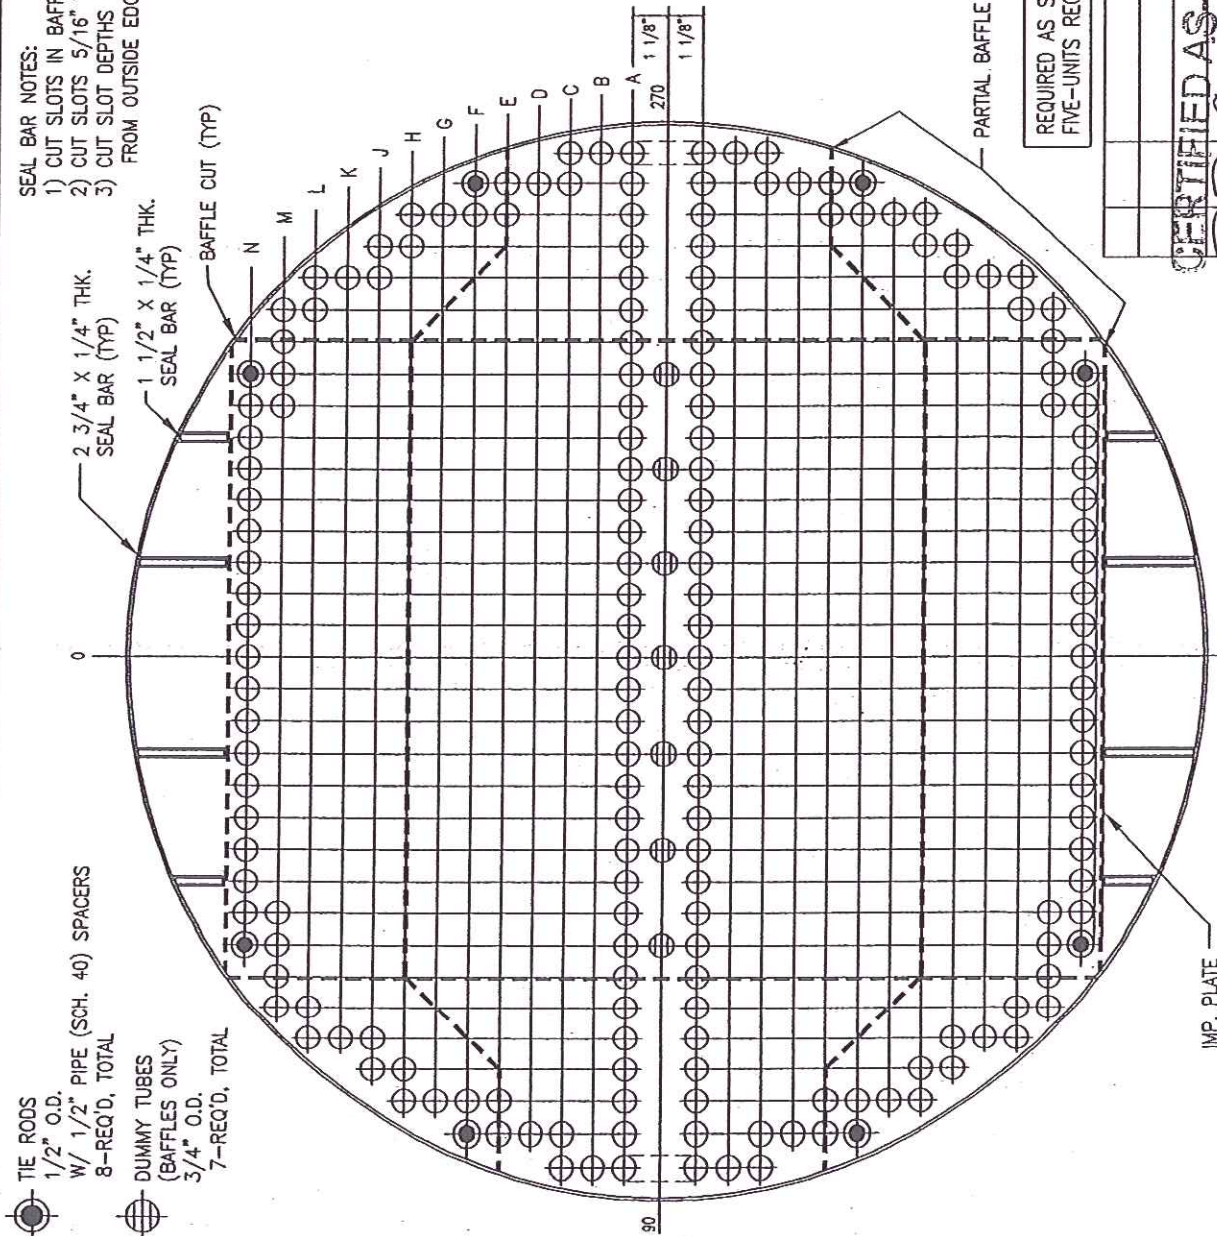


REQUIRED AS SHOWN FOR ONE UNIT;
 FIVE-UNITS REQUIRED.

TUBE LAYOUT

OWN. BY	Date	 Energy Exchanger Co. 1544 N. Garrett Rd., Tulsa, Okla. 74116
DATE	9/11/06	
CHKD. BY	OWG. NO.	REV.
		X-7265-F

CERTIFIED AS BUILT
D. D. Chero Haffner

VIEW LOOKING AT SHELL SIDE OF NO. #4 TUBESHEET

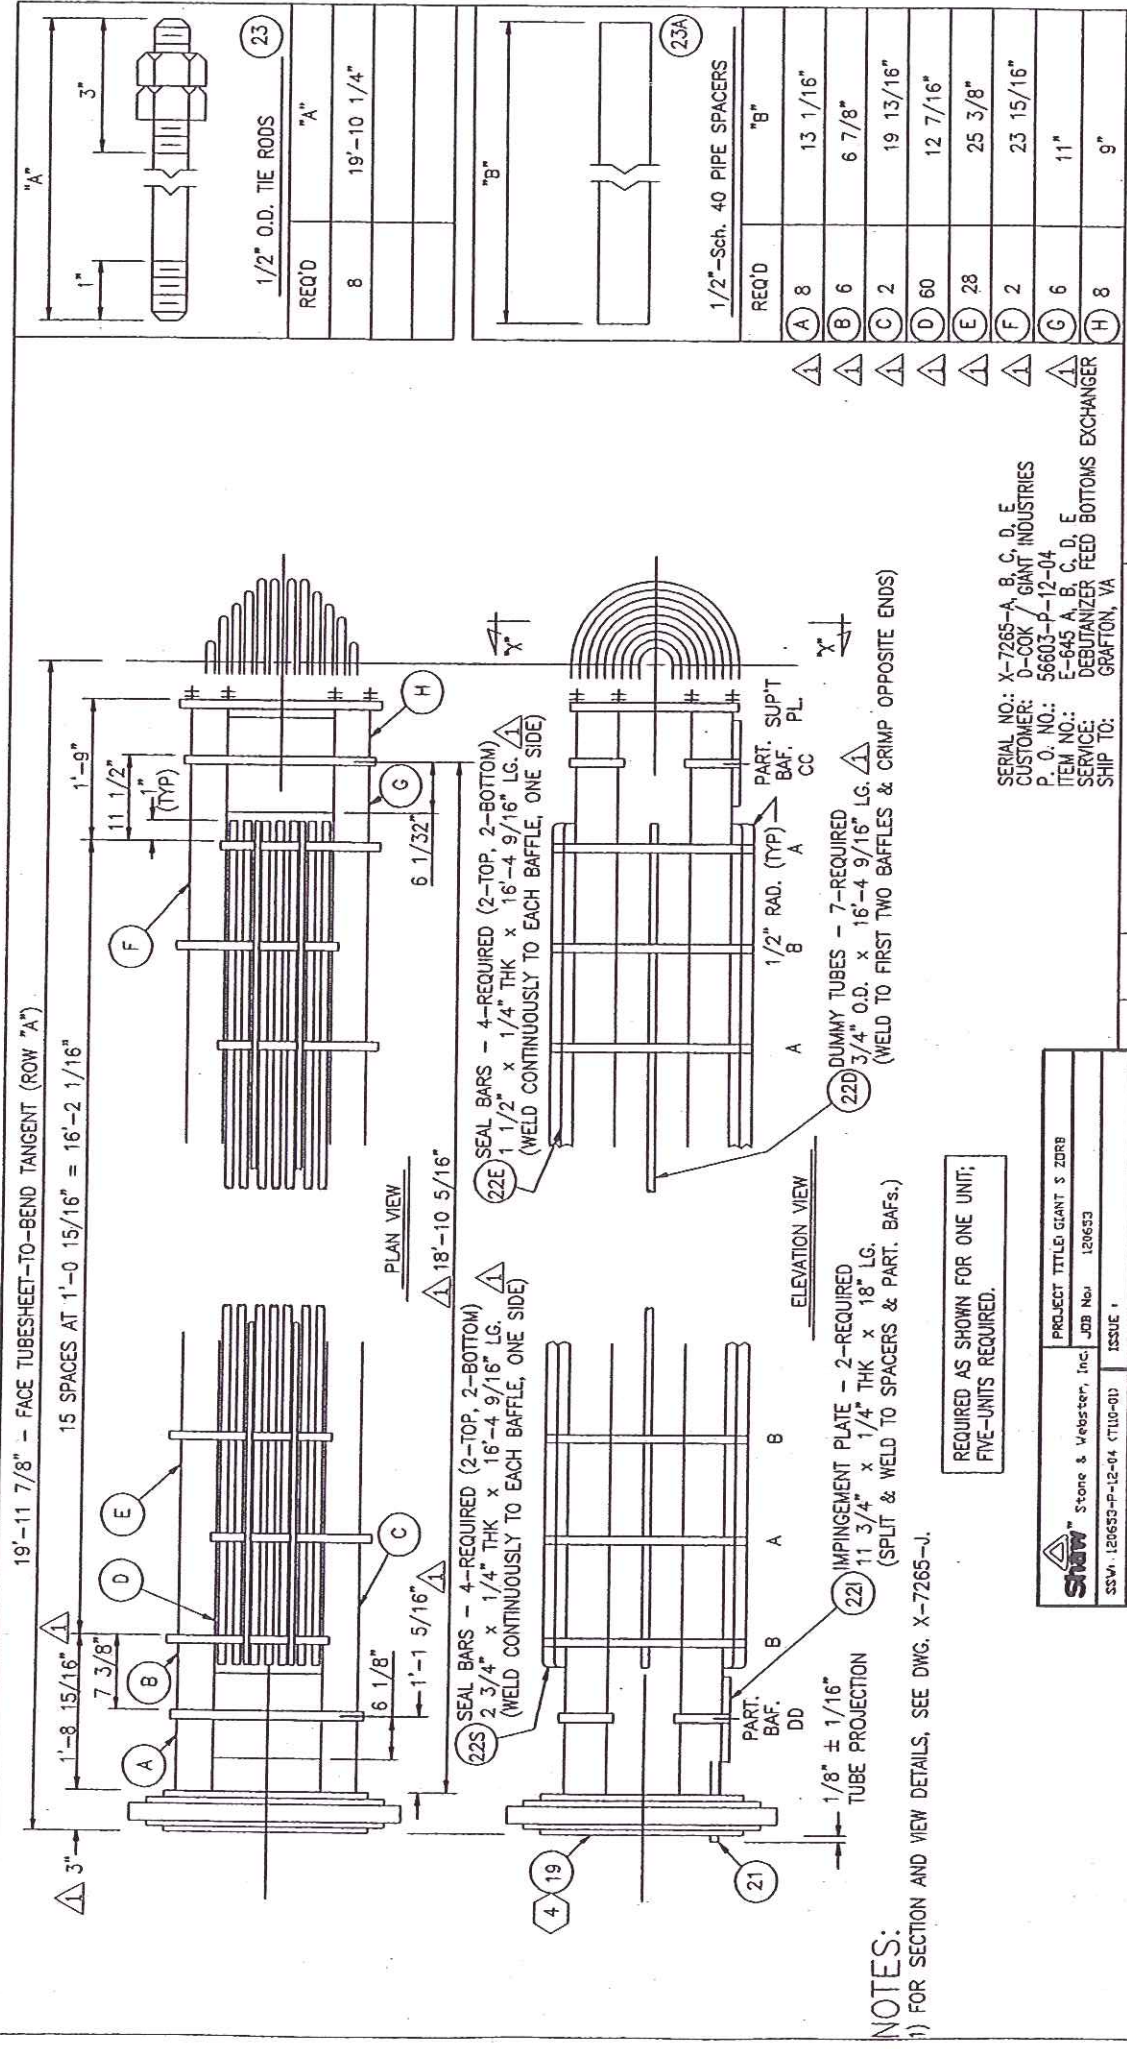

NOTES:
1) FOR SECTION AND VIEW DETAILS, SEE DWG. X-7265-1.

REQUIRED AS SHOWN FOR ONE UNIT;
FIVE-UNITS REQUIRED.

SERIAL NO.: X-7265-A, B, C, D, E
CUSTOMER: D-COK, GIANT INDUSTRIES
P. O. NO.: 56603-P-12-04
ITEM NO.: E-645 A, B, C, D, E
SERVICE: DEBUTANIZER FEED BOTTOMS EXCHANGER
SHIP TO: GRAFTON, VA

REQ'D	"A"	"B"
8	19'-10 1/4"	13 1/16"
		6 7/8"
		19 13/16"
		12 7/16"
		25 3/8"
		23 15/16"
		11"
		9"

BUNDLE DETAILS

Energy Exchanger Co.
1544 N. Garnett Rd. • Tulsa, Okla. 74116

OWN. BY: Don

DATE: 10/10/06

CHKD. BY: D. Carlo

DWG. NO.: X-7265-1H

REV. 1

Shaw Stone & Webster, Inc. JOB No. 120653		PROJECT TITLE: GIANT S ZDRB	
EQUIPMENT No.: 56603-P-12-04 (T110-01)		ISSUE 1	
☐ FOR INFORMATION ☐ ACCEPTED ☐ ACCEPTED AS NOTED SIGNED:	☐ ACCEPTED FOR CIVIL AND PIPING IFC ☐ ACCEPTED AS CERTIFIED ☐ REVISE AND RESUBMIT	DATE:	
THE ACCEPTANCE OF THIS DATA BY SHAW STONE & WEBSTER DOES NOT RELIEVE THE CONTRACTOR OR SUPPLIER FROM THE OBLIGATIONS IMPOSED BY THE PURCHASER ORDER OR CONTRACT.			

FORM U-1 MANUFACTURER'S DATA REPORT FOR PRESSURE VESSELS
As Required by the Provisions of the ASME Code Rules, Section VIII, Division 1

1. Manufactured and certified by ENERGY EXCHANGER COMPANY, 1844 NORTH GARNETT ROAD, TULSA, OK 74116
(Name and address of Manufacturer)

2. Manufactured for D-COK LLC, 3657 BRIAR PARK DRIVE, HOUSTON, TEXAS 77042-5205
(Name and address of Purchaser)

Location of installation GIANT INDUSTRIES, GRAFTON, VIRGINIA

4. Type: HORIZONTAL HEAT EXCHANGER X-7265-C X-7265-A3 REV. 3 5259 2007
(Horiz., vert., or sphere) (Tank, separator, jkt. vessel, heat exh., etc.) (Mfg's serial No.) (CRN) (Drawing No.) (Nat'l. Bd. No.) (Year built)

5. ASME Code, Section VIII, Div. 1 2004 EDITION, 2005 ADDENDA 2519
Edition and Addenda (date) Code Case No. Special Service per UG-120(d)

Items 6 - 11 incl. to be completed for single wall vessels, jackets of jacketed vessels, shell of heat exchangers, or chamber of multi-chamber vessels.

6. Shell (a) No. of course(s): 3 (b) Overall length (ft & in.): 20'-11 1/8"

Course(s)			Material	Thickness		Long. Joint (Cat. A)			Circum. Joint (Cat. A, B & C)			Heat Treatment					
No.	Diameter, in.	Length (ft & in.)	Spec./Grade or Type	Nom.	Corr.	Type	Full	Spot	None	Eff.	Type	Full	Spot	None	Eff.	Temp.	Time
2	34" I.D.	8'-0"	SA-516-70	1/2"	1/8"	1		SPOT		.85	1		SPOT		.85	---	---
1	34" I.D.	4'-11 1/8"	SA-516-70	1/2"	1/8"	1		SPOT		.85	1		SPOT		.85	---	---

7. Heads: (a) SA-516-70 (b)
(Mat'l Spec. No., Grade or Type) H.T. - Time & Temp (Mat'l Spec. No., Grade or Type) H.T. - Time & Temp

	Location (Top, Bottom, Ends)	Thickness		Radius		Elliptical Ratio	Conical Apex Angle	Hemispherical Radius	Flat Diameter	Side to Pressure		Category A		
		Min.	Corr.	Crown	Knuckle					Convex	Concave	Type	Full, Spot, None	Eff.
(a)	END	7/16"	1/8"			2:1					X	S	NONE	1.0
(b)														

If removable, bolts used (describe other fastening)

(Mat'l Spec. No., Grade, size, No.)

8. Type of jacket Jacket closure
(Describe as ogee & weld, bar, etc.)
If bar, give dimensions If bolted, describe or sketch.

9. MAWP 314 15 psi at max. temp. 450 366 °F Min. design metal temp. 0 °F at 314 psi.
(internal) (external) (internal) (external)

Impact test NO; SHELL SIDE DESIGNED PER UCS-66(a)(c)(g) & UG-20(f) at test temperature of --- °F
(Indicate yes or no and the component(s) impact tested)

11. Hydro., ~~press.~~, ~~test press.~~ test press. 408 PSIG Proof test ---

Items 12 and 13 to be completed for tube sections.

12. Tubesheet: SA-516-70N 34 3/4 3" 5/16 BOLTED
Stationary (Mat'l Spec. No.) Dia., in. (subject to press.) Nom. thk., in. Corr. Allow., in. Attachment (welded or bolted)

Floating (Mat'l Spec. No.) Dia., in. Nom. thk., in. Corr. Allow., in. Attachment

13. Tubes: SA-179 3/4 .083" (MIN) 385 U
Mat'l Spec. No., Grade or Type O.D., in. Nom. thk., in. or gauge Number Type (Straight or U)

Items 14 - 18 incl. to be completed for inner chambers of jacketed vessels or channels of heat exchangers.

14. Shell (a) No. of course(s): 1 (b) Overall length (ft & in.): 1'-11"

Course(s)			Material	Thickness		Long. Joint (Cat. A)			Circum. Joint (Cat. A, B & C)			Heat Treatment	
No.	Diameter, in.	Length (ft & in.)	Spec./Grade or Type	Nom.	Corr.	Type	Full, Spot, None	Eff.	Type	Full, Spot, None	Eff.	Temp.	Time
1	34" I.D.	1'-11"	SA-516-70	1/2"	1/8"	1	SPOT	.85	1	SPOT	.85	...	...

15. Heads: (a) SA-516-70N (b)
(Mat'l Spec. No., Grade or Type) H.T. - Time & Temp (Mat'l Spec. No., Grade or Type) H.T. - Time & Temp

[Name of Specimen, Grade of Type, N.T., Time & Temp]														
	Location (Top, Bottom, Ends)	Thickness		Radius		Elliptical Ratio	Conical Apex Angle	Hemispherical Radius	Flat Diameter	Side to Pressure		Category A		
		Min.	Corr.	Crown	Knuckle					Convex	Concave	Type	Full, Spot, None	Eff.
(a)	END	3 1/8"	3/16"						34 3/4"					
(b)														

If removable, bolts used (describe other fastening) (a) SA-193-B7, 3/4", 48.; CHAN-TO-SHELL: SA-193-B7, 3/4", 48

(Mat'l Spec. No., Grade, Size, No.)

16. MAWP 301 15 psi at max. temp. 480 366 °F Min. design metal temp. 0 °F at 301 psi.
(internal) (external) (internal) (external)

17. Impact test NO; CHANNEL SIDE DESIGNED PER UCS-66(a)(c)(g) & UG-20(f) at test temperature of ... °F
(Indicate yes or no and the component(s) impact tested)

18. Hydro., ~~###~~, ~~####~~ test press. 391 PSIG Proof test ---

19. Nozzles, inspection, and safety valve openings:

Purpose (Inlet, Outlet, Drain, etc.)	No.	Diameter or Size	Flange Type	Material		Nozzle Thickness		Reinforcement Material	How Attached		Location (Insp. Open.)
				Nozzle	Flange	Nom.	Corr.		Nozzle	Flange	
INLET/OUTLET	1/1	8" 300#	RFWN	SA-106-B	SA-105	.500"	1/8"	SA-516-70	WELDED	WELDED	CHANNEL
T.W./P.G.	2/2	1 1/2" 300#	RFLWN	SA-105	---	.630"	1/8"	WELD	WELDED	---	CH. NOZS.
INLET/OUTLET	1/1	8" 300#	RFWN	SA-106-B	SA-105	.500"	1/8"	SA-516-70	WELDED	WELDED	SHELL
T.W./P.G.	2/2	1 1/2" 300#	RFLWN	SA-105	---	.630"	1/8"	WELD	WELDED	---	SH. NOZS.

20. Supports: Skirt NO Lugs --- Legs --- Others (2) BELLY BANDS Attached SHELL; WELDED
(Yes or No) (No.) (No.) (Describe) (Where and How)

21. Manufacturer's Partial Data Reports properly identified and signed by Commissioned Inspectors have been furnished for the following items of the report:
(List the name of part, item number, mfg's. name and identifying number)

22. Remarks: SERVICE: DEBUTANIZER FEED BOTTOMS EXCHANGER, P.O. NO: 56603-P-12-04, ITEM NO: E-645 C, SIZE: 34-240, TYPE: AEU

TUBES DESIGNED W/ 0" C.A. PRESSURE RELIEF DEVICES PROVIDED BY OTHERS.

LINES 6-11 INCLUDE (1) 39 1/4 O.D. x 34 I.D. x 4 9/16" THK., SA-105N, RING

LINES 14-18 INCLUDE (2) 39 1/4" O.D. x 34" I.D. x 4 9/16" THK., SA-105N, RING;

CERTIFICATE OF SHOP COMPLIANCE

We certify that the statements made in this report are correct and that all details of design, material, construction, and workmanship of this vessel conform to the ASME Code for Pressure Vessels, Section VIII, Division 1,

U Certificate of Authorization No.

12370

Expires

9/27/2007

Date 3-12-07 Name ENERGY EXCHANGER COMPANY

(Manufacturer)

Signed

[Signature]
(Representative)

CERTIFICATE OF SHOP INSPECTION

I, the undersigned, holding a valid commission issued by The National Board of Boiler and Pressure Vessel Inspectors and the State or Province of OKLAHOMA and employed by OneBeacon America Insurance Company of BOSTON, MASS. have inspected the pressure vessel described in this Manufacturer's Data Report on 3-12-07, and state that, to the best of my knowledge and belief, the Manufacturer has constructed this pressure vessel in accordance with ASME Code, Section VIII, Division 1. By signing this certificate neither the Inspector nor his employer makes any warranty, expressed or implied, concerning the pressure vessel described in this Manufacturer's Data Report. Furthermore, neither the inspector nor his employer shall be liable in any manner for any personal injury or property damage or a loss of any kind arising from or connected with this inspection.

Date 3-12-07

Signed

[Signature]

Commissions N.B.# 11921 BA OKLA.# 823

(Authorized Inspector)

(Nat'l Board incl. endorsement, State, Province and No.)

CERTIFICATE OF FIELD ASSEMBLY COMPLIANCE

We certify that the statements on this report are correct and that the field assembly construction of all parts of this vessel conforms with the requirements of ASME Code, Section VIII, Division 1,

U Certificate of Authorization No.

Expires

Date _____ Name _____

Signed

(Assembler)

(Representative)

CERTIFICATE OF FIELD ASSEMBLY INSPECTION

I, the undersigned, holding a valid commission issued by The National Board of Boiler and Pressure Vessel Inspectors and the State or Province of _____ and employed by _____ of _____ have compared the statements in this Manufacturer's Data Report with the described pressure vessel and state that parts referred to as data items _____, not included in the certificate of shop inspection, have been inspected by me and to the best of my knowledge and belief, the Manufacturer has constructed and assembled this pressure vessel in accordance with ASME Code, Section VIII, Division 1. The described vessel was inspected and subjected to a hydrostatic test of _____ psi. By signing this certificate neither the Inspector nor his employer makes any warranty, expressed or implied, concerning the pressure vessel described in this Manufacturer's Data Report. Furthermore, neither the Inspector nor his employer shall be liable in any manner for any personal injury or property damage or a loss of any kind arising from or connected with this inspection.


Date _____ Signed _____

Commissions

(Authorized Inspector)

(Nat'l Board incl. endorsement, State, Province and No.)

15 5259

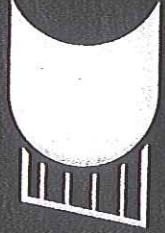

CERTIFIED BY
Energy Exchanger Company
TULSA, OKLAHOMA

MAWP SHELL	314 #	P.S.I.G. @	450 #	OF	408	TEST P.S.I.G.	
MAWP TUBE	301 #	P.S.I.G. @	480 #	OF	391	TEST P.S.I.G.	
MIN. DESIGN METAL TEMP.	0					314 #	P.S.I.G.
	0					301 #	P.S.I.G.
SERIAL NO.	X-7265 C					YEAR BUILT	2007
P.O. NO.	56603-P-12-04						
SERVICE	DEBUTANIZER FEED BOTTOMS EXCHANGER						
ITEM	1E-645 C	SIZE	34-240	TYPE	AEU		

* MAX. ALLOW. EXT. PRESS. = 15 PSIG @ 366° F

550

John Campbell