

Energy Exchanger Company





HEAT EXCHANGER SPECIFICATION SHEET

#1057507

P.O. No.: 56603-P-12-04

REV. 0 AS PURCHASED

Customer	SHAW STONE & WEBSTER (GIANT)		Job No.:	X-7265 "AS BUILT"	
Address	HOUSTON, TX		Rev.:	1	Date: 3/13/07
Plant Location	GRAFTON, VA		File:	06-6102	
Service of Unit	DEBUTANIZER FEED/BOTTOMS EXCHANGER		Item:	E-645 A/B/C/D/E	
Size	34-240	Type	AEU	Horizontal	Connected In 1 Parallel 5 Series
Surf./Unit	Gross / ☒ Eff	14164.78 ft ²	Shells/Unit	5	Surf./Shell Gross ☒ Eff. 2832.96 ft ²
PERFORMANCE OF ONE UNIT					
Fluid Allocation	Shell Side		Tube Side		
Fluid Name	DEBUTANIZER FEED		DEBUTANIZER BOTTOMS		
Fluid Quantity, Total	lb/hr	312999	297443		
Vapor (In/Out)		19071			
Liquid	312999	293928	297443	297443	
Steam					
Water					
Noncondensable					
Temperature (In/Out)	°F	121.	349.0	406.	170.
Density (Vapor/Liquid)	Lb/Ft ³	42.95	2.3600	34.11	31.47
Viscosity	cP	0.331	0.0130	0.124	0.10
Molecular Weight					
Molecular Weight, Noncondensable					
Specific Heat	Btu/lb-F	0.5160	0.5930	0.714	0.7960
Thermal Conductivity	Btu/hr-ft-F	0.0660	0.0200	0.047	0.0440
Latent Heat	Btu/lb				
Inlet Pressure	psia	291.7		269.7	
Velocity	ft/sec			3.41	
Pressure Drop, Allow./Calc.	psi	25.00	/	19.00	25.00 / 8.00
Fouling Resistance (Min.)	Hr-Ft ² -°F/Btu	0.002		0.002	
Heat Exchanged	45260000	Btu/hr; M.T.D. (Corrected)	43.25	°F	
Transfer Rate, Service	73.87	Btu/hr-ft ² -F; Clean		Btu/hr-ft ² -F	
CONSTRUCTION OF ONE SHELL			Sketch (Bundle/Nozzle Orientation)		
Design/Test Pressure	psig	310/FV/408	300/FV/391		
Design Temperature (Max/Min)	°F	450/366/0	480/366/0		
No. Passes Per Shell		1	2		
Corrosion Allowance	inch	0.125	0.125		
Connections	In	1 - 8" 300RF	1 - 8" 300RF		
Size & Rating	Out	1 - 8" 300RF	1 - 8" 300RF		
	Intermediate	(2) 1 - 10" 300RF	1 - 8" 300RF		
Tube No.	365 U'S	OD 0.75 in; Thk. ☒ Min	Avg 0.083 in; Length 20. ft; Pitch 1 in 90°		
Tube Type	BARE	Material	SA-179		
Shell	SA-516-70	☒ ID	OD 34. in ; Shell Cover SA-516-70	☒ Integ.	Remov.
Channel or Bonnet	SA-516-70	Channel Cover	SA-516-70 N	☒ Integ.	☒ Remov.
Tubesheet-Stationary	SA-516-70 N	Tubesheet - Floating			
Floating Head Cover		Impingement Protection	PLATE ON BUNDLE		
Baffles-Cross	16 - SA-516-70	Type V SEG	% Cut (☒ Dia. ☒ Area)	20. Spacing c/c 12.94	Inlet in
Baffles-Long		Seal Type			
Supports - Tube	SA-516-70	U-Bend YES	Type FULL		
Bypass Seal Arrangement		Tube-Tubesheet Joint	ROLLED		
Expansion Joint		Type			
pv ² - Inlet Nozzle		Bundle Entrance	Bundle Exit		
Gaskets - Shell Side	S.I. D.J.F.G.F	Tube Side	S.I. D.J.F.G.F.		
	- Floating Head				
Code Requirements	ASME SECTION VIII, DIV. 1 CODE STAMP		TEMA Class	R	
Weight/Shell	19,000 lb. EACH	Filled With Water	27,550 lb. EACH	Bundle	11,100 lb. EACH
REMARKS					
(1) DELETED.					
(2) 10" OUTLET ON SHELL "D". 10" INLET AND OUTLET ON SHELL "E"					
(3) 5 ROW PARTIAL SUPPORT AT SHELL NOZZLE CENTERLINES					
(4) PROVIDE (2) 1-1/2" X 300# RFLWN ON EACH OF INLET AND OUTLET (TUBESIDE AND SHELLSIDE) NOZZLES OF EACH INDIVIDUAL SHELL (EXCHANGER).					
(5) TIE ROD SPACER SLEEVES SHALL BE SCH. 40 PIPE THICKNESS.					
(6) SHELLSIDE SHALL BE DESIGNED FOR HYDROGEN SERVICE.					

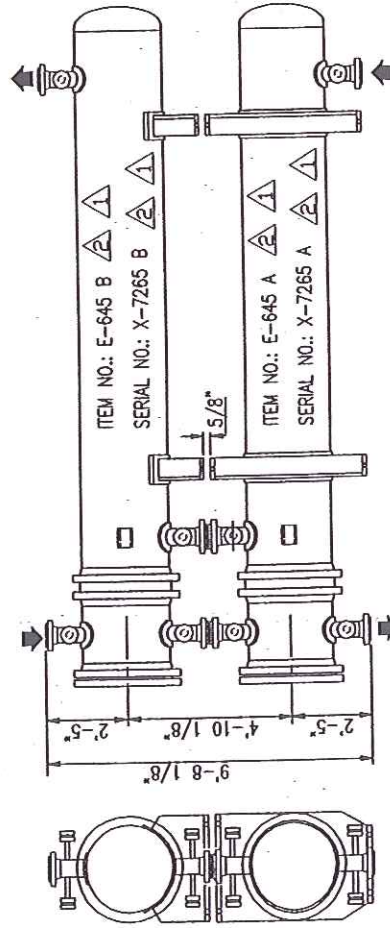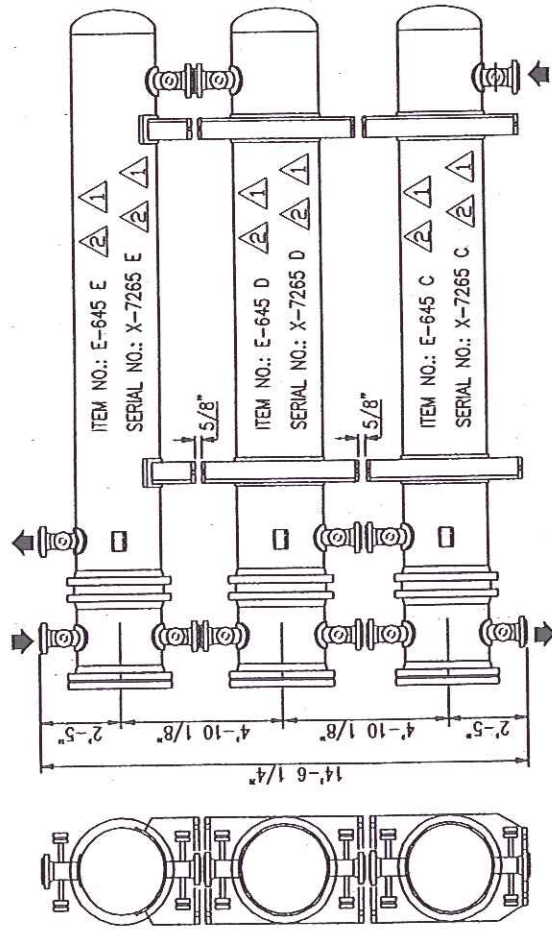

NOTE:
1) SHIMS, GASKETS & BOLTING FOR STACKING SHALL BE FURNISHED BY ENERGY.
2) HYDROTEST IN THE STACKED POSITION.

CERTIFIED AS-BUILT
D.D. CARLO 4/24/07

SERIAL NO.: X-7265-A, B, C, D, E
CUSTOMER: D-COK / GIANT INDUSTRIES
P.O. NO.: 56603-P-12-04
ITEM NO.: E-645 A, B, C, D, E
SERVICE: DEBUTANIZER FEED BOTTOMS EXCHANGER
SHIP TO: GRAFTON, VA


Shaw Stone & Webster, Inc.		PROJECT TITLE: GIANT S 2008
SSW 120653-P-12-04 (7110-01)	JOB NO. 120653	
EQUIPMENT No. 1 56603-P-12-04 (7110-01)		ISSUE 1
☐ FOR INFORMATION	☐ ACCEPTED FOR CIVIL AND PIPING IFC	
☐ ACCEPTED	☐ ACCEPTED AS CERTIFIED	
☐ ACCEPTED AS NOTED	☐ REVISE AND RESUBMIT	
SIGNED 1		
DATE 1		
THE ACCEPTANCE OF THIS DATA BY SHAW STONE & WEBSTER DOES NOT RELIEVE THE CONTRACTOR OR SUPPLIER FROM THE OBLIGATIONS IMPOSED BY THE PURCHASER ORDER OR CONTRACT.		

STACKING ARRANGEMENTS

DWN. BY	Date	 Energy Exchanger Co. 1544 No. Carpent Rd. - Tulsa, Okla. 74116
DATE	8/12/06	
CKD. BY	GH	DWG. NO. X-7265-A6
		REV. 2

NO.	DATE	REVISIONS
1	12/18/06	REV. PER CUSTOMER COMMENTS Dan/AD
2	10/10/06	REV. PER CUSTOMER COMMENTS Dan/DID

DRILL & TAP 3/4" DEEP FOR (8) -1/2" Ø TIE
RODS ON SHELL SIDE OF # 4 TUBESHEET.
DO NOT DRILL THRU !!
(SEE TUBE LAYOUT FOR LOCATIONS)

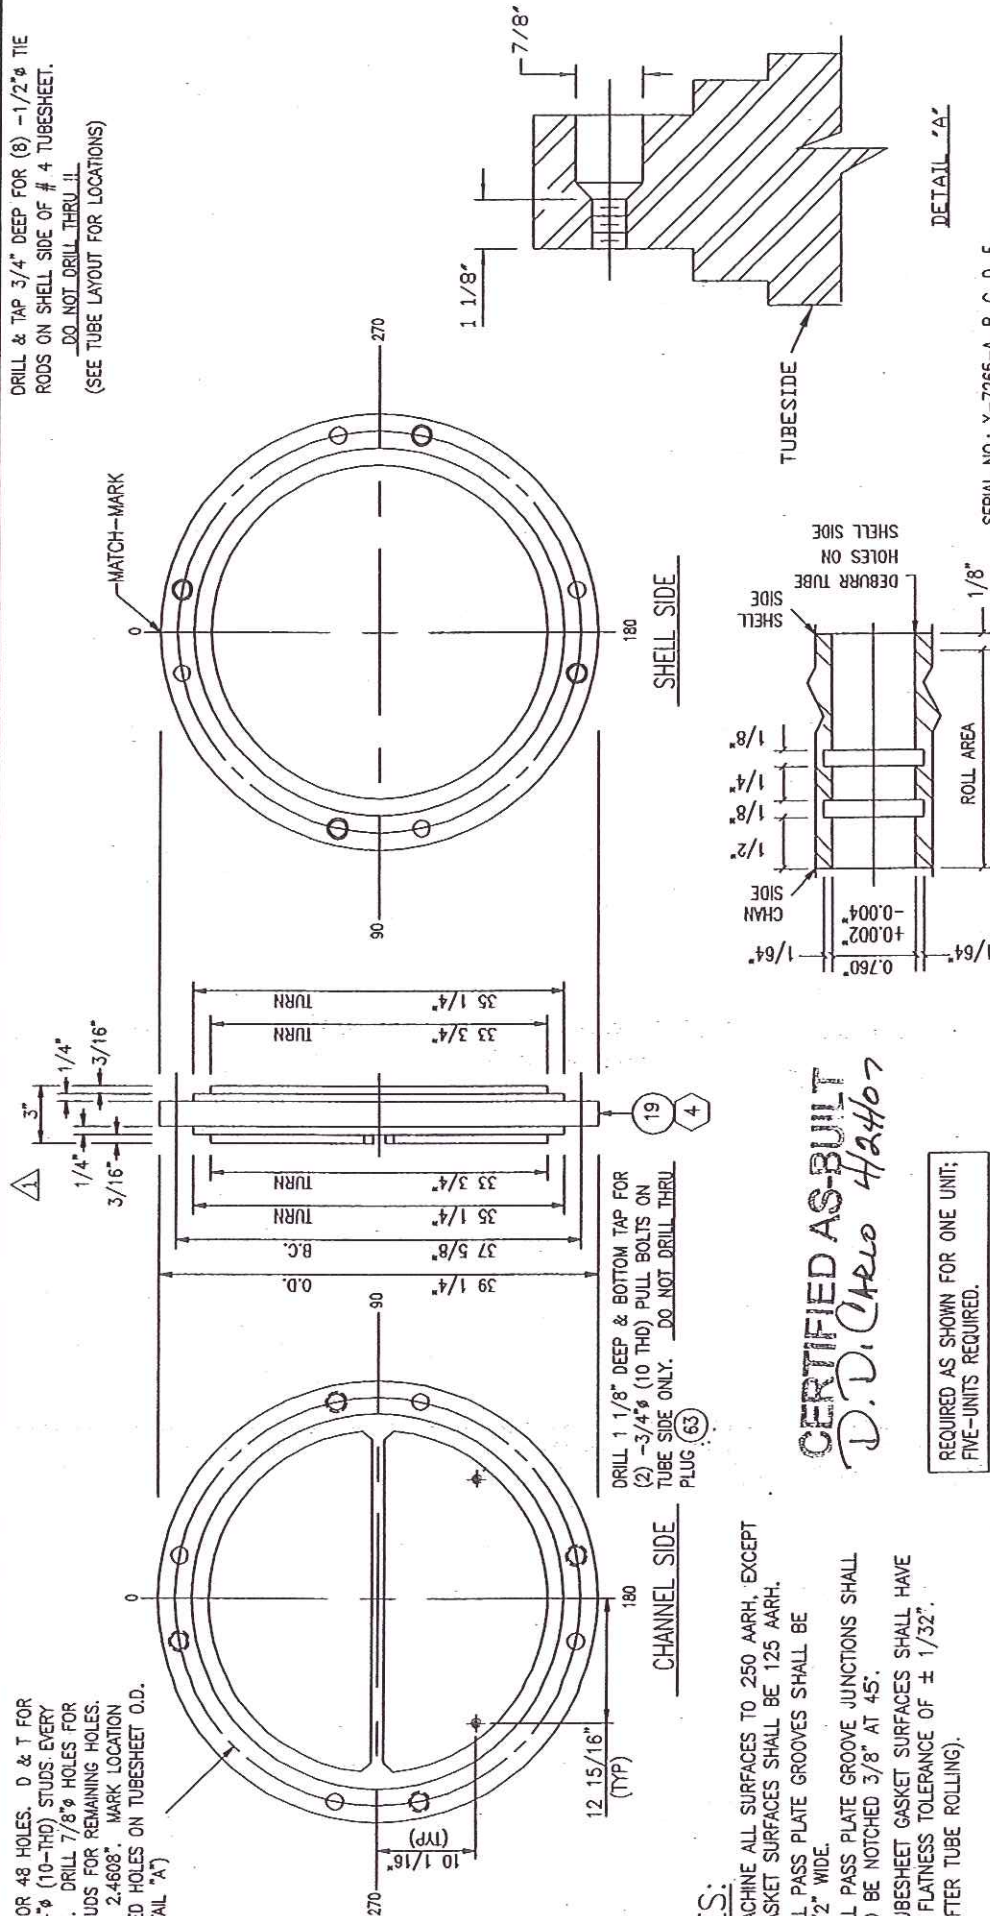

- 1) MACHINE ALL SURFACES TO 250 AARH, EXCEPT GASKET SURFACES SHALL BE 125 AARH.
- 2) ALL PASS PLATE GROOVES SHALL BE $1\frac{1}{2}$ " WIDE.
- 3) ALL PASS PLATE GROOVE JUNCTIONS SHALL TO BE NOTCHED $3/8"$ AT 45° .
- 4) TUBESHEET GASKET SURFACES SHALL HAVE A FLATNESS TOLERANCE OF $\pm 1/32"$.
(AFTER TUBE ROLLING).

REQUIRED AS SHOWN FOR ONE UNIT;
FIVE-UNITS REQUIRED.

CERTIFIED AS-BUILT
D.D. Carlo 4/24/07

 Shaw Stone & Webster, Inc.	PROJECT TITLE: GRANT S 20R8
	JOB No. 120653
SSW 120653-P-12-04 (1110-01)	ISSUE 1
EQUIPMENT No. 1 56603-P-12-04 (1110-01)	☐ ACCEPTED FOR CIVIL AND PIPING IFC ☐ ACCEPTED AS CERTIFIED ☐ REVISE AND RESUBMIT
☐ FOR INFORMATION ☐ ACCEPTED ☐ ACCEPTED AS NOTED	SIGNED 1
DATE 1	
THE ACCEPTANCE OF THIS DATA BY SHAW STONE & WEBSTER DOES NOT RELIEVE THE CONTRACTOR OR SUPPLIER FROM THE OBLIGATIONS IMPOSED BY THE PURCHASER ORDER	


SERIAL NO.: X-7265-A, B, C, D, E
CUSTOMER: D-COK / GIANT INDUSTRIES
P. O. NO.: 56803-P-12-04
ITEM NO.: E-645 A, B, C, D, E
SERVICE: DEBRITANIZER FEED BOTTOMS EXCHANGER
SHIP TO: GRAFTON, VA

TUBESHEET DETAILS



Energy Exchanger Co.
1344 No. Cornett Rd. - Tulsa, Okla. 74116

CKD. BY M.Carlo	DWG. NO. X-7265-E	REV. 1
--------------------	----------------------	-----------

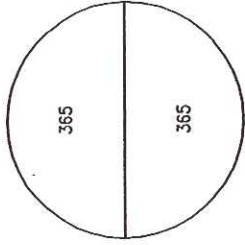

TUBE DISTRIBUTION

NOTES:


- 1) DRILL AND REAM TUBE HOLES IN TUBESHEET TO 0.760" + 0.002", - 0.004" DIA. FOR 365 - 3/4" O.D. U-TUBES. TOTAL HOLES = 730.
- 2) TUBE PITCH = 1" SQUARE.
- 3) NUMBER OF PASSES = 2.
- 4) SEE DRAWING X-7265-E FOR TUBE GROOVING DETAILS.
- 5) BAFFLE O.D. = 33 13/16".
- 6) O.T.L. = 33 1/2".

SERIAL NO.: X-7265-A, B, C, D, E
 CUSTOMER: D-COK / GIANT INDUSTRIES
 P. O. NO.: 56603-P-12-04
 ITEM NO.: E-645 A, B, C, D, E
 SERVICE: DEBUTANIZER FEED BOTTOMS EXCHANGER
 SHIP TO: GRAFTON, VA

PROJECT TITLE: GIANT S ZORR	
Stone & Webster, Inc.	JOB No. 120653
SSN 120653-P-12-04	CT110-01
EQUIPMENT No. 1	56603-P-12-04
CT110-01	ISSUE 1
☐ FOR INFORMATION	☐ ACCEPTED FOR CIVIL AND PIPING IFC
☐ ACCEPTED	☐ ACCEPTED AS CERTIFIED
☐ ACCEPTED AS NOTED	☐ REVISE AND RESUBMIT
SIGNED:	
DATE:	
THE ACCEPTANCE OF THIS DATA BY SHAW STONE & WEBSTER DOES NOT RELIEVE THE CONTRACTOR OR SUPPLIER FROM THE OBLIGATIONS IMPOSED BY THE PURCHASER ORDER OR CONTRACT.	

TUBE LAYOUT

- SEAL BAR NOTES:
- 1) CUT SLOTS IN BAFFLES ONLY.
 - 2) CUT SLOTS 5/16" WIDE.
 - 3) CUT SLOT DEPTHS [SEAL BAR WIDTH + 1/16"] FROM OUTSIDE EDGE OF SLOT.

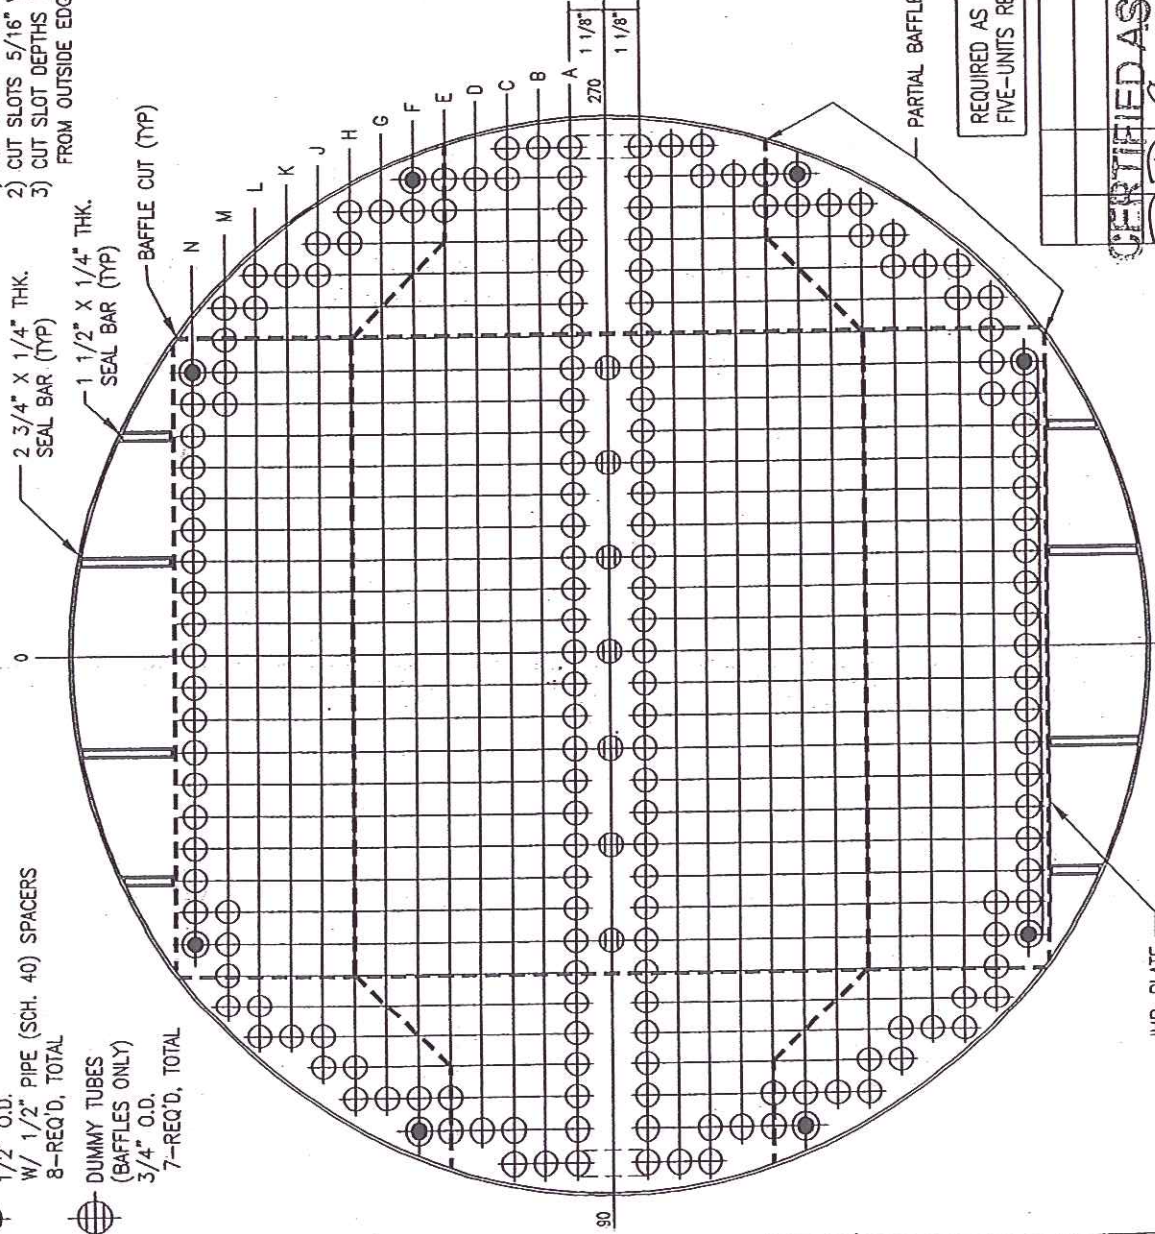

CERTIFIED AS BUILT
 D. J. Chico 4/24/07



DOWN. BY	Dave
DATE	9/11/06
CKD. BY	D. Chico
DWG. NO.	X-7265-F
REV.	0

VIEW LOOKING AT SHELL SIDE OF NO. #4 TUBESHEET

19'-11 7/8" - FACE TUBESHEET-TO-BEND TANGENT (ROW "A")

15 SPACES AT 1'-0 15/16" = 16'-2 1/16"

1'-8 15/16"

7 3/8"

1'-1 5/16"

6 1/8"

1'-1 5/16"

6 1/8"

1'-1 5/16"

1'-9"

11 1/2"

1"

6 1/32"

1'-9"

11 1/2"

1"

6 1/32"

1'-9"

1'-9"

11 1/2"

1"

6 1/32"

1'-9"

11 1/2"

1"

6 1/32"

1'-9"

1'-9"

11 1/2"

1"

6 1/32"

1'-9"

11 1/2"

1"

6 1/32"

1'-9"

1"

3"

1"

3"

1"

"A"

1"

3"

1"

3"

1/2" O.D. TIE RODS

23

"A"

REQ'D

8

19'-10 1/4"

"B"

1/2"-Sch. 40 PIPE SPACERS

23A

PLAN VIEW

ELEVATION VIEW

SEAL BARS - 4-REQUIRED (2-TOP, 2-BOTTOM)

1 1/2" x 1/4" THK x 16'-4 9/16" LG. (WELD CONTINUOUSLY TO EACH BAFFLE, ONE SIDE)

22S

SEAL BARS - 4-REQUIRED (2-TOP, 2-BOTTOM)

1 1/2" x 1/4" THK x 16'-4 9/16" LG. (WELD CONTINUOUSLY TO EACH BAFFLE, ONE SIDE)

22E

DUMMY TUBES - 7-REQUIRED

3/4" O.D. x 16'-4 9/16" LG. (WELD TO FIRST TWO BAFFLES & CRIMP OPPOSITE ENDS)

22D

IMPINGEMENT PLATE - 2-REQUIRED

11 3/4" x 1/4" THK x 18" LG. (SPLIT & WELD TO SPACERS & PART. BAFs.)

22I

1/8" ± 1/16" TUBE PROJECTION

21

PART. BAF. DD

1/2" RAD. (TYP)

PART. BAF. CC

SUPT. PL

CC

1/2" RAD. (TYP)

PART. BAF. CC

SUPT. PL

CC

1'-8 15/16"

7 3/8"

1'-1 5/16"

6 1/8"

1'-1 5/16"

6 1/8"

1'-1 5/16"

FORM U-1 MANUFACTURER'S DATA REPORT FOR PRESSURE VESSELS
As Required by the Provisions of the ASME Code Rules, Section VIII, Division 1

1. Manufactured and certified by ENERGY EXCHANGER COMPANY, 1844 NORTH GARNETT ROAD, TULSA, OK 74116
(Name and address of Manufacturer)

2. Manufactured for D-COK LLC, 3657 BRIAR PARK DRIVE, HOUSTON, TEXAS 77042-5205
(Name and address of Purchaser)

Location of installation GIANT INDUSTRIES, GRAFTON, VIRGINIA
(Name and address)

4. Type: HORIZONTAL HEAT EXCHANGER X-7265-D X-7265-A4 REV. 3 5260 2007
(Horiz., vert., or sphere) (Tank, separator, jkt. vessel, heat exh., etc.) (Mfg's serial No.) (CRN) (Drawing No.) (Nat'l. Bd. No.) (Year built)

5. ASME Code, Section VIII, Div. 1 2004 EDITION, 2005 ADDENDA 2519
Edition and Addenda (date) Code Case No. Special Service per UG-120(d)

Items 6 - 11 incl. to be completed for single wall vessels, jackets of jacketed vessels, shell of heat exchangers, or chamber of multi-chamber vessels.

6. Shell (a) No. of course(s): 3 (b) Overall length (ft & in.): 20'-11 1/8"

No.	Course(s)		Material Spec./Grade or Type	Thickness		Type	Long. Joint (Cat. A)		Type	Circum. Joint (Cat. A, B & C)		Heat Treatment	
	Diameter, in.	Length (ft & in.)		Nom.	Corr.		Full	Spot, None		Eff.	Full	Spot, None	Eff.
2	34" I.D.	8'-0"	SA-516-70	1/2"	1/8"	1	SPOT	.85	1	SPOT	.85	...	...
1	34" I.D.	4'-11 1/8"	SA-516-70	1/2"	1/8"	1	SPOT	.85	1	SPOT	.85	...	...

7. Heads: (a) SA-516-70 (b) SA-516-70
(Mat'l Spec. No., Grade or Type) H.T. - Time & Temp (Mat'l Spec. No., Grade or Type) H.T. - Time & Temp

	Location (Top, Bottom, Ends)	Thickness		Radius		Elliptical Ratio	Conical Apex Angle	Hemispherical Radius	Flat Diameter	Side to Pressure		Category A		
		Min.	Corr.	Crown	Knuckle					Convex	Concave	Type	Full	Spot, None
(a)	END	7/16"	1/8"			2:1					X	S	NONE	1.0
(b)														

If removable, bolts used (describe other fastening) SA-516-70
(Mat'l Spec. No., Grade, size, No.)

8. Type of jacket SA-516-70 Jacket closure SA-516-70
(Describe as ogee & weld, bar, etc.)

If bar, give dimensions SA-516-70 If bolted, describe or sketch. SA-516-70

9. MAWP 314 15 psi at max. temp. 450 366 °F Min. design metal temp. 0 °F at 314 psi.
(internal) (external) (internal) (external)

Impact test NO; SHELL SIDE DESIGNED PER UCS-66(a)(c)(g) & UG-20(f) at test temperature of ... °F
(Indicate yes or no and the component(s) impact tested)

11. Hydro., ~~PROV. UNKNOWN~~ test press. 408 PSIG Proof test ...

Items 12 and 13 to be completed for tube sections.

12. Tubesheet: SA-516-70N 34 3/4 3" 5/16 BOLTED
Stationary (Mat'l Spec. No.) Dia., in. (subject to press.) Nom. thk., in. Corr. Allow., in. Attachment (welded or bolted)

SA-516-70N 34 3/4 3" 5/16 BOLTED
Floating (Mat'l Spec. No.) Dia., in. Nom. thk., in. Corr. Allow., in. Attachment

13. Tubes: SA-179 3/4 .083" (MIN) 365 U
Mat'l Spec. No., Grade or Type O.D., in. Nom. thk., in. or gauge Number Type (Straight or U)

Items 14 - 18 incl. to be completed for inner chambers of jacketed vessels or channels of heat exchangers.

14. Shell (a) No. of course(s): 1 (b) Overall length (ft & in.): 1'-11"

No.	Course(s)		Material Spec./Grade or Type	Thickness		Type	Long. Joint (Cat. A)		Type	Circum. Joint (Cat. A, B & C)		Heat Treatment	
	Diameter, in.	Length (ft & in.)		Nom.	Corr.		Full	Spot, None		Eff.	Full	Spot, None	Eff.
1	34" I.D.	1'-11"	SA-516-70	1/2"	1/8"	1	SPOT	.85	1	SPOT	.85	...	...

15. Heads: (a) SA-516-70N (b) SA-516-70N
(Mat'l Spec. No., Grade or Type) H.T. - Time & Temp (Mat'l Spec. No., Grade or Type) H.T. - Time & Temp

	Location (Top, Bottom, Ends)	Thickness		Radius		Elliptical Ratio	Conical Apex Angle	Hemispherical Radius	Flat Diameter	Side to Pressure		Category A		
		Min.	Corr.	Crown	Knuckle					Convex	Concave	Type	Full, Spot, None	Eff.
(a)	END	3 1/8"	3/16"						34 3/4"					
(b)														

If removable, bolts used (describe other fastening) SA-193-B7, 3/4", 48; CHAN-TO-SHELL: SA-193-B7, 3/4", 48
(Mat'l Spec. No., Grade, Size, No.)

16. MAWP 301 15 psi at max. temp. 480 366 °F Min. design metal temp. 0 °F at 301 psi.
(internal) (external) (internal) (external)

17. Impact test NO; CHANNEL SIDE DESIGNED PER UCS-66(a)(c)(g) & UG-20(f) at test temperature of ... °F
(Indicate yes or no and the component(s) impact tested)

18. Hydro., ~~PSIG~~, ~~test press.~~ 391-PSIG Proof test ...

19. Nozzles, inspection, and safety valve openings:

Purpose (Inlet, Outlet, Drain, etc.)	No.	Diameter or Size	Flange Type	Material		Nozzle Thickness		Reinforcement Material	How Attached		Location (Insp. Open.)
				Nozzle	Flange	Nom.	Corr.		Nozzle	Flange	
INLET/OUTLET	1/1	8" 300#	RFLWN	SA-106-B	SA-105	.500"	1/8"	SA-516-70	WELDED	WELDED	CHANNEL
T.W./P.G.	2/2	1 1/2" 300#	RFLWN	SA-105	---	.630"	1/8"	WELD	WELDED	---	CH. NOZS.
INLET	1	8" 300#	RFLWN	SA-106-B	SA-105	.500"	1/8"	SA-516-70	WELDED	WELDED	SHELL
OUTLET	1	10" 300#	RFLWN	SA-106-B	SA-105	.500"	1/8"	SA-516-70	WELDED	WELDED	SHELL
T.W./P.G.	2/2	1 1/2" 300#	RFLWN	SA-105	---	.630"	1/8"	WELD	WELDED	---	SH. NOZS.

20. Supports: Skirt NO Lugs --- Legs --- Others (2) BELLY BANDS Attached SHELL; WELDED
(Yes or No) (No.) (No.) (Describe) (Where and How)

21. Manufacturer's Partial Data Reports properly identified and signed by Commissioned Inspectors have been furnished for the following items of the report:
(List the name of part, item number, mfg's. name and identifying number)

22. Remarks: SERVICE: DEBUTANIZER FEED BOTTOMS EXCHANGER, P.O. NO: 56603-P-12-04, ITEM NO: E-645 D, SIZE: 34-240, TYPE: AEU

TUBES DESIGNED W/ 0" C.A. PRESSURE RELIEF DEVICES PROVIDED BY OTHERS.

LINES 6-11 INCLUDE (1) 39 1/4 O.D. x 34 I.D. x 4 9/16" THK., SA-105N; RING

LINES 14-18 INCLUDE (2) 39 1/4" O.D. x 34" I.D. x 4 9/16" THK., SA-105N, RING;

CERTIFICATE OF SHOP COMPLIANCE

We certify that the statements made in this report are correct and that all details of design, material, construction, and workmanship of this vessel conform to the ASME Code for Pressure Vessels, Section VIII, Division 1,
U Certificate of Authorization No. 12370 Expires 9/27/2007

Date 3-12-07 Name ENERGY EXCHANGER COMPANY
(Manufacturer)

Signed Edgar O. Owen
(Representative)

CERTIFICATE OF SHOP INSPECTION

I, the undersigned, holding a valid commission issued by The National Board of Boiler and Pressure Vessel Inspectors and the State or Province of OKLAHOMA and employed by OneBeacon America Insurance Company of BOSTON, MASS. have inspected the pressure vessel described in this Manufacturer's Data Report on 3-12-07, and state that, to the best of my knowledge and belief, the Manufacturer has constructed this pressure vessel in accordance with ASME Code, Section VIII, Division 1. By signing this certificate neither the Inspector nor his employer makes any warranty, expressed or implied, concerning the pressure vessel described in this Manufacturer's Data Report. Furthermore, neither the inspector nor his employer shall be liable in any manner for any personal injury or property damage or a loss of any kind arising from or connected with this inspection.

Date 3-12-07 Signed [Signature]
(Authorized Inspector)

Commissions N.B.# 11921 BA OKLA.# 823
(Nat'l Board incl. endorsement, State, Province and No.)

CERTIFICATE OF FIELD ASSEMBLY COMPLIANCE

We certify that the statements on this report are correct and that the field assembly construction of all parts of this vessel conforms with the requirements of ASME Code, Section VIII, Division 1,
U Certificate of Authorization No. --- Expires ---

Date --- Name ---
(Assembler)

Signed ---
(Representative)


CERTIFICATE OF FIELD ASSEMBLY INSPECTION

I, the undersigned, holding a valid commission issued by The National Board of Boiler and Pressure Vessel Inspectors and the State or Province of --- and employed by --- of --- have compared the statements in this Manufacturer's Data Report with the described pressure vessel and state that parts referred to as data items ---, not included in the certificate of shop inspection, have been inspected by me and to the best of my knowledge and belief, the Manufacturer has constructed and assembled this pressure vessel in accordance with ASME Code, Section VIII, Division 1. The described vessel was inspected and subjected to a hydrostatic test of --- psi. By signing this certificate neither the Inspector nor his employer makes any warranty, expressed or implied, concerning the pressure vessel described in this Manufacturer's Data Report. Furthermore, neither the Inspector nor his employer shall be liable in any manner for any personal injury or property damage or a loss of any kind arising from or connected with this inspection.

Date --- Signed ---
(Authorized Inspector)

Commissions ---
(Nat'l Board incl. endorsement, State, Province and No.)

5260

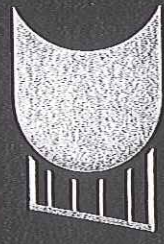

CERTIFIED BY
Energy Exchanger Company
TULSA, OKLAHOMA

MAWP SHELL	314 #	P.S.I.G. @	450 #	OF	408	TEST P.S.I.G.
MAWP TUBE	301 #	P.S.I.G. @	480 #	OF	391	TEST P.S.I.G.
MIN. DESIGN METAL TEMP.		SHELL	0	OF @	314 #	P.S.I.G.
		TUBE	0	OF @	301 #	P.S.I.G.

YEAR BUILT 2007

SERIAL NO.

X-7265 D

P.O. NO.

56603-P-12-04

SERVICE

DEBUTANIZER FEED BOTTOMS EXCHANGER

ITEM

E-164515

SIZE

34-240

TYPE

A E U

MAX. ALLOW. EXT. PRESS. = 15 PSIG @ 366° F

SSO
Jack Campbell