







DRAWING NO. DWG036512 REV. B

REVISIONS					
REV	DESCRIPTION	DATE	REV'D	CHKD	APPR
0	ORIGINAL RELEASE	190809	FCH	L.M	E.G
A	UP DATED PLAN 23/52/M	200809	IFCH	L.M	E.G
B	AS BUILT	200809	UPELL	L.M	E.G

ITEM	DESCRIPTION PLAN 23	MAT'L	QTY
1	GASKET, 75" 300/600 P.S.I.	DUPLEX	3
2	FLANGE, 75 SW R.F. - 600# SCH. 80	DUPLEX	8
3	VALVE, 75 SW 800#	DUPLEX	2
4	TUBE, 75 - SCH. 80	DUPLEX	-
5	REDUCTION SW 3/4"x1/2" #	DUPLEX	1
6	TUBO 1/2"-SCH160	DUPLEX	-
7	GASKET, 5" 300/600 P.S.I.	DUPLEX	1
8	FLANGE, 5 SW R.F. - 600# SCH. 80	DUPLEX	2
9	TUBO 1/2"-SCH80	DUPLEX	-

ITEM	DESCRIPTION PLAN 52	MAT'L	QTY
1	GASKET, 75" 300/600 P.S.I.	316L	4
2	FLANGE, 75 SW R.F. - 500# SCH. 80	316L	7
3	TEE, 75 SW R.F. - #3000	316L	1
4	VALVE, 75 SW 800#	316L	1
5	TUBE, 75 - SCH. 80	316L	-

ITEM	DESCRIPTION PLAN M	MAT'L	QTY
1	TUBE, 1"-SCH. 80	STEEL/GALVANIZED	-
2	TUBE, 75 - SCH. 80	STEEL/GALVANIZED	-
3	TUBO 1/2" SCH. 80	STEEL/GALVANIZED	-
4	REDUCTION 1"x3/4" NPT	STEEL/GALVANIZED	2
5	REDUCTION 1"x1/2" NPT	STEEL/GALVANIZED	2
6	CAP 1/2"NPT	STEEL/GALVANIZED	2
7	SOFT FLOW, 75	BRONZE	1
8	SOFT FLOW, 1/2"	BRONZE	1
9	UNION 1/2"NPT	STEEL/GALVANIZED	4
10	UNION 3/4"NPT	STEEL/GALVANIZED	4
11	TEE 1/2" NPT #3000	STEEL/GALVANIZED	1
12	TEE 1" NPT #3000	STEEL/GALVANIZED	2
13	GLOBE VALVE 3/4"NPT	BRONZE	1
14	GLOBE VALVE 1/2"NPT	BRONZE	1
15	GATE VALVE 1"NPT #250	BRONZE	2
16	FLANGE, 1"-NPT-A150-RF-SCH.80	STEEL/GALVANIZED	2
17	ELBOW 3/4" NPT #30	STEEL/GALVANIZED	3
18	ELBOW 1/2" NPT	STEEL/GALVANIZED	7
19	ELBOW 3/4 NPT #3000	STEEL/GALVANIZED	2

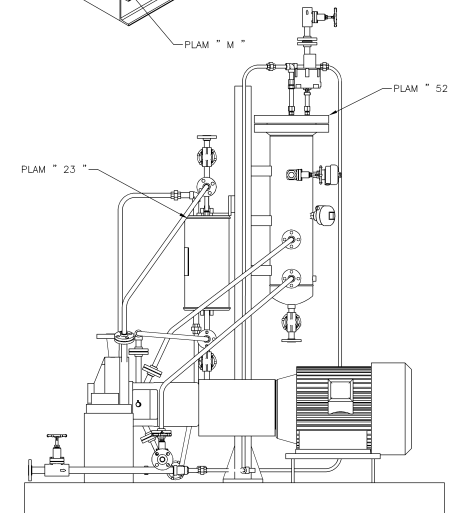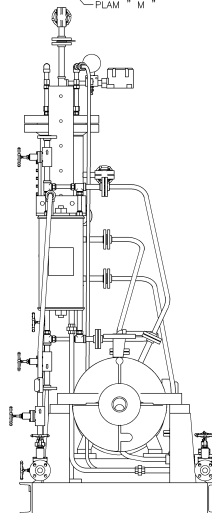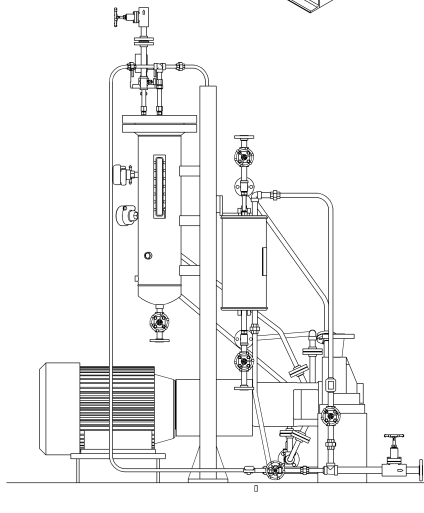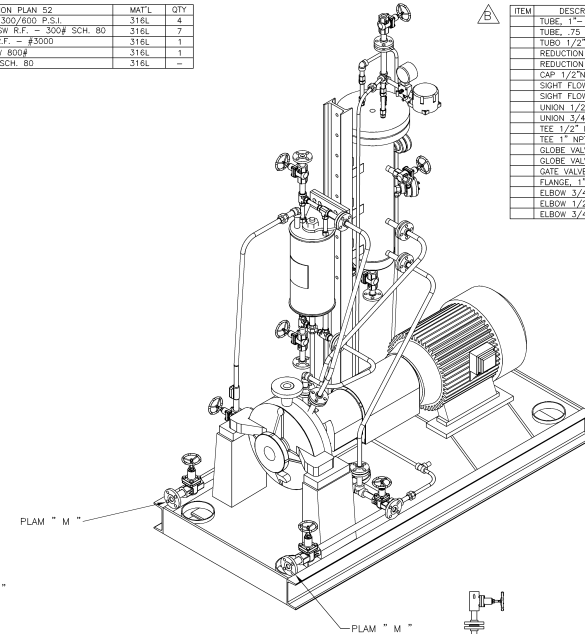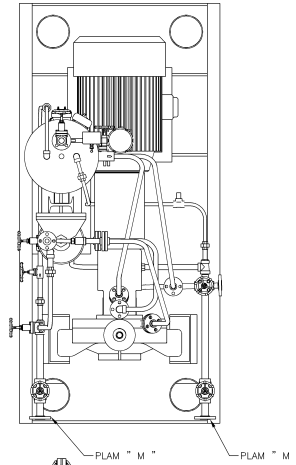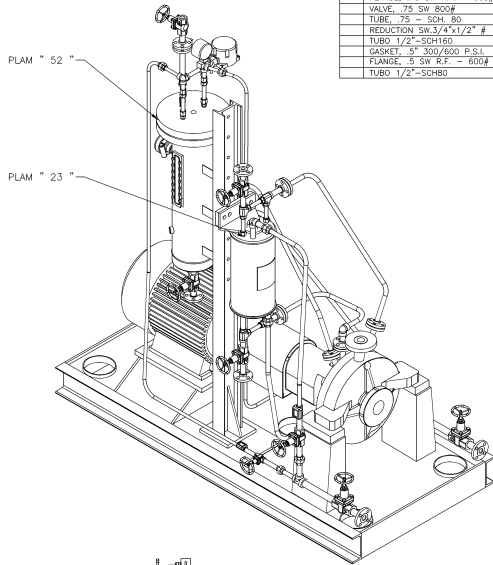

APPROVAL NOTE TO CUSTOMER		ORDER NO. CSHE0026	DRAWN BY: J. MENZ		DATE: 190809	DWG TITLE: PLAN 23/52/M
CHECKED BY: J. MENZ		DATE: 190809	DRAWN BY: J. MENZ		DATE: 190809	DWG TITLE: PLAN 23/52/M
3rd Angle Projection		PROPRIETARY NOTE	SIZE: A1	DRAWING NO. DWG036512	REV. B	SHEET NO. n/p
SCALE: 1		UNITS	SHEET NO.		n/p	