


BOTTOM OUTLET

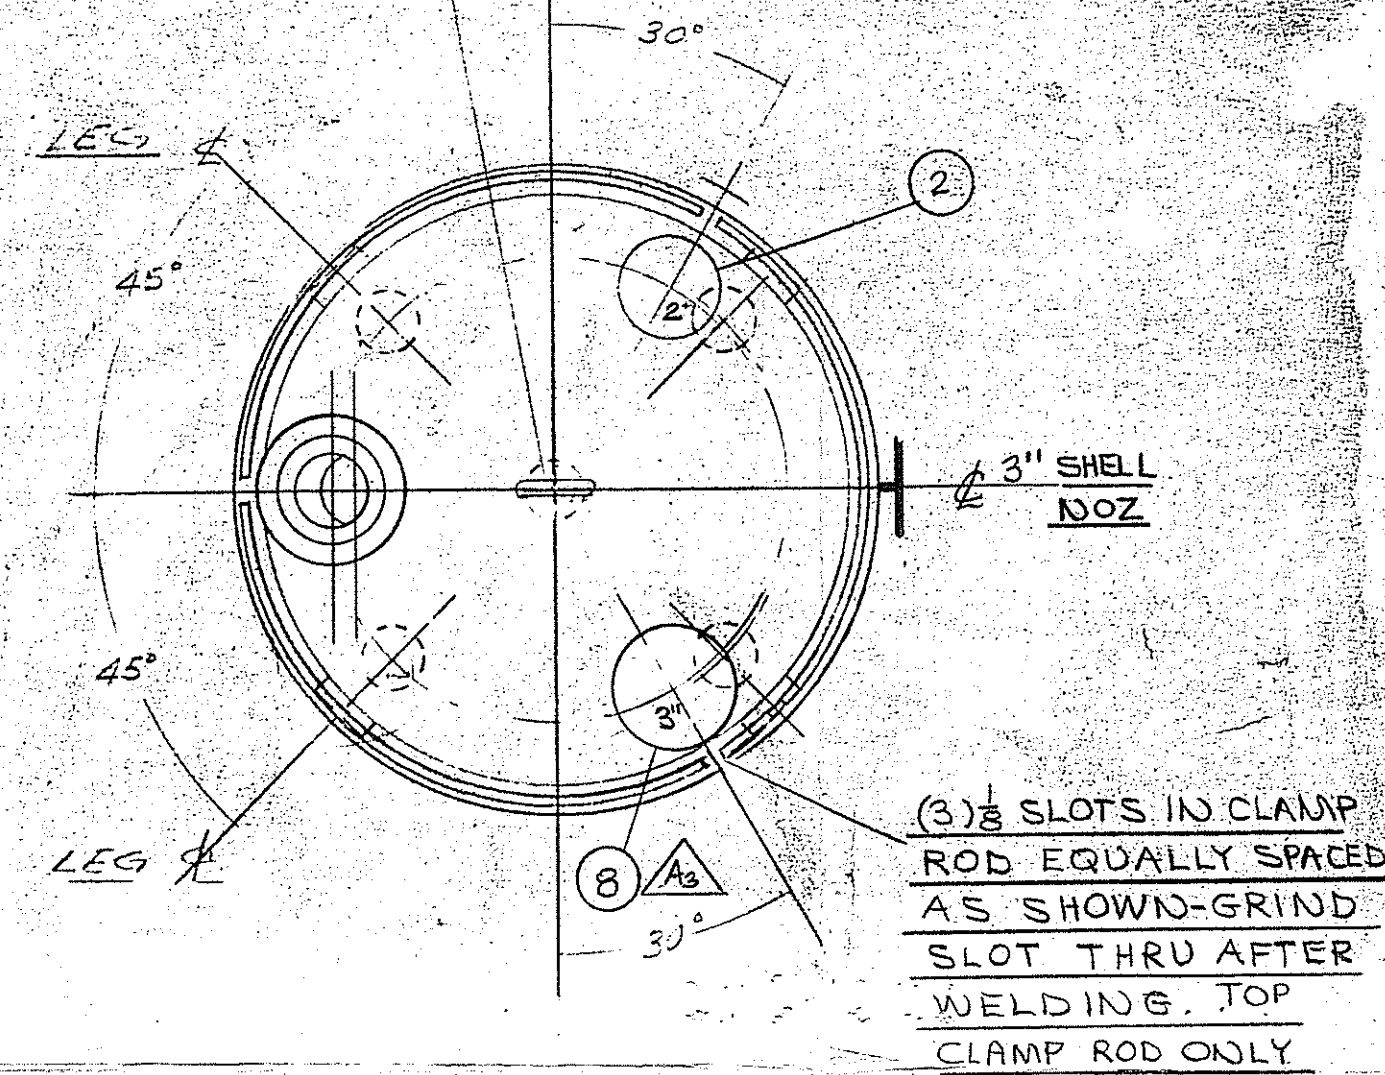


ITEM	QTY	PART NO.	DWG. NO.	DESCRIPTION
1	1	2099764	C	36" BLANK HEAD
2	1	2074526	A	2" FLANGED NOZZLE
3	1	1108364		4" FLG'D. NOZ.
4	1	1362164	1362160	4" HANDHOLE & PEEPHOLE ASS'Y.
5	52	2067141	A	CLAMPS
6	2	2052351	A	$\frac{3}{8}$ " DIA. CLAMP BAR
7	1	2080119	A	LIFTING LOOP
8	1	1100303		3" FLG'D. NOZ. (150 LB. ANSI FLG.)
9	1	2036521	C	36" HEAD SA 285 GR. B
10	8	2107936	A	FORK STRAP HRS
11	2	1100303		3" FLG'D. NOZ.
12	4	2086470	A	SOCKET FOR LEG CPL'G
13	4	2036521	A	LEG CPL'G (WELD AFTER GLASSING) 2" IPS
14	4	2070056	A	2" ADJ. NUT
15	4	2071319	C	2" C.I. LEG BASE
16	4	2071639	A	2" IPS STL PIPE LEG

BASE MATERIAL		
VESSEL	SA-285 GR. B	
JACKET		
SEALER		
THICKNESSES	TANK	JKT.
HD. TOP	4.275 MIN.	
HD. BOT.	2.18 MIN.	
SHELL	$\frac{5}{16}$	
SEALER		
DESIGN & INSPECTION		
SPECIFICATION	TANK	JKT.
ASME CODE	YES	
DESIGN & STAMP		
DESIGN PRESS. PSI	25/FV	
DESIGN TEMP. °F.	650°	
NAT'L. BD. NO.	38509	
HYDRO TEST PSI	25	
RADIOGRAPH		
HEAT TREAT SPEC. NO.		

SEE OPERATING LIMITATIONS

1940903

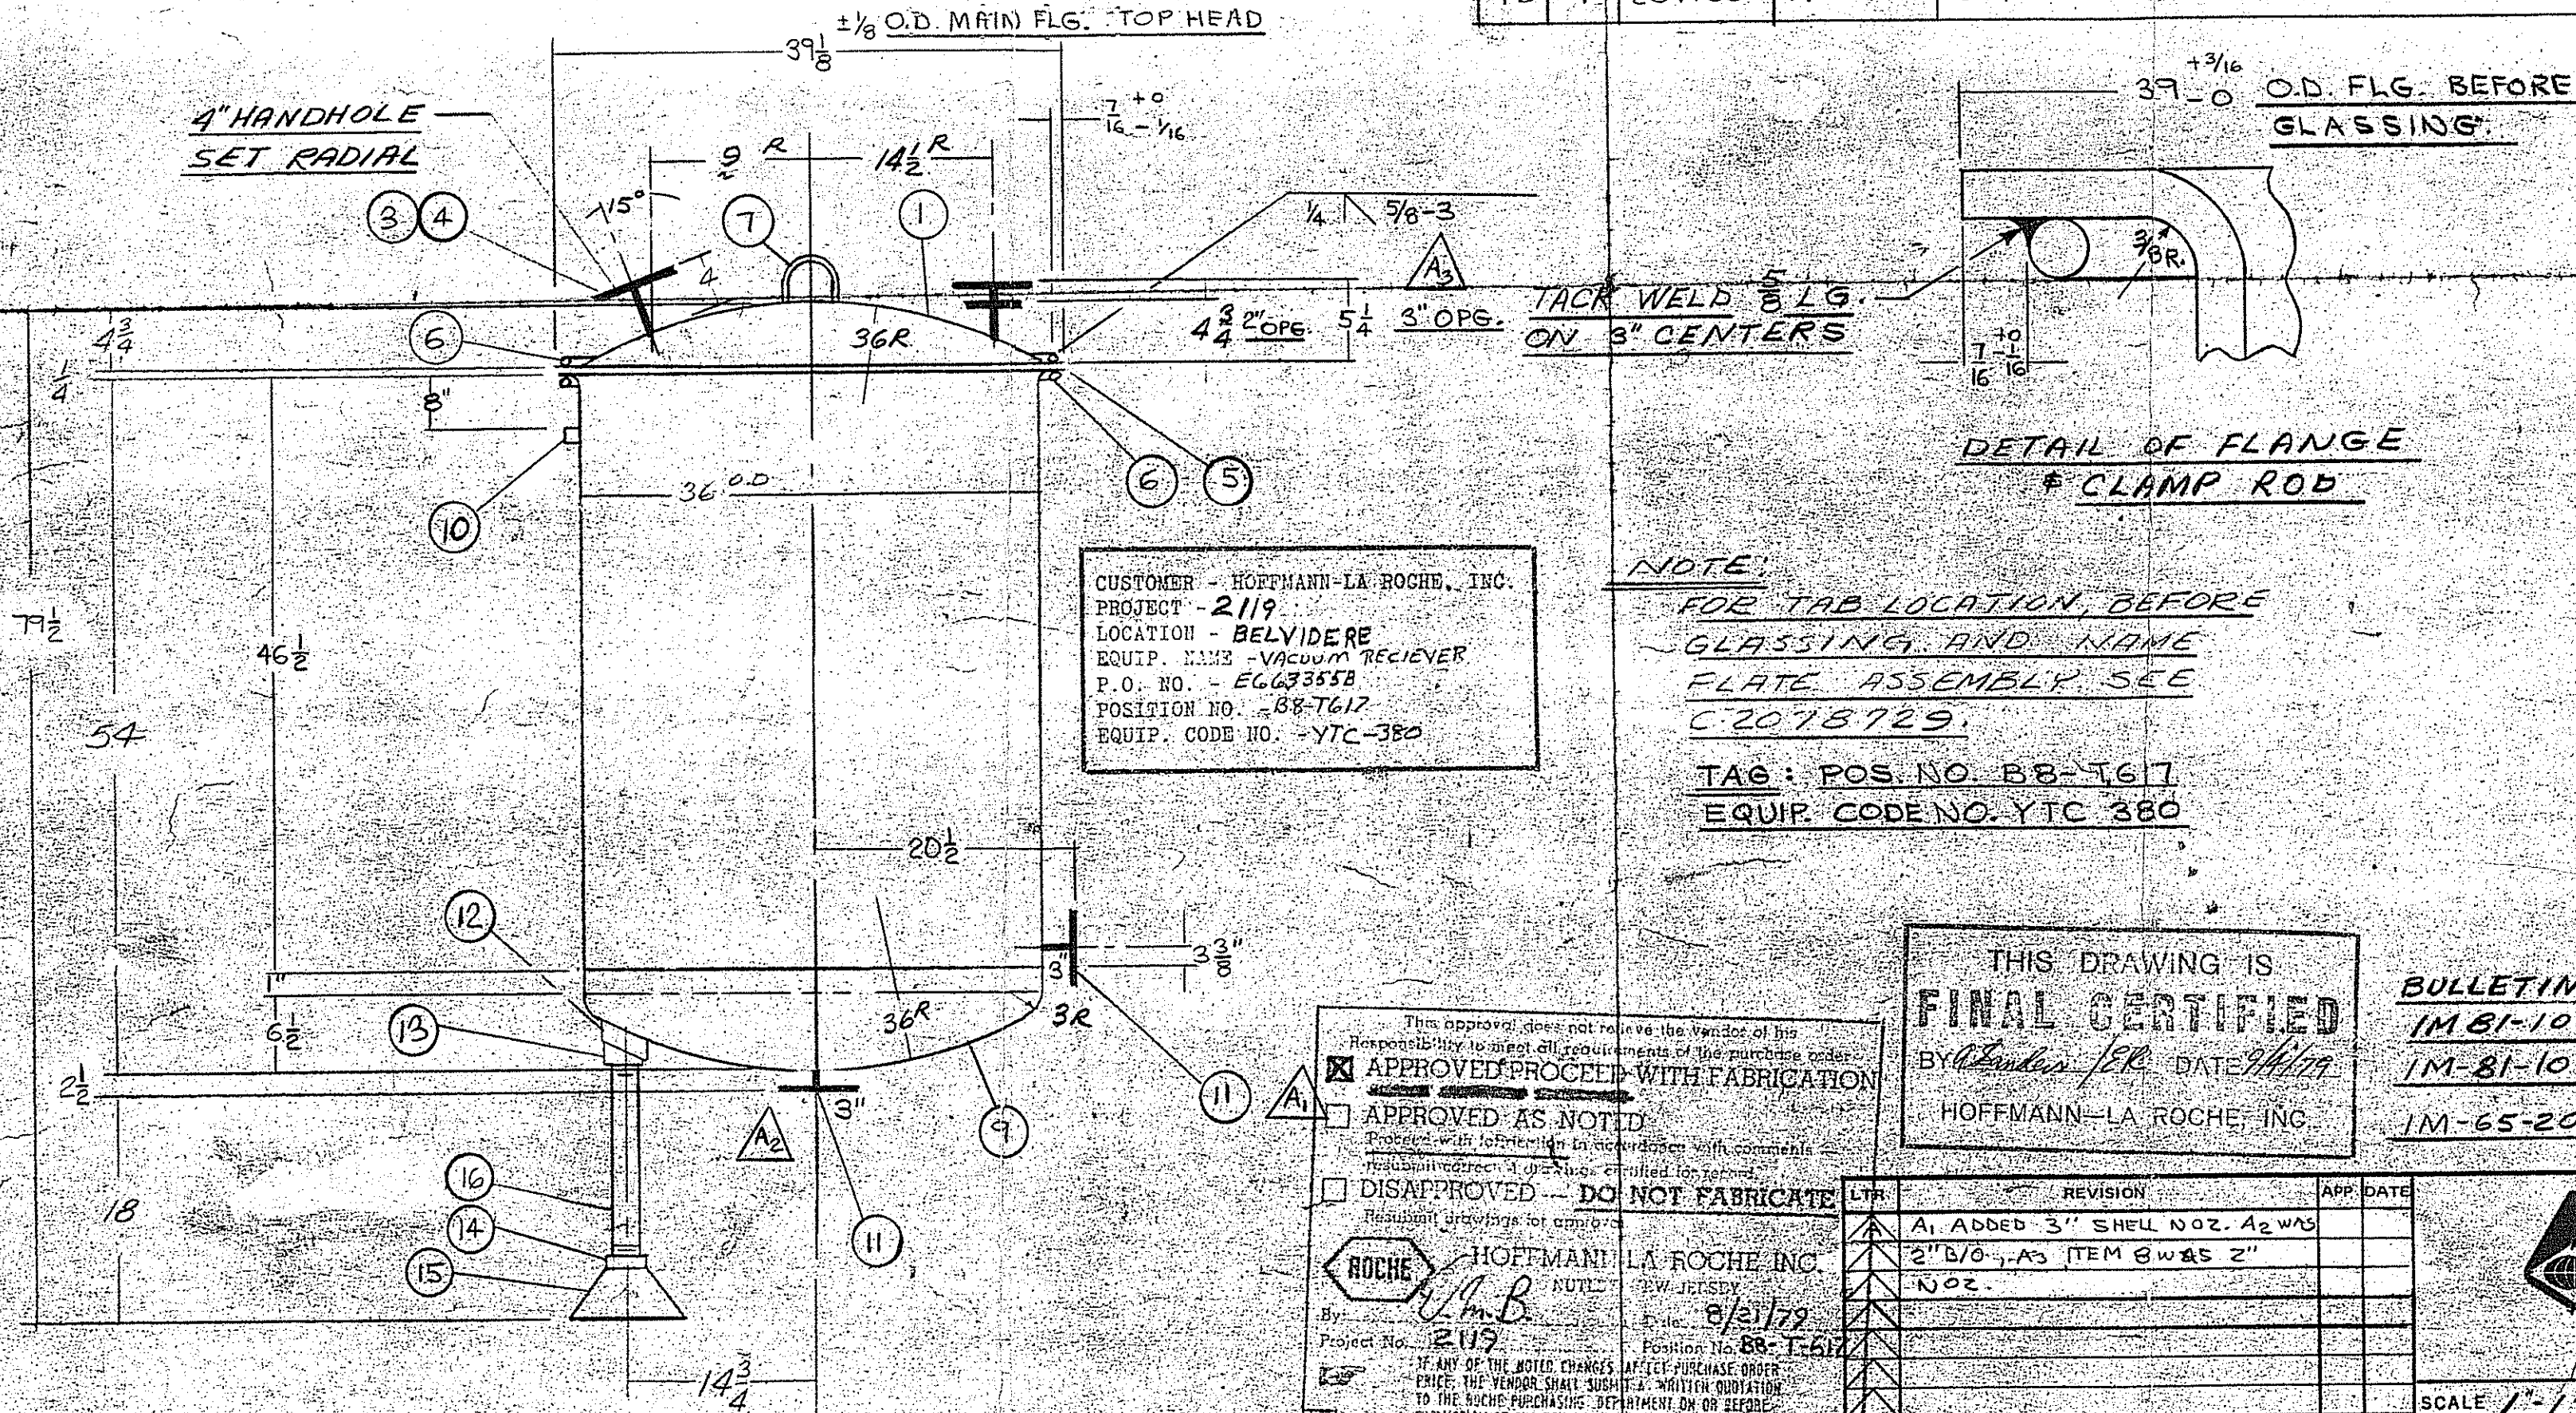4" HANDHOLE
SET RADIAL

NOTE:

FOR TAB LOCATION, BEFORE GLASSING AND NAME PLATE ASSEMBLY SEE C-2078729.

TAG: POS. NO. B8-T617
EQUIP. CODE NO. YTC 380

THIS DRAWING IS
FINAL CERTIFIED
BY *[Signature]* DATE *8/21/79*
HOFFMANN-LA ROCHE, INC.

BULLETINS
IM-81-100
IM-81-101
IM-65-201

This approval does not relieve the vendor of his responsibility to meet all requirements of the purchase order.

☒ APPROVED PROCEED WITH FABRICATION

☐ APPROVED AS NOTED

☐ DISAPPROVED - DO NOT FABRICATE

Resubmit drawings for approval


HOFFMANN-LA ROCHE, INC.
NUTLEY, N.J.

By: *[Signature]* Date: *8/21/79*

Project No. *2119* Position No. *B8-T617*

IF ANY OF THE NOTED CHANGES APPEAR PURCHASE ORDER ENCL. THE VENDOR SHALL SUBMIT A WRITTEN QUOTATION TO THE ROYCE PURCHASING DEPARTMENT ON OR BEFORE SUBMISSION OF THE REVISED DRAWINGS.

REV	REVISION	APP	DATE
1	A1. ADDED 3" SHELL NOZ. A2 WAS 2" B/O A3 ITEM 8 WAS 2" NOZ.		
2			
3			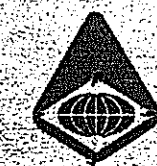
PFAUDLER
SYBRON CORPORATION

PLANTS IN ELYRIA, OHIO AND ROCHESTER, NEW YORK

SCALE 1"=1'-0"

DRAWN R.Y. DATE 11-1-78

CHECKED CM DATE 11-2-78

APPROVED & K. J. [Signature] DATE 8-13-79

CERTIFIED

NO. REQ'D. (1) ONE

CE 278-0860

SHEET OF

EQUIP. CODE NO. YTC - 380 - 1

ALL TANK NOZZLES FURNISHED WITH DRILLING

SPLIT FLG. 150 LB. ANSI

WORK FROM DIMENSIONS DO NOT SCALE

SEE PLAN VIEW FOR ORIENTATION

THIS DOCUMENT IS THE PROPERTY OF THE PFAUDLER CO. IT IS TO BE USED ONLY FOR THE PURPOSE FOR WHICH IT WAS LENT AND MUST NOT BE REPRODUCED WITHOUT WRITTEN PERMISSION OR USED IN ANY WAY DETRIMENTAL TO THE INTEREST OF THIS COMPANY. IT IS SUBJECT TO RETURN UPON REQUEST.