




APPROVAL DRAWING SUBMITTAL

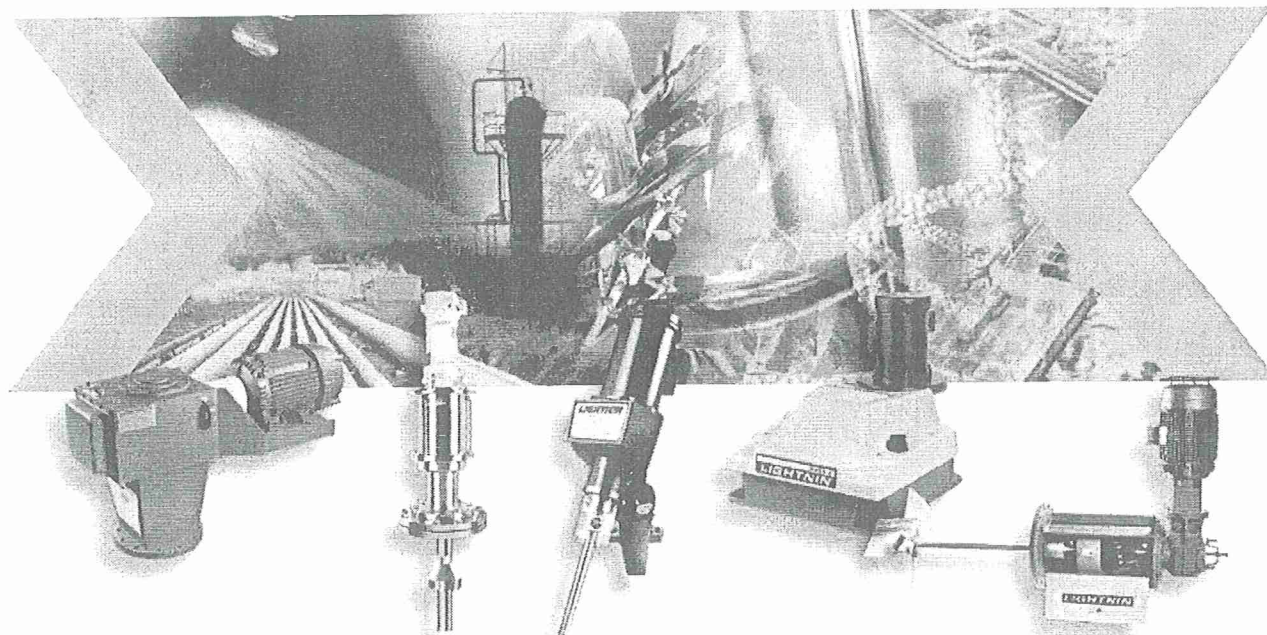

Tagging:
AG-8403 Lime Slurry

*AGIT. FOR
108620*

Ship To Customer: THE UNIVERSITY OF FLORIDA
Bill To Customer: THE UNIVERSITY OF FLORIDA
PO Number: 1100119520
Model: Lightnin Mixer Model X6C200
Order Number: 0001319766
Line Number: 000150

SPX®

<http://www.lightninmixers.com>



AN SPX BRAND

APPROVAL DRAWING SUBMITTAL

LIGHTNIN SALES ORDER 0001319766

LIGHTNIN LINE ITEM 000150

Table of Contents

TITLE

DOCUMENT NO.


General Arrangement Drawing
Assembly Drawing X5C & X6C
Flange and Gasket Proportions
Stuffing Box Assembly
A310 (1 piece) Impeller Assembly

1319766000150-A
L-17989
DS-E-571
L-17003
L-16701

For
#108620



DATE: 4/28/2011

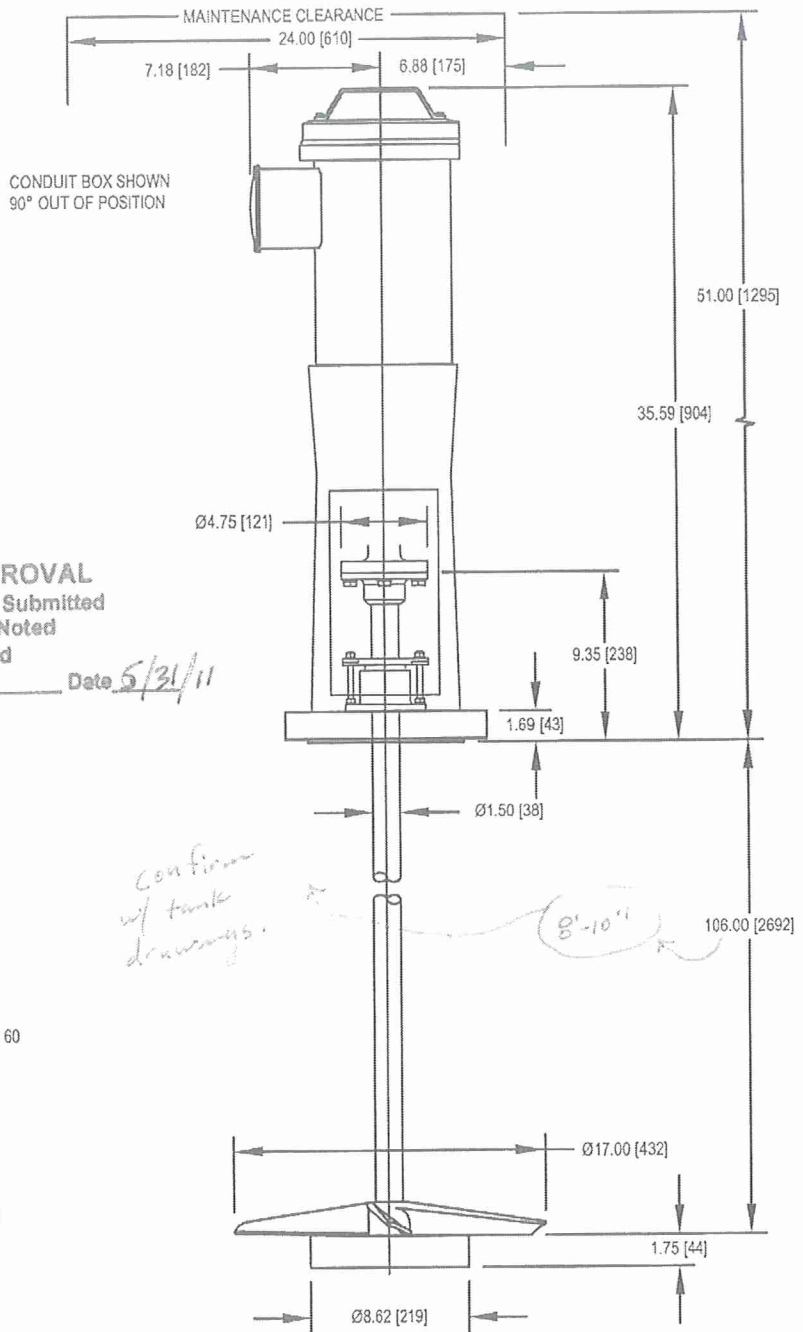

FOR APPROVAL
☒ Approved as Submitted
☒ Approved as Noted
☐ Not Approved
Name TSC Date 5/31/11

NOTES:

- MOTOR DATA:
H.P.: 2.000 R.P.M.: 1725
VOLTS: 230/460 PHASE: 3 Hz: 60
ENCLOSURE: TEFC DUTY: INVERTER
IMPELLER SPEED - 280 IMPELLER TYPE - A310
- APPROXIMATE TOTAL MIXER WEIGHT IS 288 lb [131 kg]
WEIGHT WILL VARY WITH MOTOR CHARACTERISTICS.
- ALL DIMENSIONS ARE IN INCHES [mm] AND ARE MAXIMUM.
- MIXER MOUNTING DESIGN DATA:
VERTICAL DOWNWARD LOAD: 580 LBS. [2580 N]
TORQUE: 830 IN.-LBS. [94 N·m]
BENDING MOMENT: 10000 IN.-LBS. [1130 N·m]
DESIGN LOADS ARE GREATER THAN ACTUAL LOADS
BY A SUITABLE FACTOR, CONSISTENT WITH
CONSTRUCTION CODES AND LIGHTNIN EXPERIENCE.
LIGHTNIN WARRANTIES AND GUARANTEES EXTEND
FOR THOSE ITEMS FURNISHED BY IT. ALL OTHER EQUIPMENT
AND DESIGNS ARE THE RESPONSIBILITY OF OTHERS.
- UNIT IS FURNISHED WITH A STUFFING BOX.
PACKING MATERIAL: COMBINATION 50
- MIXER MOUNTING FLANGE DATA:
150 LB. ANSI SERIES DRILLING
SIZE: 6" O.D.: 11.00 BOLT CIRCLE: 9.50
NO. OF HOLES: 8 BOLT DIA.: 0.75
AS COMMON PRACTICE, FLANGE BOLT HOLES STRADDLE
MIXER CENTERLINE.
- MATERIAL OF IN-TANK MIXER PARTS IS 316

For
#108620

ALL EQUIPMENT DESIGN AND APPLICATION DATA SHOWN HEREIN
AND RELATED KNOW-HOW IS CONFIDENTIAL AND THE PROPERTY
OF THE LIGHTNIN GROUP OF COMPANIES.
NO USE OR DISCLOSURE THEREOF MAY BE MADE WITHOUT
OUR WRITTEN PERMISSION.

LIGHTNIN
MIXERS AND AERATORS

GENERAL ARRANGEMENT

FOR: **THE UNIVERSITY OF FLORIDA**
S.O. NO.: 1319766 LINE NO.: 150
CUST. P.O. NO.: 1100119520 QUANTITY: 1
TAG NO.: AG-8403 Lime Slurry RATIO: 6:1
MIXER MODEL: X6C200
SERIAL NO.: 1000002624928



© LIGHTNIN
2011

CERTIFIED BY:

DATE:

DRAWING NO. 1319766000150-A

MOTOR HANDLE

101

109

155/62

103

60

107

7

5

56

37

38

51

SEE DETAIL "A"

94

REFER TO STUFFING BOX ASSEMBLY DRAWING

191

42

258

44

45

238

51

239

236

237

DETAIL "A"

GEAR CARRIER ASSEMBLY AND RING GEAR ①

13

15

11

2

9

WHEN ORDERING PARTS, SPECIFY:
DRAWING NO., PART NAME, ITEM NO.,
AND MIXER SERIAL NUMBER.

1	GEAR CARRIER ASSEMBLY
2	RING GEAR
5	RING GEAR RETAINING PIN
7	RETAINING RING
9	SUN GEAR
11	PLANET GEAR
12	THRUST WASHER (NOT SHOWN)
13	NEEDLE BEARING
15	CARRIER BODY
24	PLANET DOWEL PIN
27	KEY
36	HOUSING
37	BALL BEARING
38	OIL SEAL (2)
41	BALL BEARING
42	IMPELLER SHAFT
44	IMPELLER
45	SET SCREW
51	DRIVE SHAFT
52	RETAINING RING
56	RETAINING RING
59	RETAINING RING (2)
60	FLAT HEAD SCREW
62	WASHER
67	HEX HEAD CAP SCREW
68	LOCKWASHER
94	PEDESTAL BACK GUARD
95	PEDESTAL SAFETY COVER
101	MOTOR
103	ADAPTER
106	MOTOR KEY
107	SUN GEAR KEY
108	GASKET
109	O-RING
110	DRIVE COUPLING ASSEMBLY
155	ADAPTER HARDWARE
191	FLANGE
236	REMOVABLE COUPLING
237	KEY
238	THRUST PLATE
239	HEX HEAD CAP SCREW (NYLOK)
258	O-RING

ITEM PART NAME

ALL EQUIPMENT DESIGN AND APPLICATION DATA SHOWN HEREIN
AND RELATED KNOW-HOW IS CONFIDENTIAL AND THE PROPERTY
OF THE LIGHTNIN GROUP OF COMPANIES.
NO USE OR DISCLOSURE THEREOF MAY BE MADE WITHOUT
OUR WRITTEN PERMISSION.

LIGHTNIN®
MIXERS AND AERATORS


ASSEMBLY DRAWING

**X5C75 THRU X5C500
X6C75 THRU X6C500
GEAR DRIVE ECL
WITH ELECTRIC MOTOR**

NOTES:
① GEAR KIT CONSISTS OF ITEMS 2, 5, 7, 108, 110 AND GEAR CARRIER ASSEMBLY ITEMS 9, 11, 12, 13, 15, 24, 27 & 107. KIT IS SOLD AS A SET. INDIVIDUAL ITEMS ARE NOT AVAILABLE.
② DRIVE FLAT FURNISHED ON X5C & X6C 75 THRU 150 ONLY. KEY (ITEM 27) FURNISHED ON X5C & X6C 200 THRU 500.

For #108620

CERTIFIED
© LIGHTNIN 2001

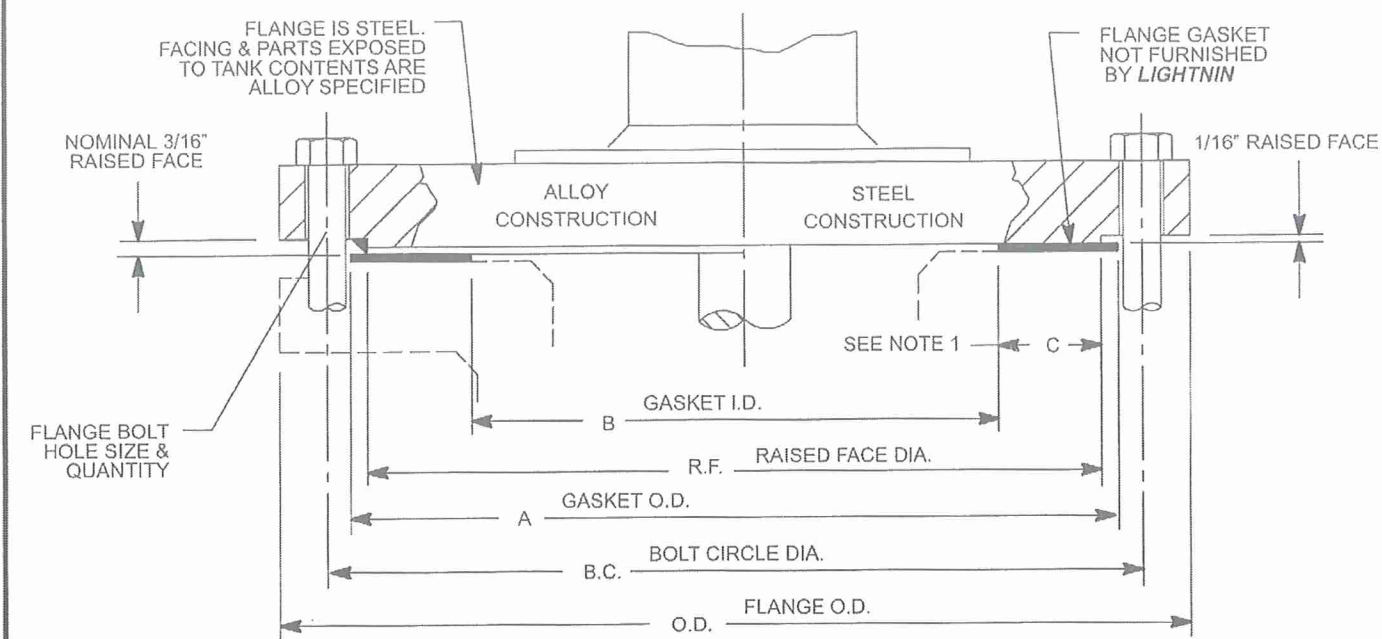

- NOTES:
- 1. GASKETS MUST BE SEATED BETWEEN THE RAISED FACES OF THE MIXER AND TANK FLANGE TO EFFECTIVELY SEAL AGAINST PRESSURE, VAPOR LEAKS AND/OR PRODUCT CONTAMINATION. DIMENSION "C" IS THE MINIMUM GASKET CONTACT AREA FOR 150 LB. RAISED FACES.
 - 2. THE STANDARD RING GASKET OUTSIDE DIAMETER EXTENDS TO THE INNER EDGES OF THE FLANGE BOLTS, WHICH ACT AS CENTERING DEVICES.
 - 3. FULL FACE ANSI GASKETS ARE GASKETS WHICH EXTEND TO THE O.D. OF THE FLANGE. FLANGE BOLT CLEARANCE HOLES MUST BE DRILLED IN THIS FULL FACE TYPE GASKET. SEE TABLE FOR HOLE SIZE AND BOLT CIRCLE.
 - 4. GASKETS CAN ALSO BE MADE EQUAL TO THE RAISED FACE (R.F.) DIAMETER WITH THE SAME I.D. AS SHOWN IN THE TABLE (DIM. "B")
 - 5. GASKET MATERIAL AND THICKNESS ARE THE RESPONSIBILITY OF THE USER. THEY MUST BE PRODUCT COMPATIBLE AND SUITABLE FOR ALL SERVICE CONDITIONS.
 - 6. GASKET STYLES OTHER THAN FLAT FACE RING GASKETS ARE AVAILABLE, BUT ARE USUALLY MORE EXPENSIVE. GASKETS FOR FLANGES WITH RATINGS IN EXCESS OF 150 LBS. ARE NOT SHOWN DUE TO VARIABLE DESIGN CONDITIONS ENCOUNTERED. SPECIFICATIONS FOR OTHER THAN RING GASKETS AND HIGHER PRESSURE DESIGNS CAN BE FOUND IN ASME UNFIRED PRESSURE VESSEL CODES OR ANSI STANDARDS.

②

ANSI 150 LB. FLANGE DATA						ANSI RING GASKET DATA			
NOM. SIZE	O.D.	R.F.	B.C.	HOLE QUAN.	HOLE DIA.	A (O.D.)	B (I.D.)	WIDTH	C MIN.
5	10.0	7.31	8.50	8	.88	7.750	5.562	1.094	.88
6	11.0	8.50	9.50	8	.88	8.750	6.625	1.062	.94
8	13.5	10.62	11.75	8	.88	11.000	8.625	1.188	1.00
10	16.0	12.75	14.25	12	1.00	13.375	10.750	1.312	1.00
12	19.0	15.00	17.00	12	1.00	16.125	12.750	1.688	1.12
14	21.0	16.25	18.75	12	1.13	17.750	14.000	1.875	1.12
16	23.5	18.50	21.25	16	1.13	20.250	16.000	2.125	1.25
18	25.0	21.00	22.75	16	1.25	21.625	18.000	1.812	1.50
20	27.5	23.00	25.00	20	1.25	23.875	20.000	1.937	1.50
24	32.0	27.25	29.50	20	1.38	28.250	24.000	2.125	1.62

For
108620




© LIGHTNIN
1985

ALL EQUIPMENT DESIGN AND APPLICATION DATA SHOWN HEREIN AND RELATED KNOW-HOW IS CONFIDENTIAL AND THE PROPERTY OF THE LIGHTNIN GROUP OF COMPANIES. NO USE OR DISCLOSURE THEREOF MAY BE MADE WITHOUT OUR WRITTEN PERMISSION.

LIGHTNIN

MIXERS AND AERATORS
OUTLINE DIMENSIONS IN INCHES

**150 LB. ANSI STANDARD
FLANGE & GASKET
PROPORTIONS**

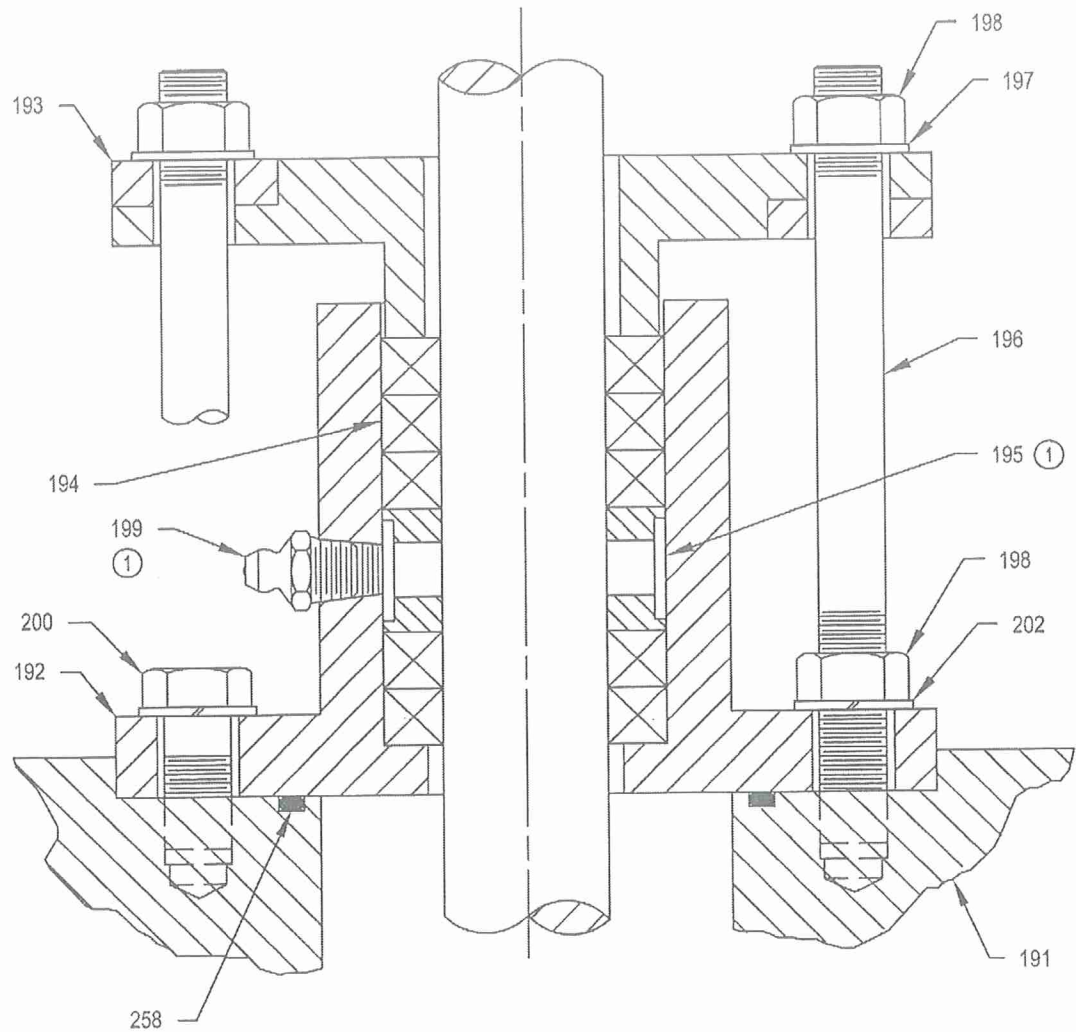

WHEN ORDERING PARTS, SPECIFY:
DRAWING NUMBER, PART NAME, ITEM NUMBER,
UNIT MODEL & SERIAL NUMBER

258	SEALING RING
202	LOCKWASHER
200	HEX HEAD CAP SCREW
199	LUBRICANT FITTING ①
198	HEX NUT
197	WASHER
196	GLAND STUD
195	LANTERN RING ①
194	PACKING
193	SPLIT PACKING GLAND
192	STUFFING BOX HUB
191	FLANGE ASSEMBLY

ITEM	PART NAME
------	-----------

For
#108620

NOTE:



① FURNISH ONLY WITH
LUBRICATED STUFFING BOX.




© LIGHTNIN
2007

STANDARD 5 RING STUFFING BOX			
MODEL	SHAFT DIA.	VESSEL PRESSURE	MAXIMUM TEMPERATURE
X1C	1.00	60 PSIG	300° F.
	1.25		
	1.50		
X5C & X6C	1.00	150 PSIG	300° F.
	1.25		
	1.50		
ALL EQUIPMENT DESIGN AND APPLICATION DATA SHOWN HEREIN AND RELATED KNOW-HOW IS CONFIDENTIAL AND THE PROPERTY OF THE LIGHTNIN GROUP OF COMPANIES. NO USE OR DISCLOSURE THEREOF MAY BE MADE WITHOUT OUR WRITTEN PERMISSION.			
LIGHTNIN® MIXERS AND AERATORS			
ASSEMBLY DRAWING			
STUFFING BOX ASSEMBLY			

DRAWING NO. L-17003E

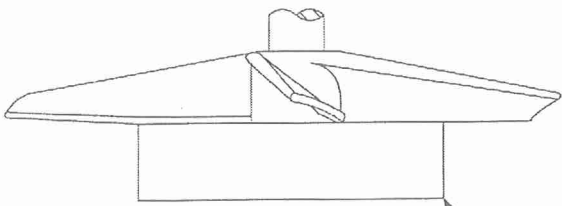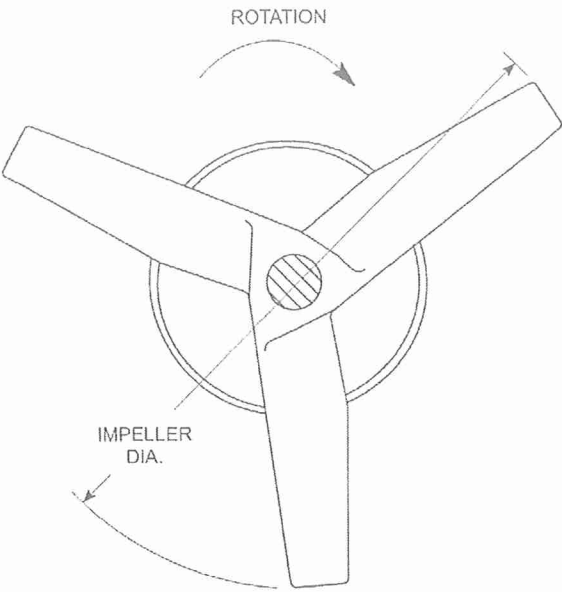

STABILIZER RING
FURNISHED ONLY
WHEN SPECIFIED

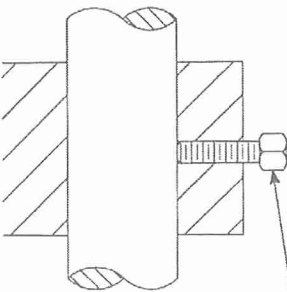

SET SCREW

For
#108620

WHEN ORDERING PARTS, SPECIFY:
DRAWING NUMBER, PART NAME, ITEM
NUMBER AND SERIAL NUMBER



CERTIFIED

© LIGHTNIN
1991

ALL EQUIPMENT DESIGN AND APPLICATION DATA SHOWN
HEREIN AND RELATED KNOW-HOW IS **CONFIDENTIAL** AND
THE PROPERTY OF THE LIGHTNIN GROUP OF COMPANIES.
NO USE OR DISCLOSURE THEREOF MAY BE MADE WITHOUT
OUR WRITTEN PERMISSION.

LIGHTNIN®
MIXERS AND AERATORS


ASSEMBLY DRAWING

A310
AXIAL FLOW IMPELLER

DRAWING NO. L-16701B

SHIP NOTE
2" TYP. FLANGE FROM SHIP
TO BE INSTALLED ON CENTERLINES

STEP UP

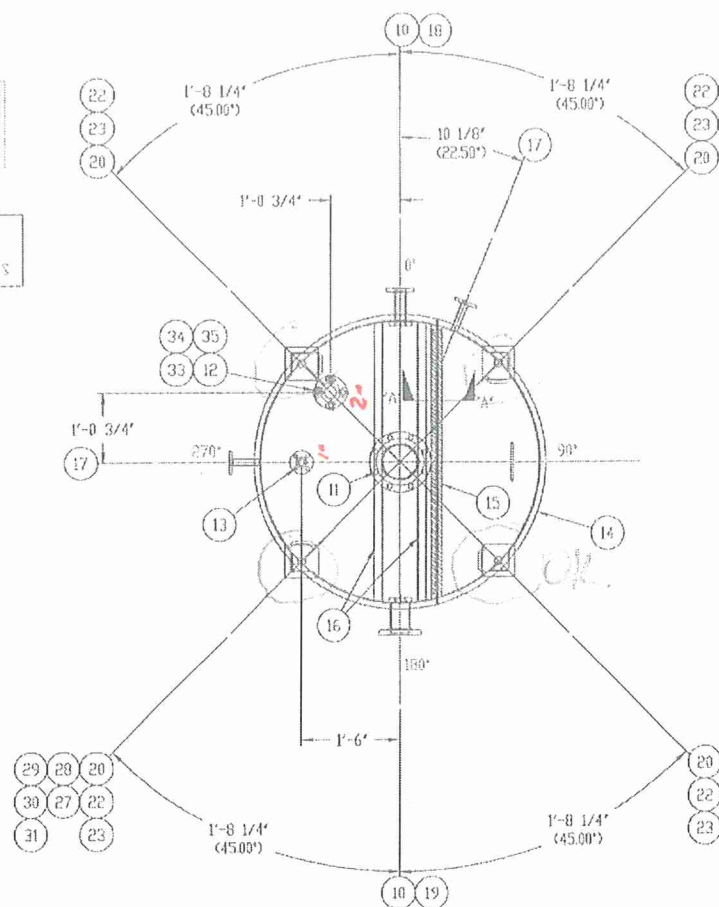

4 2-1 3/4
5 3/4

FOR APPROVAL
☒ Approved as Submitted
☐ Approved as Noted
☐ Not Approved

Name TPIC Date 5/26/11

ACTIVATOR DESIGN LOADS:
580 LB. AXIAL DOWN
830 IN LB TORQUE
10,000 IN LB BENDING

PARTS LIST			BILL OF MATERIALS		DESCRIPTION		QUANTITY	
P	QTY	U	PART NAME	U	QTY	U	QTY	U
1	100	EA	15077-1-12-2	X	100	EA	15077-1-12-2	100
2	100	EA	15077-1-12-2	X	100	EA	15077-1-12-2	100
3	100	EA	15077-1-12-2	X	100	EA	15077-1-12-2	100
INTERIOR NOTES: CLEANING/BLASTING CLASS #0 "MP" BLASTING REQUIRED. REMOVE ALL DIRT, DEBRIS, OIL, WELD SMOKE, AND CHEMICAL CONTAMINATION. GRINDING CLASS #5 WELD SPATTER AND SLAG IS REMOVED USING A "WIRE BRUSH". EXCESSIVE WELD CROWN AT STARTS AND STOPS IS REMOVED. WELLS AND GROUNDS TO A FLUSH #140-150" GRIIT FINISH. INSPECTION CLASS #1 VISUAL (100X) TEST PROCEDURE PER IMP #11.	EXTERIOR NOTES: CLEANING/BLASTING CLASS #1 "COMMERCIAL BLAST" PER SPEC. "SP6 SP6-G3" WHICH EQUALS "FACE, NO. 3". GRINDING CLASS #1 WELD SPATTER AND SLAG IS REMOVED USING A "WIRE BRUSH". EXCESSIVE WELD CROWN AT STARTS AND STOPS IS REMOVED. INSPECTION CLASS #1 VISUAL (100X) TEST PROCEDURE PER IMP #11.
---	--

QTY	UNIT	DESCRIPTION	PRICE	TOTAL
1	SURF MLC 2000	RECYCLED HUXY PRIMER HSP-PR067-VS	\$48.10	\$48.10



[illegible][illegible]

TANK GAUGE SCHEDULE		CUTTING SCHEDULE	
TOP CRK	075 174" SA 585-70 L RND	2-2 3/4" S. RND	3 1/2"
BOTTOM CRK	080 174" SA 585-70		080 14" 0 1/2"
1ST CRK	75" 075 174" SA 585-70		CRK
2ND CRK	075 174" SA 585-70		CRK

[illegible]

Approval Stamp
Release for Fabrication
Approved as Noted
Resubmit
Date:
By:

108620

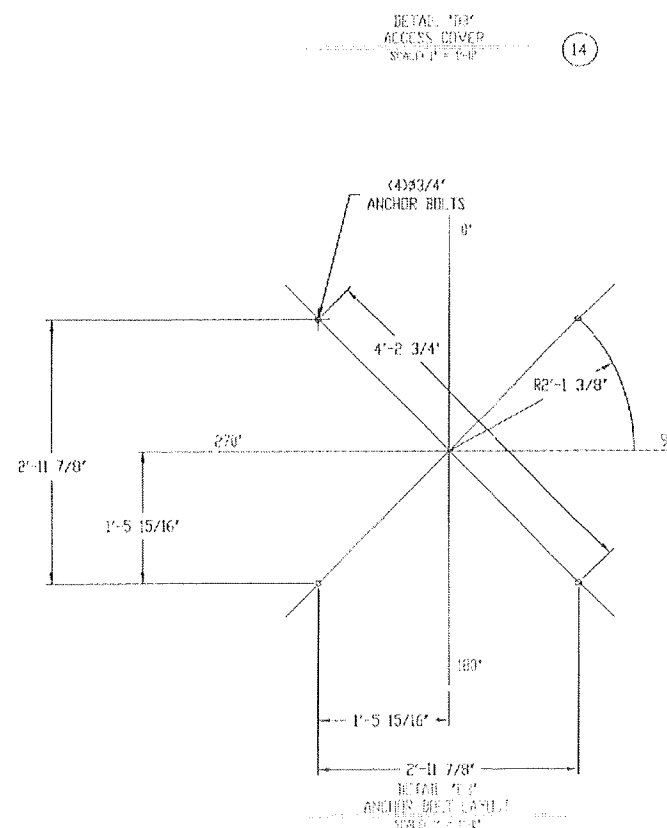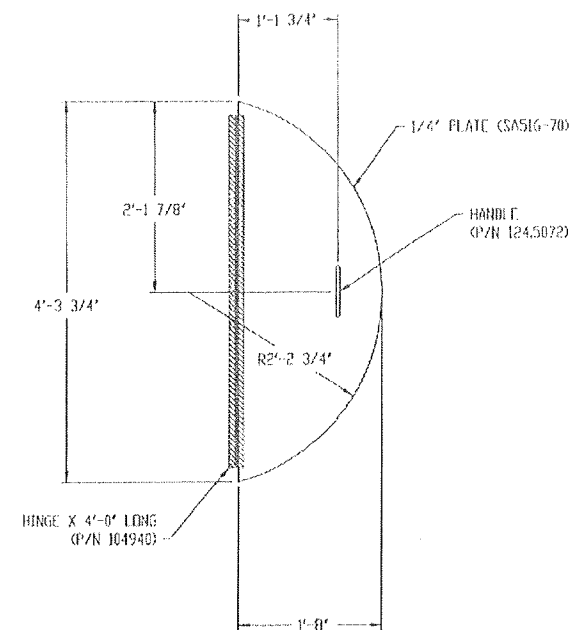

1. DATE: 4-4-11 2. BY: [redacted] 3. DATE: [redacted]		4. DESCRIPTION: [redacted] 5. [redacted] 6. [redacted]	
---	--	--	--	--	--