
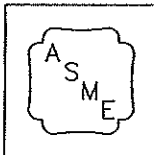
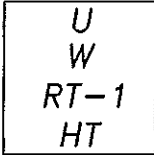


GENERAL NOTES:

1. ASME CODE REQUIRED, NATIONAL BOARD REGISTRATION IS REQUIRED
2. CONSTRUCTION IN ACCORDANCE WITH THE 2013 ASME CODE, SECTION VIII DIVISION 1 AND CLIENTS SPECIFICATIONS.
3. RADIOGRAPHY : HEAD/SHELL (CIRC SEAM) - FULL ; SHELL (LONG SEAM) - N/A
4. JOINT EFFICIENCY : HEAD/SHELL (CIRC SEAM) - 100% ; SHELL (LONG SEAM) - SEAMLESS
5. POSTWELD HEAT TREATMENT : REQUIRED
6. MAGNETIC PARTICLE EXAMINATION : NOT REQUIRED
7. LIQUID PENETRANT EXAMINATION : REQUIRED
8. LETHAL SERVICE : NO
9. DESIGN PRESSURE 230 P.S.I.G. 350 °F.
10. MINIMUM DESIGN METAL TEMPERATURE -20 °F AT 501 P.S.I.G.
11. EXTERNAL DESIGN PRESSURE FV P.S.I. 350 °F.
12. MAXIMUM ALLOWABLE STRESS : 17100 P.S.I. AT 350 °F DESIGN TEMPERATURE.
13. CORROSION ALLOWANCE : 1/8"
14. INSULATION : 1 1/2"/HC FIREPROOFING : NO
15. MAXIMUM ALLOWABLE WORKING PRESSURE 501 P.S.I.G. LIMITED BY NOZZLE
16. SHOP HYDROSTATIC TEST : 652 P.S.I.G.
17. INSPECTED BY ONE CIS COMPANY, SHOP, AND CLIENT (OTHERS) -
18. TEST HOLES SHALL BE PLUGGED WITH GREASE PRIOR TO SHIPMENT.
19. ALL FLANGE BOLT HOLES SHALL STRADDLE VESSEL CENTERLINES UNLESS OTHERWISE SHOWN OR NOTED.
20. ESTIMATED WEIGHT OF VESSEL :
 SHIPPING : 1,900 LBS
 EMPTY : 1,900 LBS
 OPERATING : 11,400 LBS
 TEST WEIGHT : 2,500 LBS
21. VESSEL SHALL BE THOROUGHLY CLEANED OF ALL SCALE, SPLATTER, FLUX, GREASE, DIRT, AND ALL LOOSE FOREIGN MATTER.
22. CLOSE ALL OPENINGS FOR SHIPMENT. PROTECT WITH PLASTIC COVERS FOR FLANGES AND PLASTIC PLUGS FOR COUPLINGS.
23. NOZZLE PROJECTIONS ARE FROM TOP OF SHELL TO FACE OF FLANGE UNLESS OTHERWISE NOTED.
24. COAT FLANGE FACES AND OTHER MACHINED SURFACES WITH STANDARD RUST PREVENTATIVE.
25. PAINTING IS REQUIRED IN ACCORDANCE WITH CUSTOMER SPECIFICATIONS : MSP-038
26. ALL TAIL DIMENSIONS ARE FROM REFERENCE WORK LINE UNLESS OTHERWISE SHOWN OR NOTED.
27. CIRCUMFERENTIAL & LONGITUDINAL WELDS USE WPS-5P UNLESS OTHERWISE NOTED.
28. ALL CARBON STEEL PIPING AND/OR VESSEL REPAIRS USE WPS-4P
29. WELD ALL ATTACHMENTS AND SUPPORTS USE WPS-2P UNLESS NOTED OTHERWISE.
30. WIND CODE: ASCE 7-05 AT 90 MPH
31. SEISMIC CODE: ASCE 7-05 CATEGORY: B
32. SNOW LOAD: 20 LBS/FT²


	CERTIFIED BY	NB 57
	VENTECH VESSEL FABRICATORS, LLC. PASADENA, TX	
	MFG. SER. NO. <u>8000-032-PK301-V1</u>	YR. BUILT <u>2015</u>
	MAWP (<u>35.2 kg/cm²g</u>) <u>501</u> psig AT (<u>176.6 °C</u>) <u>350</u> °F	
	MAWP EXT (<u>---</u> kg/cm ² g) <u>---</u> psig AT (<u>---</u> °C) <u>---</u> °F	
	MDMT (<u>-28.9 °C</u>) <u>-20</u> °F AT (<u>35.2 kg/cm²g</u>) <u>501</u> psig	
	TEST PRESSURE (<u>45.8 kg/cm²g</u>) <u>652</u> psig	
	CORR. ALLOW. (<u>3 mm</u>) <u>1/8 in.</u>	(<u>3 mm</u>) <u>1/8 in.</u> (<u>3 mm</u>) <u>1/8 in.</u>
	HEAD SHELL NOZZLES	
	INSPECTED BY: <u>ONE CIS FV @ 350 °F (176.6 °C)</u>	
	CUSTOMER: <u>VENTECH XTL Oklahoma City, LLC</u>	
	CUSTOMER P.O. #: <u>4777010-15-00112</u>	
	<u>PK-301-V1 HYDROGEN MEMBRANE VESSELS</u>	

NAMEPLATES FOR: PK-301-V2 HYDROGEN MEMBRANE VESSELS - NB 58
 PK-301-V3 HYDROGEN MEMBRANE VESSELS - NB 59
 PK-301-V4 HYDROGEN MEMBRANE VESSELS - NB 60
 PK-301-V5 HYDROGEN MEMBRANE VESSELS - NB 61

CERTIFIED AS BUILT



JCS 9/28/15

3	09-28-15	CM	JS	AS BUILT
2	03-04-15	JE	DAN	REVISED AS NOTED
1	02-17-15	JE	DAN	FOR CONSTRUCTION
0	01-28-15	JE	DAN	FOR APPROVAL
REV.	DATE	BY	CKD.	DESCRIPTION
VENTECH VESSEL FABRICATORS, LLC				
1107 BROADWAY PASADENA, TEXAS				
DRAWING TITLE HYDROGEN MEMBRANE VESSELS				
DESIGN DATA				
CUSTOMER: VENTECH XTL Oklahoma City, LLC			ITEM NO. <u>PK-301</u>	
FOR: .GTL JOINT VENTURE, LLC			TAG NO.	
LOCATION: OKLAHOMA CITY, OK			CUST. P.O. <u>4777010-15-00112</u>	
DRN. BY: J. ELIZONDO DATE: 01-28-15		<u>S/O</u>		DWG. NO. <u>D-8000-032-PK301</u>
CHKD: D. NASAB DATE: 01-28-15		8000-032-PK301V1-V5		
CERTIFIED FOR FABRICATION		DATE:		REV. <u>3</u>
				SHT <u>1</u> OF <u>3</u>

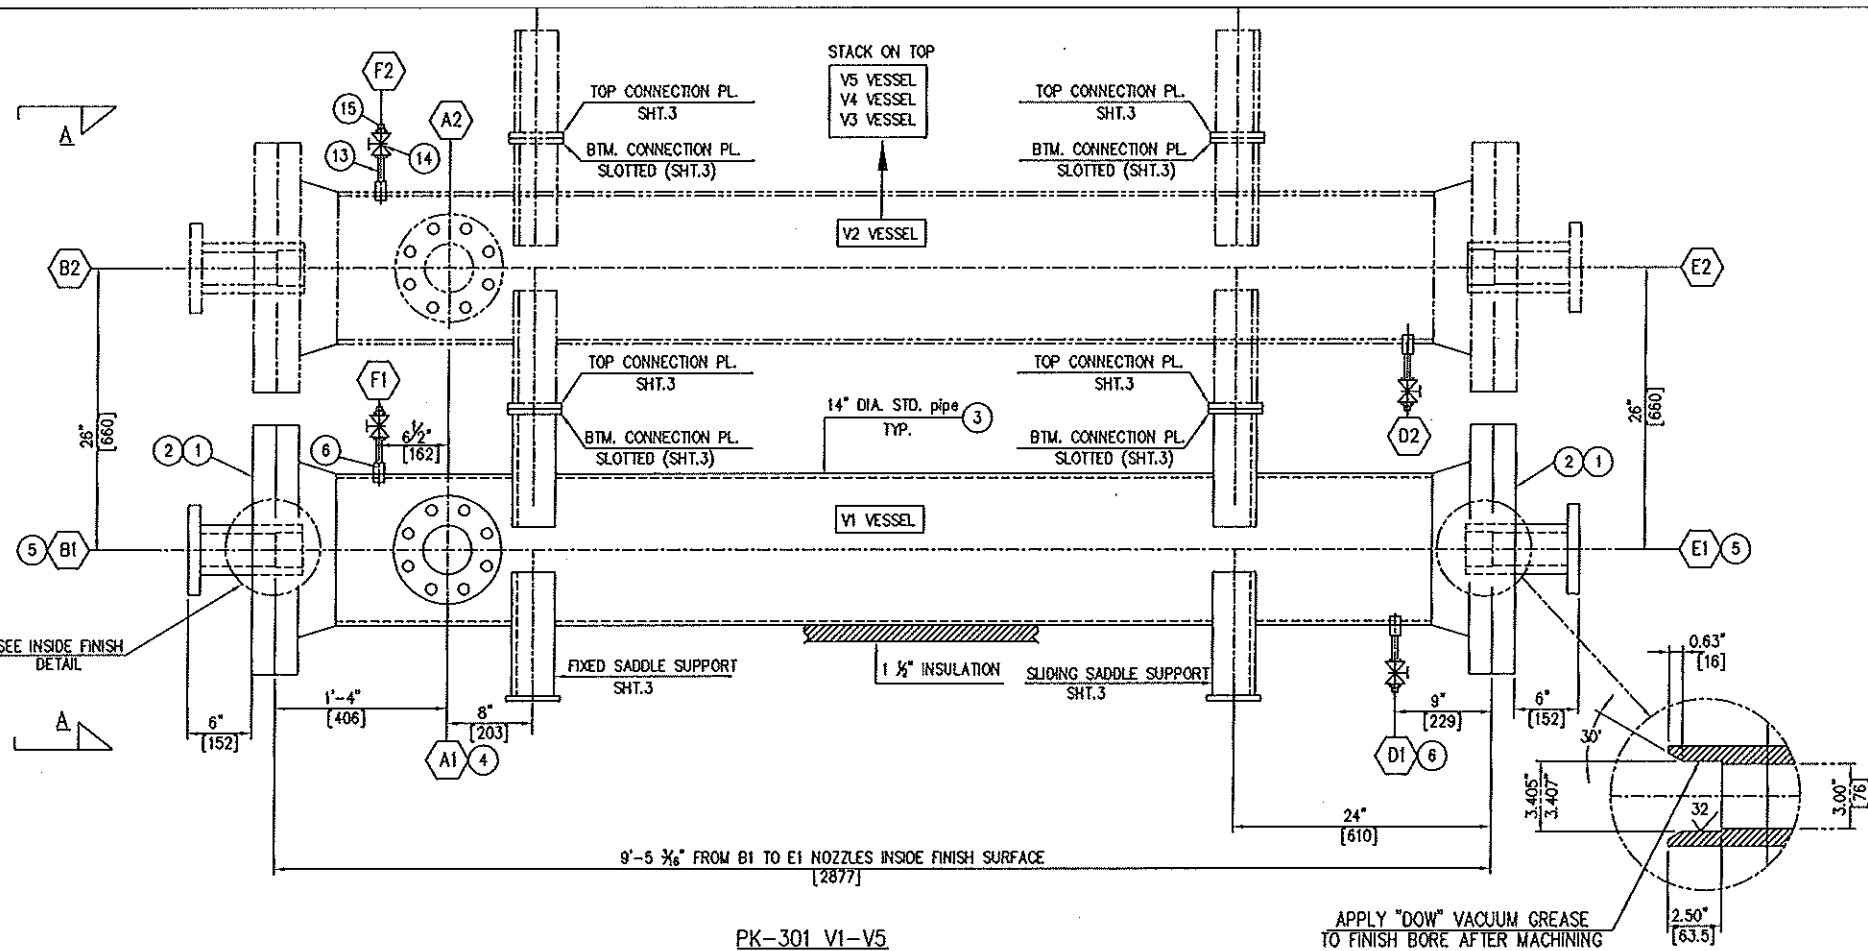

BILL OF MATERIALS			
ITEM	*QTY	DESCRIPTION	MATERIAL
1	10	14" 300# RFLWN FLANGE SCH.10D	SA-105
2	10	14" 300# RF BLIND FLANGE	SA-105
3	5	PIPE 14" SCH. STD. X 102' LONG	SA-106 GR. B
4	5	A1-A5- 4" 300# RF LWN X 9' LG.	SA-105
5	10	(B1-B5)(E1-E5)- 3" 300# RF LWN X 10 5/8" LG.	SA-105
6	10	(D1-D5)(F1-F5)- 1" 3000# SOCKET WELD COUPLING	SA-105
7	5	V-FAB NAMEPLATE	SS
8	5	V-FAB NAMEPLATE BRACKET	SS
9	1	GROUNDING LUG 1/2" THK. X 2" X 2 1/2"	SS
10	10 + 20	GASKET 14" 300# RF SPIRAL WOUND GRAPHITE FILLED	SS
11	200 + 80	STUD BOLTS 1 1/8" X 7" LONG PLATED	SA-193 GR. B7
12	400 + 160	NUTS 1 1/8" HEAVY HEX PLATED	SA-194 GR. 2H
13	10	1" PIPE NIPPLE S/XS SMLS PBE 3" LG	SA-106 GR. B
14	10	1" VALVE GATE 800# SW X THRD	CS
15	10	1" PLUG THRD SOLID ROUND HEAD	SA-105


*QUANTITIES ARE FOR FIVE VESSELS

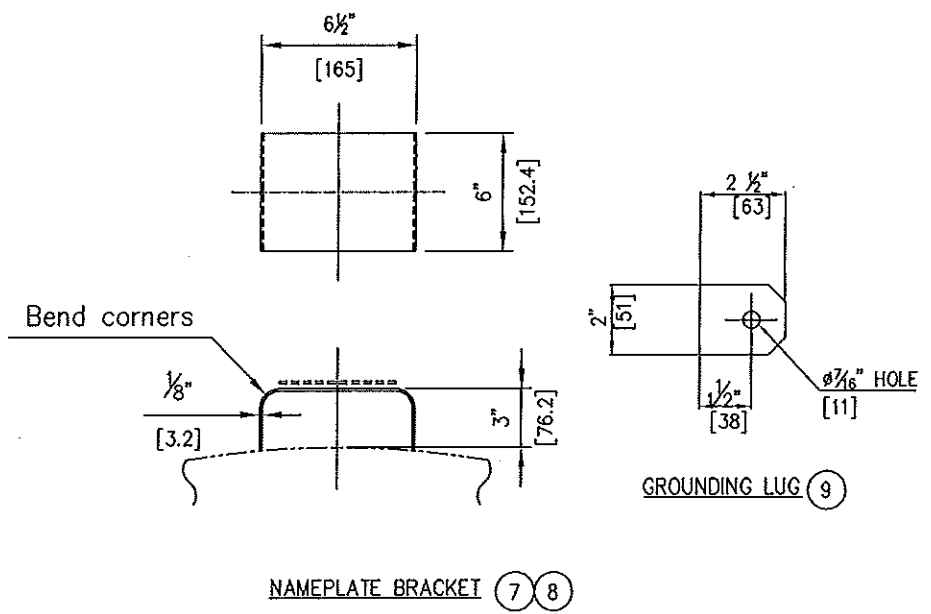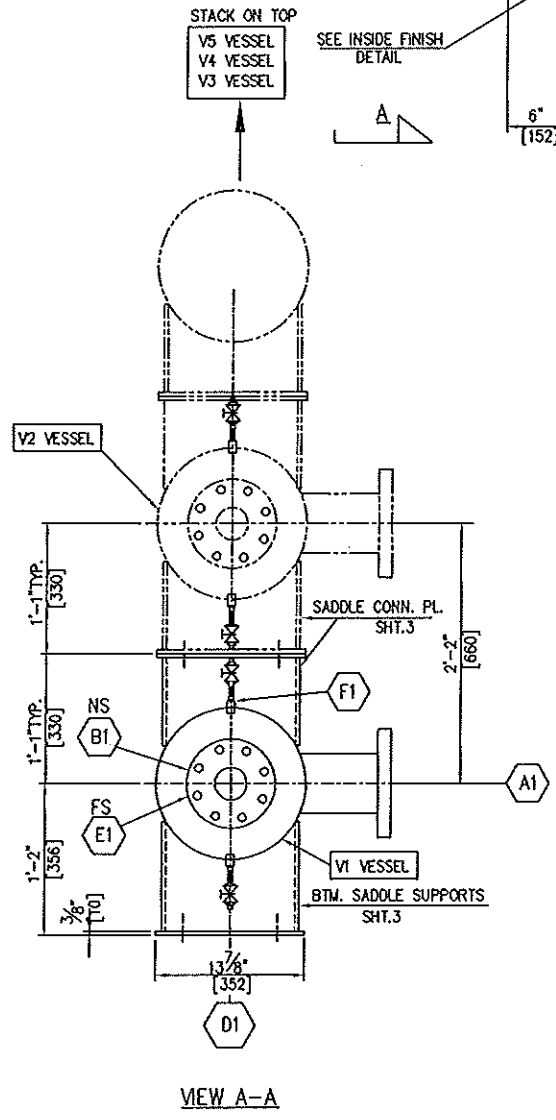

APPLY "DOW" VACUUM GREASE TO FINISH BORE AFTER MACHINING

E1 & B1 INSIDE FINISH DETAIL FOR V1-V5 VESSELS

CERTIFIED AS BUILT
JCS 9/28/15

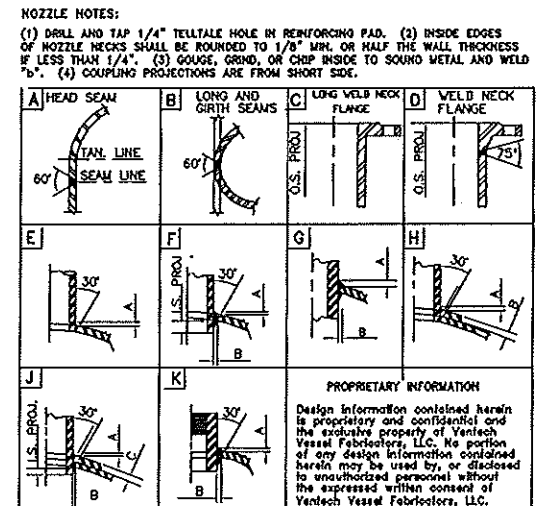

5	09-28-15	CM	JS	AS BUILT
4	07-27-15	DAN	JS	REVISED AS NOTED
3	03-24-15	JE	DAN	REVISED AS NOTED
2	03-04-15	JE	DAN	REVISED AS NOTED
1	02-17-15	JE	DAN	FOR CONSTRUCTION
REV.	DATE	BY	CKD.	DESCRIPTION
VENTECH VESSEL FABRICATORS, LLC.				
1107 BROADWAY PASADENA, TEXAS				
DRAWING TITLE: HYDROGEN MEMBRANE VESSELS GENERAL ARRANGEMENT				
CUSTOMER: VENTECH XTL Oklahoma City, LLC			ITEM NO. PK-301V1-V5	
FOR: GTL JOINT VENTURE, LLC			TAG NO.	
LOCATION: OKLAHOMA CITY, OK			CUST. P.O. 4777010-15-00112	
DRN. BY: D NASAB		DATE: 08-13-15		DWG. NO. D-8000-032-PK301V1-V5
CHKD: J. SANTOS		DATE: 08-13-15		
CERTIFIED FOR FABRICATION		DATE:		REV. 5

MARK	REQ'D	SIZE	RATING	NECK O.D.	SERVICE	NECK PL OR SCH.	O.S. PROJECTION	I.S. REINFORCING PAD SIZE	THK.	I.D.	O.D.	TYPE	STYLE	WELD SIZE
F1-F5	5	1"	3000#SW-CPLG.	1 3/4"	VENT	-	5/8"	1/2" ± 1/2"	-	-	-	K	-	3/8" 1/4"
E1-E5	5	3"	300# RFLWN	4 5/8"	RESIDUE	-	SEE DWG.	SEE DWG.	-	-	-	C	E	3/8" 1/4"
D1-D5	5	1"	3000#SW-CPLG.	1 3/4"	DRAIN	-	5/8"	1/2" ± 1/2"	-	-	-	K	F	3/8" 1/4"
B1-B5	5	3"	300# RFLWN	4 5/8"	PERMEATE	-	SEE DWG.	SEE DWG.	-	-	-	C	F	3/8" 1/4"
A1-A5	5	4"	300# RFLWN	5 1/2"	RLET	-	8"	1/2" ± 1/2"	-	-	-	C	F	3/8" 1/4"
NOZZLE SCHEDULE (INSIDE PROJECTION IS FROM THE LOWEST POINT, OUTSIDE PROJECTION IS FROM THE HIGHEST POINT LINE OF VESSEL)														