

DRY WT. PER 1/2" BAY: 82,800 [37,560 Kg]	FLOODED WT. PER 1/2" BAY: 90,840 [41,205 Kg]	SEISMIC FORCE AT 0.182g	WIND LOADING-27 PSF	SNOW LOAD-30 PSF			
COLUMN LOAD PER COLUMN (KIPS)	DRY FLOODED	WIND LOAD HORIZONTAL -Y	WIND LOAD HORIZONTAL -X	SEISMIC LOAD HORIZONTAL -Y	SEISMIC LOAD HORIZONTAL -X	SNOW LOAD -Y	
COLUMN "A"	8.0 [3629]	11.6 [5262]	3.2 [1452]	2.8 [1179]	5.0 [2268]	3.0 [1361]	2.4 [1089]
COLUMN "B"	13.7 [6214]	15.1 [6849]	6.6 [2994]	5.4 [2485]	6.6 [2994]	2.8 [1315]	4.9 [2223]
COLUMN "C"	8.0 [3629]	7.7 [3493]	3.2 [1452]	2.8 [1179]	3.2 [1452]	1.9 [862]	2.4 [1089]
PUMP SKID PER ANCHOR	2.2 [998]	2.5 [1134]	0.5 [227]	0.7 [317]	0.4 [181]	0.6 [272]	0.7 [317]


FOUNDATION LOADS CALCULATED PER IRC 2000  
 WIND: V<sub>35</sub> = 100 MPH  
 TERRAIN EXPOSURE = C  
 OCCUPANCY CATEGORY II

SEISMIC:  
 OCCUPANCY CATEGORY III  
 SITE CLASS D  
 S<sub>s</sub> = 0.412g  
 S<sub>1</sub> = 0.18g  
 S<sub>0.1</sub> = 0.15  
 SNOW: P<sub>g</sub> = 30 PSF  
 OCCUPANCY CATEGORY II  
 C<sub>e</sub> = 1.0  
 C<sub>f</sub> = 1.0





\* WEIGHTS SHOWN EQUATE TO 120% OF CALCULATED LOAD VALUES

STRUCTURE LOADS CALCULATED PER IRC 2006  
 WIND: V<sub>35</sub> = 100 MPH  
 TERRAIN EXPOSURE = C  
 OCCUPANCY CATEGORY III

SEISMIC:  
 OCCUPANCY CATEGORY III  
 IMPORTANCE FACTOR I = 1.5  
 SITE SOIL CLASS D  
 S<sub>s</sub> = 0.41g  
 S<sub>1</sub> = 0.15  
 SNOW: P<sub>g</sub> = 30 PSF  
 OCCUPANCY CATEGORY II  
 C<sub>e</sub> = 1.0  
 C<sub>f</sub> = 1.0

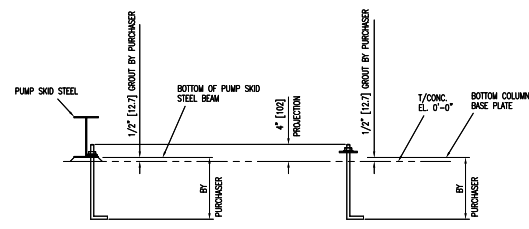

- COLUMN ANCHORS  
 64 - 1" [25] DIA. REOD
- PUMP SKID ANCHORS  
 6 - 3/4" [19] DIA. REOD
- PIPE SUPPORT ANCHORS  
 12 - 1/2" [13] DIA. REOD
- LADDER ANCHORS  
 8 - 1/2" [13] DIA. REOD
- SOLED 4X

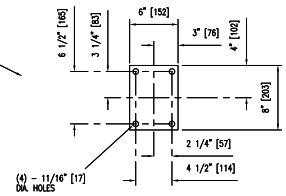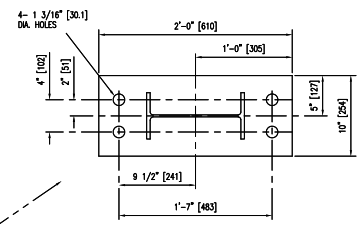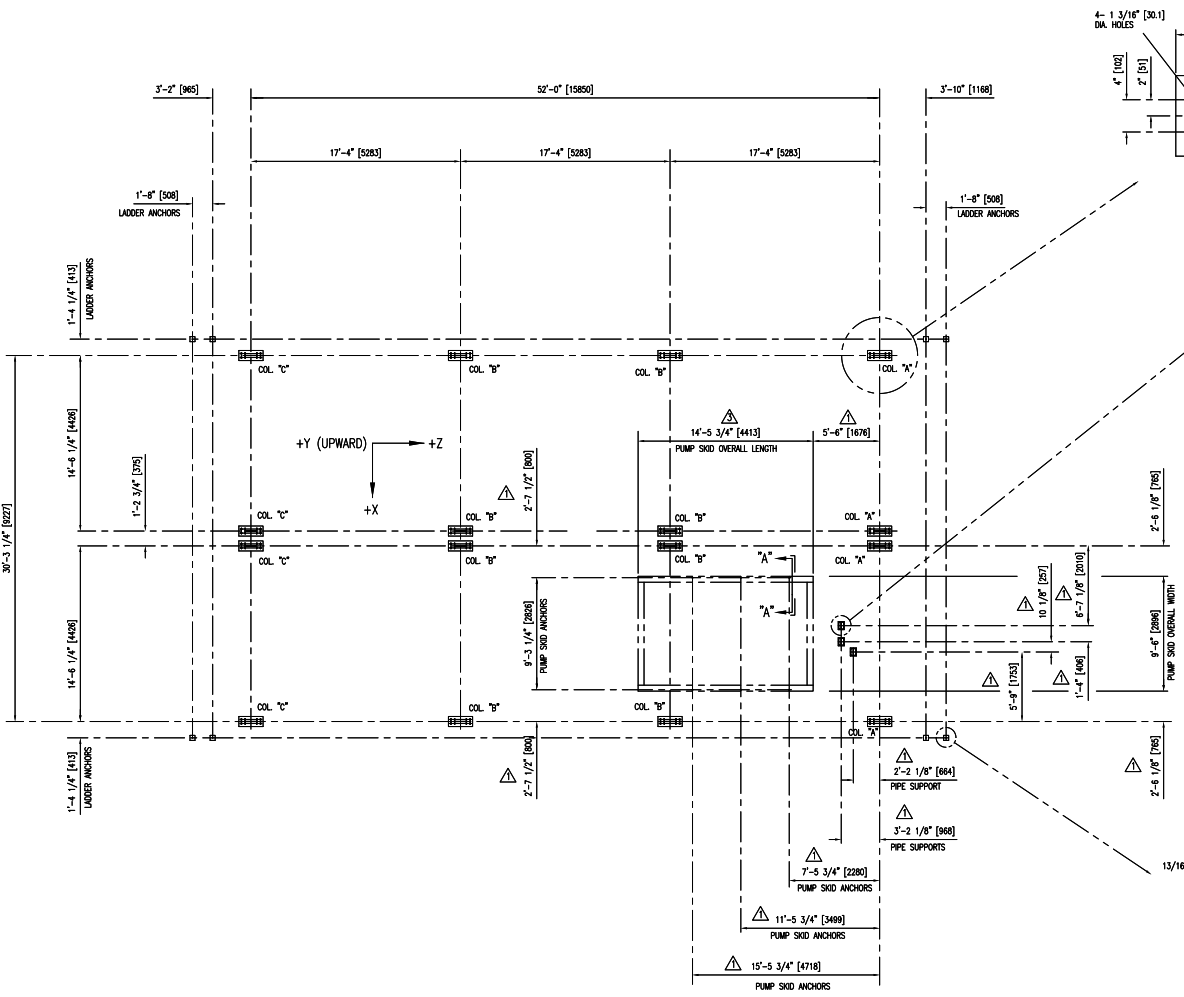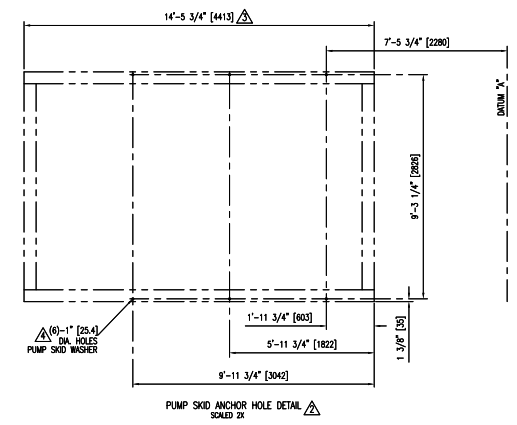


- NOTES:
- LOADS SHOWN ARE MAXIMUM VALUES FOR GRADE LOADING.
  - ANCHORS ARE TO BE FURNISHED BY THE PURCHASER.
  - FOOTING DESIGN AND ANCHOR LENGTHS ARE TO BE DETERMINED BY THE PURCHASER.
  - COOLING HEAT EXCHANGERS IS TO BE NOTIFIED OF ANY ADDITIONAL LOADS IMPOSED ON THE HEAT EXCHANGER UNITS.
  - ANCHOR BOLTS TO BE FABRICATED USING MATERIAL WITH A MINIMUM ALLOWABLE AXIAL TENSION STRESS OF 18.1 ksi, i.e. ASTM A57.


RELATED DRAWINGS  
 14496-001 SH 1 GENERAL ARRANGEMENT  
 14496-001 SH 3 PRODUCT INFORMATION SHEET  
 14496-10P0 P & ID DRAWING

UNLESS OTHERWISE SPECIFIED	REVISIONS	DATE	BY	APP'D
1. AS SHOWN	1			
2. AS SHOWN	2			
3. AS SHOWN	3			
100. AS SHOWN	100			


ANCHOR BOLT PLAN

LADDER FOOTINGS 5" X 5" SOLED 8X

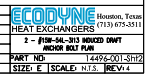


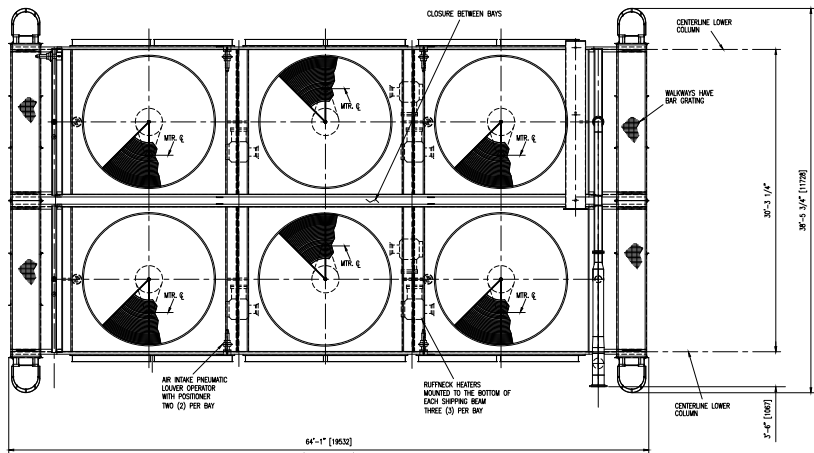


PLAN VIEW

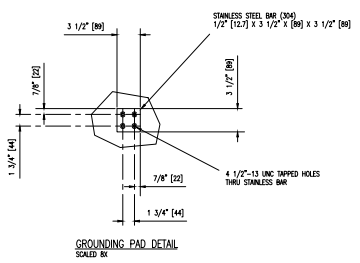

CUSTOMER INTERFACES		MATERIAL/GRICE
INLET CONNECTION	14"-150# RF FLANGE	SA-105 FS ANS STD.
OUTLET CONNECTION	14"-150# RF FLANGE	SA-105 FS ANS STD.
CLEAN-OUT CONNECTION LOCATED ON PNE-STRAINER	1" NPT GATE VALVE, (PLUGGED)	A-126, Iron
SURGE TANK FILL	2" NPT HALF COUPLING, (PLUGGED)	SA-105 FS
SURGE TANK FILL, ON TANK	2" NPT HALF COUPLING, (PLUGGED)	SA-105 FS
SURGE TANK DRAIN, ON TANK	1" NPT HALF COUPLING, (PLUGGED)	SA-105 FS
SURGE TANK DRAIN	1 1/2" NPT GATE VALVE, (PLUGGED)	A-126, Iron

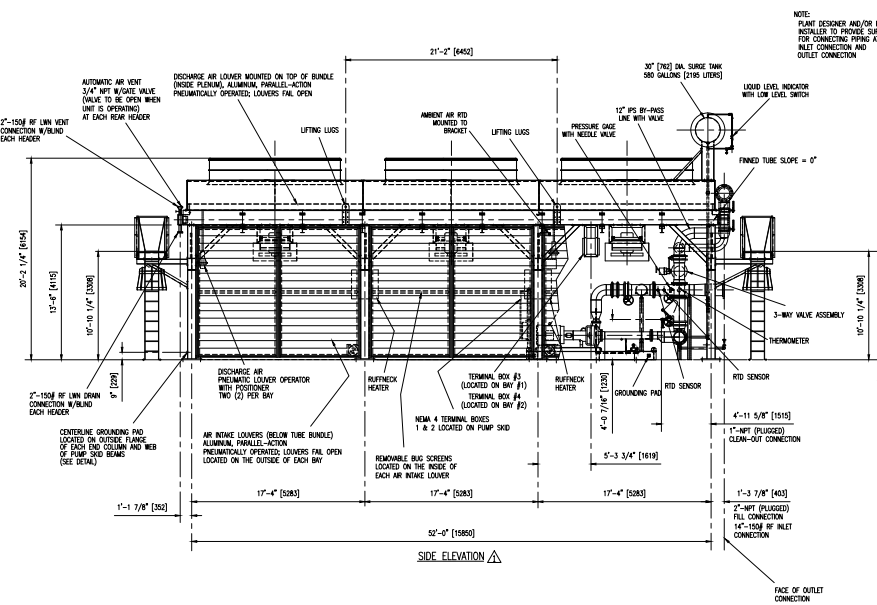

SIDE ELEVATION

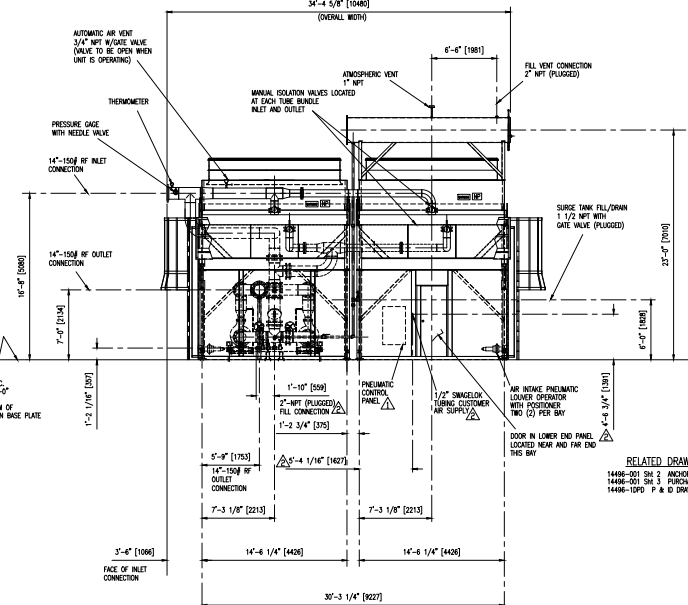


FRONT ELEVATION

NOTE: PLANT DESIGNER AND/OR PLANT ENGINEER TO PROVIDE SUPPORT FOR CONNECTING PIPING AT INLET CONNECTION AND OUTLET CONNECTION

RELATED DRAWINGS  
 1466-001 SH 2 ANCHOR BOLT PLAN  
 1466-001 SH 3 PURCHASER INFORMATION SHEET  
 1466-100P P & D DRAWING

NO.	DESCRIPTION	DATE
1	ISSUED FOR CONSTRUCTION	1/12/2011
2	REVISED	1/12/2011
3	REVISED	1/12/2011
4	REVISED	1/12/2011
5	REVISED	1/12/2011
6	REVISED	1/12/2011
7	REVISED	1/12/2011
8	REVISED	1/12/2011
9	REVISED	1/12/2011
10	REVISED	1/12/2011

**ECONYNE**  
 Houston, Texas  
 2800 West Loop South  
 Suite 1000  
 Houston, Texas 77058-4001  
 Phone: 281.460.0000  
 Fax: 281.460.0001  
 Email: sales@econyne.com  
 Website: www.econyne.com  
 PART NO: 1466-001 SH 2  
 DATE: 1/12/2011  
 DRAWN BY: E. TEAGUE

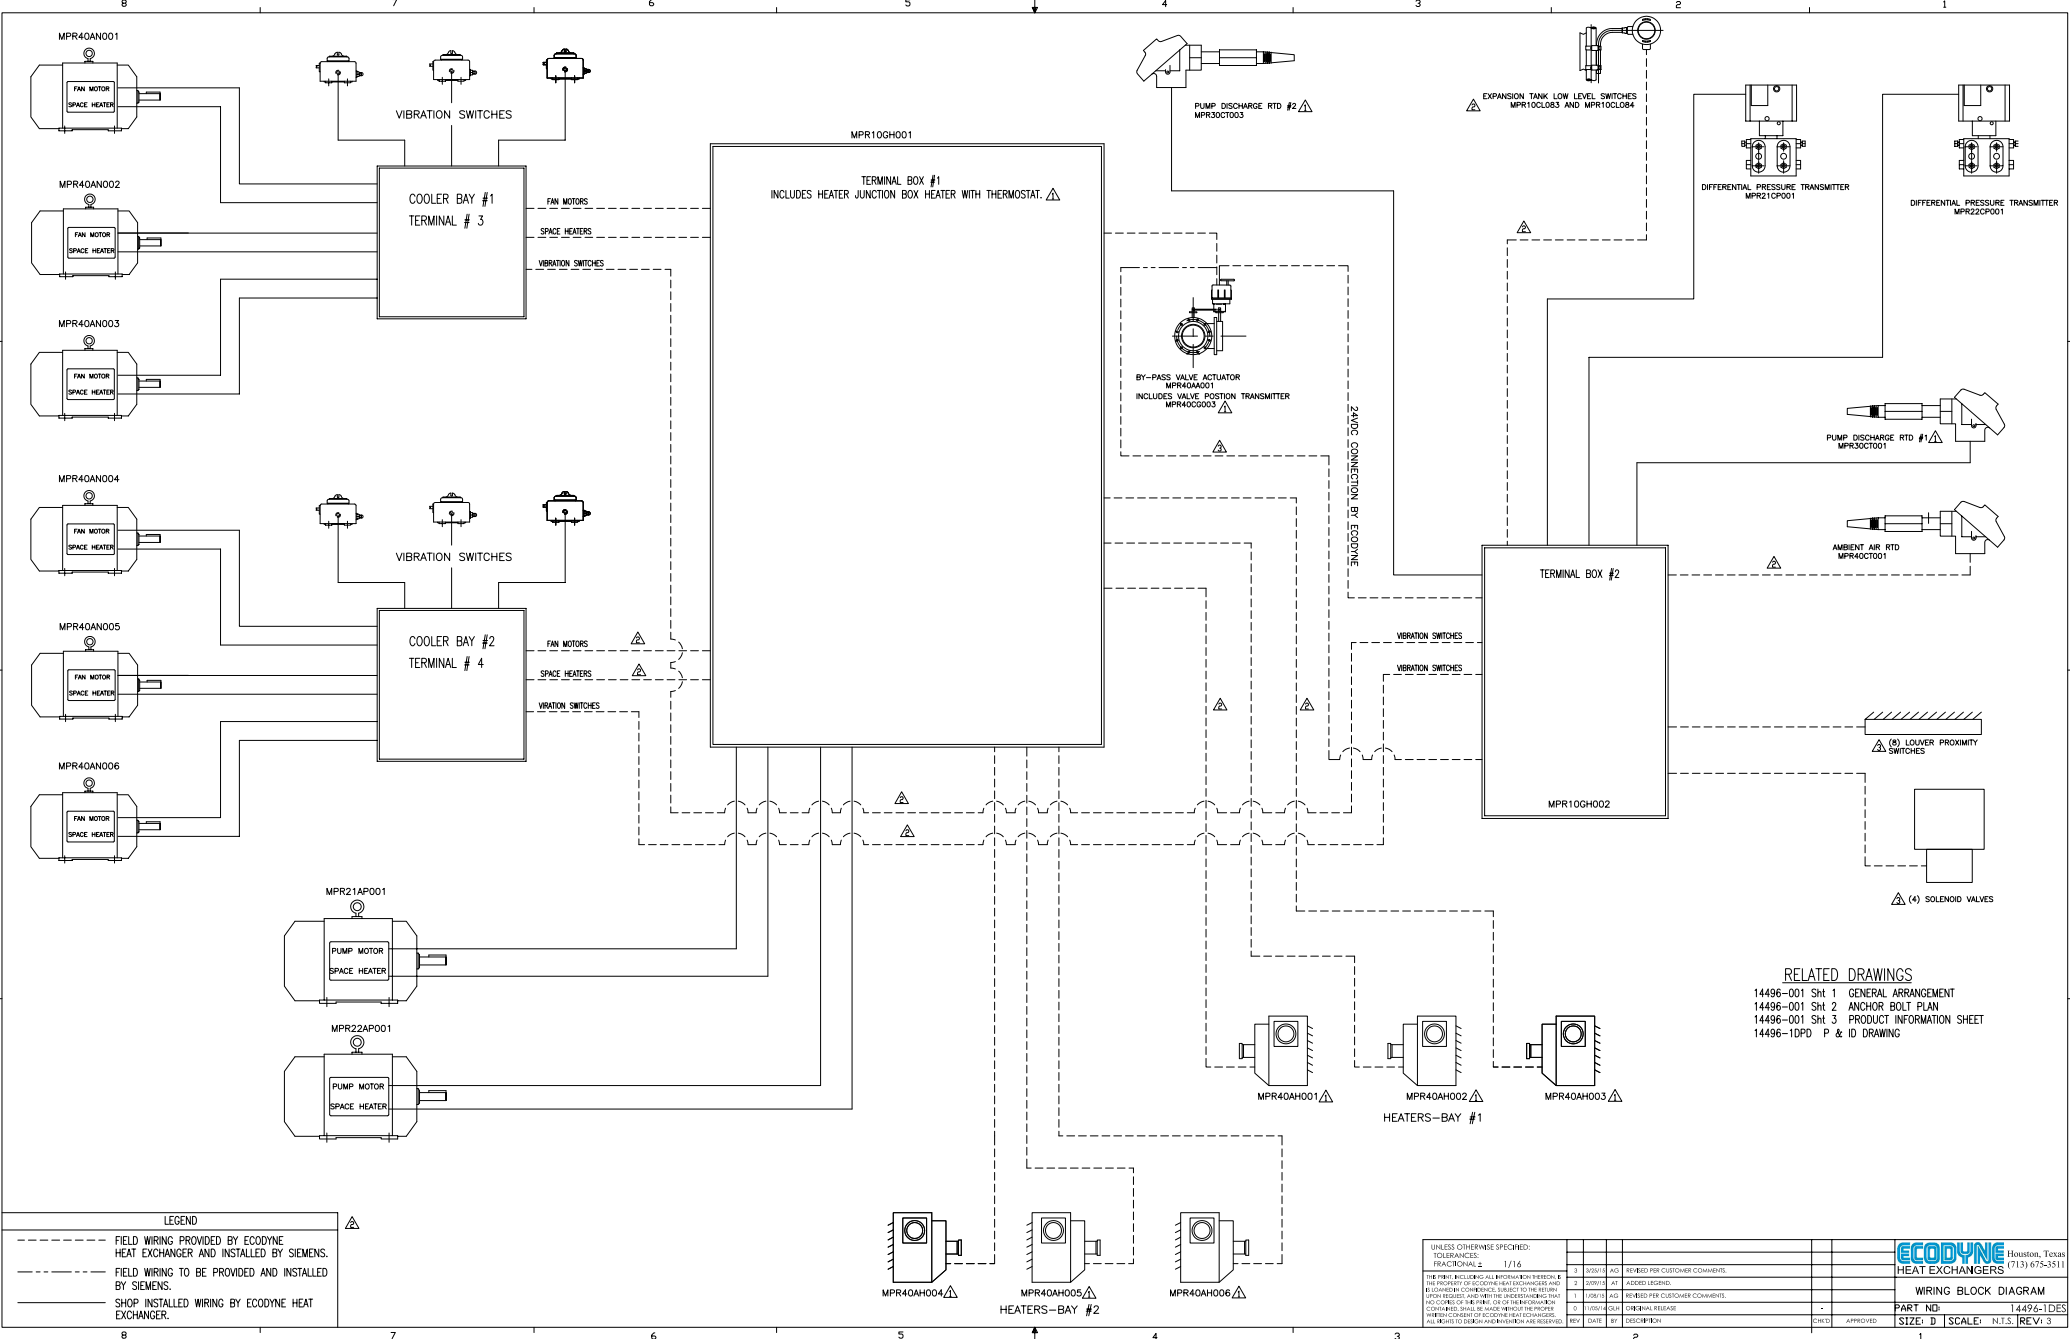


- RELATED DRAWINGS**
- 14496-001 SH1 GENERAL ARRANGEMENT
  - 14496-001 SH2 ANCHOR BOLT PLAN
  - 14496-001 SH3 PRODUCT INFORMATION SHEET
  - 14496-1DPD P & ID DRAWING

**LEGEND**

- - - - - FIELD WIRING PROVIDED BY ECODYNE HEAT EXCHANGER AND INSTALLED BY SIEMENS.
- - - - - FIELD WIRING TO BE PROVIDED AND INSTALLED BY SIEMENS.
- - - - - SHOP INSTALLED WIRING BY ECODYNE HEAT EXCHANGER.

UNLESS OTHERWISE SPECIFIED:			TOLERANCES:		DRAWING SCALE:		DATE		APPROVED		ECODYNE Houston, Texas	
FRAC. DECIMALS			1/16								17131 675-5511	
3	3/32	AS				REQUIRED FOR CUSTOMER COMMENTS						<b>WIRING BLOCK DIAGRAM</b>
2	3/64	AT				SEEDED LEGENDS						
1	3/128	AS				REQUIRED FOR CUSTOMER COMMENTS						
0	1/256	AS				CUSTOMER APPROVAL						
REV.	DATE	BY	DESCRIPTION					CHKD		APPROVED		PART NO. 14496-1DES
											SIZE: D SCALE: N.T.S. [REV: 3]	


HEAT EXCHANGER  
TERMINAL BOX #3

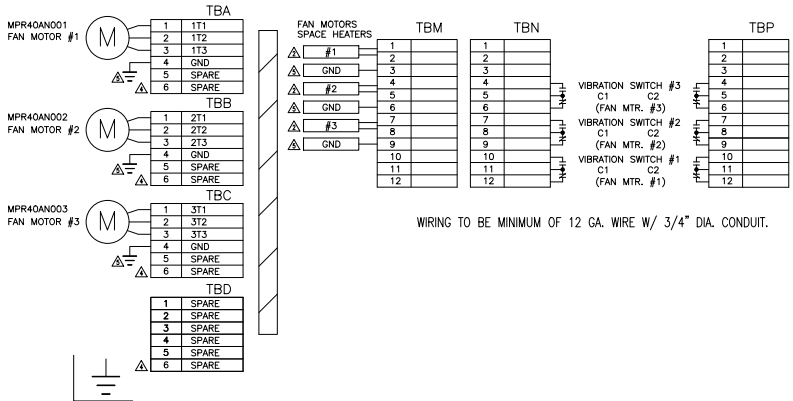

INTERCONNECTION WIRING  
HEAT EXCHANGER TERMINAL BOX #3 TO MAIN JUNCTION BOXES ON PUMP SKID

TERMINAL BOX #3	TO	TERMINAL BOX MPR10GH001
FAN MTR LEADS	TBA1	TB1-1
	TBA2	TB1-2
	TBA3	TB1-3
FAN MTR SPACE HTR LEADS	TBB1	TB2-1
	TBB2	TB2-2
	TBB3	TB2-3
	TBC1	TB3-1
	TBC2	TB3-2
	TBC3	TB3-3
VIB SWITCH LEADS	TBM1	TB7-1
	TBM2	TB7-2
	TBM3	TB7-3
	TBM4	TB7-4
	TBM5	TB7-5
	TBM6	TB7-6
VIB SWITCH LEADS	TBN5	TB2-11
	TBN6	TB2-12
	TBN8	TB2-14
	TBN9	TB2-15
	TBN11	TB2-17
	TBN12	TB2-18
	TBP5	TB3-11
	TBP6	TB3-12
	TBP8	TB3-14
	TBP9	TB3-15
	TBP11	TB3-17
	TBP12	TB2-18

HEAT EXCHANGER  
TERMINAL BOX #4

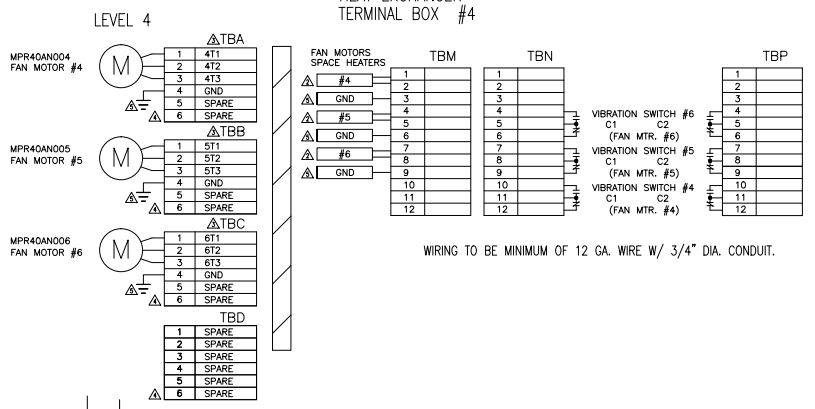

INTERCONNECTION WIRING  
HEAT EXCHANGER TERMINAL BOX #4 TO MAIN JUNCTION BOXES ON PUMP SKID

TERMINAL BOX #4	TO	TERMINAL BOX MPR10GH001
FAN MTR LEADS	TBD1	TB4-1
	TBD2	TB4-2
	TBD3	TB4-3
FAN MTR SPACE HTR LEADS	TBE1	TB5-1
	TBE2	TB5-2
	TBE3	TB5-3
FAN MTR SPACE HTR LEADS	TBF1	TB6-1
	TBF2	TB6-2
	TBF3	TB6-3
VIB SWITCH LEADS	TBN1	TB7-7
	TBN2	TB7-8
	TBN3	TB7-9
	TBN4	TB7-10
	TBN5	TB7-11
	TBN6	TB7-12
VIB SWITCH LEADS	TBN5	TB2-2
	TBN6	TB2-3
	TBN8	TB2-5
	TBN9	TB2-6
	TBN11	TB2-8
	TBN12	TB2-9
	TBP5	TB3-2
	TBP6	TB3-3
	TBP8	TB3-5
TBP9	TB3-6	
TBP11	TB3-8	
TBP12	TB3-9	

- RELATED DRAWINGS
- 14496-001 SH 1 GENERAL ARRANGEMENT
  - 14496-001 SH 2 ANCHOR BOLT PLAN
  - 14496-001 SH 3 PRODUCT INFORMATION SHEET
  - 14496-10PD P & ID DRAWING

- NOTES:
1. JUNCTION ZBOXES TO BE NEMA 4.
  2. WIRING TO BE MINIMUM OF 12 GA. WIRE W/ 3/4" DIA. CONDUIT.

UNLESS OTHERWISE SPECIFIED:	3	1/16	AG	REVISED TO SHOW AS BUILT
TOLERANCES:	3	1/16 <td>AG</td> <td>REVISED TO SHOW AS BUILT</td>	AG	REVISED TO SHOW AS BUILT
FUNCTIONAL:	1/16 <td></td> <td></td> <td></td>			
THIS PRINT INCLUDING ALL INFORMATION THEREON IS THE PROPERTY OF ECODYNE HEAT EXCHANGERS AND IS LOANED TO YOUR FACILITY TO BE USED ONLY FOR THE PROJECT AND WORK ORDER SPECIFICALLY IDENTIFIED ON THE DRAWING. IT IS NOT TO BE REPRODUCED, COPIED, OR TRANSMITTED IN ANY MANNER WITHOUT THE EXPRESS WRITTEN CONSENT OF ECODYNE HEAT EXCHANGERS. ALL RIGHTS TO DESIGN AND INVENTION ARE RESERVED.	1	1/16	AG	REVISED PER CUSTOMER COMMENTS
	2	1/16	AG	REVISED PER CUSTOMER COMMENTS
	3	1/16	AG	REVISED PER CUSTOMER COMMENTS
	4	1/16	AG	REVISED PER CUSTOMER COMMENTS
**ECODYNE** Houston, Texas  
713) 675-3511

HEAT EXCHANGERS

PART NO: 14496-1111

SIZE: D | SCALE: 1:1 | REV: 5