


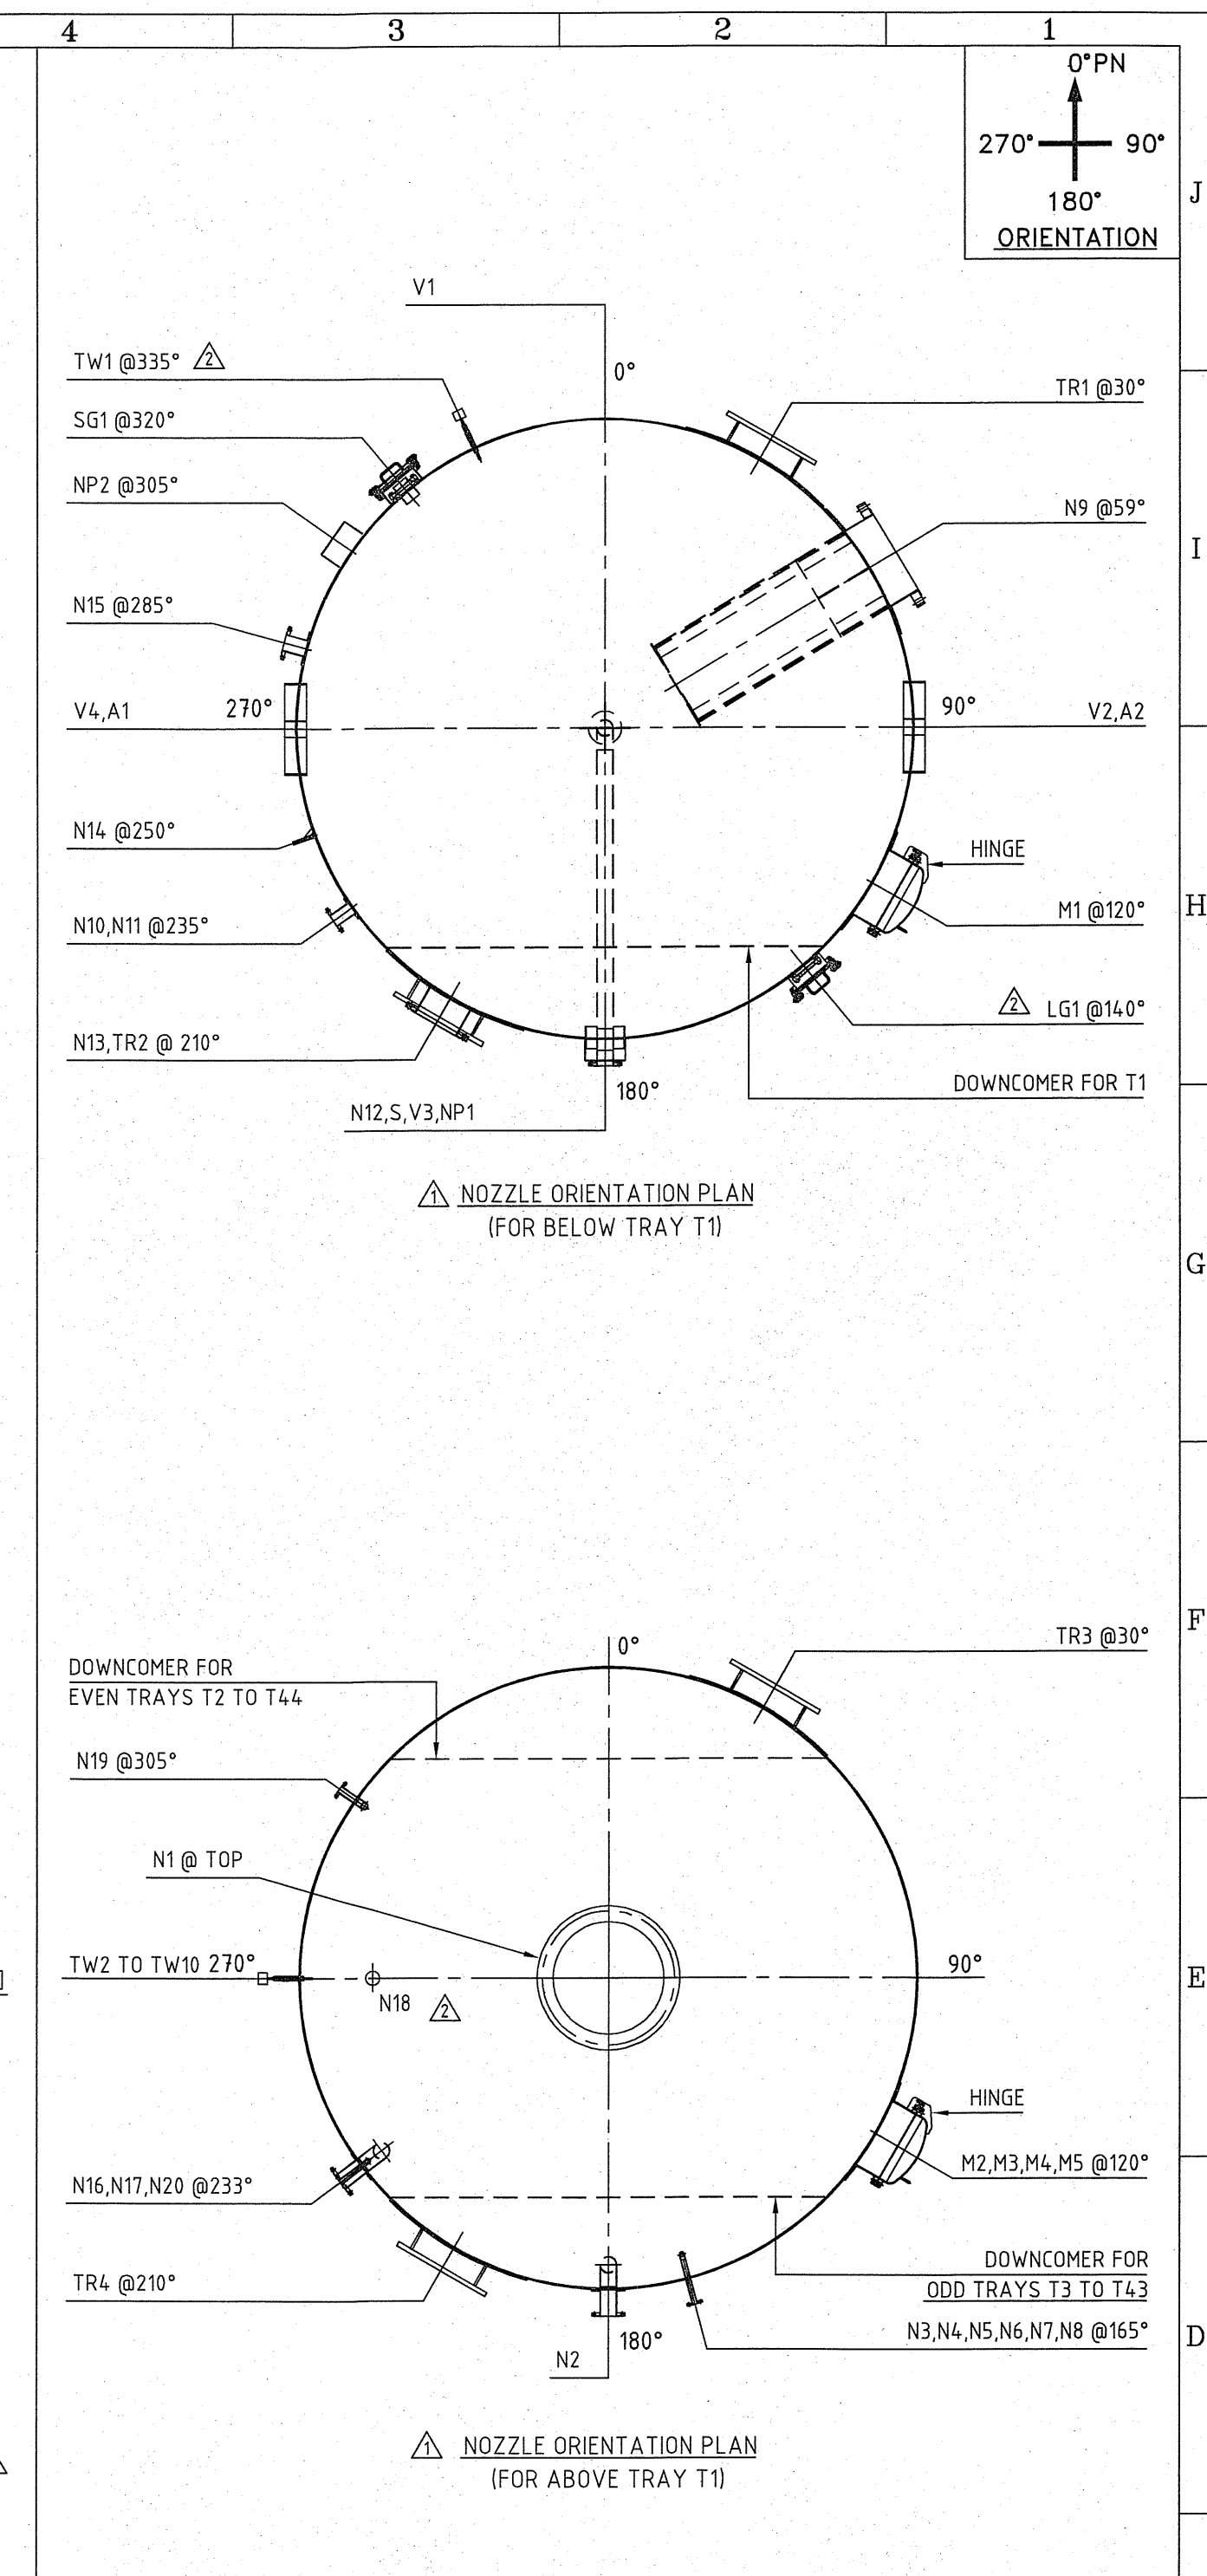

ORIGINAL			
AS BUILT DWG.			
3	AS BUILT	G.S.S.	Y.S.G. ✓
2	REVISED AS MARKED A	K.S.P.	G.S.S. K.B. 26/02/2008
1	REVISED AS MARKED A	K.S.P.	G.S.S. K.B. 30/01/2008
0	FOR FABRICATION	K.S.P.	G.S.S. K.B. 08/10/2007
REV. NO.	DESCRIPTION	DRAWN	CHKD. APPD. DATE
CLIENT LOUISIANA GREEN FUELS LTD. PLANT 22.45 MGPY DEHYDRATED ETHANOL (UNDENATURED) LOCATION LA CASSINE, LOUISIANA, USA			
	THIS DWG. IS THE PROPERTY OF PRAJ INDUSTRIES LTD. AND SHOULD NOT BE REPRODUCED WITHOUT WRITTEN CONSENT FROM PRAJ INDUSTRIES LTD. "PRAJ HOUSE", Bavdhan, Pune-411 021. (INDIA)		
TITLE : GENERAL ASSEMBLY DRAWING FOR RECTIFIER COLUMN (C-1461)			
		I.D. NO. C-1461	PIL JOB CODE 06D058
		SCALE N.T.S.	CAD FILE NAME 06D058-1-GAD403
DWG. NO.	06D058 — 1 — GAD403	SHEET 1 OF 1 REV. 3	
4	3	2	1