
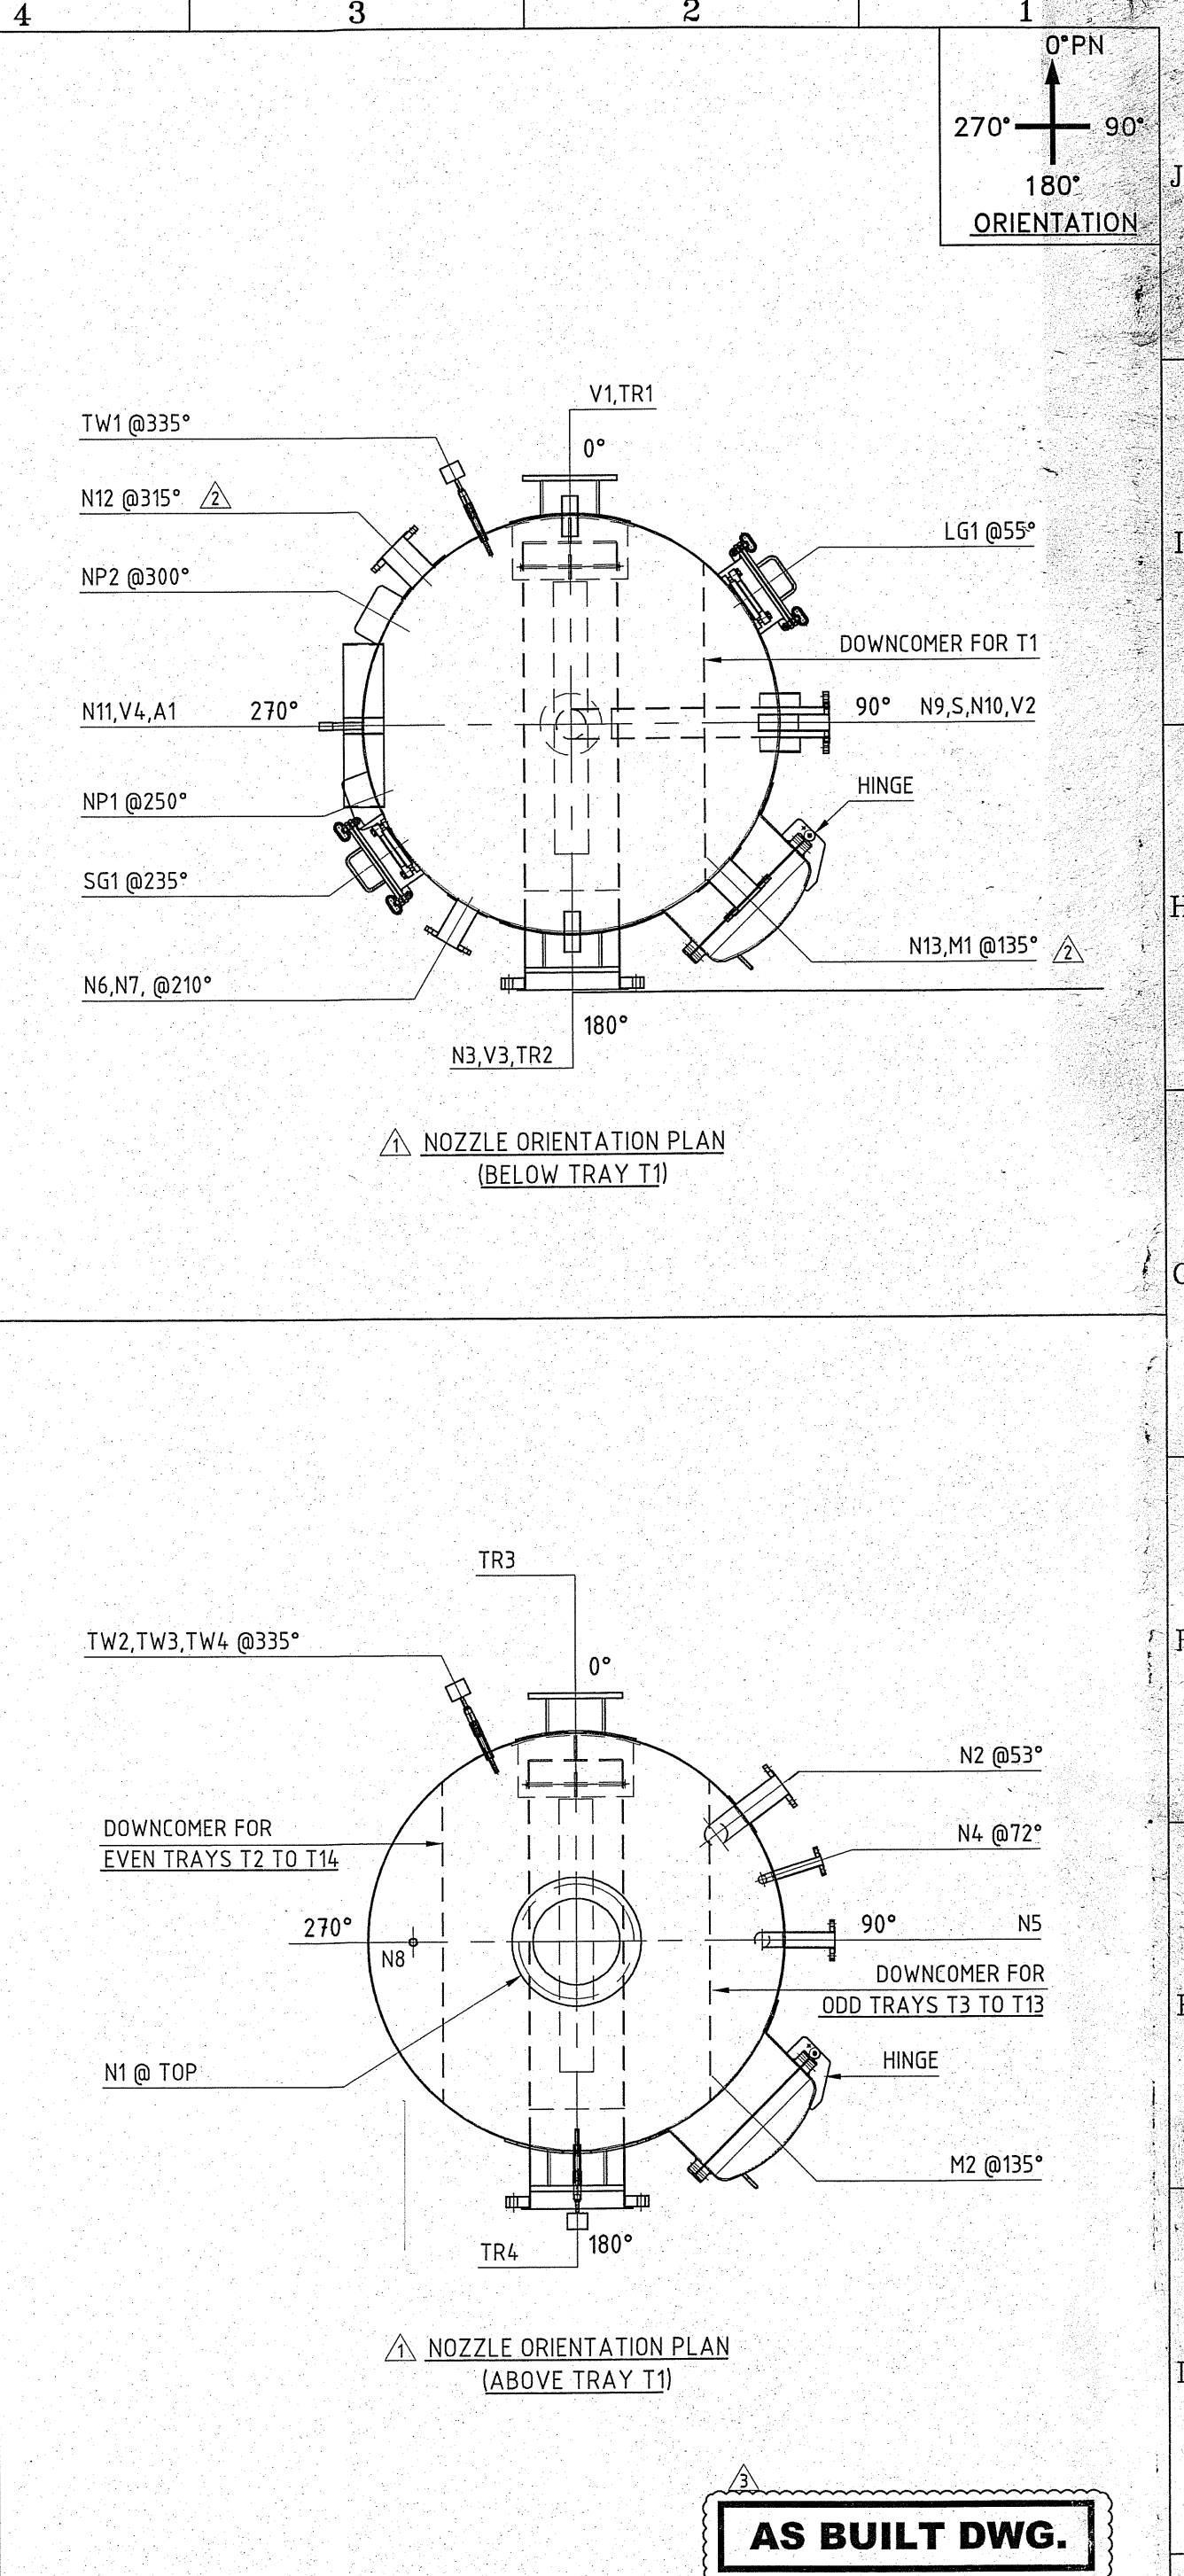


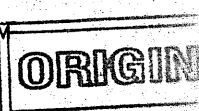

3	AS BUILT DWG 	PSK	YSG	KB 	28/03/2008
2	REVISED AS MARKED 	K.S.P.	G.S.S.	K.B.	06/03/2008
1	REVISED AS MARKED 	K.S.P.	G.S.S.	K.B.	30/01/2008
0	FOR FABRICATION	K.G.W.	G.S.S.	K.B.	08/10/2007 ¹
REV. NO.	DESCRIPTION	DRAWN	CHKD.	APPD.	DATE
CLIENT : LOUISIANA GREEN FUELS LLC. PLANT : 22.45 MGPY DEHYDRATED ETHANOL (UNDENATURED) LOCATION : LA CASSINE, LOUISIANA, USA					
		THIS DWG. IS THE PROPERTY OF PRAJ INDUSTRIES LTD. AND SHOULD NOT BE REPRODUCED WITHOUT WRITTEN CONSENT FROM PRAJ INDUSTRIES LTD. "PRAJ HOUSE", Baydhan, Pune-411 021. (INDIA)			
TITLE: GENERAL ASSEMBLY DRAWING FOR SIDE STRIPPER COLUMN (C-1462)		I.D. NO. C-1462	PIL JOB CODE 06D058		
		SCALE N.T.S.	CAD FILE NAME: 06D058-1-GAD404		
DWG. NO.	06D058 - 1 - GAD404		SHEET 1 OF 1	REV. 3	