


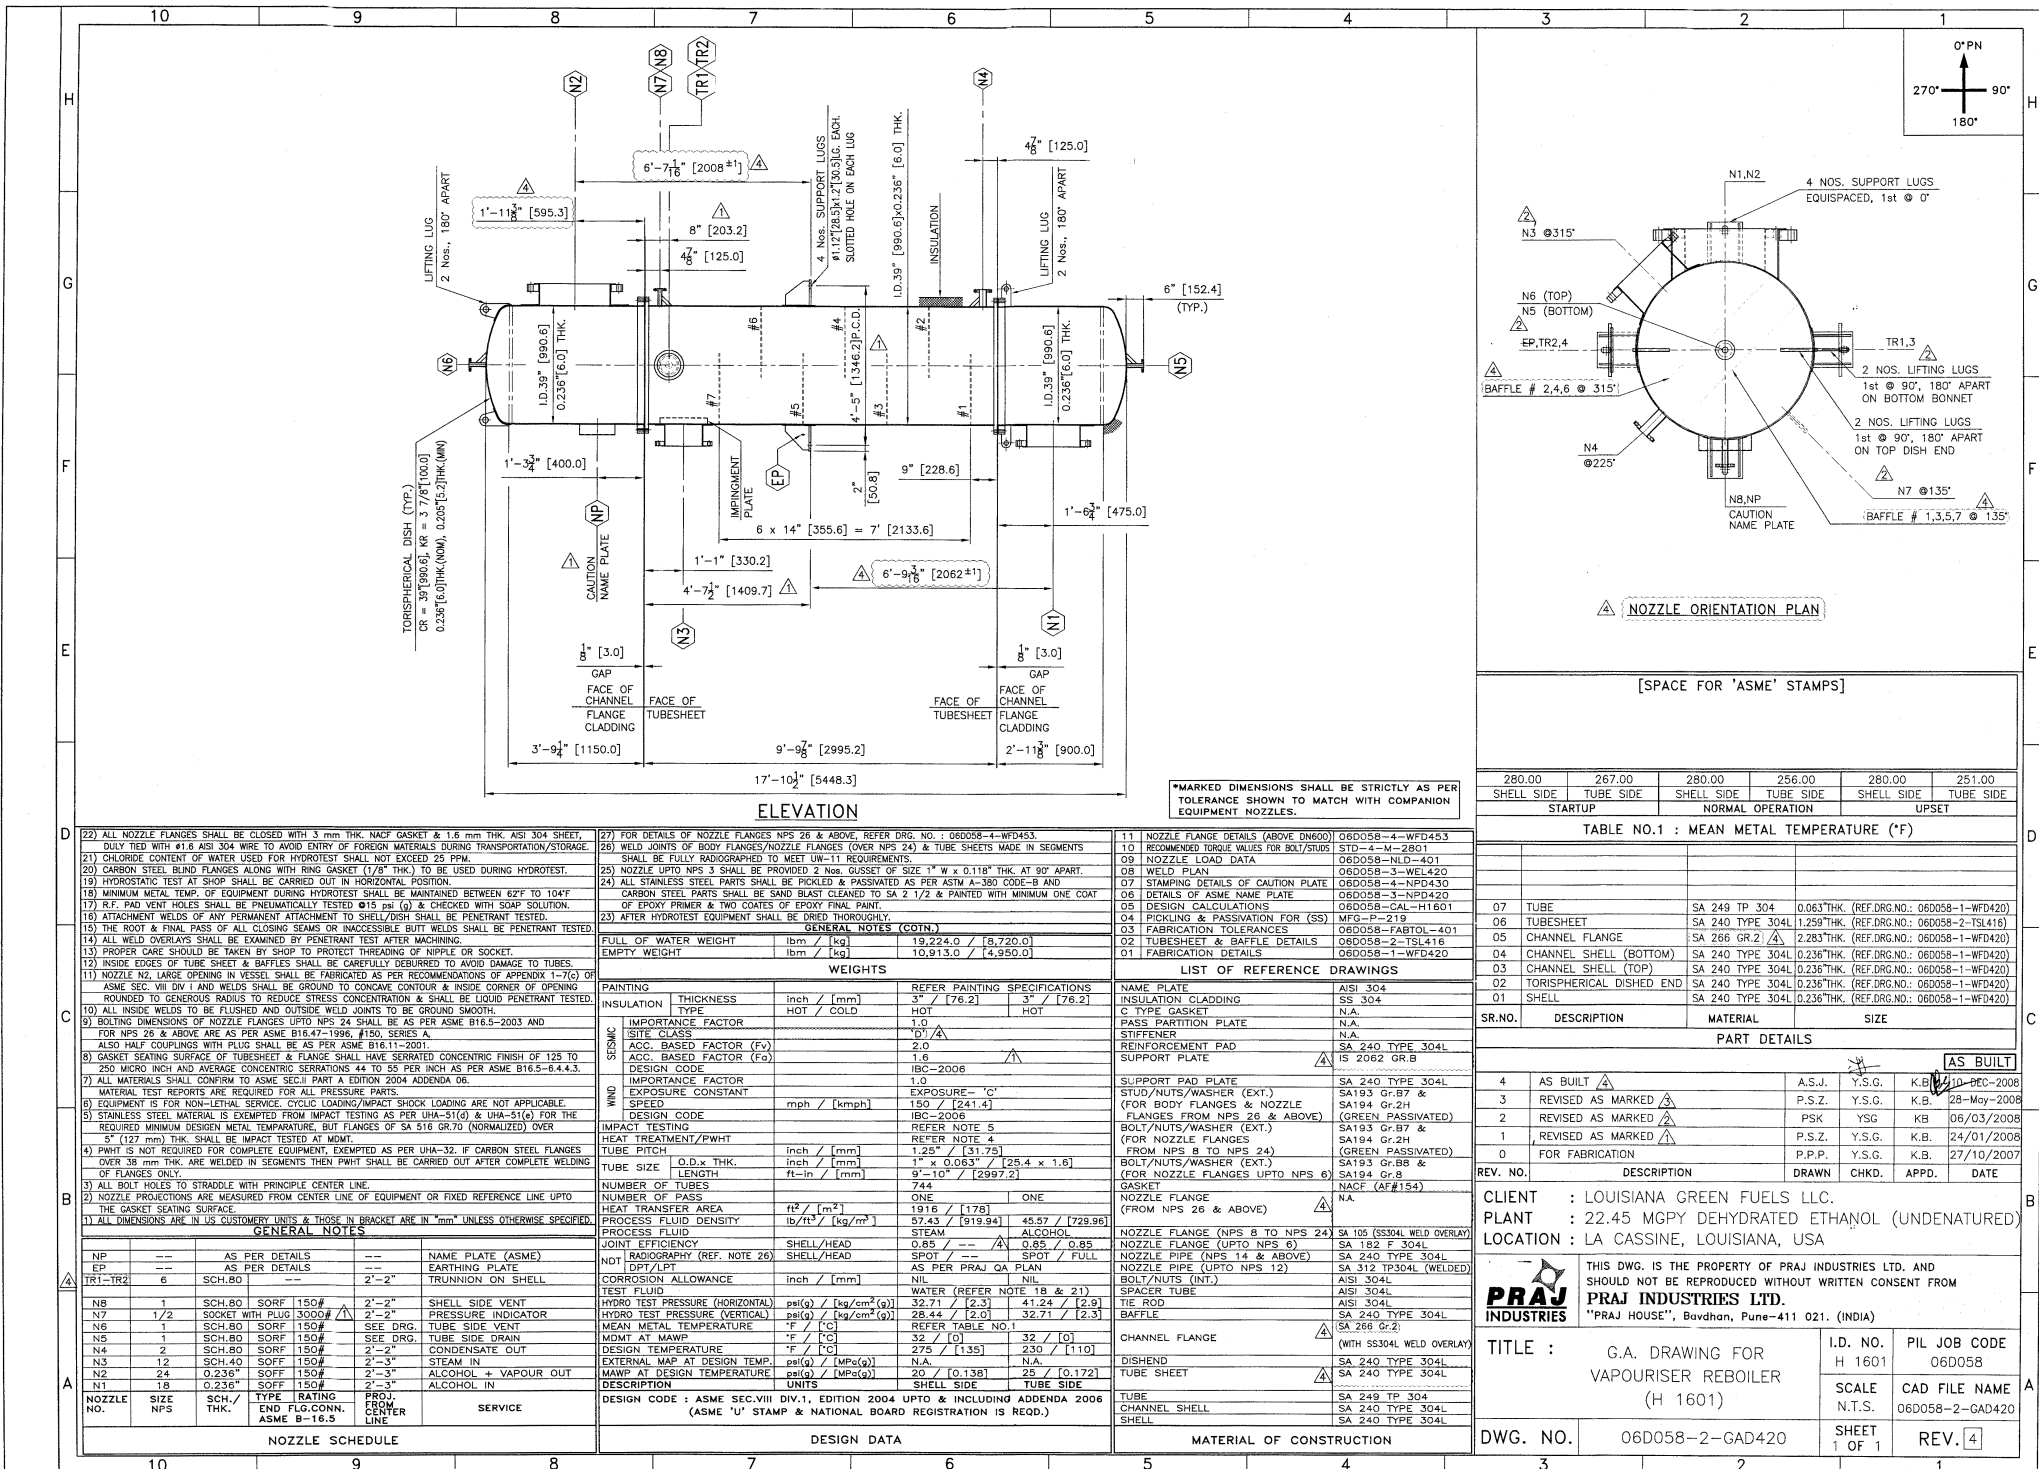

280.00	267.00	280.00	256.00	280.00	251.00
SHELL SIDE	TUBE SIDE	SHELL SIDE	TUBE SIDE	SHELL SIDE	TUBE SIDE
STARTUP		NORMAL OPERATION		UPSET	

TABLE NO.1 : MEAN METAL TEMPERATURE (°F)

SR.NO.	DESCRIPTION	MATERIAL	DETAILS	SIZE
07	TUBE	SA 249 TP 304	0.063" THK. (REF.DRG.NO.: 06D058-1-WFD420)	
08	TUBESHEET	SA 240 TYPE 304L	1.259" THK. (REF.DRG.NO.: 06D058-2-TSL416)	
05	CHANNEL FLANGE	SA 266 GR.2	2.263" THK. (REF.DRG.NO.: 06D058-1-WFD420)	
04	CHANNEL SHELL (BOTTOM)	SA 240 TYPE 304L	0.236" THK. (REF.DRG.NO.: 06D058-1-WFD420)	
03	CHANNEL SHELL (TOP)	SA 240 TYPE 304L	0.236" THK. (REF.DRG.NO.: 06D058-1-WFD420)	
02	TORISPHERICAL DISHED END	SA 240 TYPE 304L	0.236" THK. (REF.DRG.NO.: 06D058-1-WFD420)	
01	SHELL	SA 240 TYPE 304L	0.236" THK. (REF.DRG.NO.: 06D058-1-WFD420)	

REV.	NO.	DESCRIPTION	DRAWN	CHKD.	APPD.	DATE
4	AS BUILT		A.S.J.	Y.S.G.	K.B.	28-May-2008
3	REVISED AS MARKED		P.S.Z.	Y.S.G.	K.B.	06/03/2008
2	REVISED AS MARKED		PSK	Y.S.G.	K.B.	24/01/2008
1	REVISED AS MARKED		P.P.P.	Y.S.G.	K.B.	27/10/2007
0	FOR FABRICATION					

CLIENT : LOUISIANA GREEN FUELS LLC.
PLANT : 22.45 MGPY DEHYDRATED ETHANOL (UNDENATURED)
LOCATION : LA CASSINE, LOUISIANA, USA

PRAJ INDUSTRIES
THIS DWG. IS THE PROPERTY OF PRAJ INDUSTRIES LTD. AND SHOULD NOT BE REPRODUCED WITHOUT WRITTEN CONSENT FROM PRAJ INDUSTRIES LTD.
"PRAJ HOUSE", Baydhan, Pune-411 021. (INDIA)

TITLE :	G.A. DRAWING FOR VAPOURISER REBOILER (H 1601)	I.D. NO. H 1601	PIL JOB CODE 06D058
DWG. NO.	06D058-2-GAD420	SCALE N.T.S.	CAD FILE NAME 06D058-2-GAD420
		SHEET 1 OF 1	REV. 4