

GOULDS SERIAL NO:
P269C021-2

ITT/GOULDS PUMPS


Engineered Products Div.
Seneca Falls, N.Y. 13148

Model: 3420
Speed: 890 RPM
Drawing No: D05540A

Size: 30X30-31G
Impeller Dia.: 31.5
Pattern No: 68567

TEST DATE: 11/12/2012
AS-BUILT PERFORMANCE CURVE

Customer: MISSISSIPPI POWER COMPANY
P.O. No:
Item No:

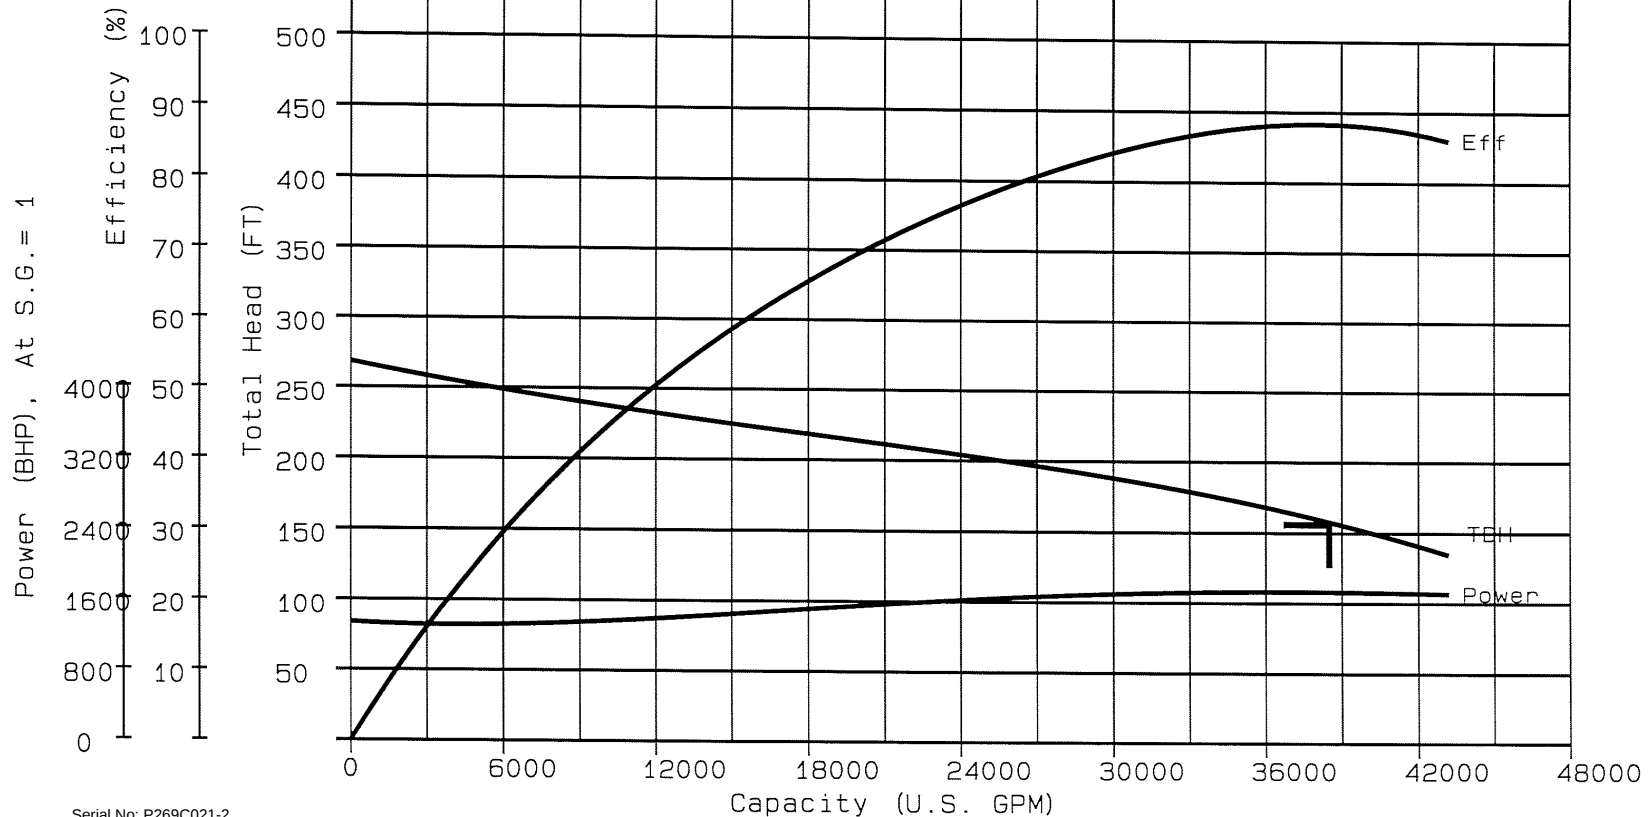

Serial No: P269C021-2
Customer: MISSISSIPPI POWER COMPANY
Project: Kemper County 1GCC
PO No: MPC10024810
Pump Item No: 01G-HE-PU- 6033
Motor Item No: 01G-HE- MO- 6033
Service: GI Closed Loop Cooling Water Pump

Doc No: 269021 T-CRV rev0
Page 1 of 2

Certified Test Data

By: Charles Hendricks
Date: 11/12/2012

Southern Company Generation **Kemper County**
MM233842 **0** **Unit 1**

BROWNLEE-MORROW ENGINEERING PO: MPC10024810
269021 T-CRV Rev: 0
IGCC - COMBINED CYCLE - MULTIPAGE - GI CLOSED LOOP COOLING WATER

Approved

GOULDS SERIAL NO:
P269C021-3

ITT/GOULDS PUMPS


Engineered Products Div.
Seneca Falls, N.Y. 13148

Model: 3420
Speed: 890 RPM
Drawing No: D05540A

Size: 30X30-31G
Impeller Dia.: 31.5
Pattern No: 68567

TEST DATE: 11/9/2012
AS-BUILT PERFORMANCE CURVE

Customer: MISSISSIPPI POWER COMPANY
P.O. No:
Item No:

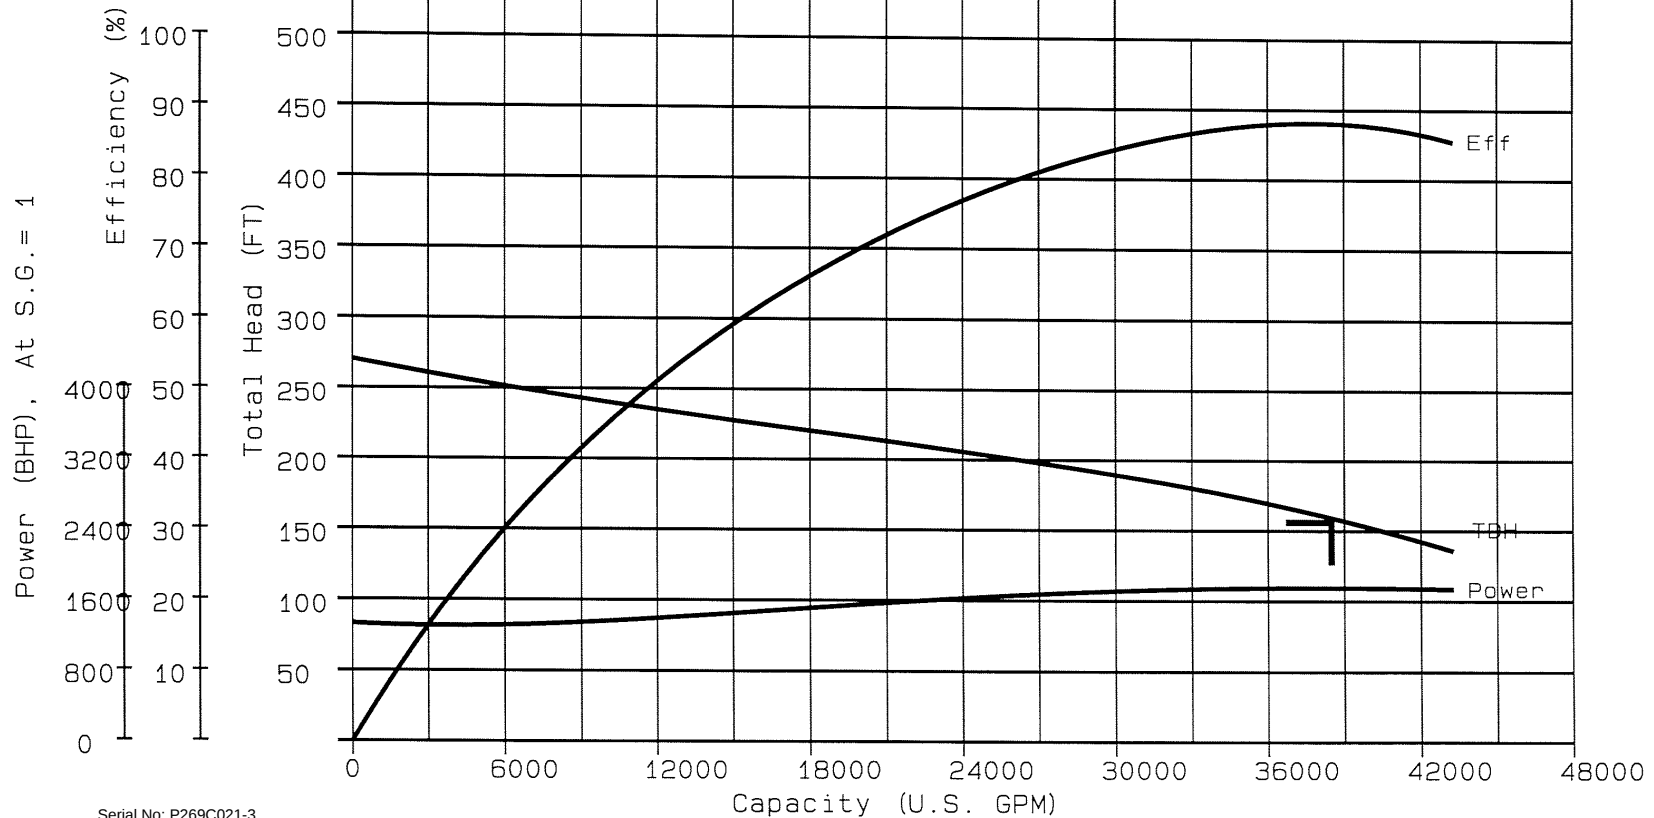

Serial No: P269C021-3
Customer: MISSISSIPPI POWER COMPANY
Project: Kemper County 1GCC
PO No: MPC10024810
Pump Item No: 01G-HE-PU- 6034
Motor Item No: 01G-HE- MO- 6034
Service: GI Closed Loop Cooling Water Pump

Doc No: 269021 T-CRV rev0
Page 2 of 2

Certified Test Data

By: *Charles H. Kelpali*
Date: 11/9/2012



Kemper County MM233842

Approved