




NOZZLE SCHEDULE

DATE RECD	CHK'D BY:	REV. BY:	DESCRIPTION	REV.
--------------	--------------	-------------	-------------	------


RE	3-25-97	NONE	7-161-A	2
----	---------	------	---------	---

111450


114401

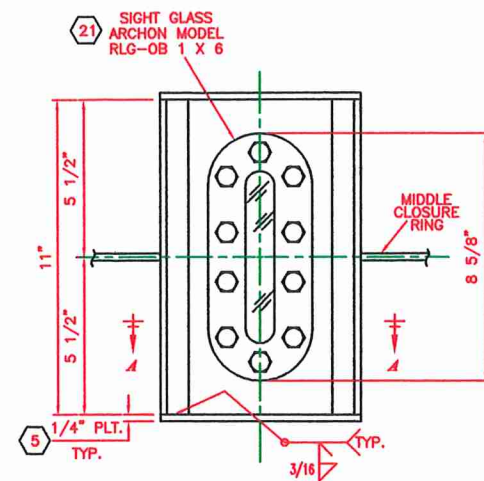


DETAIL NOZ. N13b

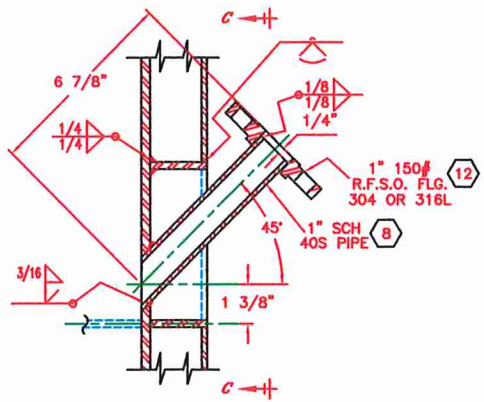


DETAIL NOZ. N8

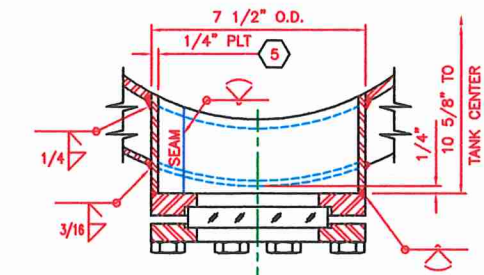


DETAIL NOZ. N15

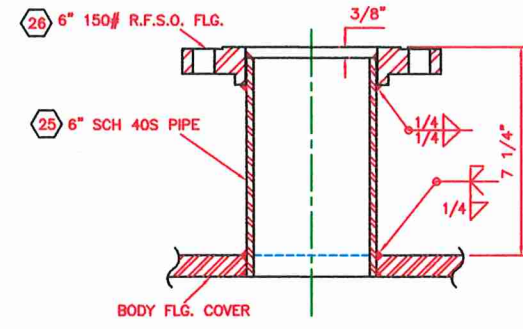


DETAIL NOZ. N9

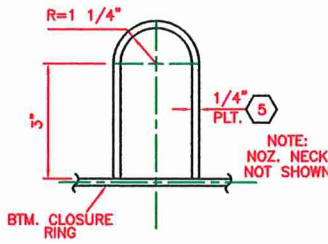


VIEW B-B
(1) REQ'D

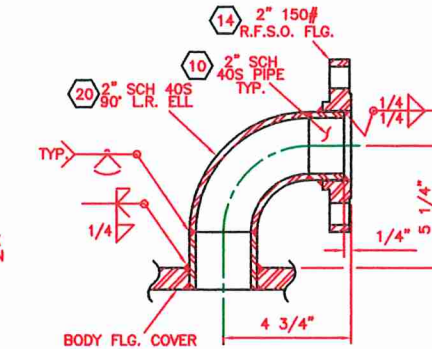


DETAIL NOZ. N6

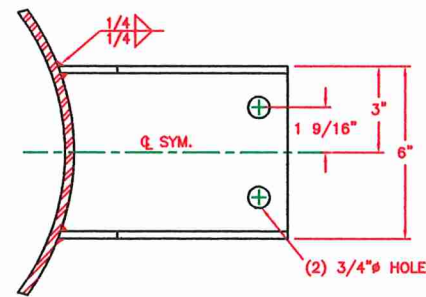


SECTION A-A
TYP. (2) PLACES

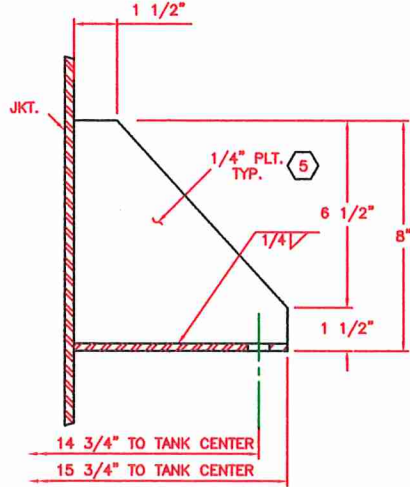


SUPPORT LUG DETAIL
(2) REQ'D @ 180° APART

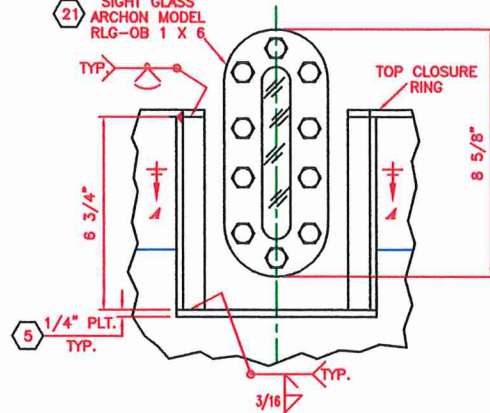


DETAIL NOZ. N13a

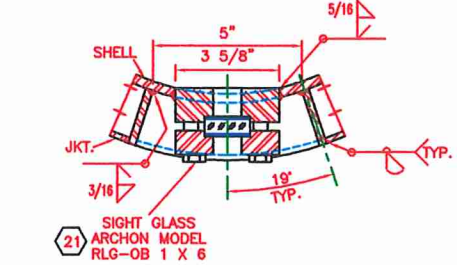


DETAIL NOZ. N10

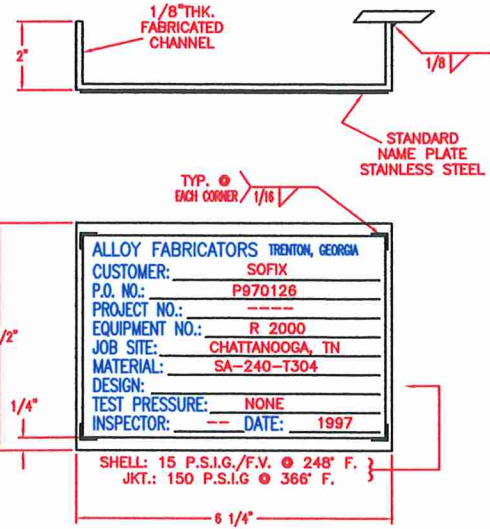


NAME PLATE DETAIL

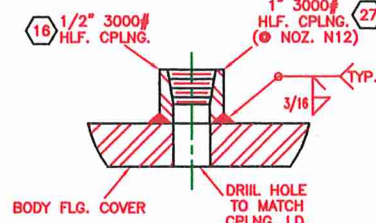


DETAIL NOZS. N3,
N4 & N12

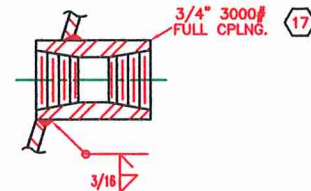


DETAIL NOZ. N7d

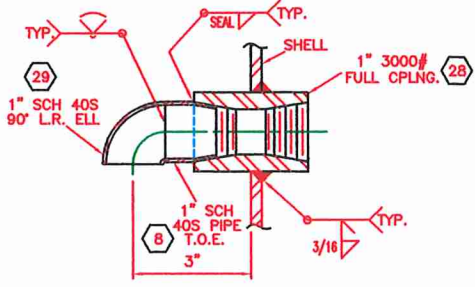


DETAIL NOZ. N1 & N2

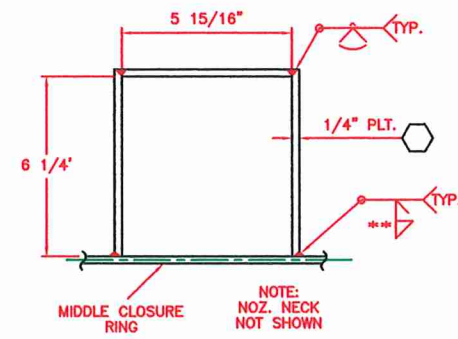


VIEW C-C
(1) REQ'D

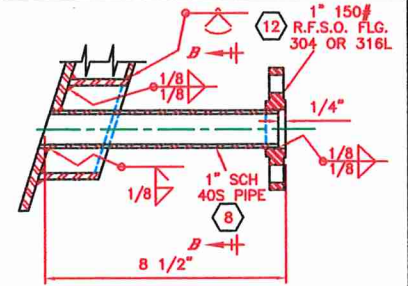

DETAIL NOZ. N14

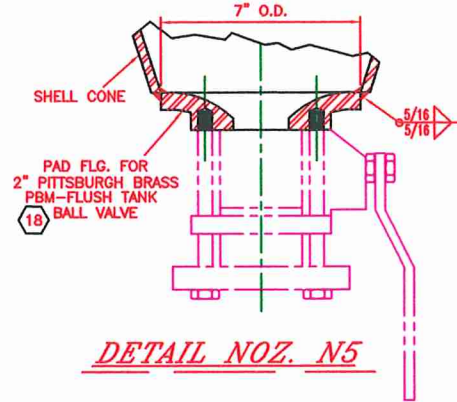

DETAIL NOZ. N5

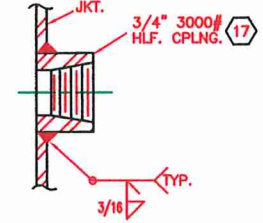

DETAIL NOZ. N7a-N7c

DRAWING STATUS		CERTIFIED RELEASED FOR FABRICATION		DATE	
PROJECT ENGINEER					
DATE REC'D		P.O. NO.: P970126			
DATE REC'D		EQUIP. No.: R 2000			
REV. BY: T.R.		PROJ. No.: ---			
REV. BY: T.R.		DRAWN BY: TERRY REYNOLDS			
REV. BY: T.R.		CHECKED BY: AVERY KEESEE			
AS BUILT		ALLOY FABRICATORS, INC.			
PER. CUST. APP.		TRENTON, GA.			
REV. ORG. ISSUE TO SHOP		CUSTOMER			
		SOFIX			
		DWG. TITLE			
		T-41 CONCENTRATING VESSEL			
DATE		SCALE		DRAWING NO. 2 of 2	
4-1-97		NONE		7-161-B	
REV.		ISSUE		2	
2					