


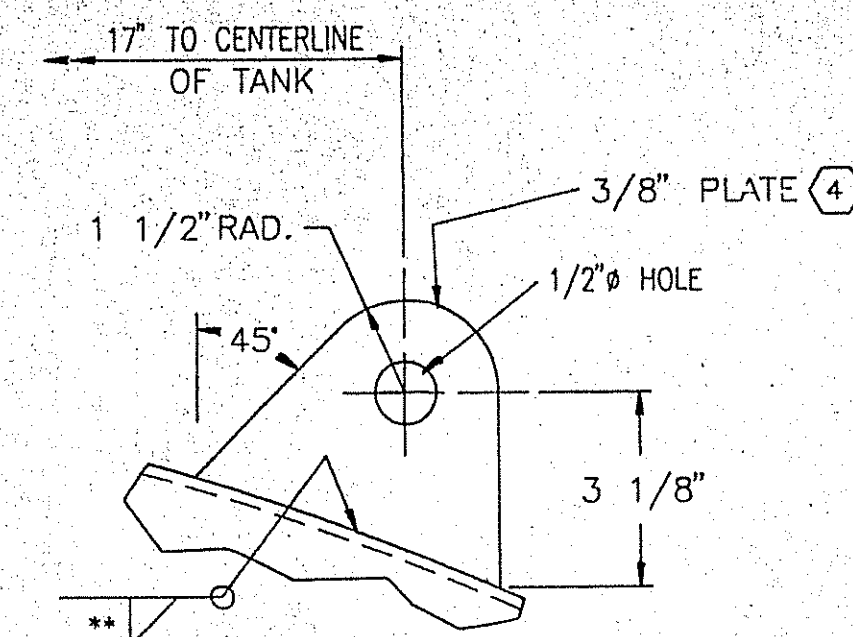


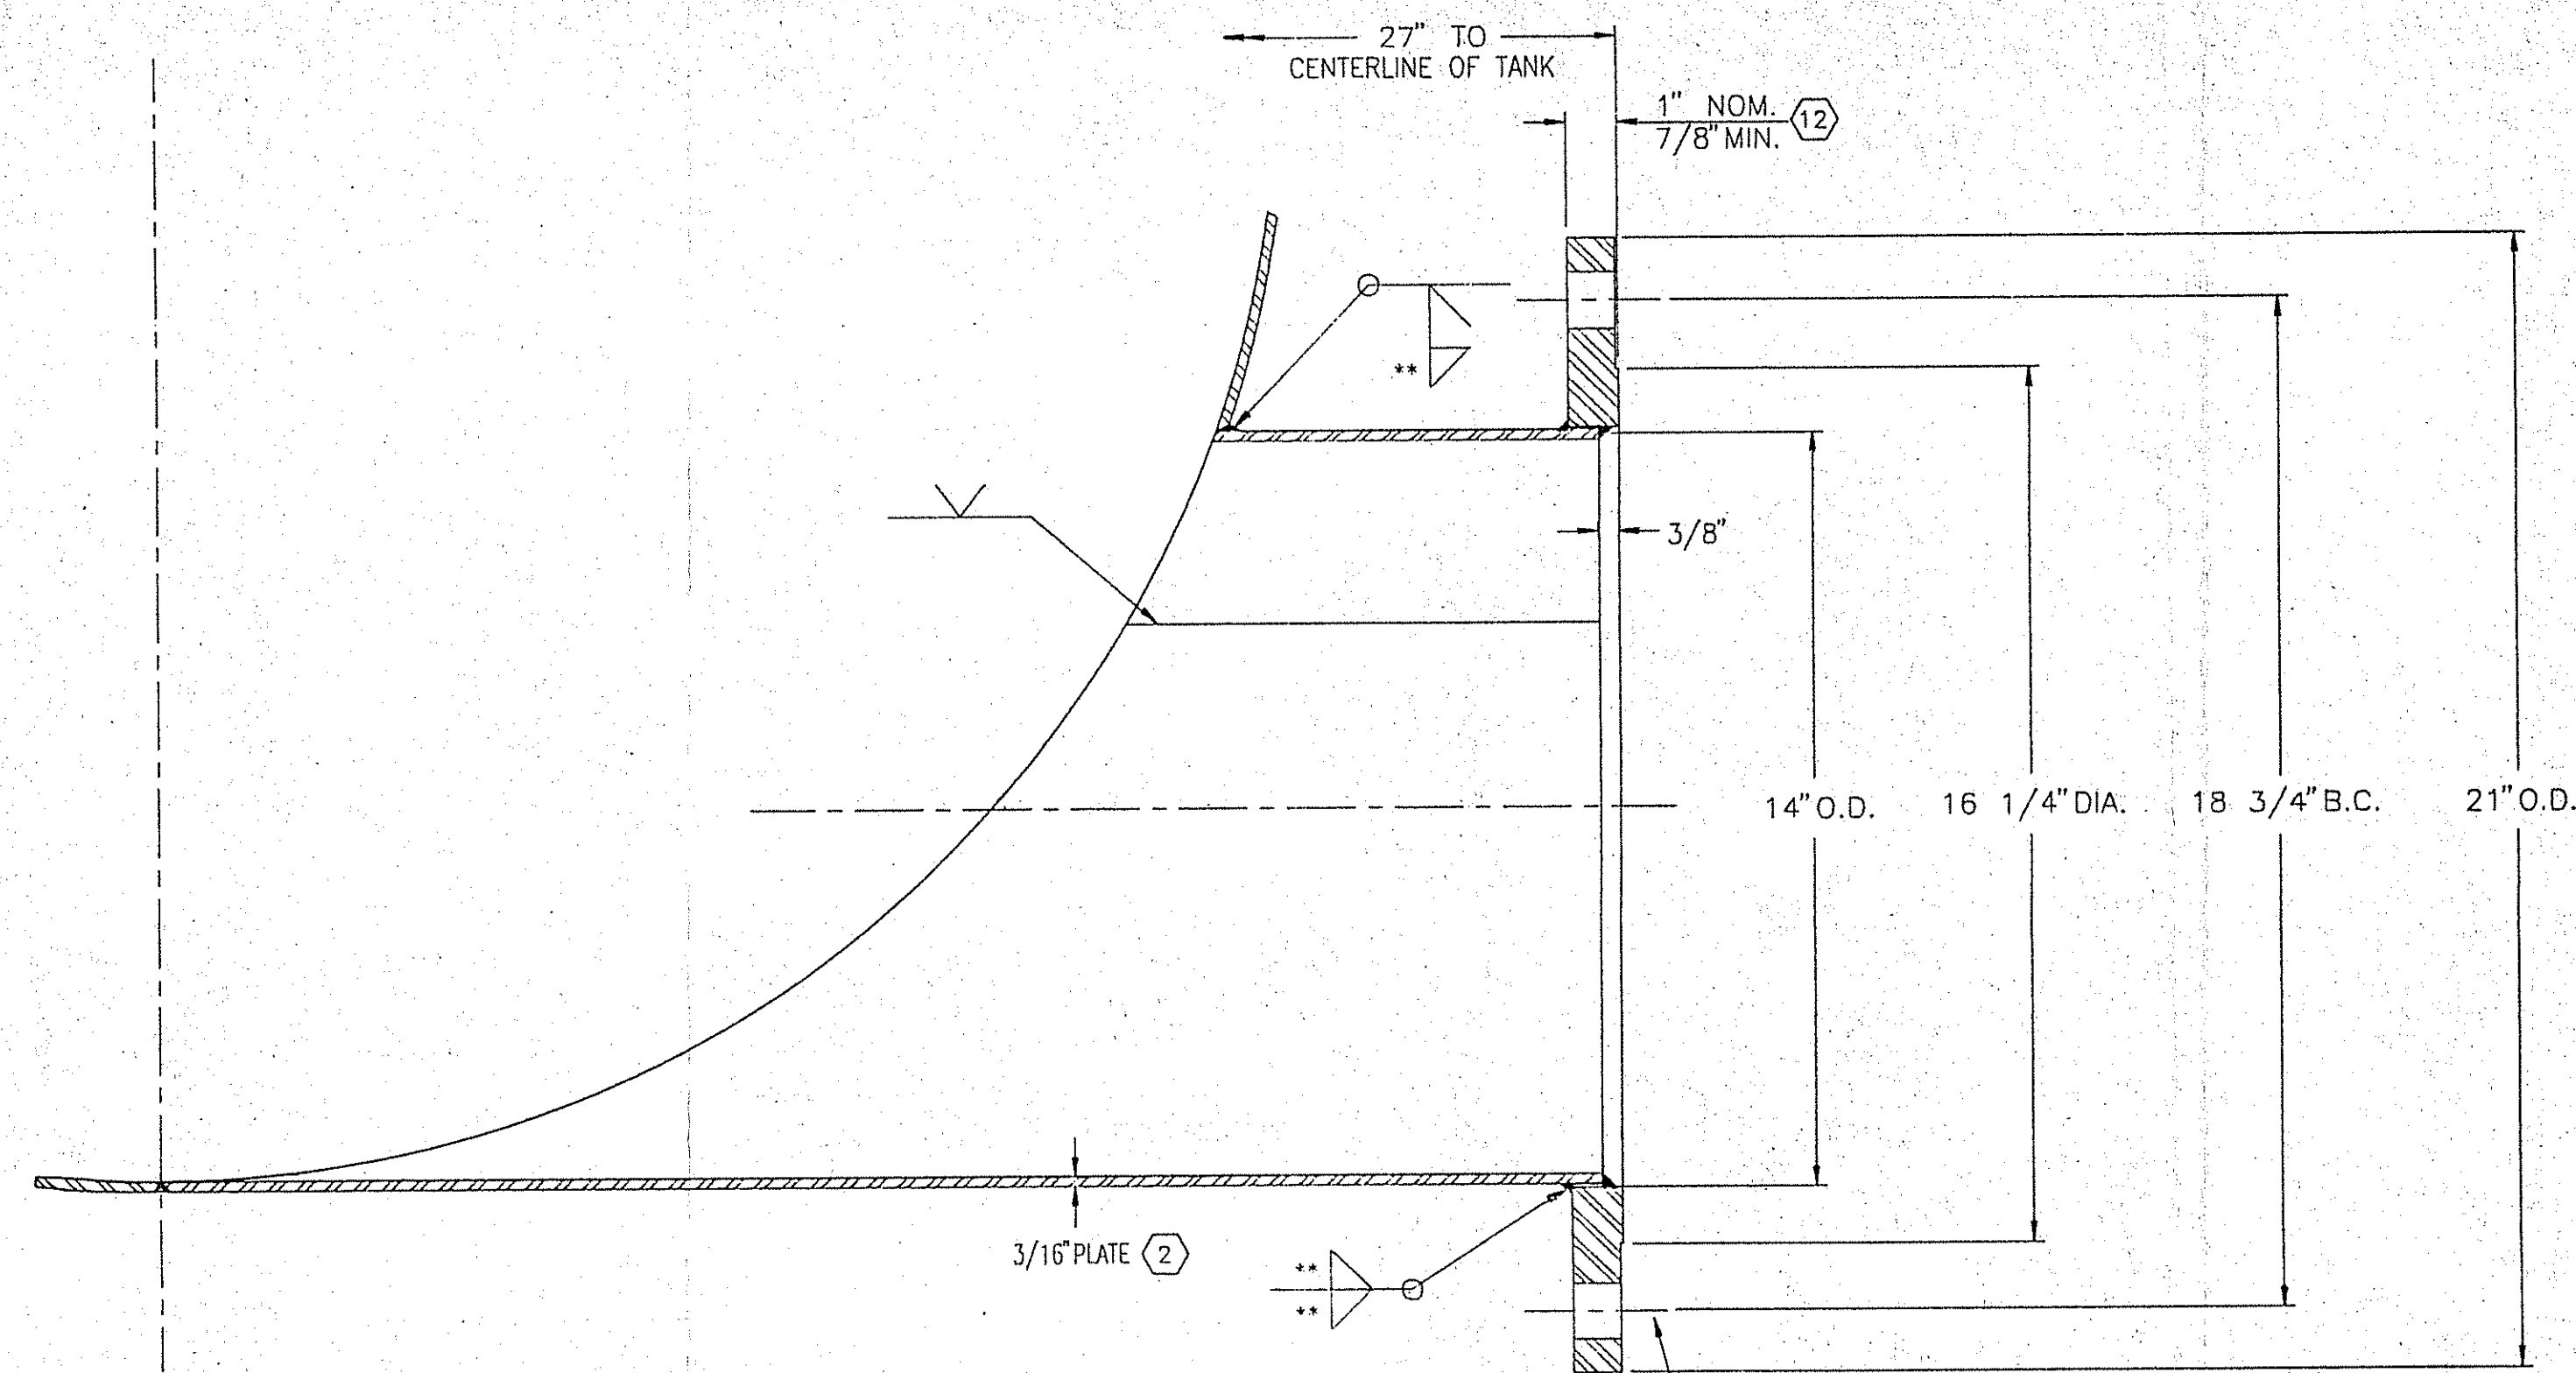


LIFTING LUG DETAIL
(3) REQ'D. @ 120" APART

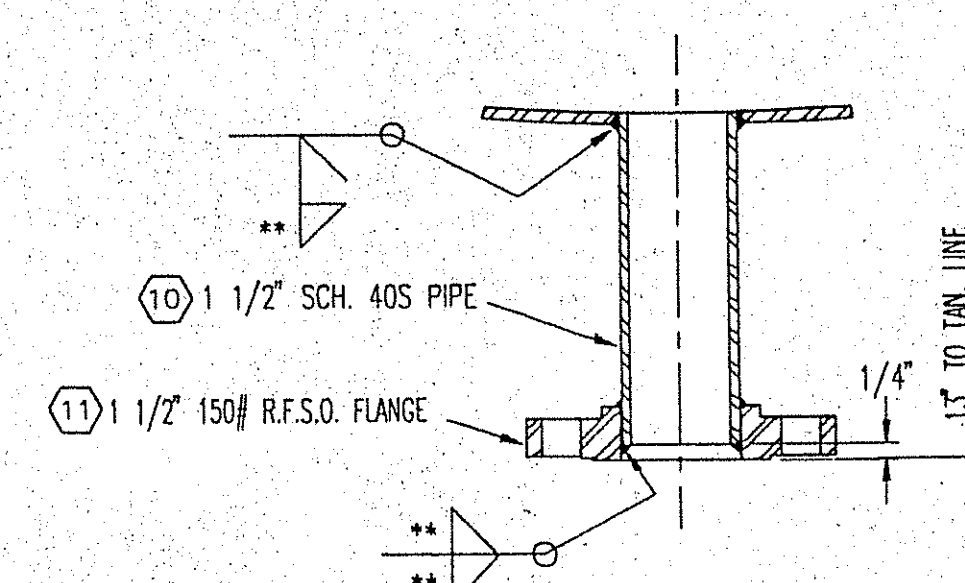


DETAIL NOZ. N4

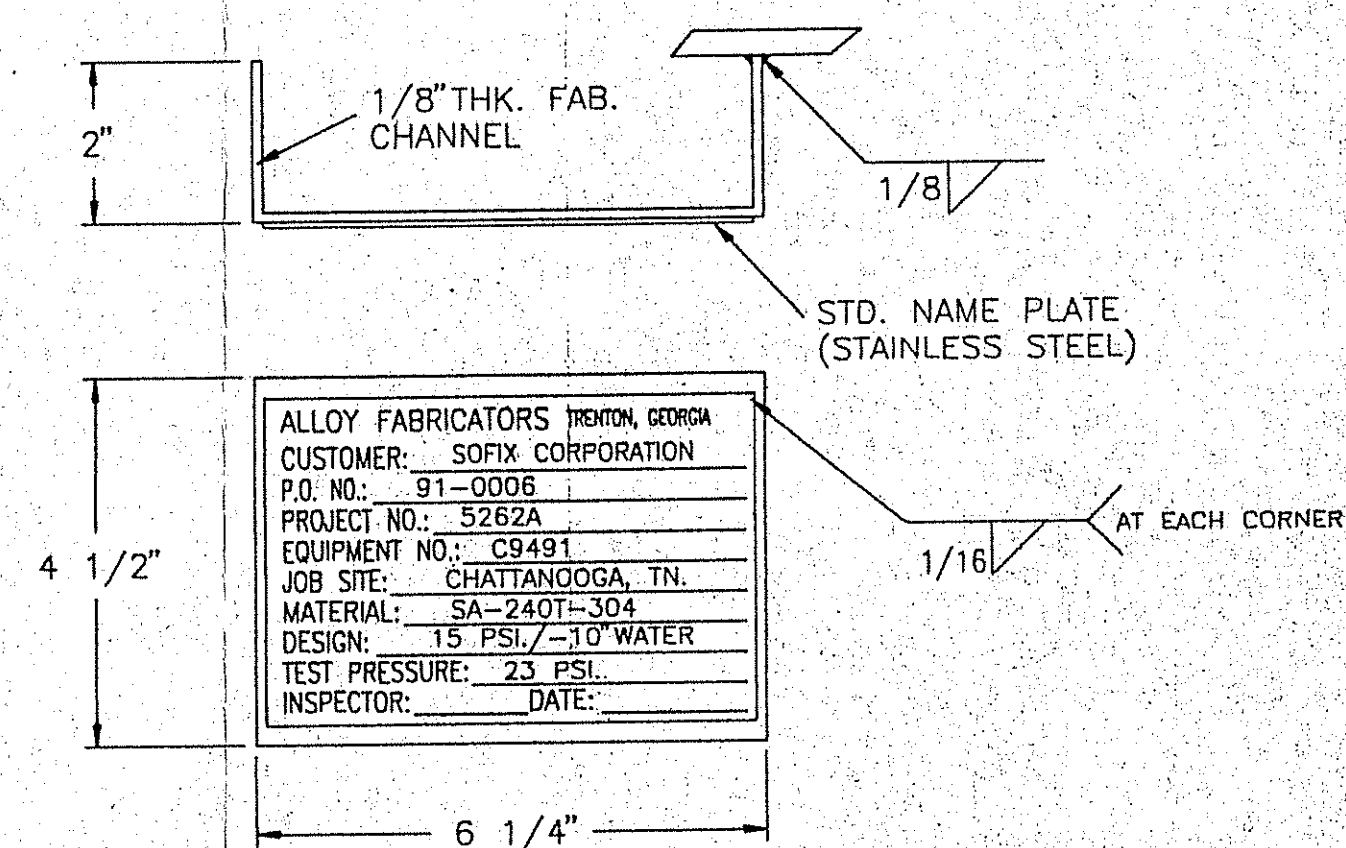

NAME PLATE DETAIL

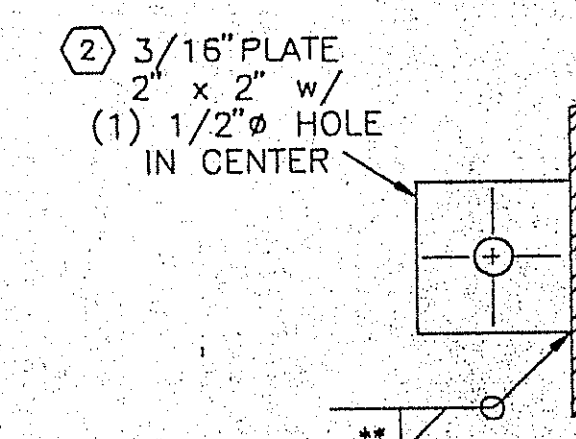

GROUNDING LUG DETAIL
(1) REQUIRED

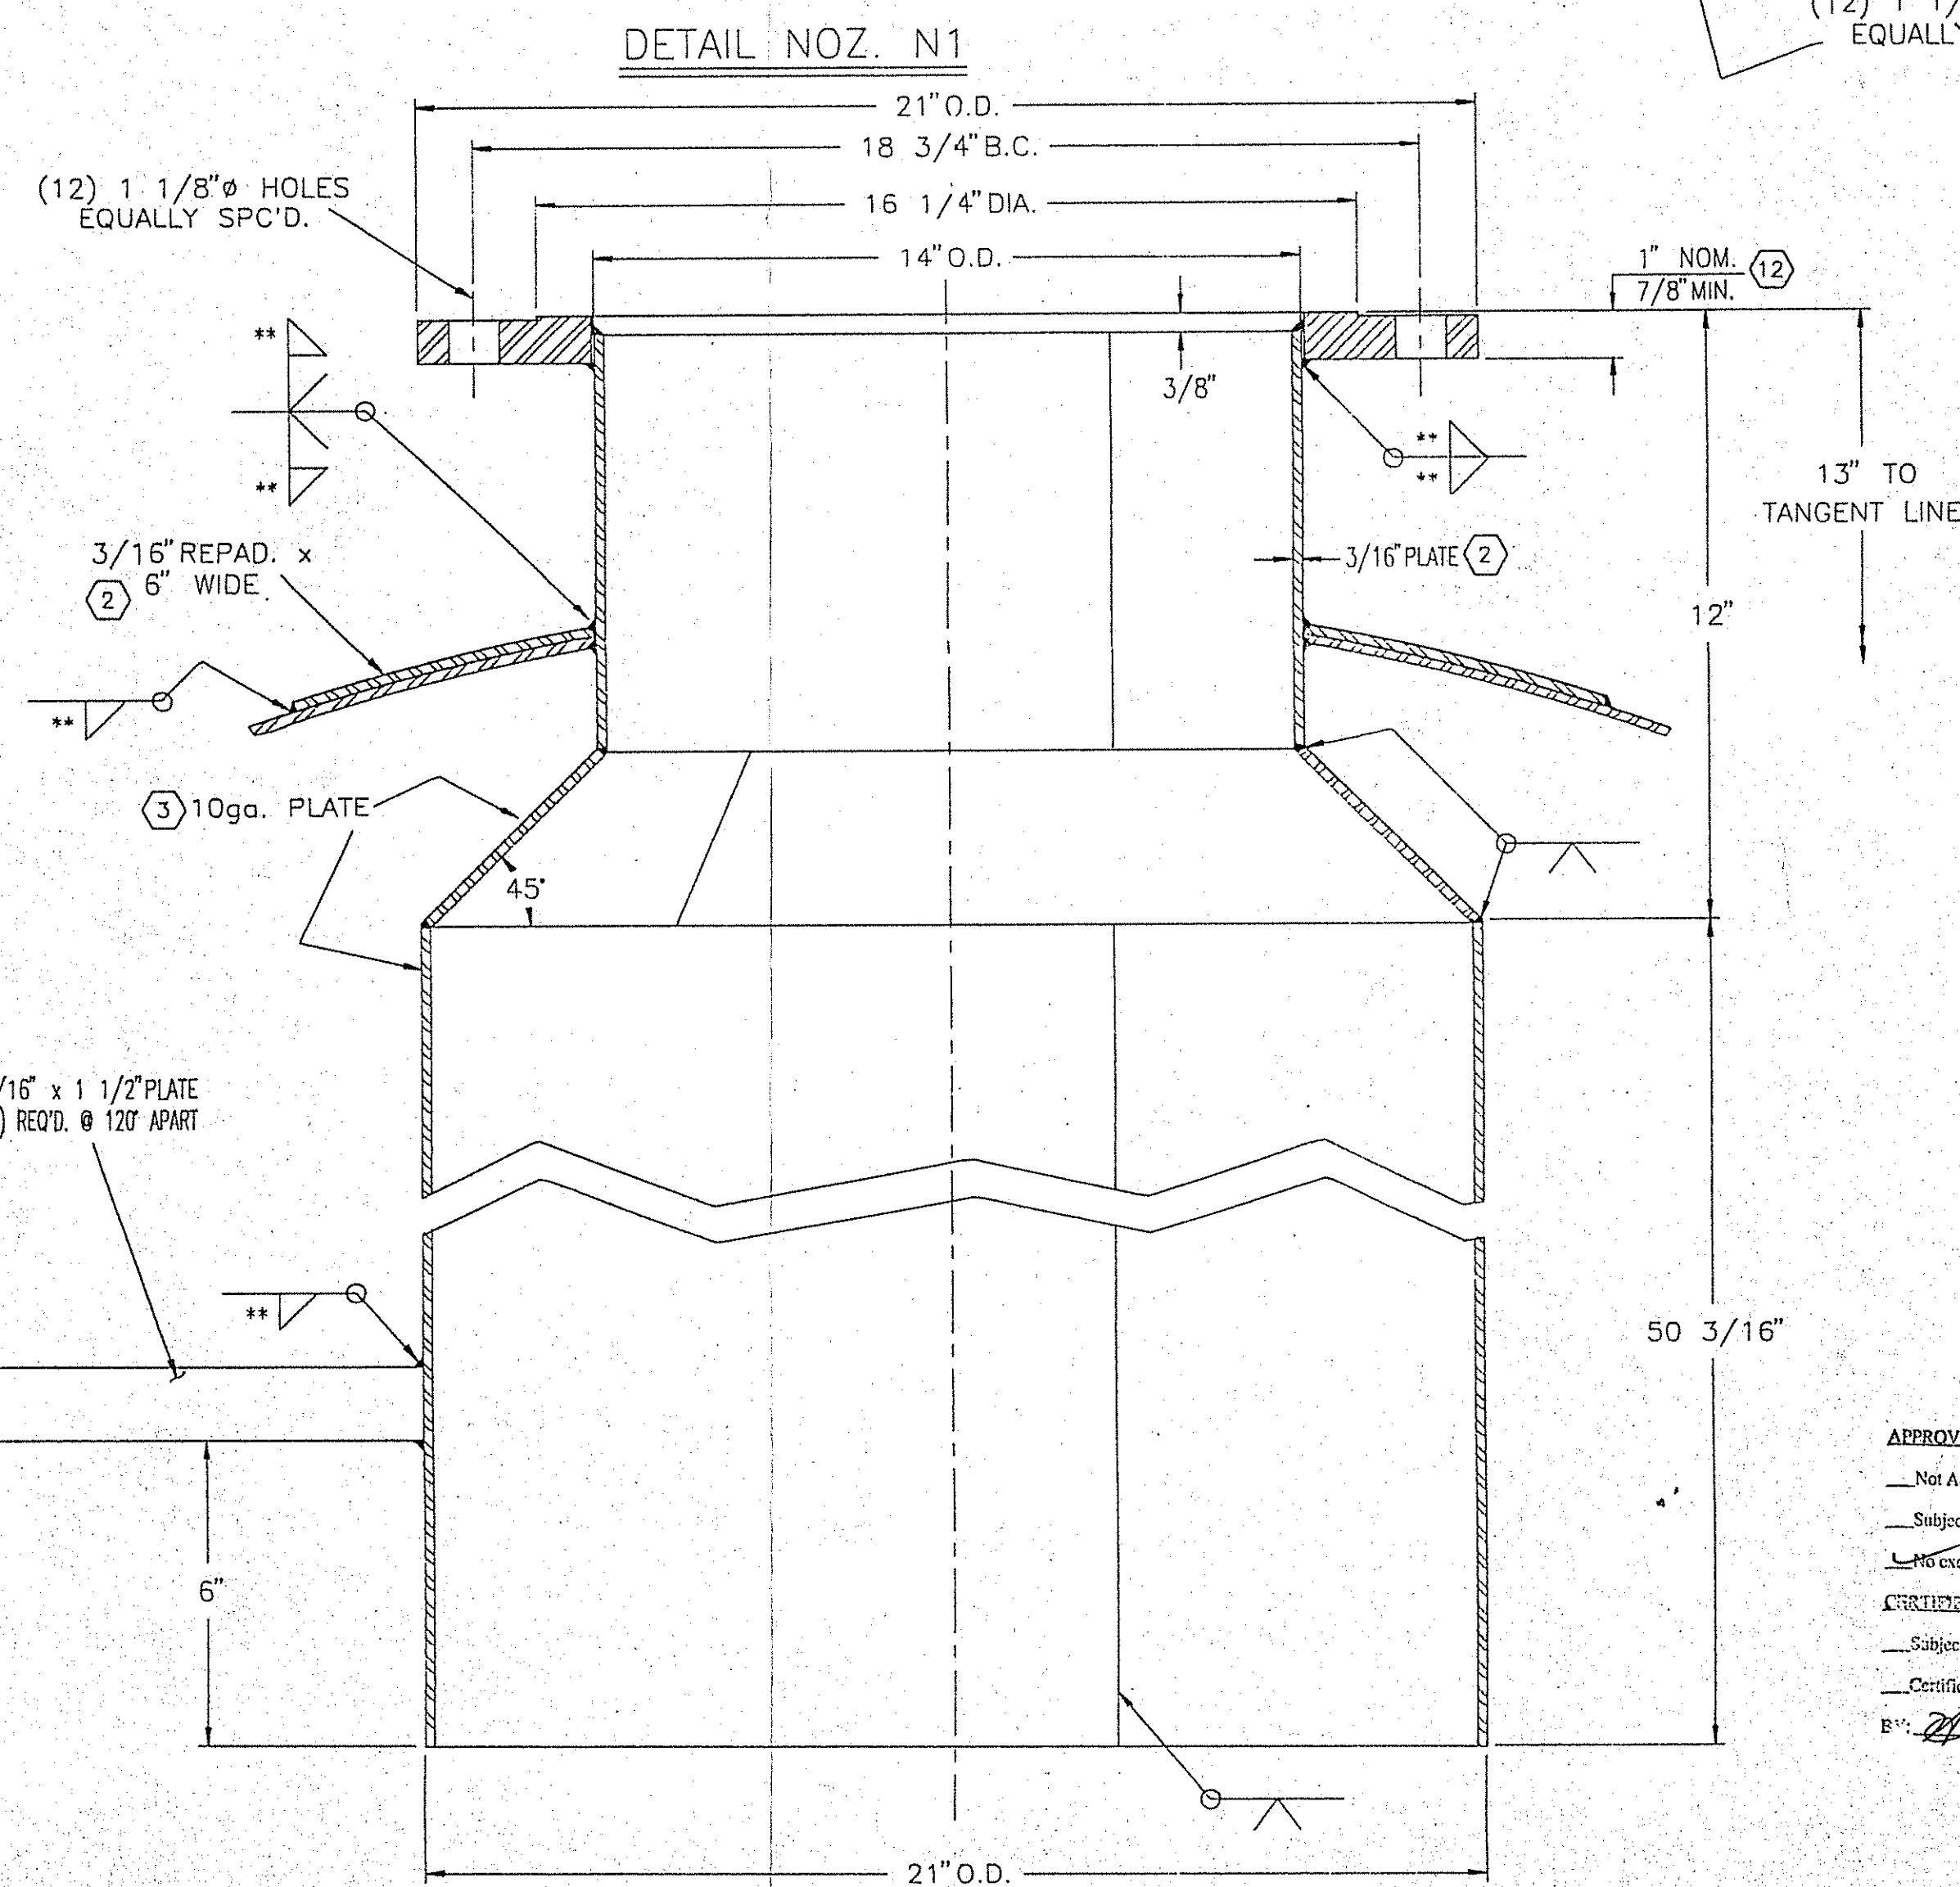


DETAIL NOZ. N3

SOFIX CORPORATION
Chattanooga, TN 37406

APPROVAL DRAWINGS
Not Acceptable. Not released for production. Revise and resubmit.
Subject to revision as indicated. Released for production, submit Certified drawings.
No exception taken. Released for production, submit certified drawing.

CERTIFIED DRAWINGS
Subject to revision as indicated. Released for production. Resubmit Certified drawings.
Certified drawings accepted. Released for production, submit AS BUILT drawing.

By: *[Signature]* Date: 11/12/91

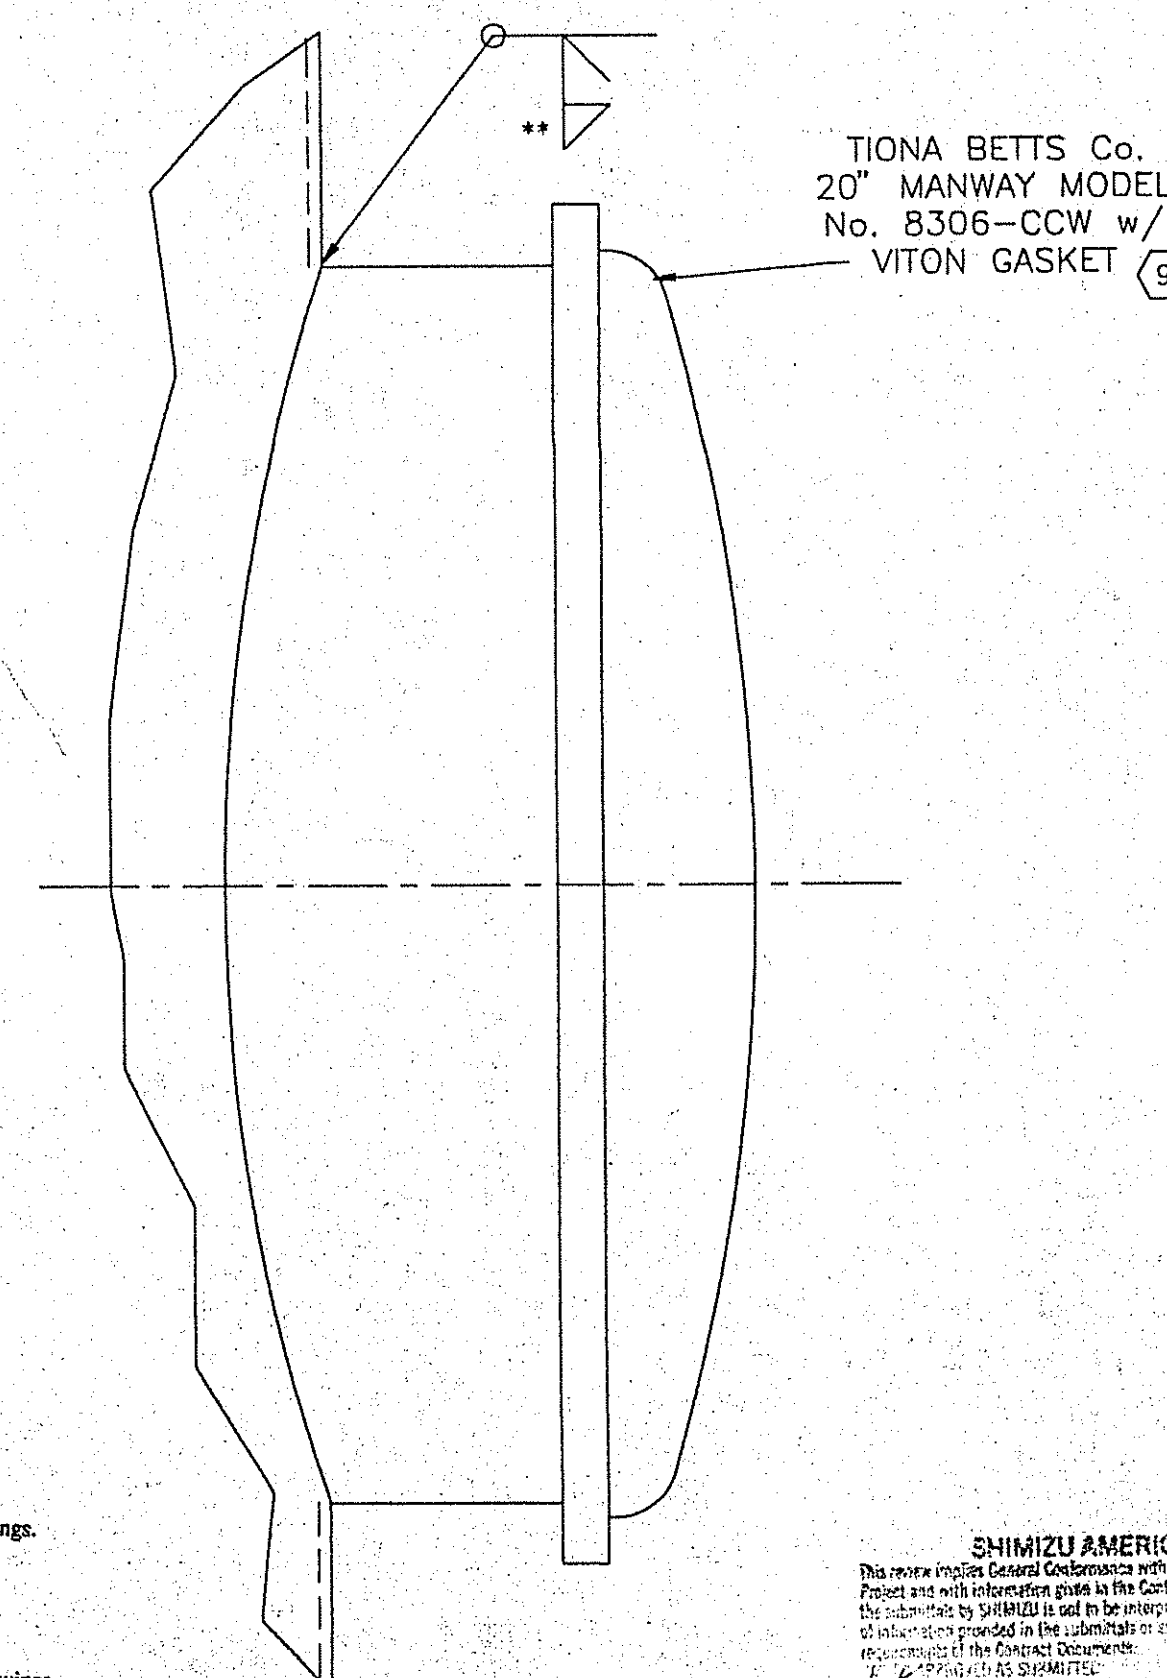

DETAIL NOZ. M1

SIMONS-EASTERN CONSULTANTS, INC.

1-159-B P. 5262A 001 OF 001

SHIMIZU AMERICA CORP.
SOFIX CORPORATION

RECEIVED 2/21/91 COPIES 4
P.O. 91-00006 FILE # 119
EQUIP. # C9491

REVIEWED
FOR GENERAL COMPLIANCE WITH THE DESIGN CONCEPT OF THE PROJECT AND CONTRACT DOCUMENTS.
NO RESPONSIBILITY IS ASSUMED FOR CORRECTNESS OF THE DRAWING OR DETAILS.
BY: *[Signature]* DATE: 12/31/91
☐ NOT ACCEPTABLE - NOT RELEASED FOR PRODUCTION REVISION AND RESUBMIT.
☐ SUBJECT TO REVISION AS INDICATED. RELEASED FOR PRODUCTION SUBMIT CERTIFIED DRAWINGS.
☒ NO EXCEPTION TAKEN - RELEASED FOR PRODUCTION - SUBMIT CERTIFIED DRAWING.
☐ CERTIFIED DRAWING ACCEPTED - RELEASED FOR PRODUCTION.
☐ NOT REQUIRED BY SIMONS FOR ENGINEERING DESIGN.

RECEIVED
NOV 12 1991
H. L. WILLIAMS

** FILLET SIZE EQUAL TO SMALLER OF PIPE WALL OR SHELL THICKNESS

RELEASED FOR FABRICATION
[Signature] DATE 10-22-91
PROJECT ENGINEER

RETURN TO VENDOR

DATE	RECD	DATA	P.O. NO.	91-0006
CHK'D	BY	DATE	EQUIP. No.	C9491
REV.	SY.	DATE	PROJ. No.	5262A
APP.	PER.	CUST.	DRAWN BY:	KEVIN W. MULLINS
REV.	PER.	CUST.	CHECKED BY:	
REV.	PER.	CUST.	ISSUE TO SHOP	
REV.	PER.	CUST.	DESCRIPTION	ALLOY FABRICATORS, INC.
REV.	PER.	CUST.	DESCRIPTION	TRENTON, GA.
REV.	PER.	CUST.	DESCRIPTION	CUSTOMER
REV.	PER.	CUST.	DESCRIPTION	SOFIX CORPORATION
REV.	PER.	CUST.	DESCRIPTION	DWG. TITLE
REV.	PER.	CUST.	DESCRIPTION	CYCLONE
REV.	PER.	CUST.	DESCRIPTION	DATE: 8-23-91
REV.	PER.	CUST.	DESCRIPTION	SCALE: NONE
REV.	PER.	CUST.	DESCRIPTION	DRAWING NO. 2 of 2
REV.	PER.	CUST.	DESCRIPTION	1-159-B
REV.	PER.	CUST.	DESCRIPTION	ISSUE 1