
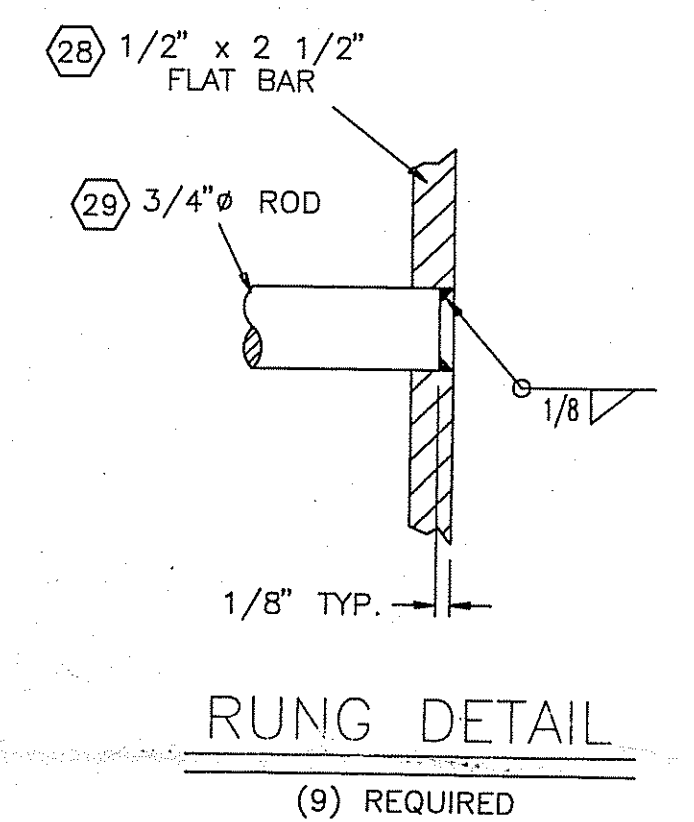
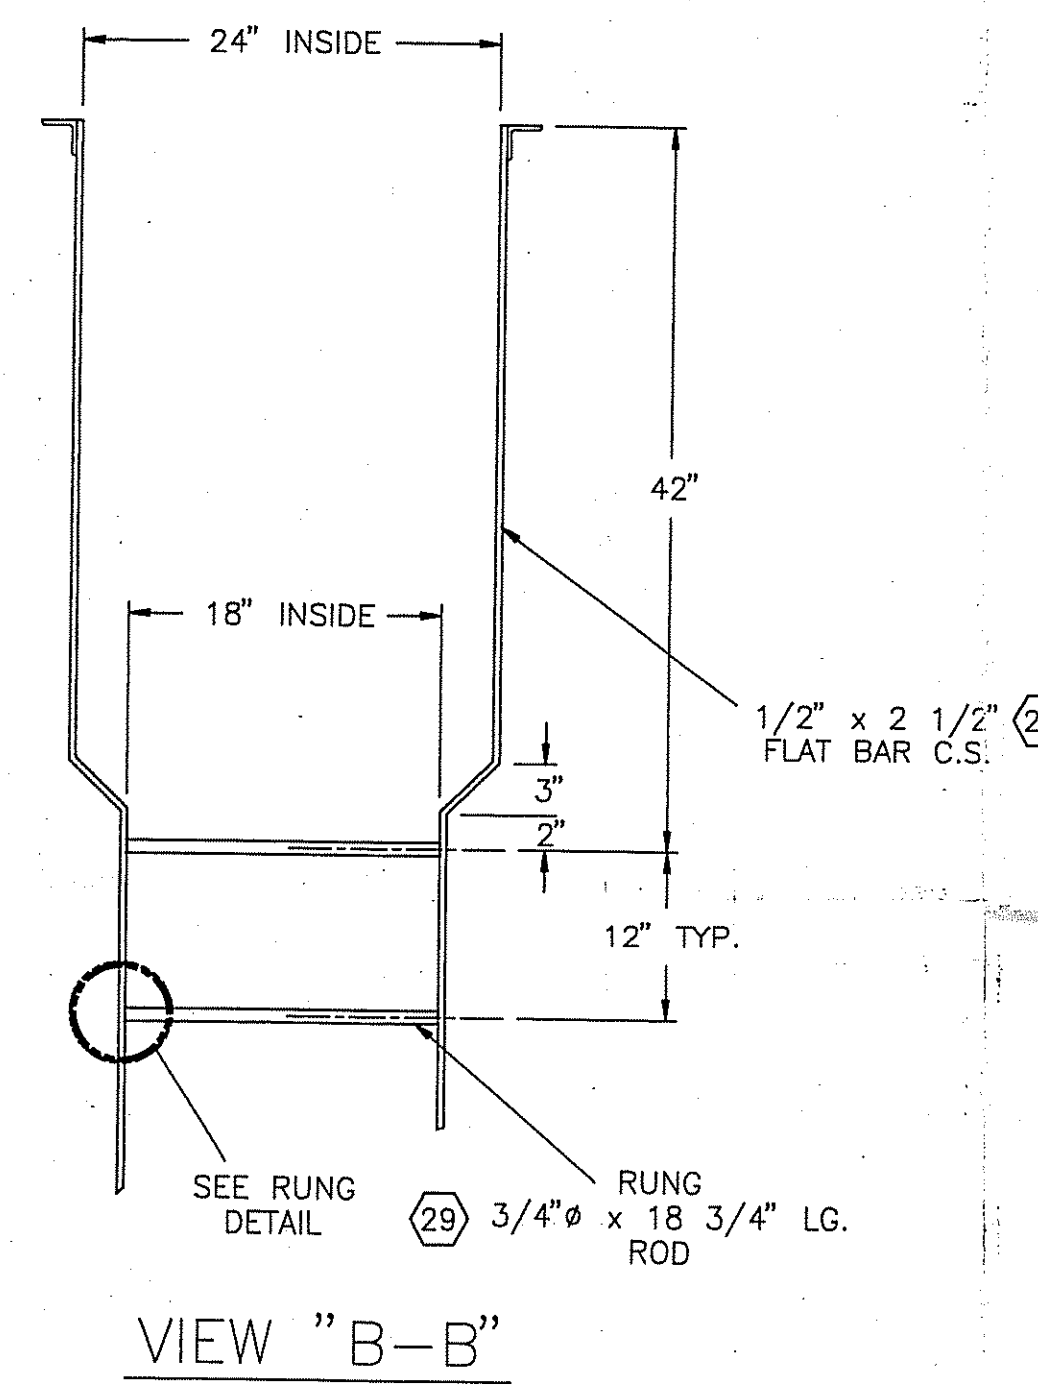
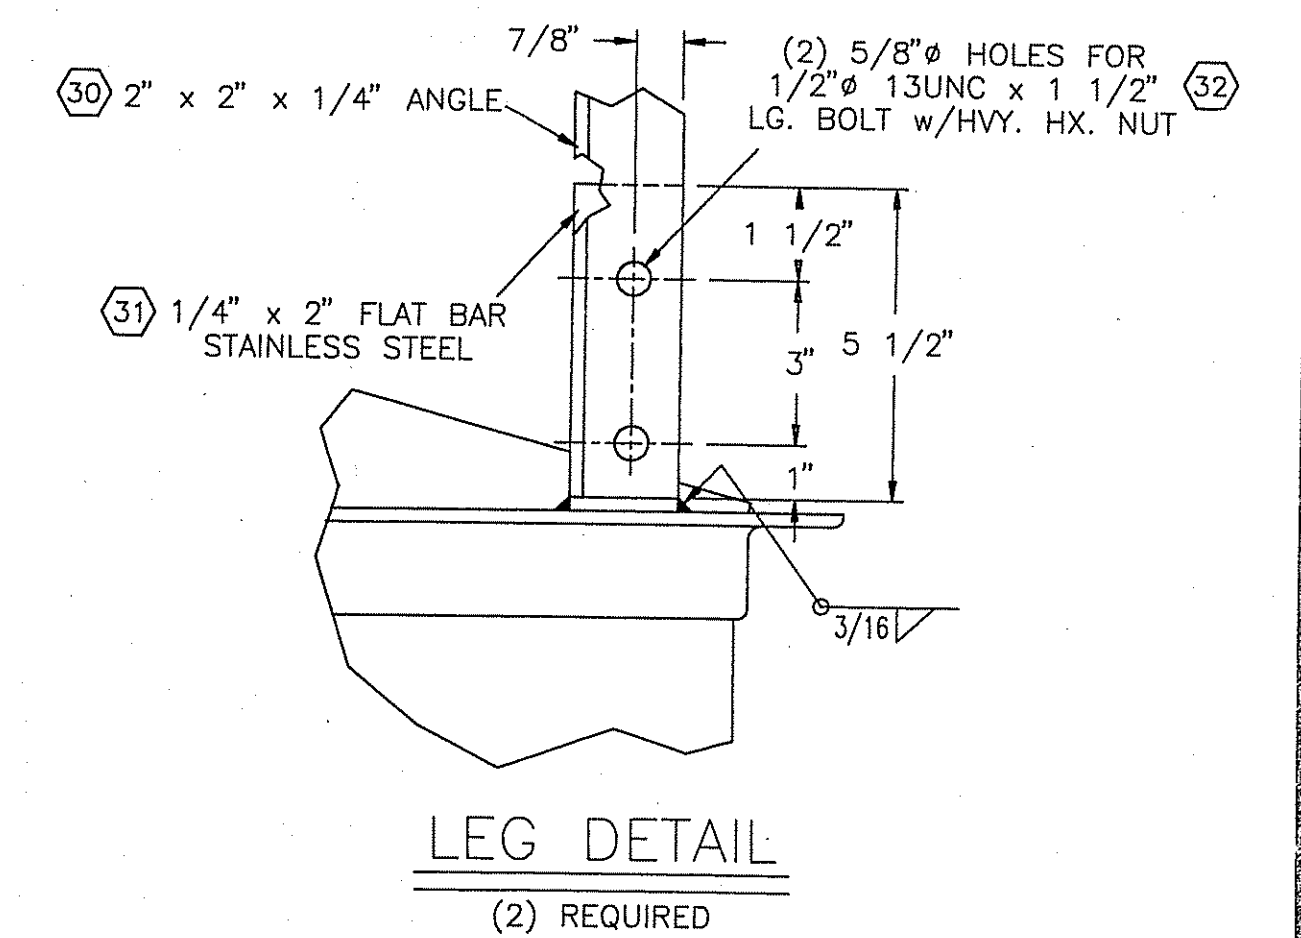
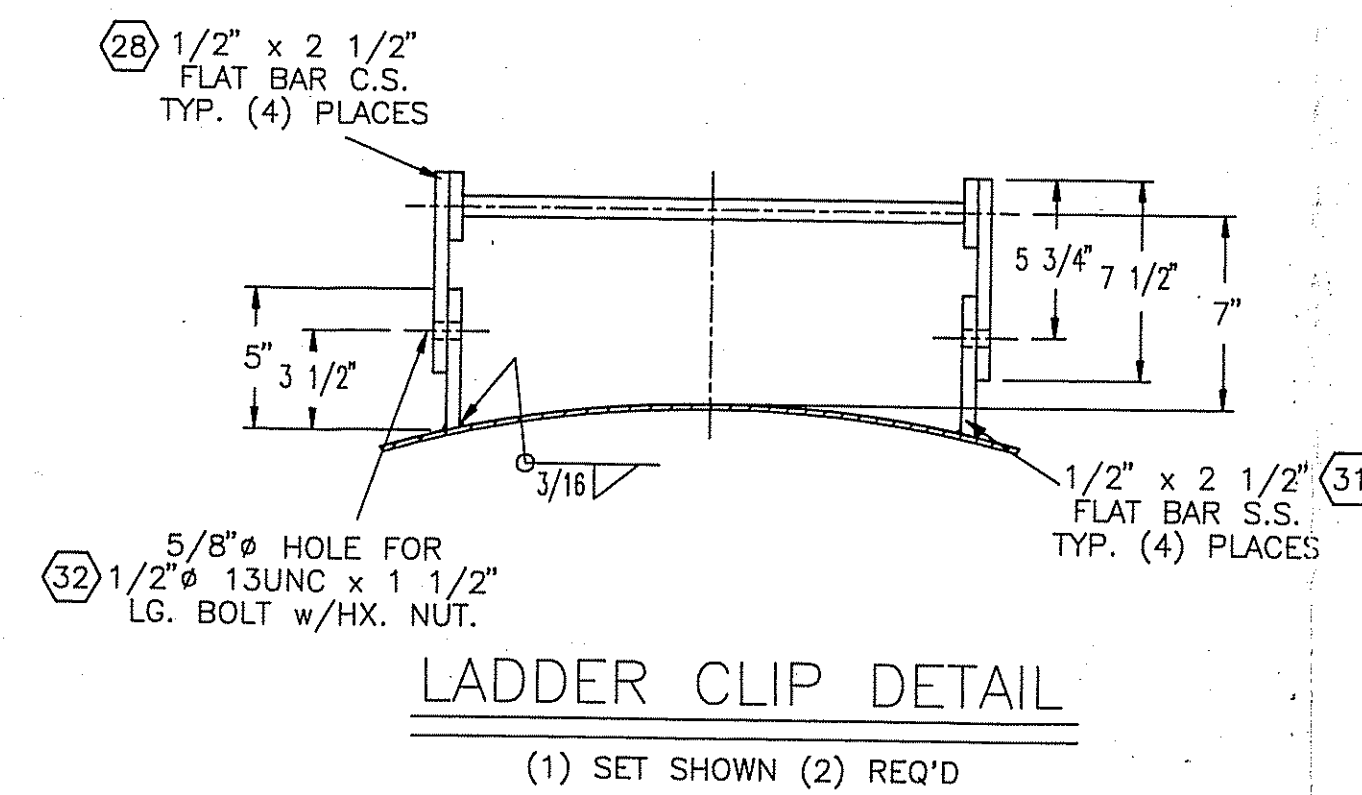
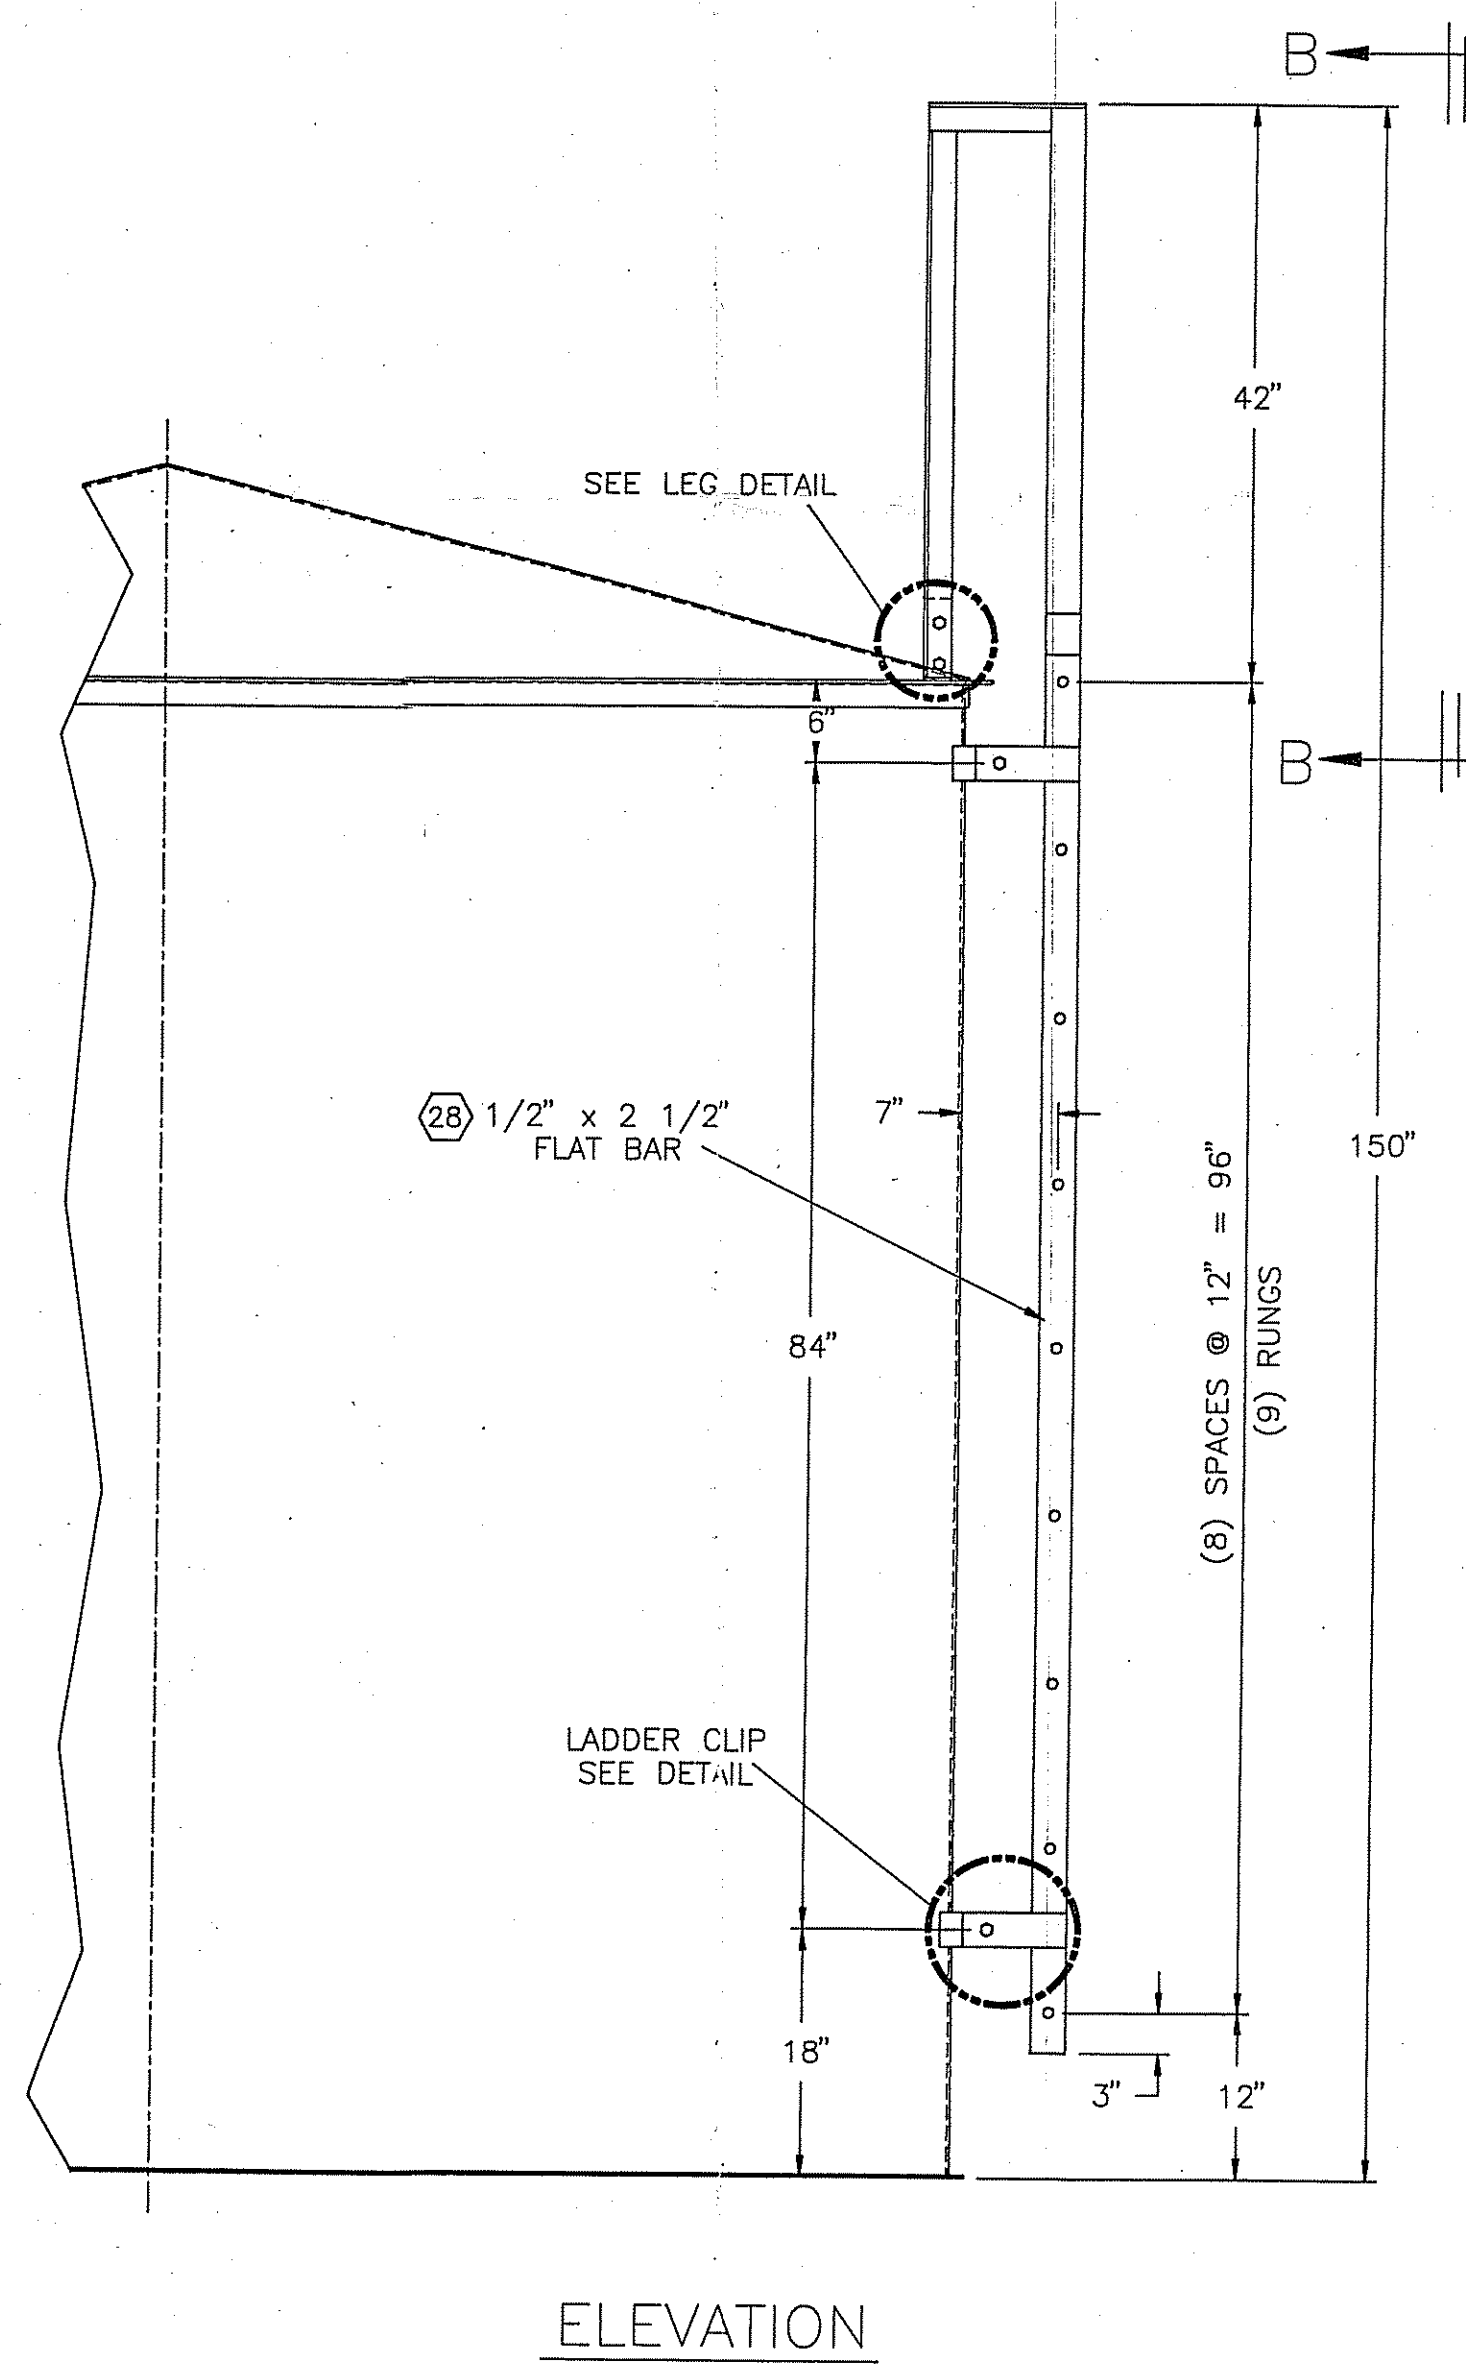


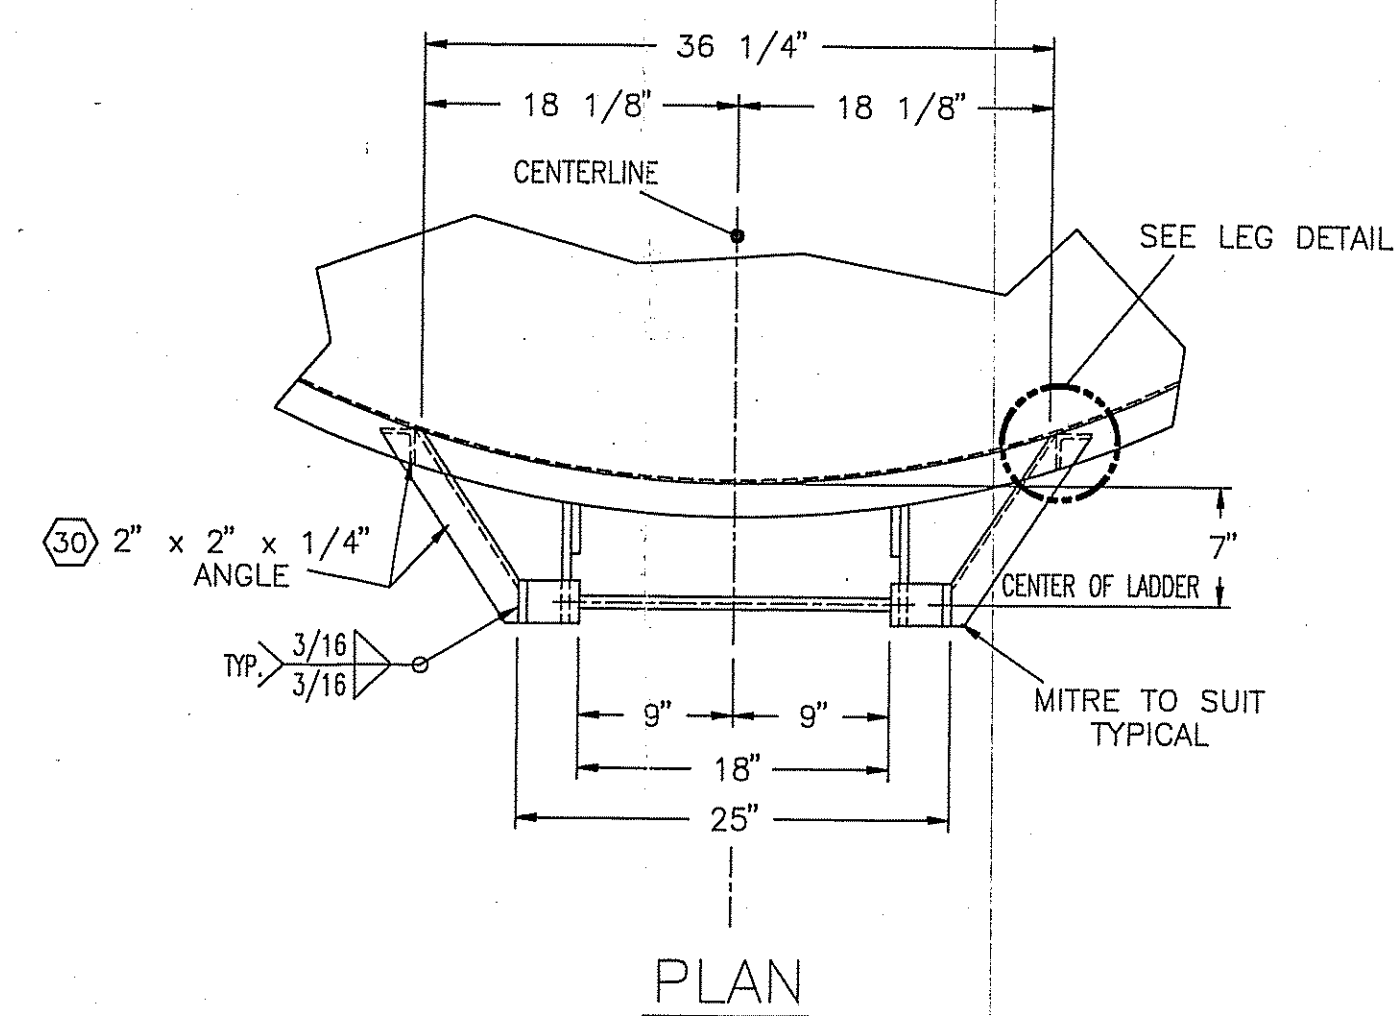

RECEIVED
JUN 25 1991
H. I. WILLIAMS

DATE RECD 6-07-91 CHK'D BY RM		DATE 4-08-91 BY RM		P.O. NO.: 91-00006	
		CUST. DATA		EQUIP. No.: T3213	
REV. BY T. GASS		REV. BY T. GASS		PROJ. No.: 52624	
DRAWN BY: TIM GASS		CHECKED BY: KEVIN MULLINS		DRAWN BY: TIM GASS	
AS BUILT		DESCRIPTION		ALLOY FABRICATORS, INC. TRENTON, GA.	
PER. CUST. APP. ORG. ISSUE TO SHOP		DESCRIPTION		CUSTOMER SOFIX CORPORATION	
		DWG. TITLE		USED TCE TANK	
DATE 2-1-91		SCALE NONE		DRAWING NO. 3 of 3 1-164-C	
REV. 1		REV. 1		ISSUE 2	

114424

DETAIL NOZ. N1

DETAIL NOZ. N4

DETAIL NOZ. N11

DETAIL NOZ. N5 & N9

DETAIL NOZ. N10 & N17

DETAIL NOZ. N3

DETAIL NOZ. N7

DETAIL NOZ. N8

DETAIL NOZ. N6

DETAIL NOZ. N13, & N16

HOLD DOWN & GROUNDING LUG DETAIL

LIFTING LUG DETAIL

PARTITION DETAIL

TYPICAL (3) PLACES

DETAIL NOZ. M1

** FILLET SIZE EQUAL TO THINNER
OF PIPE OR SHELL THICKNESS

REV. DIM. @ NOZ. N3		REV. DIM. @ NOZ. N3		REV. DIM. @ NOZ. N3		REV. DIM. @ NOZ. N3	
ADD. (1) GROUND LUG		ADD. (1) GROUND LUG		ADD. (1) GROUND LUG		ADD. (1) GROUND LUG	
REV. PER. CUST. APP.		REV. PER. CUST. APP.		REV. PER. CUST. APP.		REV. PER. CUST. APP.	
ORG. ISSUE TO SHOP		ORG. ISSUE TO SHOP		ORG. ISSUE TO SHOP		ORG. ISSUE TO SHOP	
REV. DATE		REV. DATE		REV. DATE		REV. DATE	
2-1-91		2-1-91		2-1-91		2-1-91	
SCALE		SCALE		SCALE		SCALE	
NONE		NONE		NONE		NONE	
DRAWING NO. 2 of 3		DRAWING NO. 2 of 3		DRAWING NO. 2 of 3		DRAWING NO. 2 of 3	
1-164-B		1-164-B		1-164-B		1-164-B	
ISSUE		ISSUE		ISSUE		ISSUE	
2		2		2		2	

114424

