


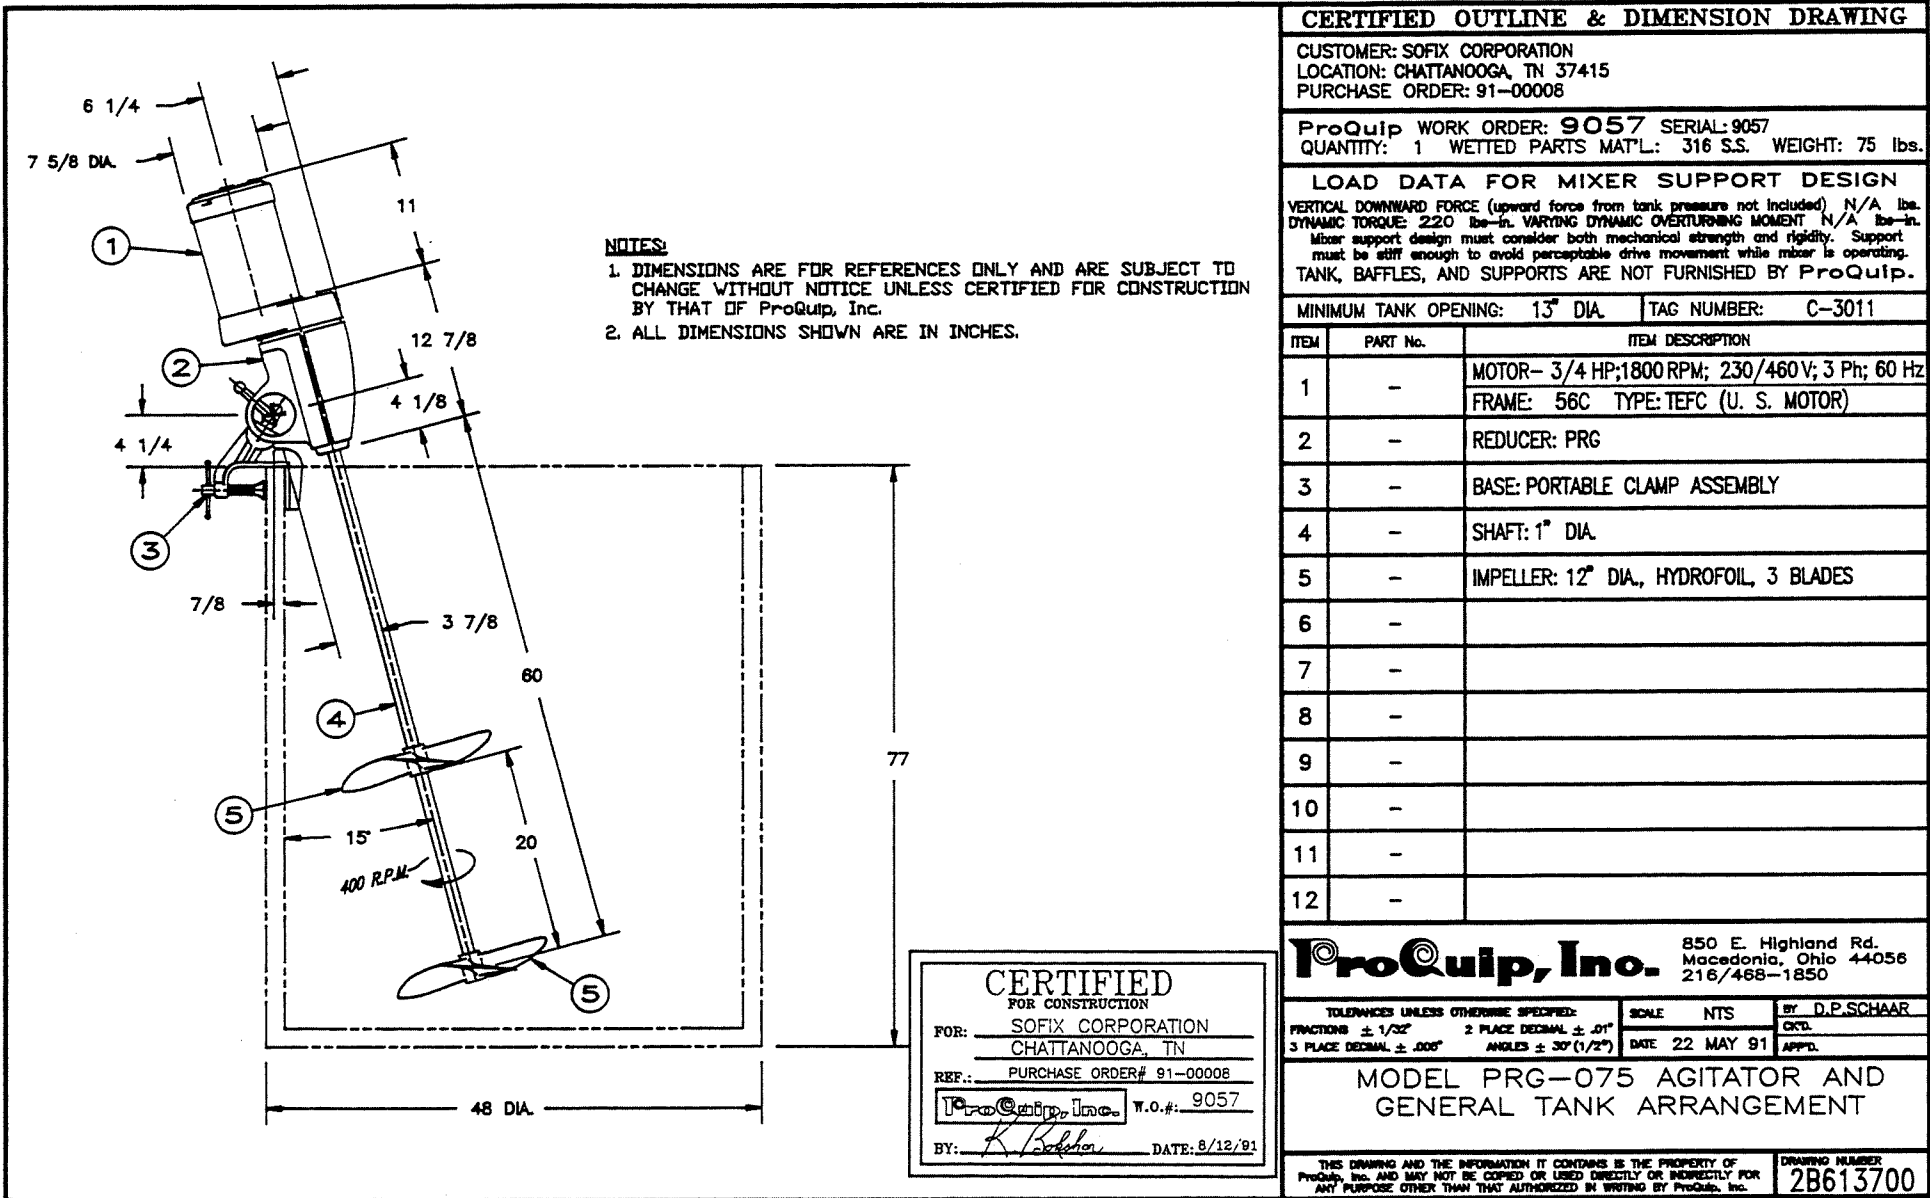
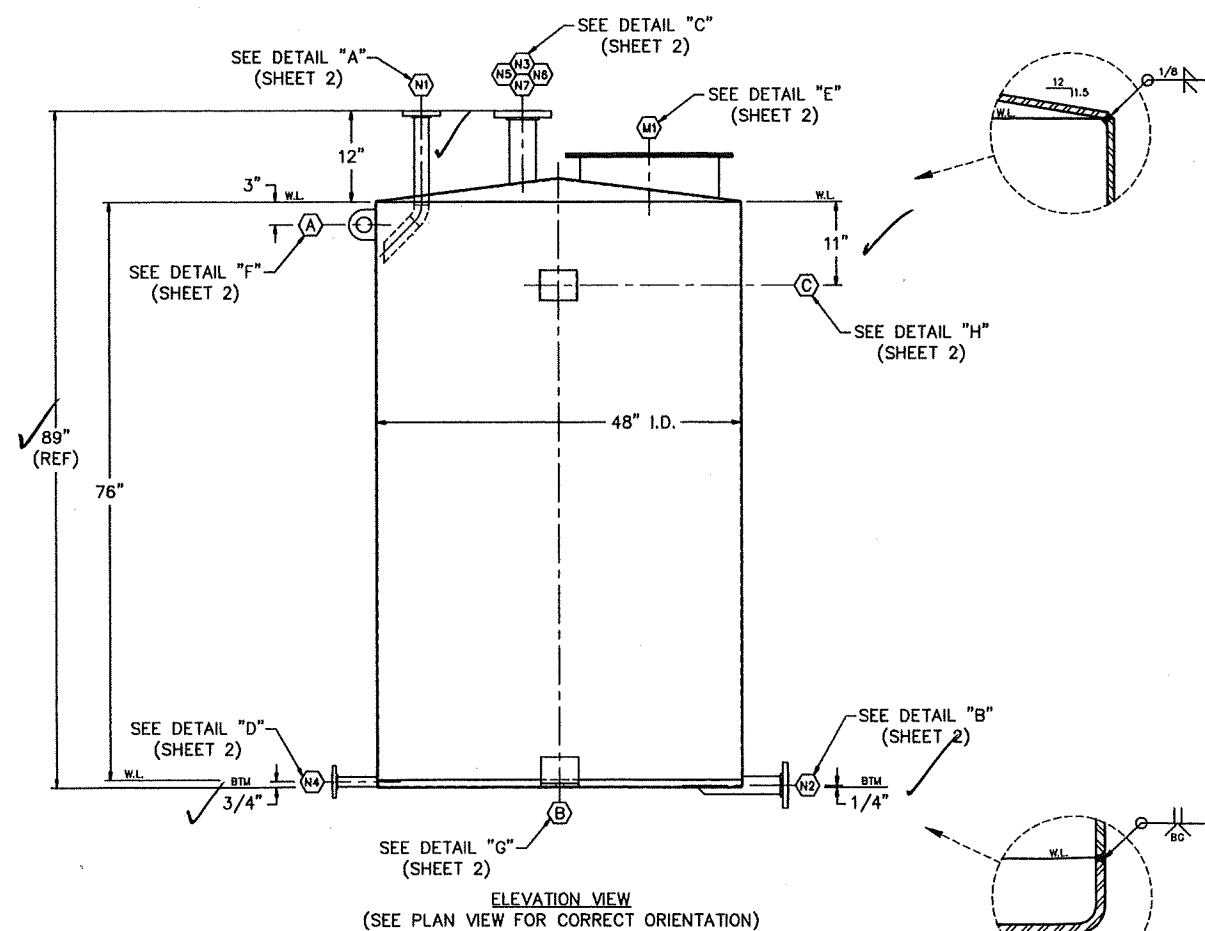
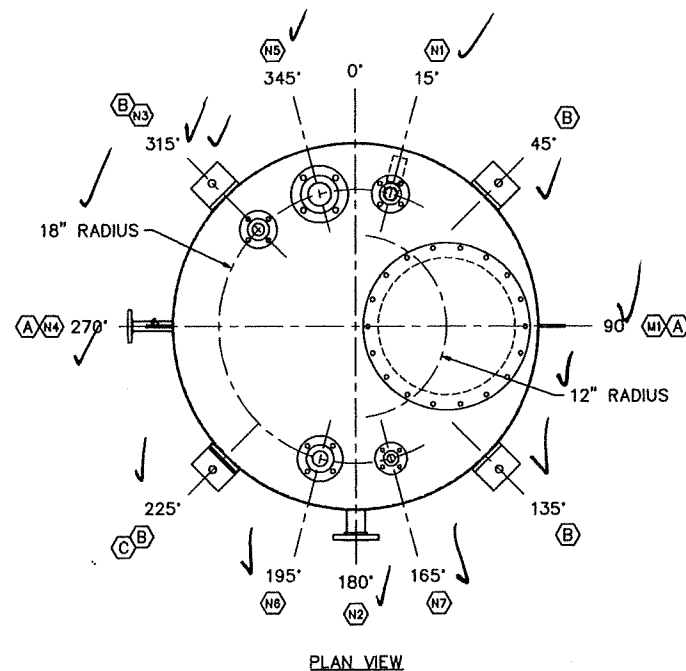
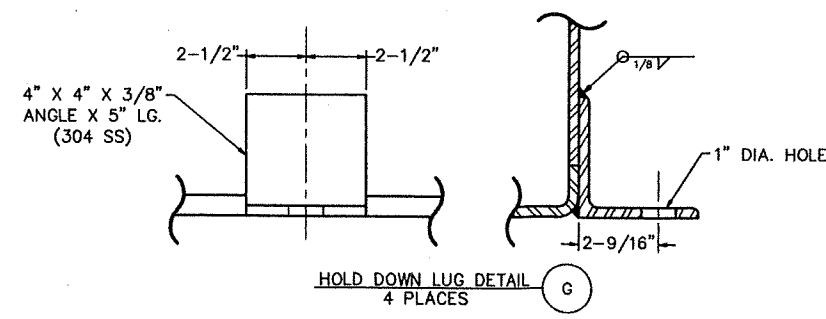
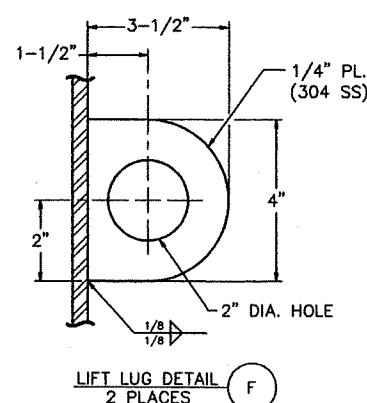
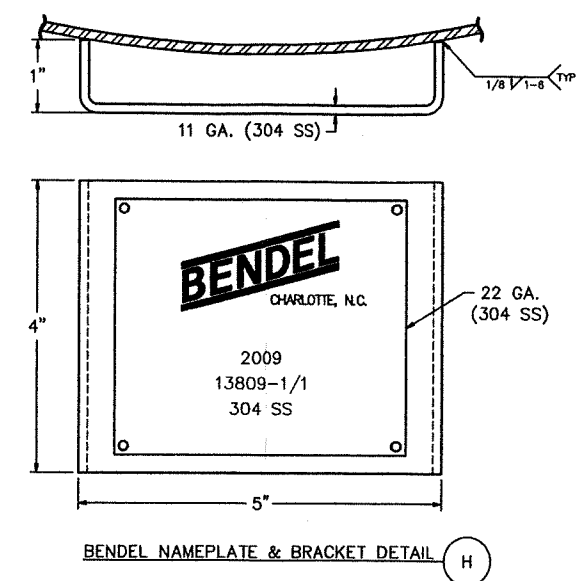
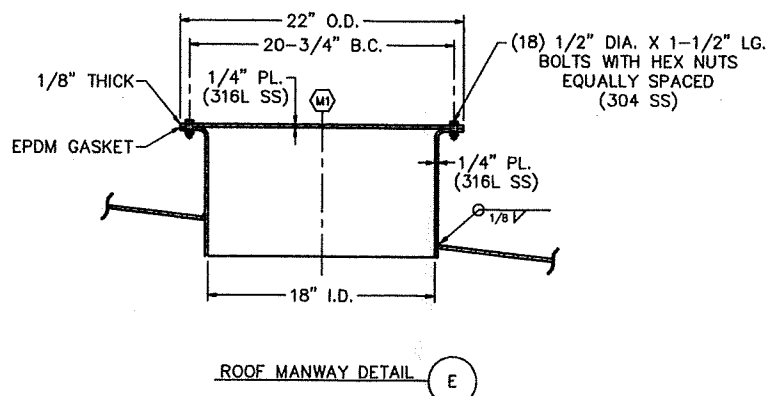
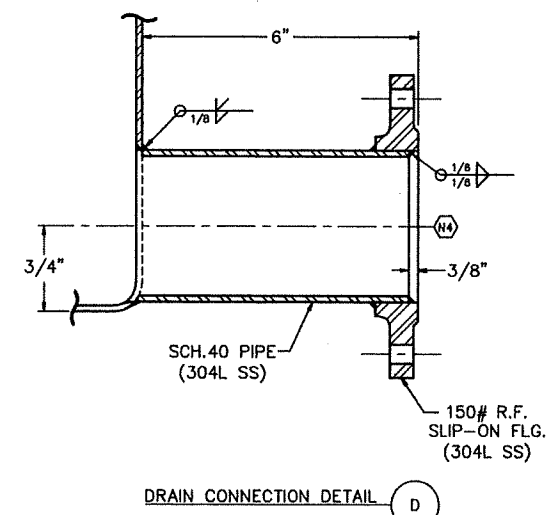


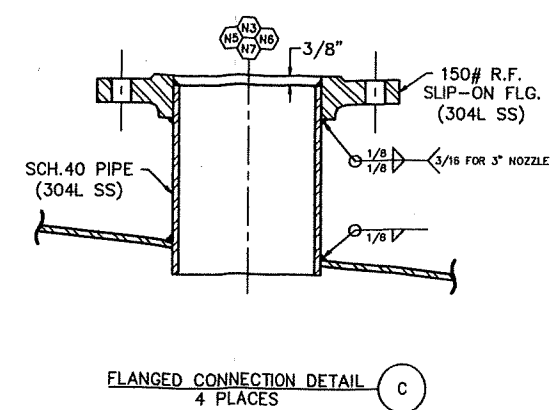

114483
AGITATOR

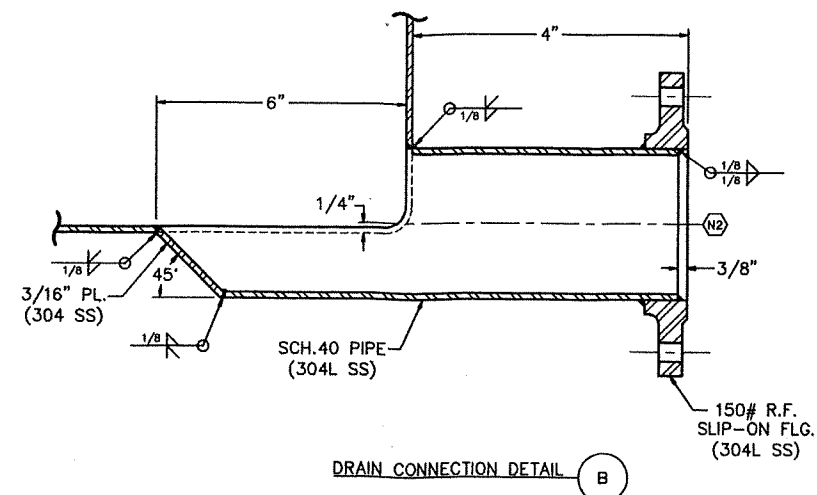

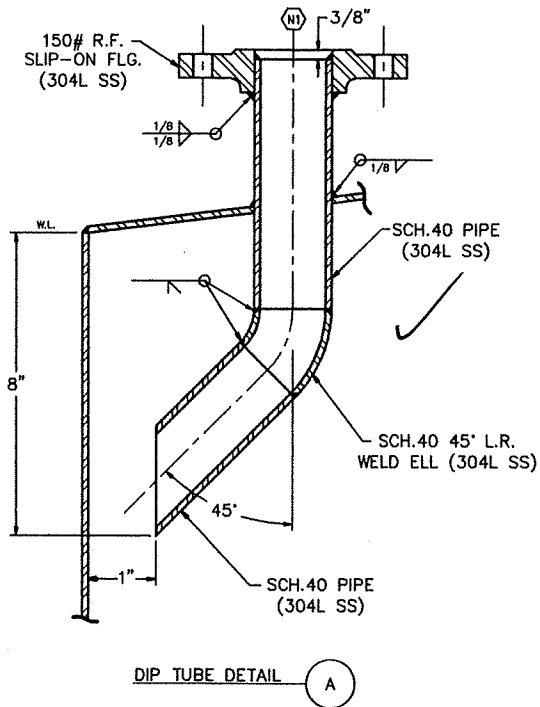

☐ DRAWING APPROVED, PROCEED WITH FABRICATION
☐ DRAWING APPROVED AS NOTED, PROCEED WITH FABRICATION
☐ REVISE AND RESUBMIT FOR FILES ONLY
☐ REVISE DRAWING AS NOTED, RESUBMIT FOR APPROVAL
 PRIOR TO PROCEEDING WITH FABRICATION
 SIGNATURE _____ DATE _____

DATE	REVISION	BY
4-30-09	FOR CUSTOMER APPROVAL	W.P.
SUBJECT		
DETAILS		
CUSTOMER		
SOFIX CORPORATION CHATTANOOGA, TN		
SCALE: NONE		
S.O. NO. 13809	JOB NO. 3755	DWG. NO. 021380909
		SH. NO. 2 OF 2

BENDEL
CHARLOTTE, N.C.

114483