



THIS DRAWING MUST NOT BE COPIED OR REPRODUCED IN ANY MANNER WITHOUT THE WRITTEN PERMISSION OF THE DESIGNER. THE DESIGNER SHALL BE RESPONSIBLE FOR THE ACCURACY OF THE INFORMATION PROVIDED. THE RECIPIENT SHALL BE RESPONSIBLE FOR THE PROTECTION OF THE INFORMATION PROVIDED. THE RECIPIENT SHALL NOT BE RESPONSIBLE FOR THE PROTECTION OF THE INFORMATION PROVIDED.

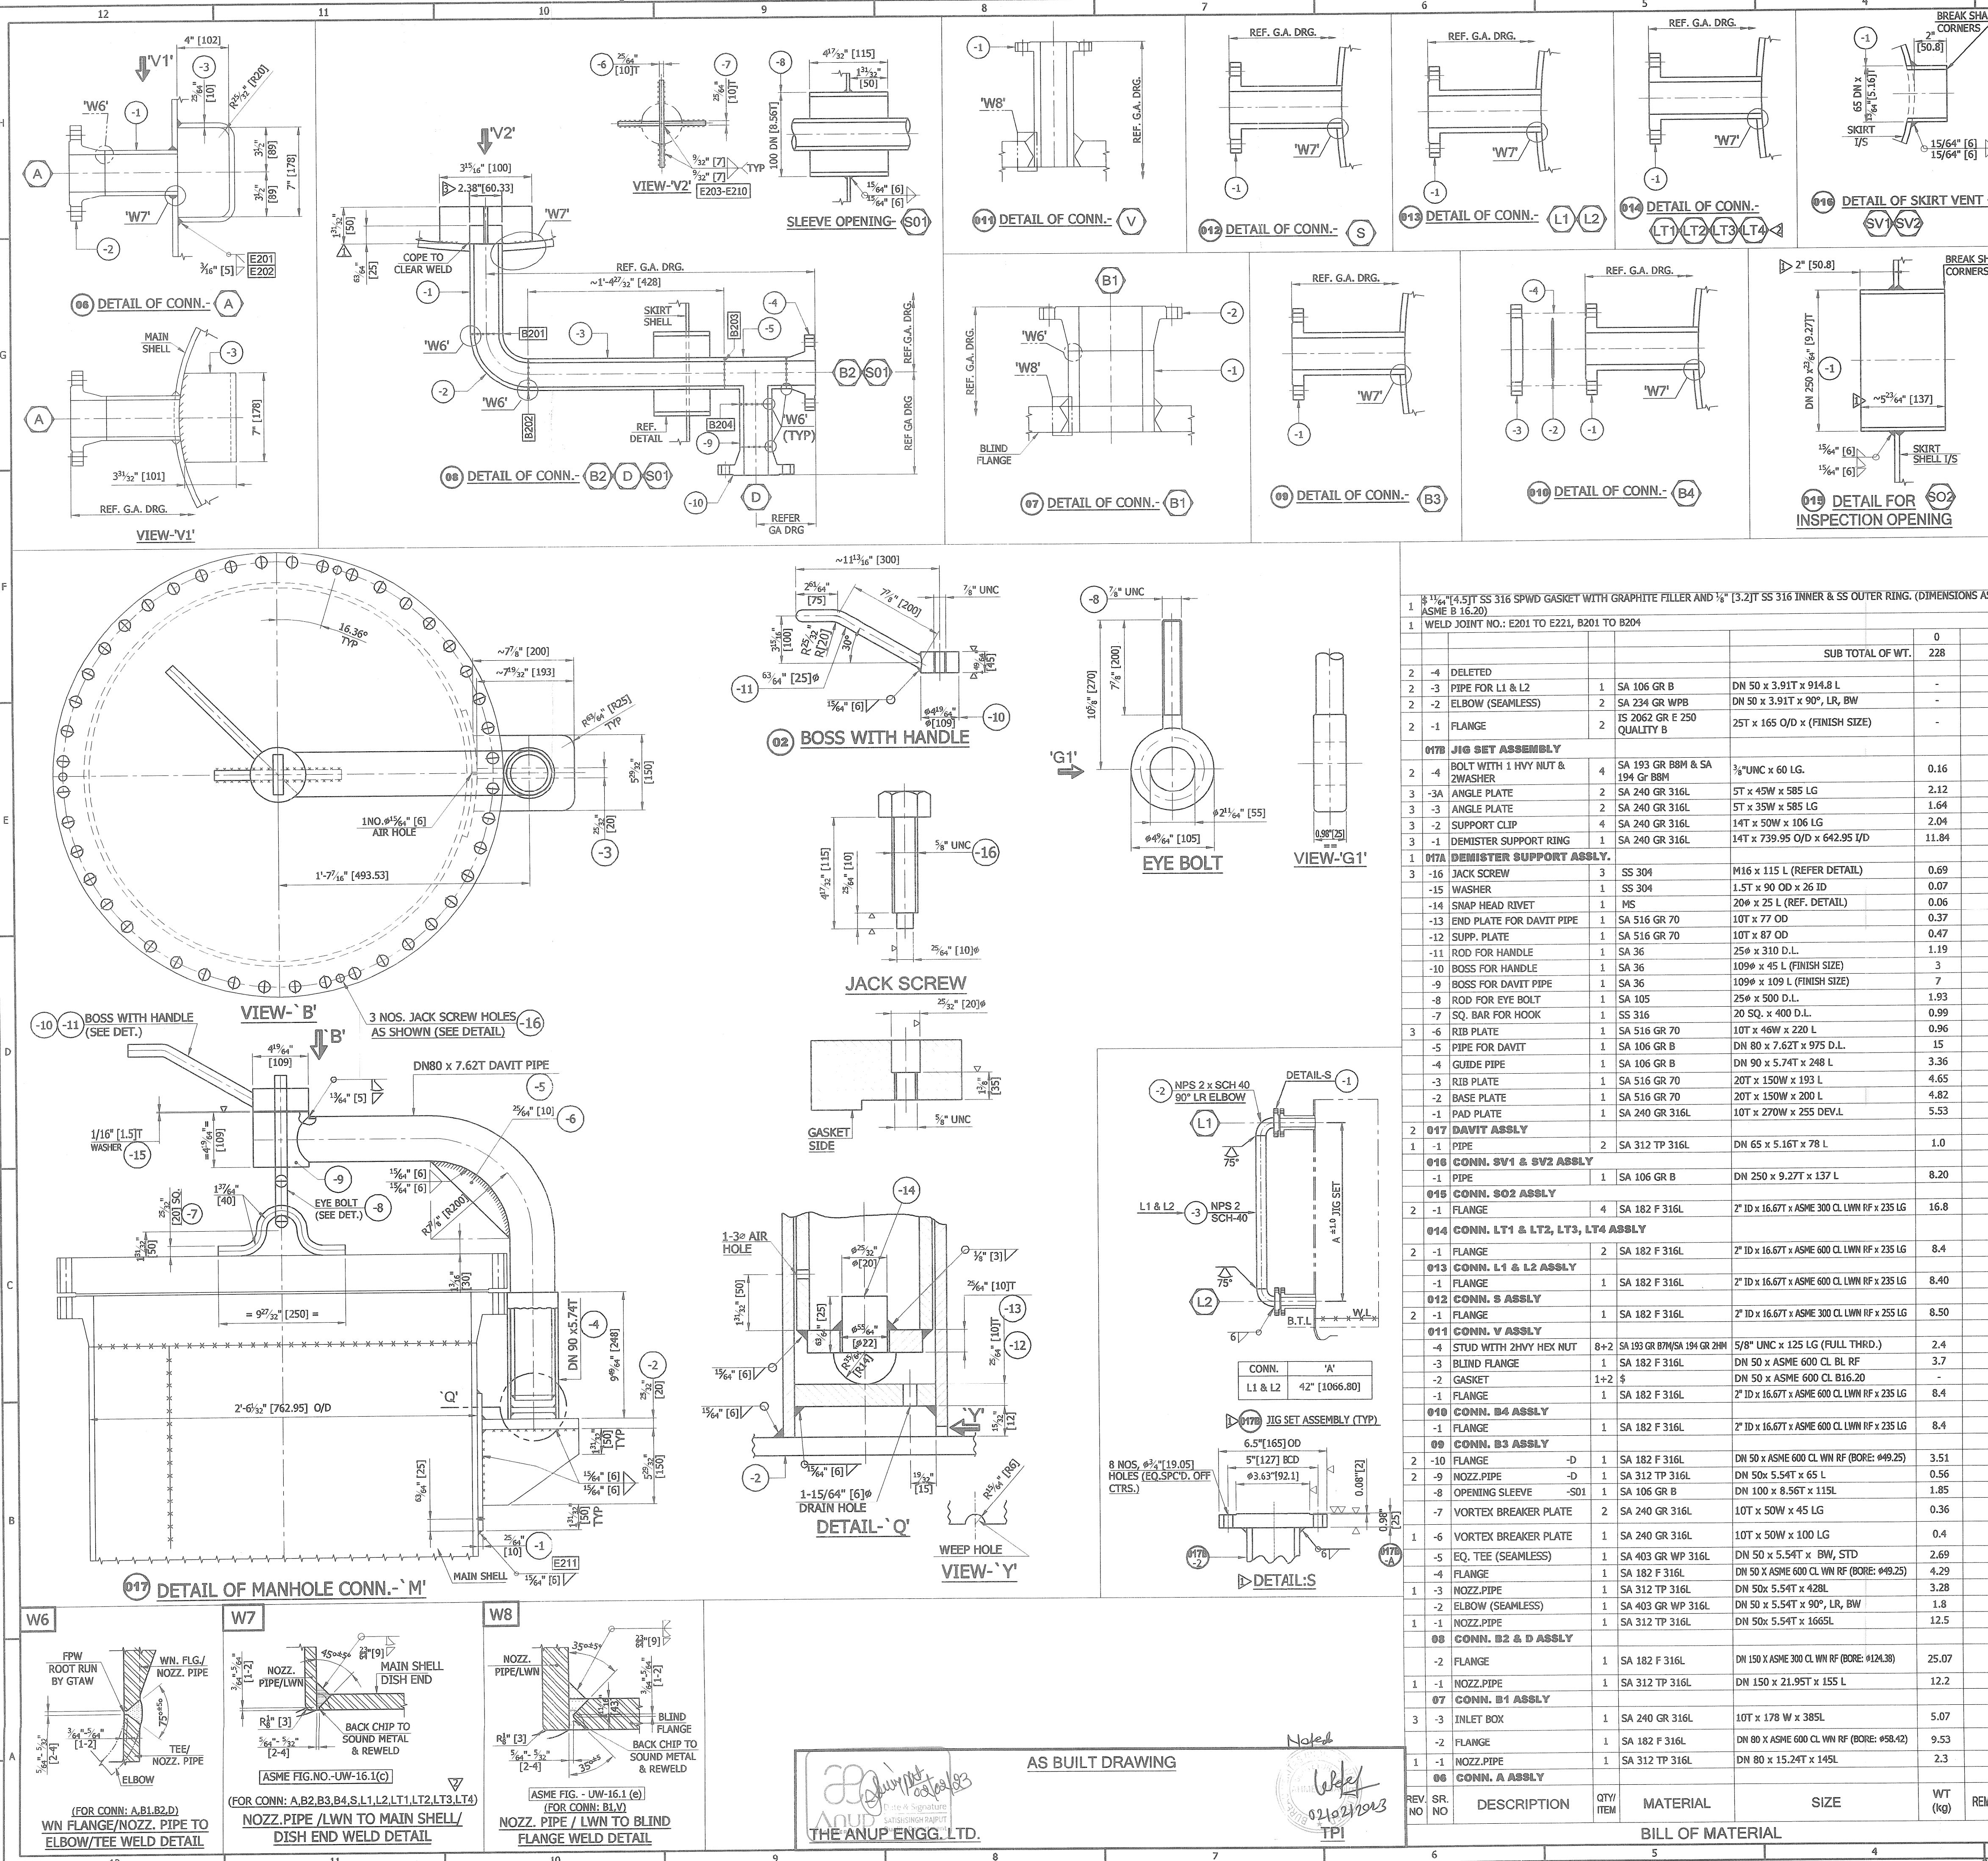


TOP VIEW OF SUPPORT RING & RETAINER ANGLE FOR MIST ELIMINATOR	
SECTION 'G-G'	
VIEW 'R1'	
VIEW 'R'	
DETAIL 'B'	
NOZZLES WELD JOINT NUMBER	
REVISIONS	
EQUIPMENT OWNER	
ENGINEERING & PROJECT MANAGEMENT	
CONTRACT NO :	
THE ANUP ENGINEERING LTD. AHMEDABAD	
CLIENT:- WORLD ENERGY PARAMOUNT PARAMOUNT, CA	
P.O.NO. : 4505426369 DATE 09.07.2021	
SHEET NO: 2 OF 4	
REV: 4	
18-D-272 ARG2 AMINE REGEN REFLUX DRUM	
H2S RECOVERY UNIT	
NOZZLES DETAILS DRAWING	
ITEM NO. 18-D-272	
QTY ONE	
DATE 20-10-2021	
SCALE 1 : 19	
MFR'S SERIAL No. V-1264	
AP DOCUMENT NUMBER EN207122-ANUP-9V3-00068	
SHEET NO. 2 OF 4	
REV. 4	
MFR'S SERIAL No. V-1264	

THIS DRAWING MUST NOT WITHOUT OUR CONSENT BE SHOWN TO ANY PERSON OUTSIDE THE RECIPIENT EMPLOY OR BE COPIED FOR THE PURPOSE OF MANUFACTURING ANY ARTICLE SHOWN IN THE DRAWING AND THE COPYRIGHT IN THE DRAWING SHALL BE AND REMAIN OUR SOLE PROPERTY. THIS DRAWING TOGETHER WITH ANY COPIES MADE BY THE RECIPIENT SHALL BE RETURNED ON DEMAND TO US.


ORIGINAL FRAME
SIZE 841 x 594 mm

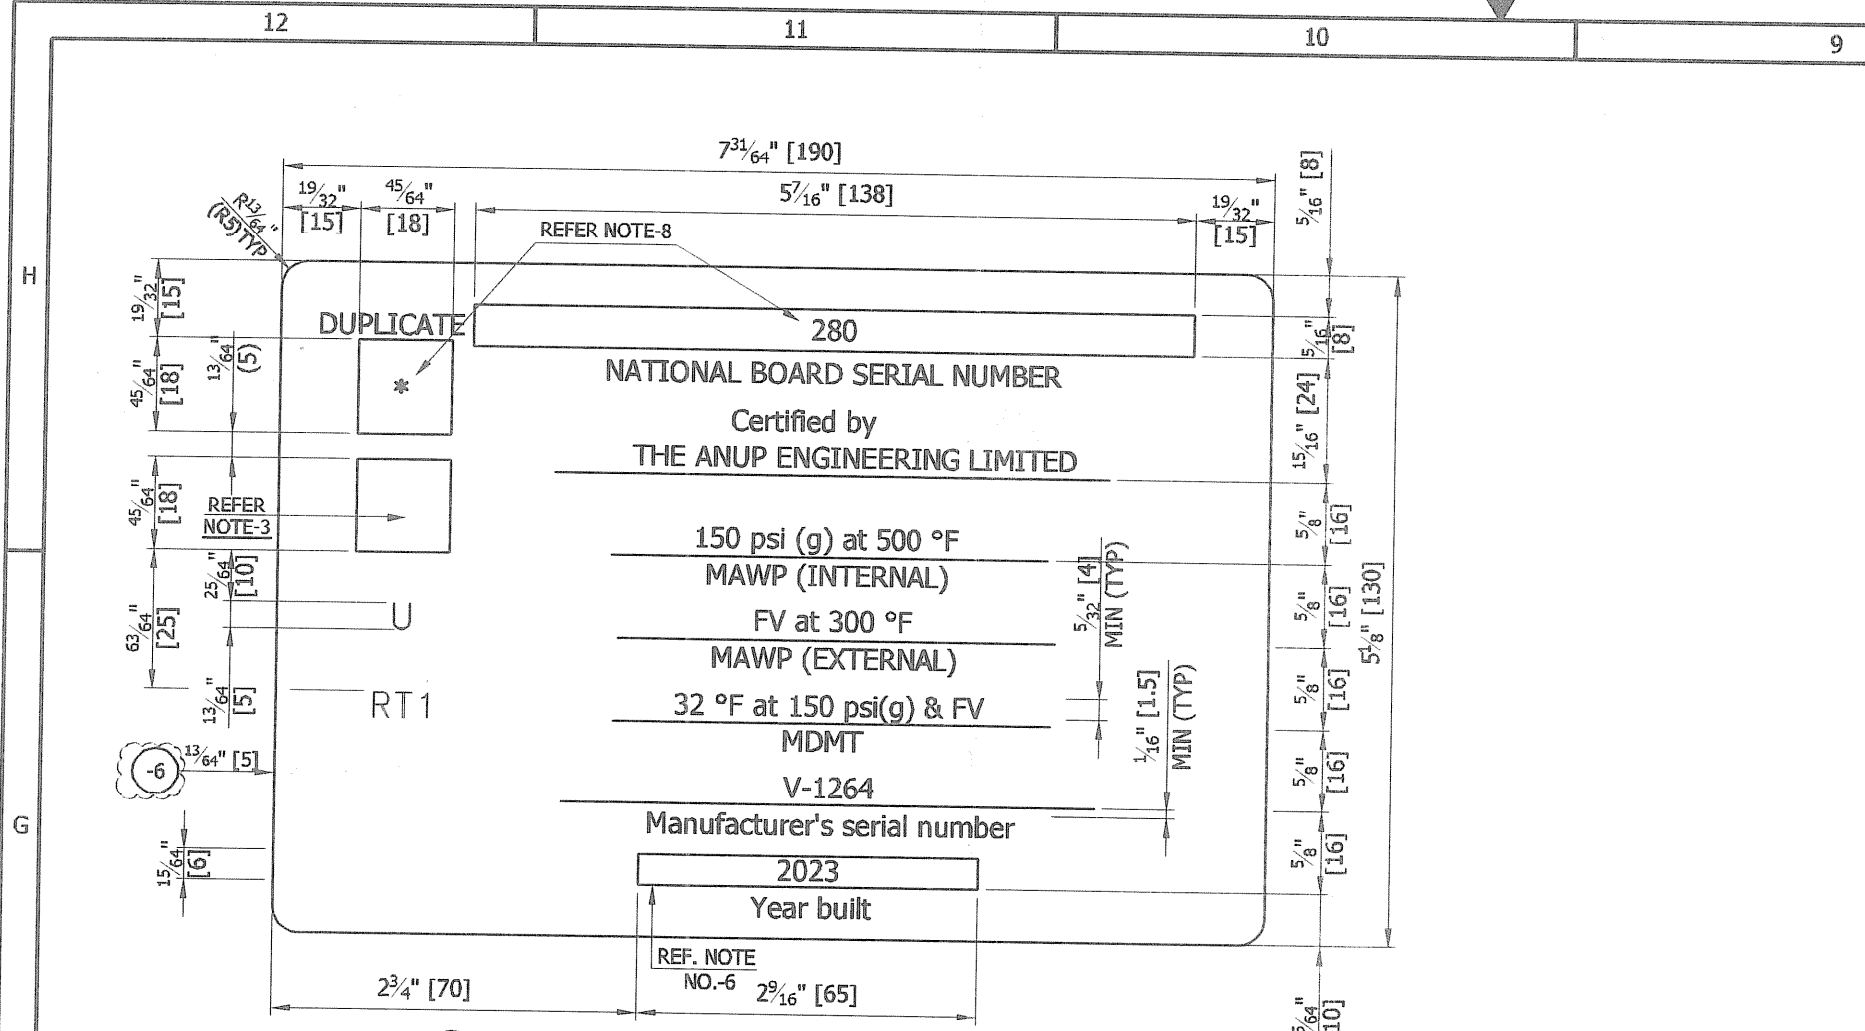

- NOTES:-**
- 1) ALL DIMENSIONS ARE IN mm UNLESS OTHERWISE SHOWN.
 - 2) HEIGHT OF CHARACTERS SHALL BE AT LEAST 4 mm & SHALL BE ENGRAVED IN A BLACK ENAMELED BACKGROUND. CHARACTERS SHALL BE EITHER INDENTED OR RAISED AT LEAST 0.1 mm & SHALL BE LEGIBLE & READABLE.
 - 3) CERTIFICATION MARK (N) TO BE HARD STAMPED IN PRESENCE OF AI AFTER OBTAINING HIS AUTHORIZATION.
 - 4) NAME PLATE SHALL BE RIVETED TO BRACKET AS PER DRAWING.
 - 5) BRACKET WITH NAME PLATE TO BE LOCATED AS MARKED IN DRG.
 - 6) YEAR BUILT SHALL CORRESPOND TO DATE OF HYDROSTATIC TESTING & SHALL BE HARD PUNCHED AFTER SUCCESSFUL COMPLETION OF HYDRO TEST.
 - 7) ALL HARD STAMPED FACE (BLOCK) SHALL BE RAISED FACE.
 - 8) NATIONAL BOARD SYMBOL AND NATIONAL BOARD SERIAL NUMBER AS ADVISED BY HEAD-QUALITY SHALL BE HARD STAMPED IN PRESENCE OF AI AFTER OBTAINING HIS AUTHORIZATION.
 - 9) DELETED

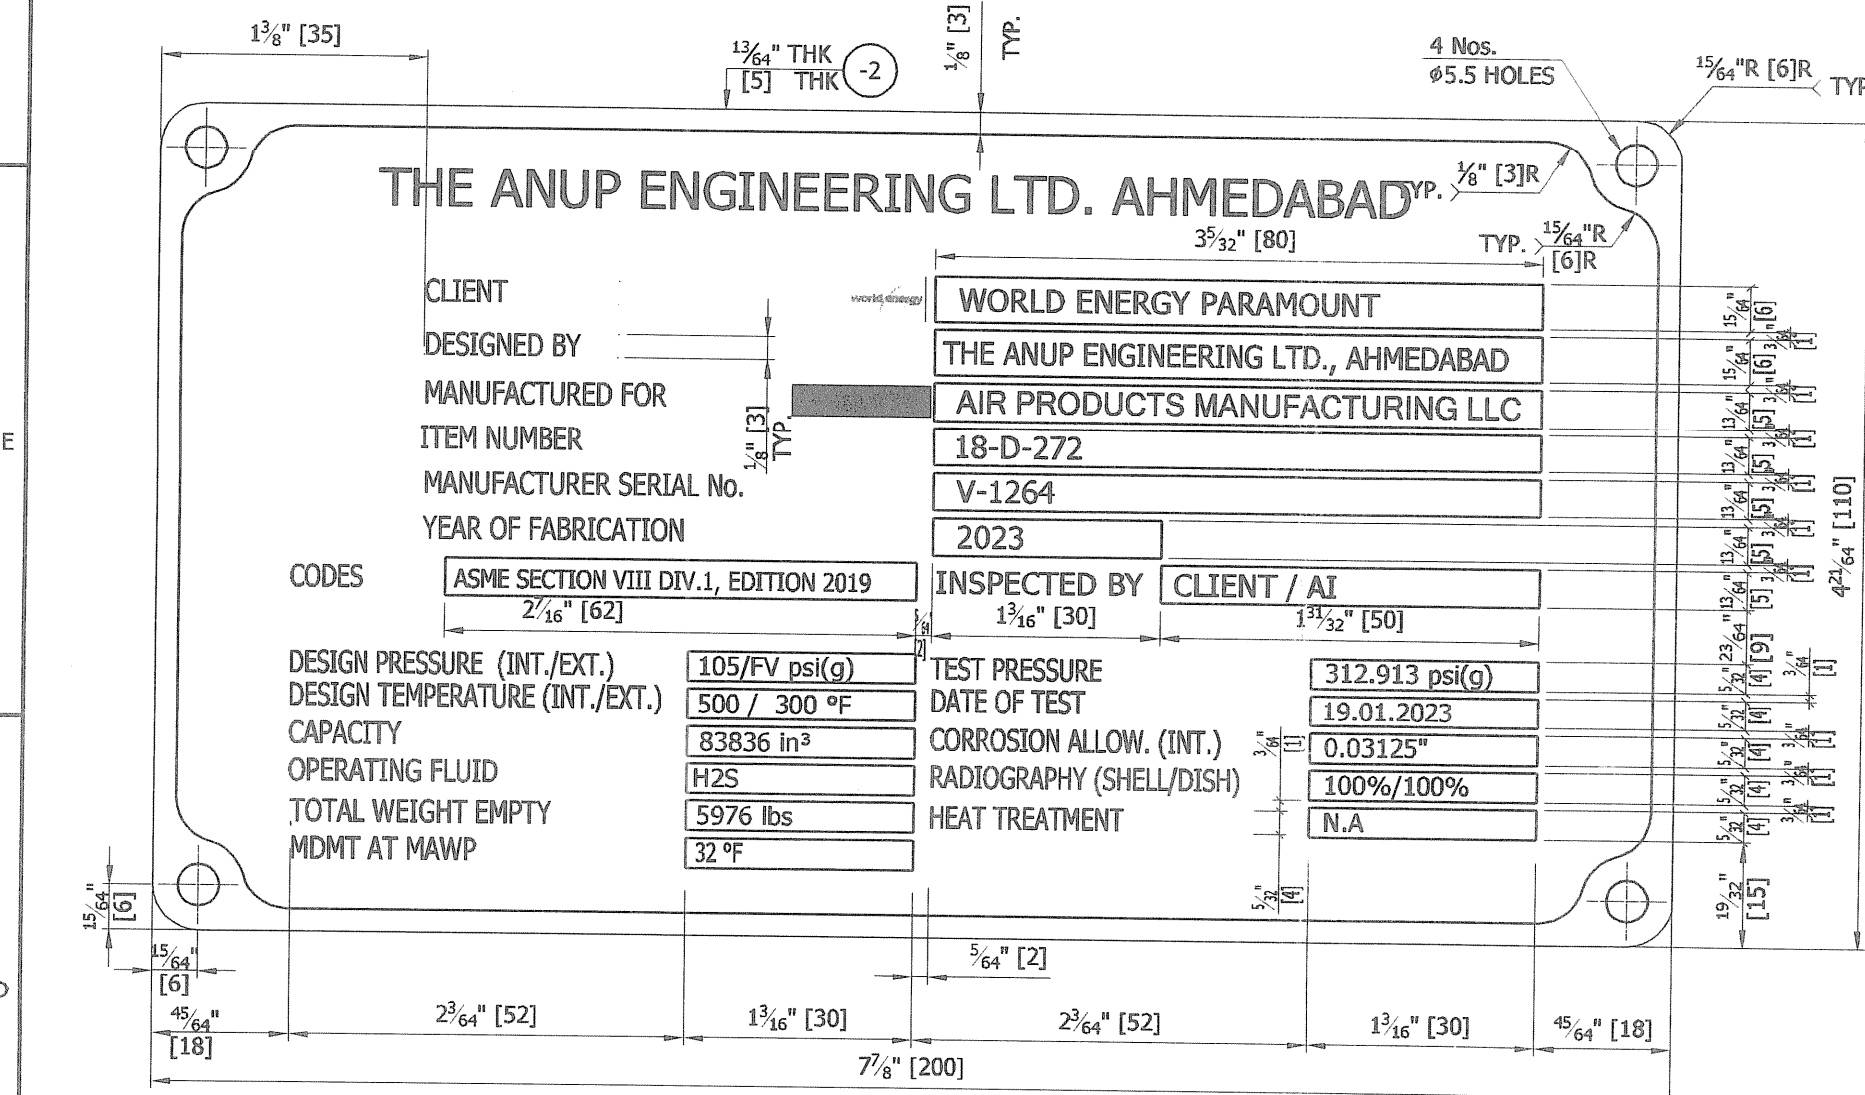

- NOTES:-**
- 1) ALL LETTERS, BLOCKS AND BORDER SHALL BE OF RAISED POLISHED FACE.
 - 2) BACK GROUND SHALL BE BLACK.
 - 3) NAME PL. SHALL BE TACK WELDED TO THE BRACKET WHERE NOT POSSIBLE IT MAY BE RIVETED.
 - 4) **TO BE FILLED AFTER HYDROTEST OF EQUIPMENT.

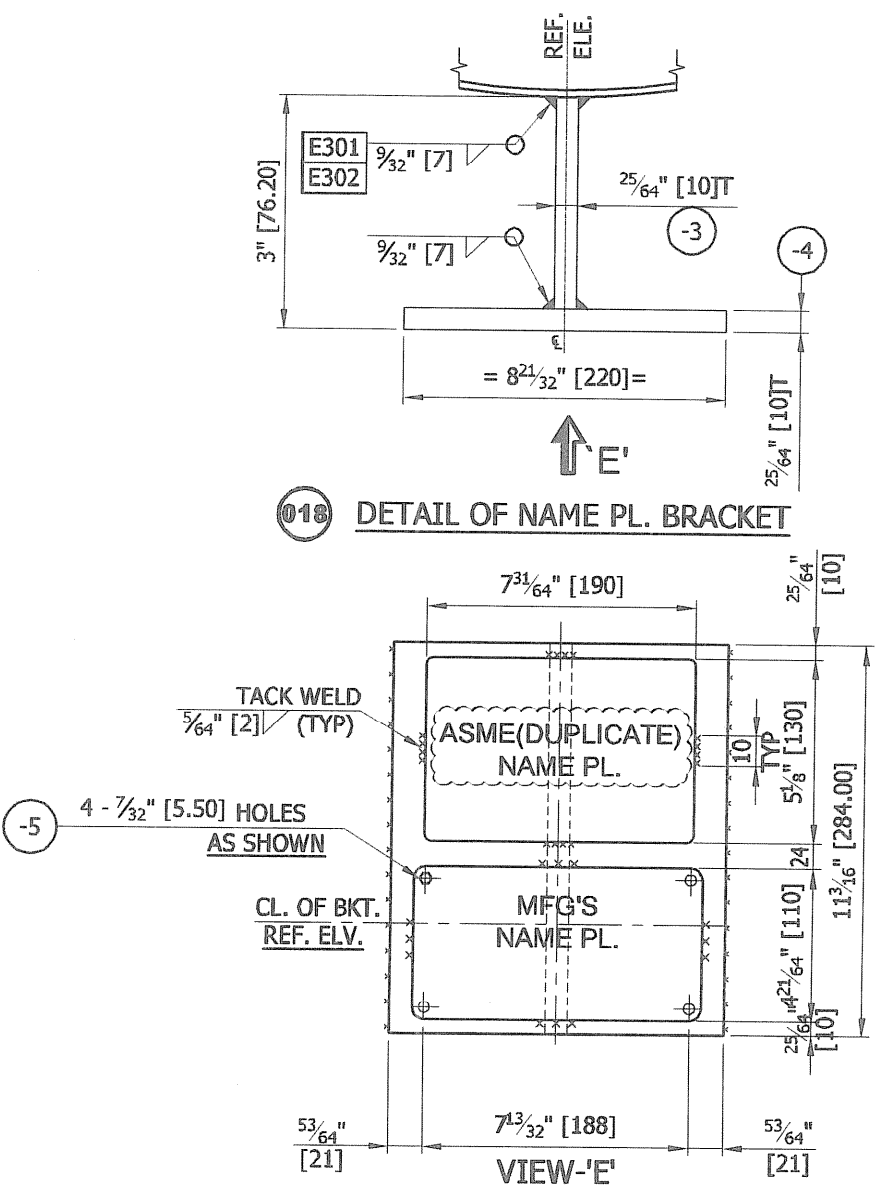

NOTE:
UNDERCUTTING OF SHELL SHALL BE AVOIDED WHEN WELDING BRACKET TO THE VESSEL

GENERAL NOTES:-

- DESIGN**
1. MECHANICAL DESIGN CALCULATION SHALL BE AS PER ASME SEC.VIII-DIV.1 ED. 2019.
 2. CORROSION ALLOWANCE IS 1/8\"/>
- MATERIAL**
1. ALL SS PLATES SHALL BE IN FULLY ANNEALED AND PICKLED CONDITION.
 2. ALL FORGING MATERIAL SHALL BE SUPPLIED IN SOLUTION ANNEALED AND QUENCHED CONDITION.
 3. MATERIAL CERTIFICATION SHALL BE AS FOLLOWS
 - a. PRESSURE PARTS: EN 10204 TYPE 3.1 CERTIFICATE FOR AIRPRODUCTS APPROVED COUNTRIES AND TYPE 3.2 FOR NON APPROVED COUNTRIES
 - b. NON PRESSURE PARTS (DIRECTLY WELDED TO PRESSURE PARTS): EN 10204 TYPE 3.1 CERTIFICATE FOR AIRPRODUCTS APPROVED COUNTRIES AND TYPE 3.2 FOR NON APPROVED COUNTRIES.
 4. POSITIVE MATERIAL IDENTIFICATION (PMI) TO BE PERFORMED FOR ALL PRESSURE CONTAINING COMPONENTS COMPONENTS IN ACCORDANCE WITH ASME-PP-000-500512-A.
 5. ALL NOZZLE FLANGES ARE AS PER ASME B 16.5-2017 FOR SIZES DN 600 (NPS 24) & BELOW AND AS PER ASME B 16.47-2017 FOR SIZES ABOVE DN 600 (NPS 24).
 6. FLANGE FACING TO BE IN ACCORDANCE WITH ASME B 16.5 SURFACE FINISH: ROUGHNESS Ra 3.2 TO 6.3 µm (Ra 125 TO 250 µin).
 7. SPARE QUANTITY
 - a. MANDATORY SPARE
 - i. GASKET: 200%
 - ii. FASTENERS: 10 % (MIN. 2)
 8. ALL PRESSURE PARTS MATERIAL SHALL MEET THE REQUIREMENT OF TPS NO. LISTED BELOW.


SR.NO.	MATERIAL	TPS. NO.
1	SA-240 GR 316L	V-1264-68 SA240 TP316L PL-REV-0
2	SA-182 F316L	V-1264-70 SA182 F316L STDFORG-REV-0
3	SA-403 WP 316L	V-1264-70 SA403 GRWP316L-REV-01
4	SA-193 GR 87M	V-1264-70 SA19387M STUDS-REV-0
5	SA-194 GR 2HM	V-1264-70 SA1942HM NUTS-REV-0

9. EXTERNAL SURFACE PREPARATION AND PAINTING SHALL BE AS PER ASME-PP-000-500520-A AND APPROVED PROCEDURE PAINTING PROCEDURE (EN207122-ANUP-9V3-00015)


- FABRICATION**
1. ALL DIMENSIONS ARE IN mm (mm) UNLESS NOTED OTHERWISE.
 2. ALL THICKNESSES SPECIFIED ON THE DRAWING ARE MINIMUM AFTER FORMING AND MACHINING.
 3. ROLLING OF PLATES SHALL BE IN LONGITUDINAL DIRECTION OF PLATES.
 4. ALL SHARP EDGES AND CORNERS SHALL BE ROUNDED OFF TO SMOOTH RADII.
 5. RAW MATERIAL IDENTIFICATION SHALL BE CARRIED OUT AS PER APPROVED QAP.
 6. WELDING TO BE DONE AS PER THE ASME-PP-000-500550-A APPROVED WELDING PROCEDURE AND WELD TEST PLAN.
 7. ALL BOLT HOLES OF THE NOZZLE FLANGE SHALL STRADDLE CENTERLINE OF THE EQUIPMENT.
 8. ALL MACHINED SURFACES, SUCH AS FLANGE FACES, THREADED BOLT HOLES, THREADS, ETC. SHALL BE PROTECTED DURING THE HEAT TREATMENT.
 9. ALL ATTACHMENTS DIRECTLY WELDED TO PRESSURE PARTS OF EQUIPMENT SHALL BE OF SAME MATERIAL AS THAT OF PRESSURE PART.
 10. NOZZLES SHALL BE LOCATED SO THAT THE NOZZLE, NOZZLE TO VESSEL WELD, AND NOZZLE REINFORCEMENT ARE AT LEAST 2\"/>
- INSPECTION AND TESTING**
1. ALL PRESSURE BEARING BUTT WELD JOINTS SHALL BE 100% RT AS PER UW-11(a).
 2. 100 % MT/PT SHALL BE PERFORMED FOR ALL WELDS.
 3. WELDS JOINING NON-PRESSURE CONTAINING COMPONENTS TO PRESSURE CONTAINING COMPONENTS SHALL BE 100% LIQUID PENETRANT OR MAGNETIC PARTICLE EXAMINED (AFTER PWHT, WHEN PWHT IS REQUIRED). THIS APPLIES TO PERMANENT AND NON-PERMANENT (E.G., LIFTING LUGS, TRUNIONS, ETC.) ATTACHMENTS ON THE INSIDE AND OUTSIDE OF THE VESSEL.
 4. WHEN TEMPORARY ATTACHMENTS ARE REMOVED, THE AREA SHALL BE GROUND FLUSH WITH THE SURROUNDING SHELL SURFACE AND LIQUID PENETRANT OR MAGNETIC PARTICLE EXAMINED.
 5. APPLICABLE NDE AND INSPECTION SHALL BE AS PER APPROVED PROCEDURES
 6. ALL TEMPORARY ATTACHMENTS SHALL BE REMOVED BEFORE HYDROSTATIC TESTING.
 7. TEMPORARY ATTACHMENTS SHALL BE REMOVED FLUSH WITH THE VESSEL SHELL AND NONDESTRUCTIVELY EXAMINED (I.E., MAGNETIC PARTICLE EXAMINATION OR DYE PENETRANT EXAMINATION (PT)), IN ADDITION TO VISUAL EXAMINATION, TO ENSURE NO CRACKS HAVE BEEN GENERATED.

- HYDRO TEST**
1. DELETED.
 2. PRESSURE TESTING SHALL BE COMPLETED BEFORE PRIMERS, PAINT, OR OTHER COATINGS ARE APPLIED.
 3. THE HYDROSTATIC TEST MEDIUM SHALL BE CLEAN, FRESH, POTABLE WATER.
 4. THE WELDS OF WELDED ATTACHMENTS PROVIDED WITH VENT HOLES (E.G., REINFORCING PADS, SLIPON FLANGES) SHALL BE LEAK TESTED USING 15PSIG (1 KG/CM²) PNEUMATIC PRESSURE AND A BUBBLE FORMING SOLUTION PRIOR TO POSTWELD HEAT TREATMENT AND FINAL HYDROSTATIC TEST.
 5. THE VESSEL SHALL BE DRAINED AND THOROUGHLY DRIED IMMEDIATELY UPON THE COMPLETION OF PRESSURE TESTING. THE PROCEDURE FOR DRAINING THE TEST FLUID SHALL PREVENT DEVELOPMENT OF VACUUM PRESSURE WITHIN THE VESSEL OR ITS INTERNALS. THE PROCEDURE SHALL PREVENT DAMAGE TO OR DISLOCATION OF THE INTERNALS.
 6. THE HYDROSTATIC TEST PRESSURE SHALL BE HELD FOR AT LEAST 1 HR.
 7. TEST WATER SHALL NOT BE IN CONTACT WITH AUSTENITIC STAINLESS STEEL FOR GREATER THAN 72 HOURS UNLESS TREATED WITH AN APPROPRIATE BIOCIDES.
 8. VESSELS OR COMPONENTS MADE OF AUSTENITIC STAINLESS STEEL MATERIALS SHALL BE PERFORMED WITH WATER CONTAINING A MAXIMUM OF 50 PPM CHLORIDE.
 9. THE INTERIOR OF THE VESSEL SHALL BE CLEANED IN ACCORDANCE WITH SECTION 4.6.1.2 OF ASME-PP-000-50801-A & APPROVED CLEANING PROCEDURE

- TRANSPORTATION**
1. EQUIPMENT SHALL BE PURGED WITH NITROGEN AT 5 psig (g) PRESSURE.
 2. ADDITIONAL INDICATIONS SUCH AS NORTH/SOUTH/EAST/WEST ALONG WITH CENTER OF GRAVITY
 3. SHALL BE CLEARLY MARKED VESSELS SHALL BE NITROGEN PURGED, FILLED AND HAVE BLIND FLANGES, SERVICE GASKETS, AND FULL BOLTING ON ALL NOZZLES. VENDOR SHALL PROVIDE SPARE DRY NITROGEN BOTTLE FOR ADDITIONAL REQUIREMENT PLEASE REFER PROJECT SPECIFICATION ASME-PP-000-50801-A SECTION 4.6.3 F. 1. I.
 4. VERTICAL VESSELS ARE TO BE MARKED ON THE BASE AND FIRST ONE FOOT OF SKIRT, INDICATING THE NORTH, SOUTH, EAST, AND WEST COORDINATES. THE COORDINATES SHALL BE INDICATED WITH A PAINTED LINE AND LETTER FOR EACH, ACCORDING TO THE ORIENTATION SHOWN ON THE VESSEL DRAWINGS.
 5. THE CENTER OF GRAVITY SHALL BE MARKED ON ALL VERTICAL VESSELS BY PAINTING A CONTINUOUS 3 INCH WIDE CIRCUMFERENTIAL STRIPE. THE LETTERS CG AND SHIPPING WEIGHT IN TONS SHALL BE PAINTED AT 2 LOCATIONS DIAMETRICALLY OPPOSITE AND ADJACENT TO THE STRIPE. THE LOCATION OF THE CENTER OF GRAVITY SPECIFIED ON THE VESSEL FABRICATION DRAWINGS IS THAT OF THE VESSEL AS FABRICATED
 6. VESSELS OR SECTION OF VESSELS SHALL BE CLEARLY IDENTIFIED BY PAINTING OR DYE STENCILING THE PO NUMBER AND THE VESSEL EQUIPMENT NUMBER IN A CONSPICUOUS LOCATION ON THE SHELL HEAD OR SUPPORT.

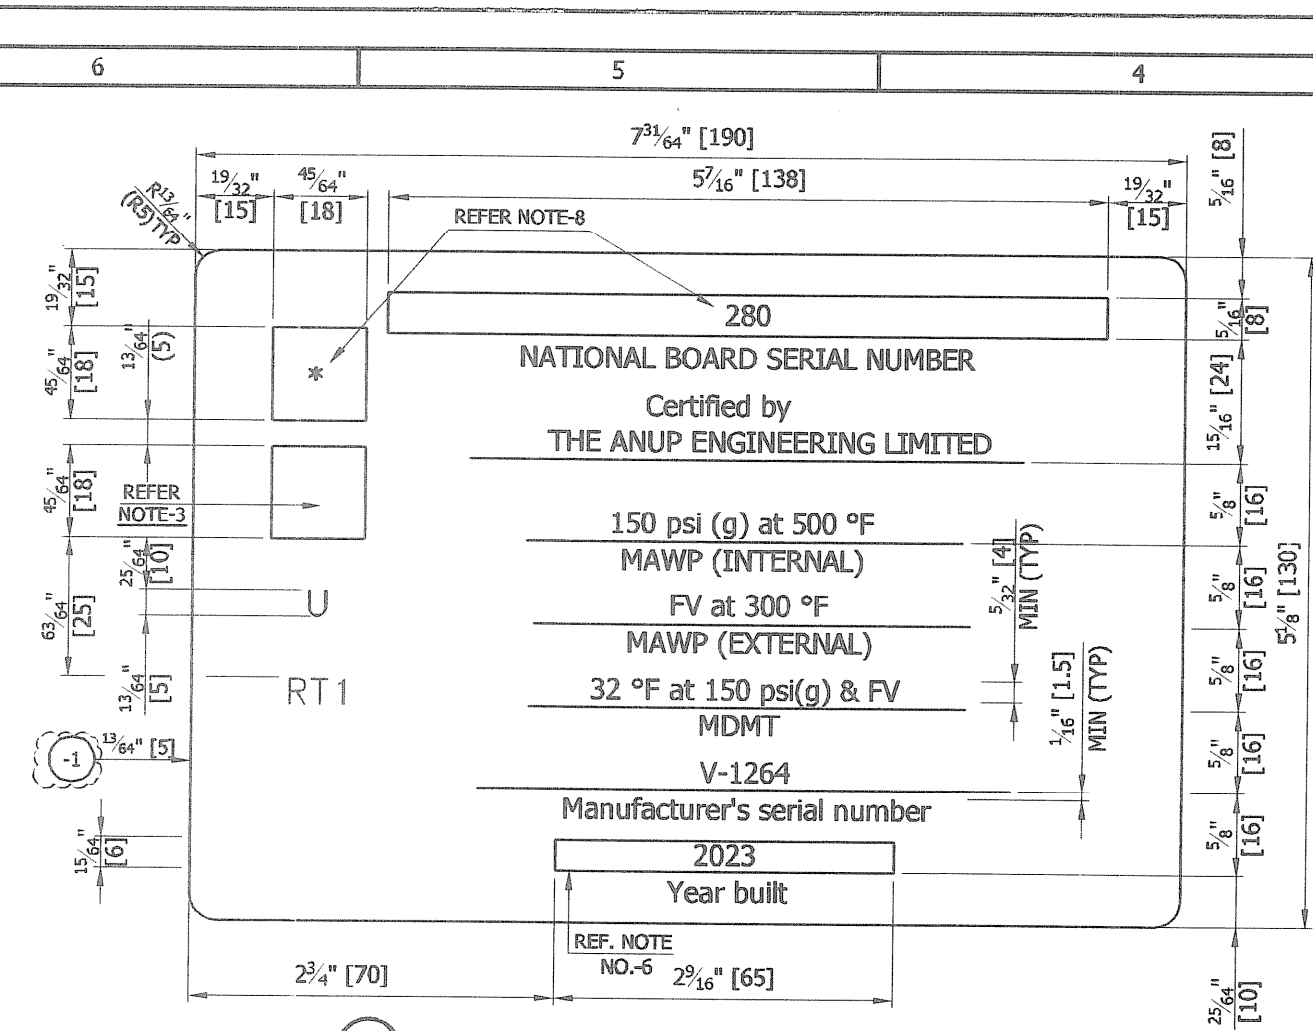

- NOTES:-**
- 1) ALL DIMENSIONS ARE IN mm UNLESS OTHERWISE SHOWN.
 - 2) HEIGHT OF CHARACTERS SHALL BE AT LEAST 4 mm & SHALL BE ENGRAVED IN A BLACK ENAMELED BACKGROUND. CHARACTERS SHALL BE EITHER INDENTED OR RAISED AT LEAST 0.1 mm & SHALL BE LEGIBLE & READABLE.
 - 3) CERTIFICATION MARK (N) TO BE HARD STAMPED IN PRESENCE OF AI AFTER OBTAINING HIS AUTHORIZATION.
 - 4) NAME PLATE SHALL BE RIVETED TO BRACKET AS PER DRAWING.
 - 5) BRACKET WITH NAME PLATE TO BE LOCATED AS MARKED IN DRG.
 - 6) YEAR BUILT SHALL CORRESPOND TO DATE OF HYDROSTATIC TESTING & SHALL BE HARD PUNCHED AFTER SUCCESSFUL COMPLETION OF HYDRO TEST.
 - 7) ALL HARD STAMPED FACE (BLOCK) SHALL BE RAISED FACE.
 - 8) NATIONAL BOARD SYMBOL AND NATIONAL BOARD SERIAL NUMBER AS ADVISED BY HEAD-QUALITY SHALL BE HARD STAMPED IN PRESENCE OF AI AFTER OBTAINING HIS AUTHORIZATION.

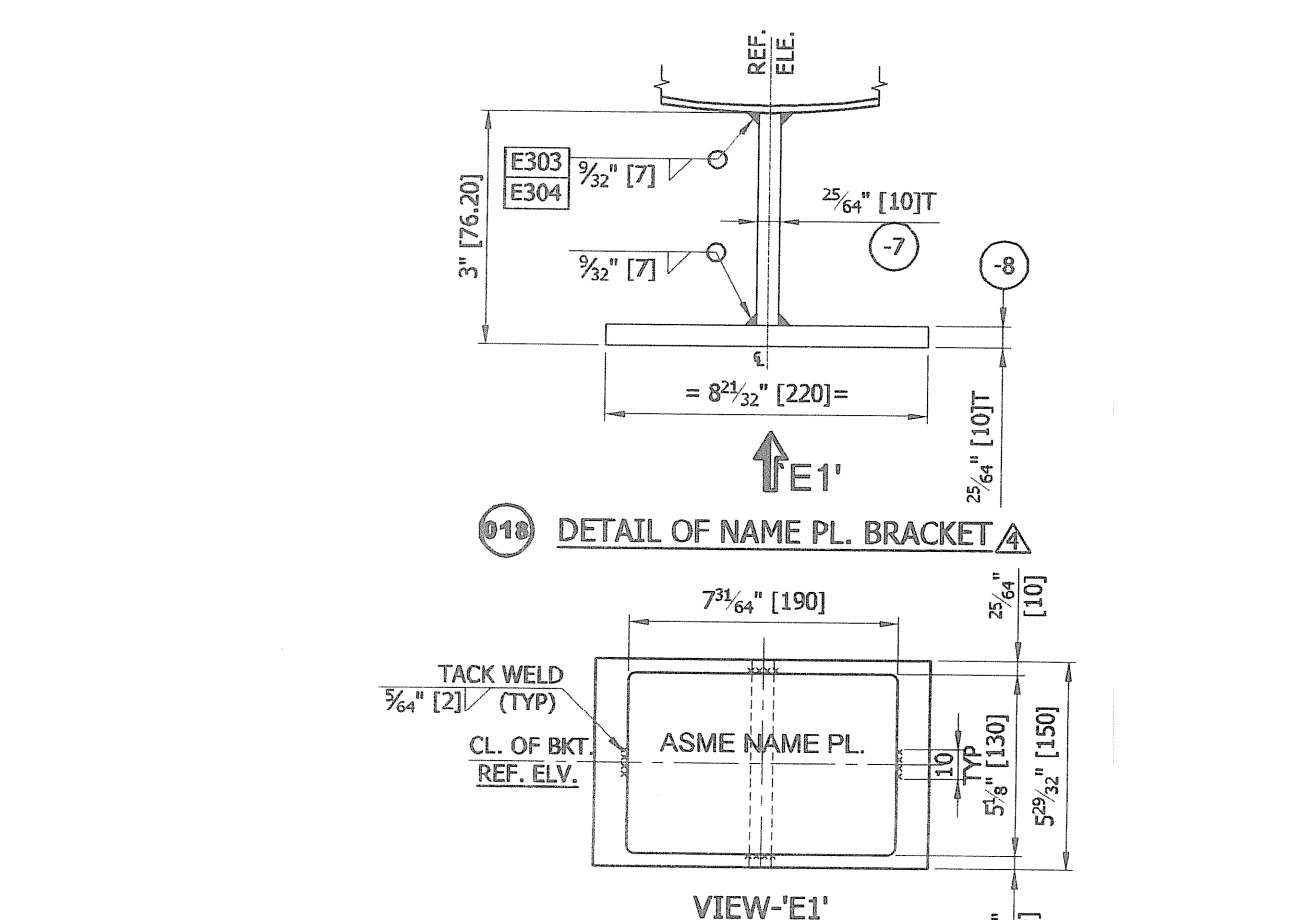


NOTE:
UNDERCUTTING OF SHELL SHALL BE AVOIDED WHEN WELDING BRACKET TO THE VESSEL

APPLICABLE STANDARDS			
SR. NO.	STD. NO.	DESCRIPTION	REV. NO.
1	ASME-PP-000-53007-D	VESSEL NAMEPLATE BRACKET	0
2	ASME-PP-000-53026-D	VESSEL VORTEX BREAKERS	0A
3	ASME-PP-000-53008-D	VESSEL GROUNDING LUG	0
4	ASME-PP-000-53021-D	VESSEL VERTICAL MANWAY DAVITS	0
5	ASME-PP-000-53027-D	VESSEL INTERNAL RUNGS	0
6	ASME-PP-000-53006-D	SKIRT OPENING VERTICAL VESSELS	0A
7	ASME-PP-000-53007-D	VESSEL NAMEPLATE BRACKET	0
8	ASME-PP-000-53001-D	MIST ELIMINATOR DETAILS	0A
9	ASME-PP-000-530029-D	SKIRT ATTACHMENT	0A

REFERENCE SPECIFICATIONS			
SR. NO.	SPEC. NO.	DESCRIPTION	REV. NO.
1	ASME-PP-000-500550-A	WELDING/NDE REQUIREMENTS FOR EQUIPMENT	0A
2	ASME-18-088-540321-A	MECHANICAL EQUIPMENT DATA SHEET FOR 18-X-261	D
3	ASME-PP-000-500512-A	POSITIVE MATERIAL IDENTIFICATION (PMI)	0
4	ASME-PP-000-500520-A	PAINTING	0D
5	ASME-PP-000-500550-A	DESIGN OF LIFTING COMPONENTS FOR MECHANICAL EQUIPMENT	0
6	ASME-PP-000-500540-A	GALVANIZING	0A
7	ASME-PP-000-50801-A	DESIGN AND FABRICATION SPECIFICATION FOR VESSELS ASME CODE SECTION VIII, DIVISIONS 1 AND 2.	0
8	ASME-PP-000-50804-A	DESIGN AND FABRICATION SPECIFICATION FOR PRESSURE VESSEL INTERNALS	0

AS BUILT DRAWING		REVISED	
THE ANUP ENGG. LTD.		TP1	
4	23-01-2023	AS BUILT DRAWING	GML AAS BMP
3	17-09-2022	DRAWING REVISED AS PER CLIENT COMMENT AS MARKED	VAP JD BMP
2	20-04-2022	DRAWING REVISED AS PER CLIENT COMMENT AS MARKED	VAP KRK DKB
1	01-01-2022	DRAWING REVISED AS PER CLIENT COMMENT AS MARKED	VAP KRK BMP
0	29-07-2021	ISSUED FOR APPROVAL	VAP KRK BMP
REV. NO.	DATE	DESCRIPTION	BY CHD. APPD.
EQUIPMENT OWNER			
Air Products Manufacturing LLC			
ENGINEERING & PROJECT MANAGEMENT			
AIR PRODUCTS			
CONTRACT NO :			
THE ANUP ENGINEERING LTD. AHMEDABAD			
CLIENT: WORLD ENERGY PARAMOUNT PARAMOUNT, CA		SHEET NO: 3 OF 4	
P.O.NO. : 4505426369 DATE 09.07.2021		DRG. NO: V-1264-FAD-2021	
DRN. VAP		REV: 4	
CHD. -		18-D-272 ARG2 AMINE REGEN REFLUX DRUM	
APPD. BMP		H2S RECOVERY UNIT	
DATE 20-10-2021		NAME PLATE AND GENERAL NOTES DETAILS DRAWING	
SCALE 1 : 19		QTY ONE	
MFR'S SERIAL NO.: V-1264		AP DOCUMENT NUMBER EN207122-ANUP-9V3-00028	
SHEET NO. 3 OF 4		REV. 4	
MFR'S SERIAL NO. : V-1264			

4 WELD JOINT NO. : E302 TO E304				SUB TOTAL OF WEIGHT (KG)		6
4	-8	NAME PLATE BRACKET PLT.-2	1	SA 240 GR 316L	10T x 220W x 150 LG.	2.65
4	-7	NAME PLATE BRACKET PLT.-1	1	SA 240 GR 316L	10T x 66.2W x 150 LG.	0.8
4	-6	ASME DUPLICATE NAME PLATE	1	SS 304	5T x 130W x 190 LG	0.99
4	-5	RIVET	8	ALUMINIUM	#5 x 20 LG	-
	-4	NAME PLATE BRACKET PLT.-2	1	SA 240 GR 316L	10T x 220W x 284 LG.	3
	-3	NAME PLATE BRACKET PLT.-1	1	SA 240 GR 316L	10T x 66.2W x 284 LG.	1.02
	-2	MFG'S NAME PLATE	1	SS 304	5T x 110W x 200 LG.	0.88
	-1	ASME NAME PLATE	1	SS 304	5T x 130W x 190 LG	0.99
018 NAME PLATE ASSLY						
REV. NO.	SR. NO.	DESCRIPTION	QTY/ ITEM	MATERIAL	SIZE	WT. (kg)
BILL OF MATERIAL						

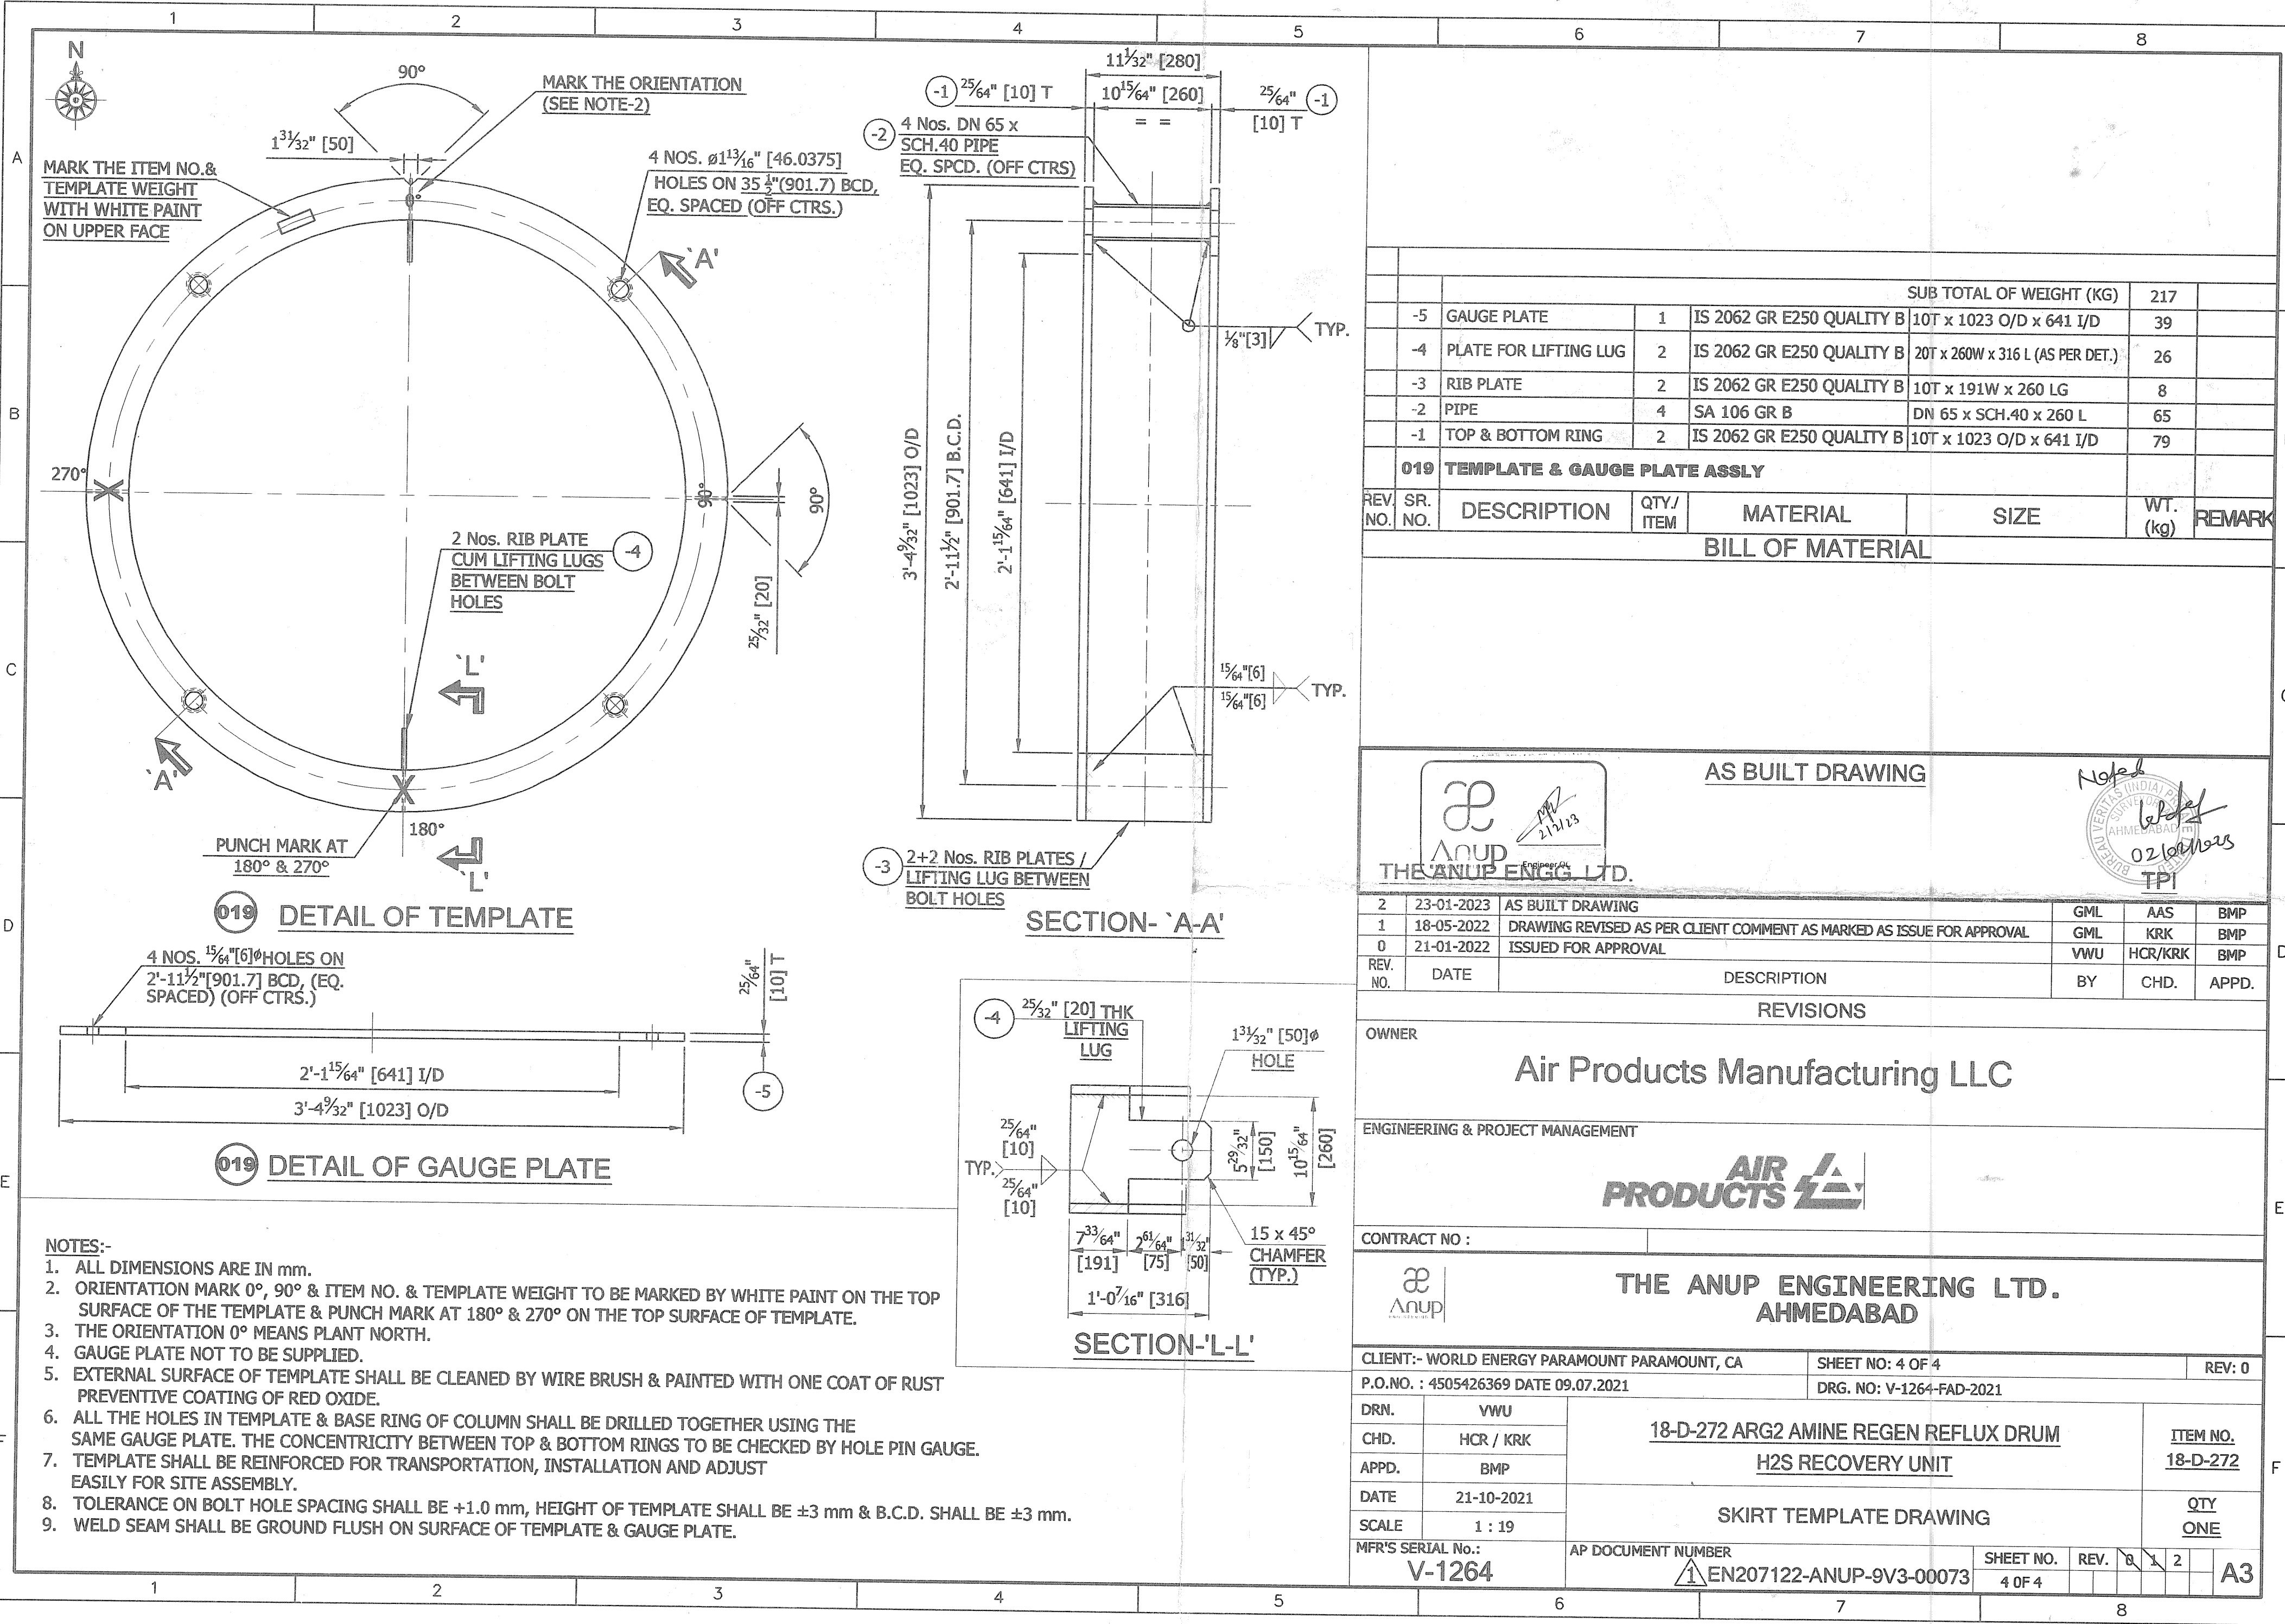

- NOTES:-**
1. ALL DIMENSIONS ARE IN mm.
 2. ORIENTATION MARK 0°, 90° & ITEM NO. & TEMPLATE WEIGHT TO BE MARKED BY WHITE PAINT ON THE TOP SURFACE OF THE TEMPLATE & PUNCH MARK AT 180° & 270° ON THE TOP SURFACE OF TEMPLATE.
 3. THE ORIENTATION 0° MEANS PLANT NORTH.
 4. GAUGE PLATE NOT TO BE SUPPLIED.
 5. EXTERNAL SURFACE OF TEMPLATE SHALL BE CLEANED BY WIRE BRUSH & PAINTED WITH ONE COAT OF RUST PREVENTIVE COATING OF RED OXIDE.
 6. ALL THE HOLES IN TEMPLATE & BASE RING OF COLUMN SHALL BE DRILLED TOGETHER USING THE SAME GAUGE PLATE. THE CONCENTRICITY BETWEEN TOP & BOTTOM RINGS TO BE CHECKED BY HOLE PIN GAUGE.
 7. TEMPLATE SHALL BE REINFORCED FOR TRANSPORTATION, INSTALLATION AND ADJUST EASILY FOR SITE ASSEMBLY.
 8. TOLERANCE ON BOLT HOLE SPACING SHALL BE +1.0 mm, HEIGHT OF TEMPLATE SHALL BE ±3 mm & B.C.D. SHALL BE ±3 mm.
 9. WELD SEAM SHALL BE GROUND FLUSH ON SURFACE OF TEMPLATE & GAUGE PLATE.

SUB TOTAL OF WEIGHT (KG)						
-5	GAUGE PLATE	1	IS 2062 GR E250 QUALITY B	10T x 1023 O/D x 641 I/D	39	
-4	PLATE FOR LIFTING LUG	2	IS 2062 GR E250 QUALITY B	20T x 260W x 316 L (AS PER DET.)	26	
-3	RIB PLATE	2	IS 2062 GR E250 QUALITY B	10T x 191W x 260 LG	8	
-2	PIPE	4	SA 106 GR B	DN 65 x SCH.40 x 260 L	65	
-1	TOP & BOTTOM RING	2	IS 2062 GR E250 QUALITY B	10T x 1023 O/D x 641 I/D	79	
019 TEMPLATE & GAUGE PLATE ASSLY						
REV. NO.	SR. NO.	DESCRIPTION	QTY/ ITEM	MATERIAL	SIZE	WT. (kg) REMARK

BILL OF MATERIAL						
2	23-01-2023	AS BUILT DRAWING		GML	AAS	BMP
1	18-05-2022	DRAWING REVISED AS PER CLIENT COMMENT AS MARKED AS ISSUE FOR APPROVAL		GML	KRK	BMP
0	21-01-2022	ISSUED FOR APPROVAL		VWU	HCR/KRK	BMP
REV. NO.	DATE	DESCRIPTION	BY	CHD.	APPD.	

OWNER

Air Products Manufacturing LLC

ENGINEERING & PROJECT MANAGEMENT

AIR PRODUCTS



CONTRACT NO :

THE ANUP ENGINEERING LTD. AHMEDABAD

CLIENT:- WORLD ENERGY PARAMOUNT PARAMOUNT, CA		SHEET NO: 4 OF 4		REV: 0
P.O.NO. : 4505426369 DATE 09.07.2021		DRG. NO: V-1264-FAD-2021		
DRN.	VWU	18-D-272 ARG2 AMINE REGEN REFLUX DRUM H2S RECOVERY UNIT		ITEM NO. 18-D-272
CHD.	HCR / KRK			
APPD.	BMP	SKIRT TEMPLATE DRAWING		QTY ONE
DATE	21-10-2021			
SCALE	1 : 19			
MFR'S SERIAL No.: V-1264		AP DOCUMENT NUMBER 1 EN207122-ANUP-9V3-00073		SHEET NO. 4 OF 4

ORIGINAL FRAME
T7E 841 x 594 mm

- 1) ALL DIMENSIONS ARE IN mm UNLESS OTHERWISE SHOWN.
- 2) IF ANY ATTACHMENT LIKE REINFORCEMENT PADS, INTERNALS, CLEATS ETC. SHALL PREFERABLY BE AWAY FROM THE MAIN SEAMS. IN CASE IT IS UNAVOIDABLE, THE MAIN SEAM PORTION COMING UNDER THE ATTACHMENT PLUS 150MM LENGTH ON BOTH SIDES SHALL BE GROUND FLUSH, FULLY RADIOGRAPHED AND DYE PENETRANT EXAMINED BEFORE WELDING OF ANY SUCH ATTACHMENT.
- 3) TO CUT SUITABLE NOTCH IN CLEAT TO AVOID FOULING WITH WELD SEAM.

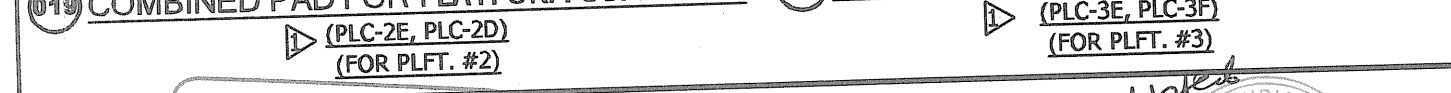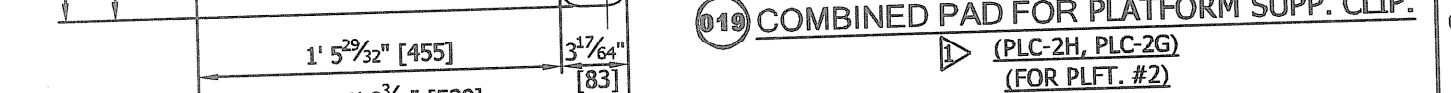

WELD JOINT NO.: E401 TO E408		SUB TOTAL OF WEIGHT (KG)					
1	-	LADDER CLEAT (LD-E02C)	2	SA 516 GR 70	10T x 152.4MM x ~337 LG. (REF. DETAIL)	(KG)	8.06
1	-8	LADDER CLEAT (LD-E02C)	2	SA 516 GR 316L	10T x 62 DEV W X 203 L		1.98
1	-7	PAD PLATE (LD-E02C)	4	SA 516 GR 70	10T x 152.4MM x ~337 LG. (REF. DETAIL)		6.12
1	-6	PAD PLATE (LD-02A, LD-02B)	2	SA 516 GR 70	10T x 152.4MM x ~203 L		2.7
1	-5A	PAD PLATE (LD-02B)	1	SA 240 GR 316L	10T x 62 DEV W X 203 L		2.97
1	-5	PAD PLATE (LD-02A, LD-E02B)	3	SA 516 GR 70	10T x 152.4MM x ~312 LG. (REF. DETAIL)		7.46
1	-4	PAD PLATE (LD-01B)	2	SA 516 GR 70	10T x 152.4MM x ~203 L		2.97
1	-3	PAD PLATE (LD-01B)	2	SA 516 GR 70	10T x 62 DEV W X 203 L		1.98
1	-2	LADDER CLEAT (LD-01A)	2	SA 516 GR 70	10T x 152.4MM x ~312 LG. (REF. DETAIL)		7.46
1	-1	LADDER CLEAT (LD-01A)	2	SA 516 GR 70	10T x 62 DEV W X 203 L		1.98

1	-1	FRD FRTLE (RED 24/12/12)	
019		PLATFORM SUPPORT ASSLY.	

NO.	NO.	DESCRIPTION	ITEM	...
BILL OF MATERIAL				

REV. NO.	DATE	DESCRIPTION	DT	UNIT	VAL

EQUIPMENT OWNER
Air Products Manufacturing LLC

ENGINEERING & PROJECT MANAGEMENT

AIR PRODUCTS 

CONTRACT NO :	
---------------	--

THE ANUP ENGINEERING LTD.
AHMEDABAD

CLIENT: WORLD ENERGY PARAMOUNT, CA	SHEET NO: 1 OF 1	RE
------------------------------------	------------------	----










CLIENT: WORLD EMERGENCY		DRG. NO: V-1264-FAD-2021	
P.O.NO. : 4505426369 DATE 09.07.2021			
DRN.	VAP	18 D 272 ARG2 AMINE REGEN REFLUX DRUM	ITEM N

CHD.	-	18-D-272 ARGE AMINE RECOVERY UNIT	18-D-2
APPD.	BMP	H2S RECOVERY UNIT	QTY


DATE	01-09-2022	EXTERNAL ATTACHMENT DRAWING				SHEET NO.	REV.	A	B	C	D	E	F	G	H	I	J	K	L	M	N	O	P	Q	R	S	T	U	V	W	X	Y	Z	AA	AB	AC	AD	AE	AF	AG	AH	AI	AJ	AK	AL	AM	AN	AO	AP	AQ	AR	AS	AT	AU	AV	AW	AX	AY	AZ	BA	BB	BC	BD	BE	BF	BG	BH	BI	BJ	BK	BL	BM	BN	BO	BP	BQ	BR	BS	BT	BU	BV	BW	BX	BY	BZ	CA	CB	CC	CD	CE	CF	CG	CH	CI	CJ	CK	CL	CM	CN	CO	CP	CQ	CR	CS	CT	CU	CV	CW	CX	CY	CZ	DA	DB	DC	DD	DE	DF	DG	DH	DI	DJ	DK	DL	DM	DN	DO	DP	DQ	DR	DS	DT	DU	DV	DW	DX	DY	DZ	EA	EB	EC	ED	EE	EF	EG	EH	EI	EJ	EK	EL	EM	EN	EO	EP	EQ	ER	ES	ET	EU	EV	EW	EX	EY	EZ	FA	FB	FC	FD	FE	FF	FG	FH	FI	FJ	FK	FL	FM	FN	FO	FP	FQ	FR	FS	FT	FU	FV	FW	FX	FY	FZ	GA	GB	GC	GD	GE	GF	GG	GH	GI	GJ	GK	GL	GM	GN	GO	GP	GQ	GR	GS	GT	GU	GV	GW	GX	GY	GZ	HA	HB	HC	HD	HE	HF	HG	HH	HI	HJ	HK	HL	HM	HN	HO	HP	HQ	HR	HS	HT	HU	HV	HW	HX	HY	HZ	IA	IB	IC	ID	IE	IF	IG	IH	II	IJ	IK	IL	IM	IN	IO	IP	IQ	IR	IS	IT	IU	IV	IW	IX	IY	IZ	JA	JB	JC	JD	JE	JF	JG	JH	JI	JJ	JK	JL	JM	JN	JO	JP	JQ	JR	JS	JT	JU	JV	JW	JX	JY	JZ	KA	KB	KC	KD	KE	KF	KG	KH	KI	KJ	KK	KL	KM	KN	KO	KP	KQ	KR	KS	KT	KU	KV	KW	KX	KY	KZ	LA	LB	LC	LD	LE	LF	LG	LH	LI	LJ	LK	LL	LM	LN	LO	LP	LQ	LR	LS	LT	LU	LV	LW	LX	LY	LZ	MA	MB	MC	MD	ME	MF	MG	MH	MI	MJ	MK	ML	MM	MN	MO	MP	MQ	MR	MS	MT	MU	MV	MW	MX	MY	MZ	NA	NB	NC	ND	NE	NF	NG	NH	NI	NJ	NK	NL	NM	NN	NO	NP	NQ	NR	NS	NT	NU	NV	NW	NX	NY	NZ	OA	OB	OC	OD	OE	OF	OG	OH
------	------------	-----------------------------	--	--	--	-----------	------	---	---	----	----	
AD	MFR'S SERIAL No.: V-1264	AP DOCUMENT NUMBER EN207122-ANUP-9V3-00020	SHEET NO. 1 OF 1	REV.	DATE	BY	CHK
----	-----------------------------	---	---------------------	------	------	----	-----


MFR'S SERIAL NO. :

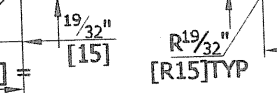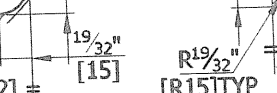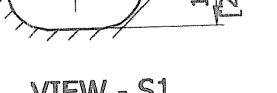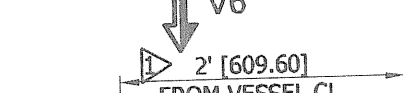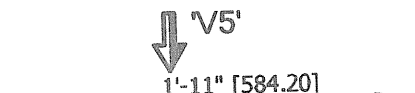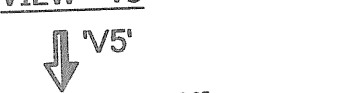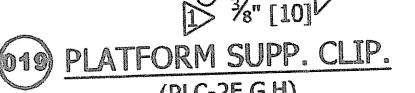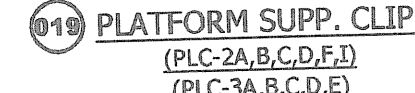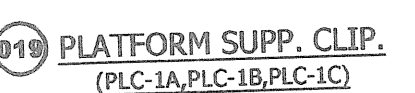


SECTIONAL ELEVATION (LOCATIONAL)

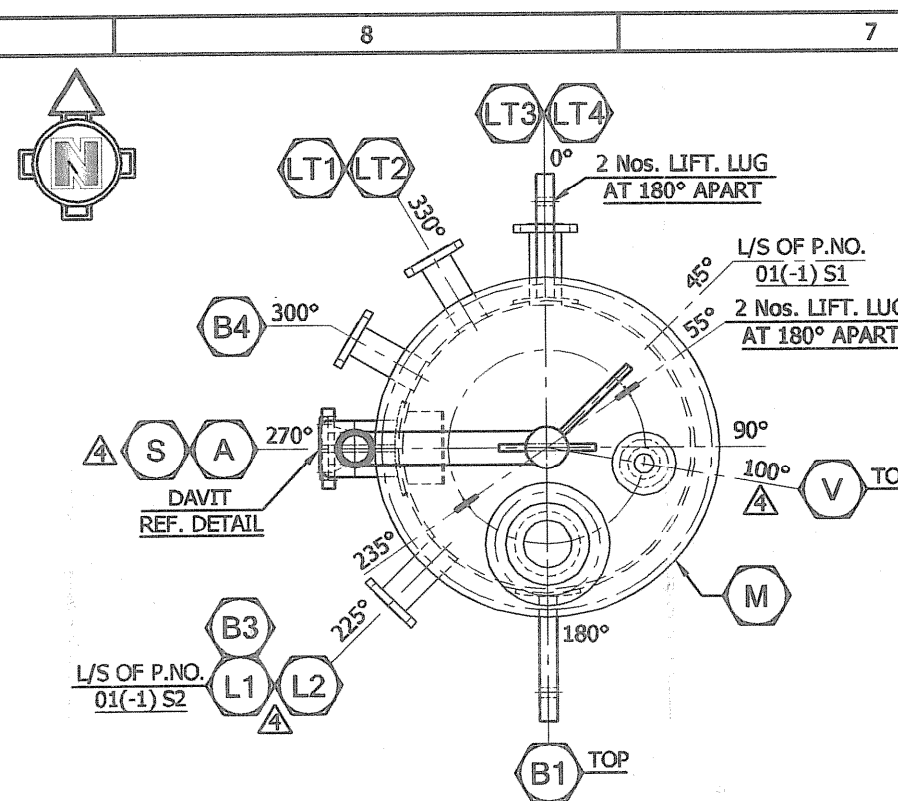


3/2/1 ORIENTATION PLAN VIEW -'A-A'
(FOR MAIN SHELL & TOP HEAD)

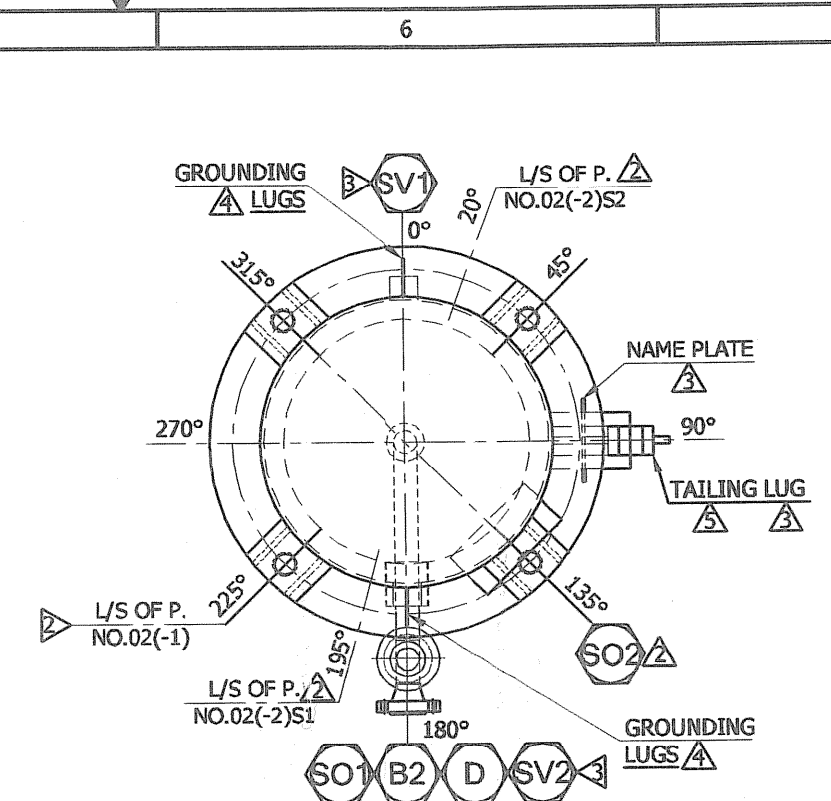


△△ ORIENTATION PLAN VIEW -'A-A'
(FOR SKIRT SHELL & BTM. HEAD)

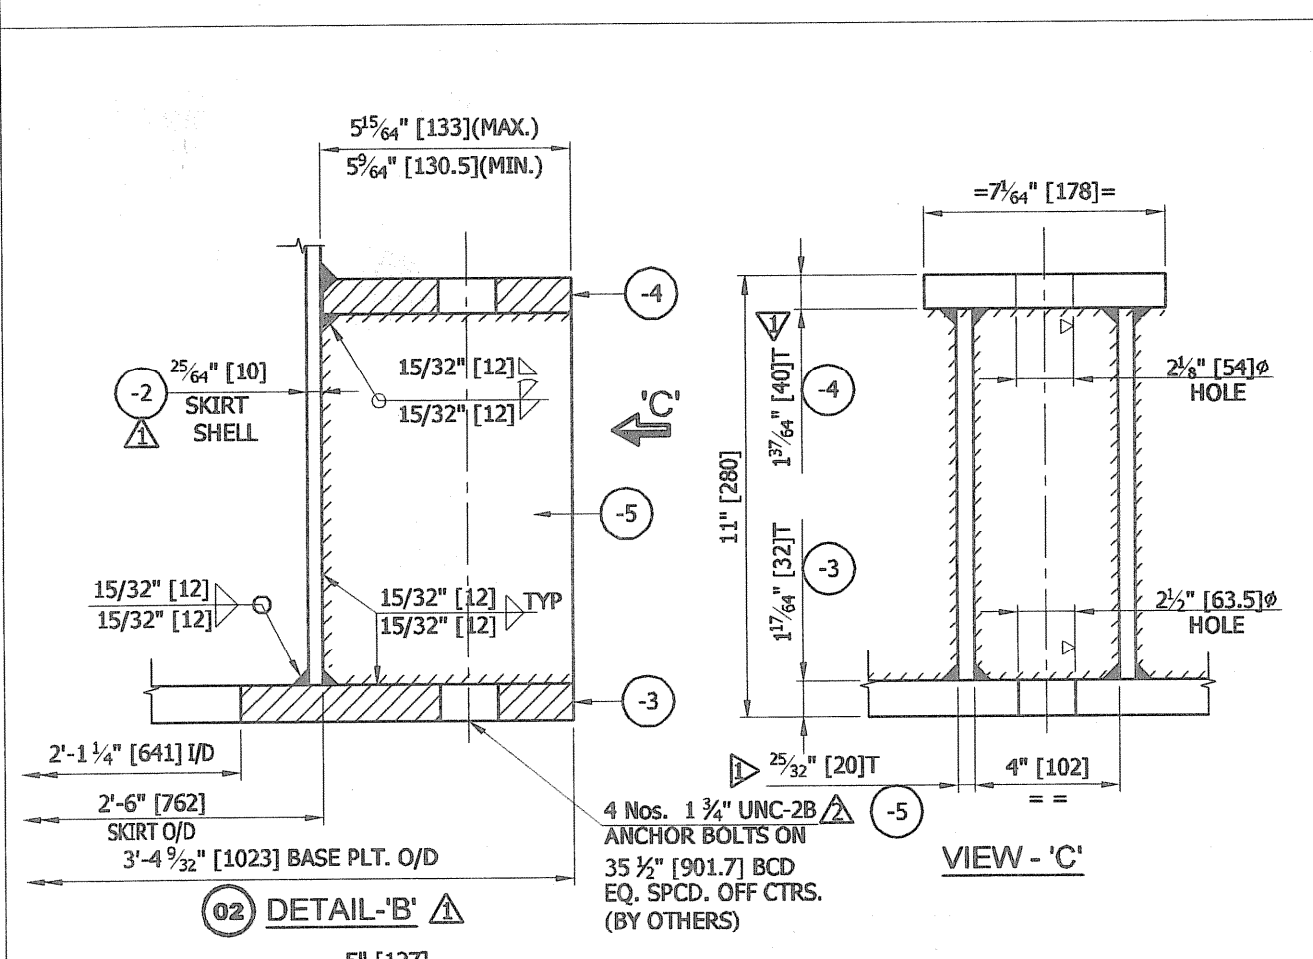


02 DETAIL-'B'

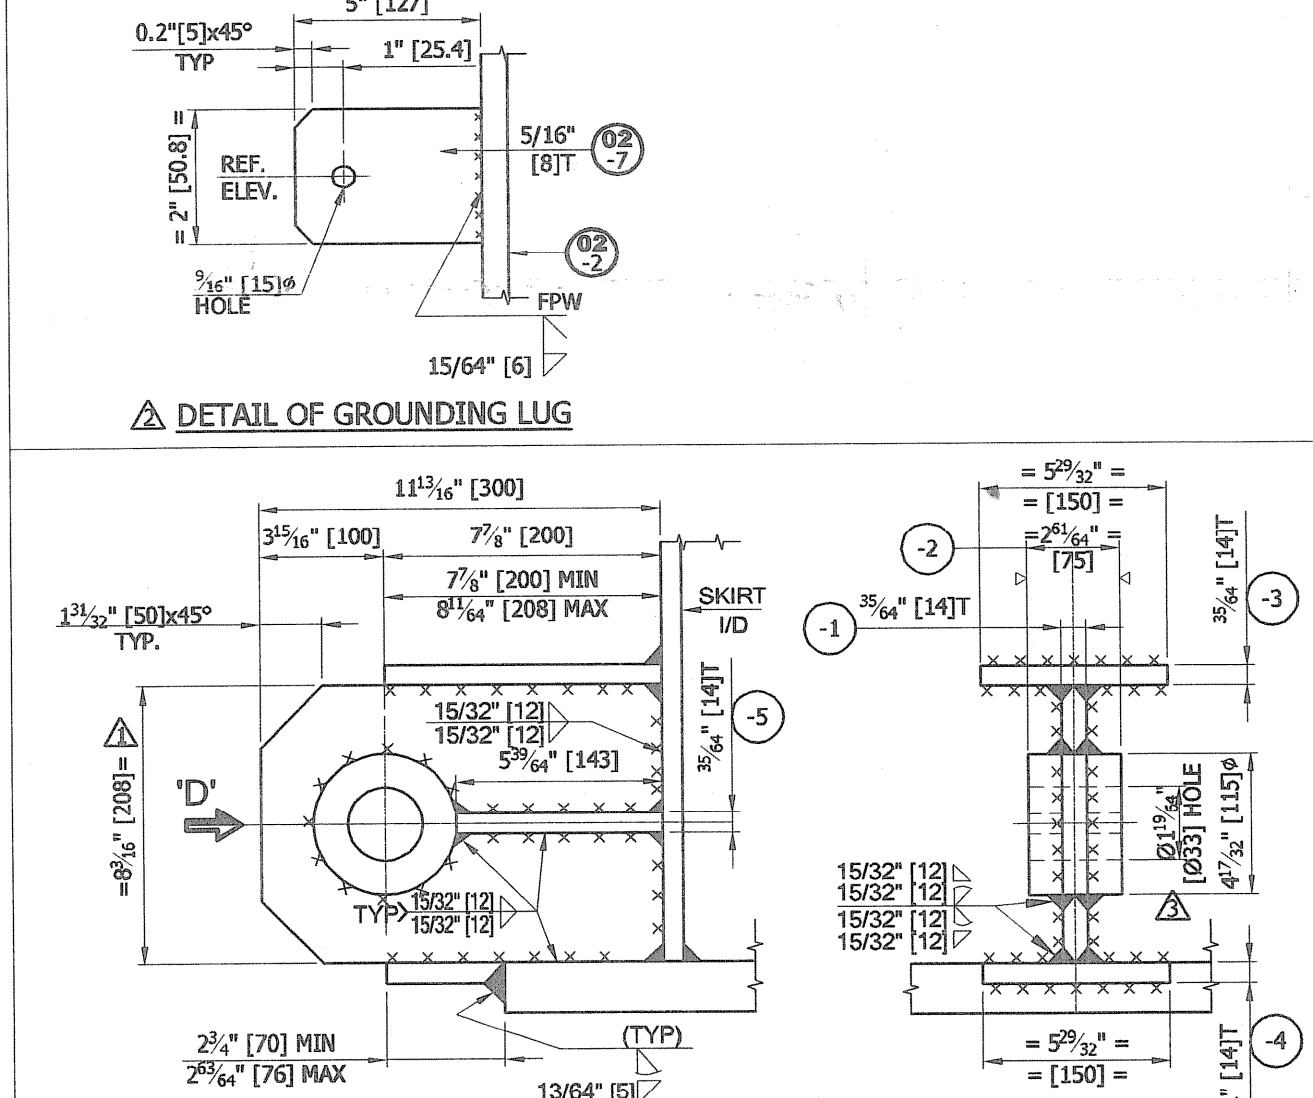


DETAIL OF TAILING LUG 123

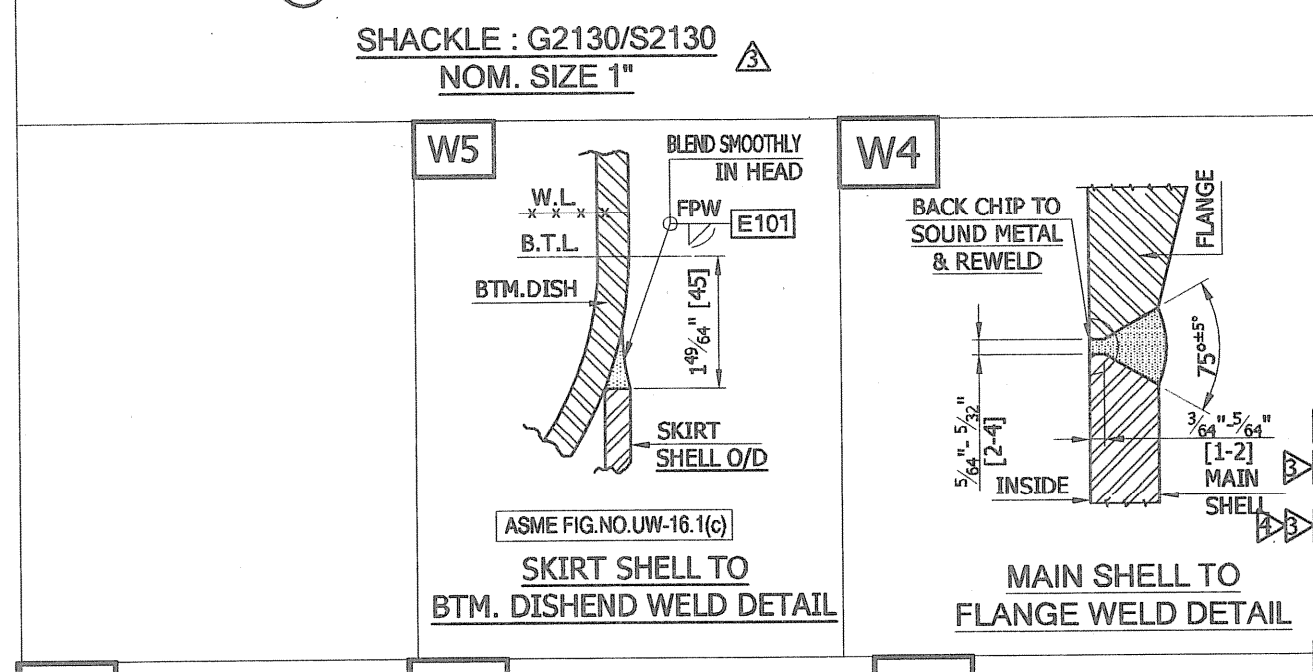

W1

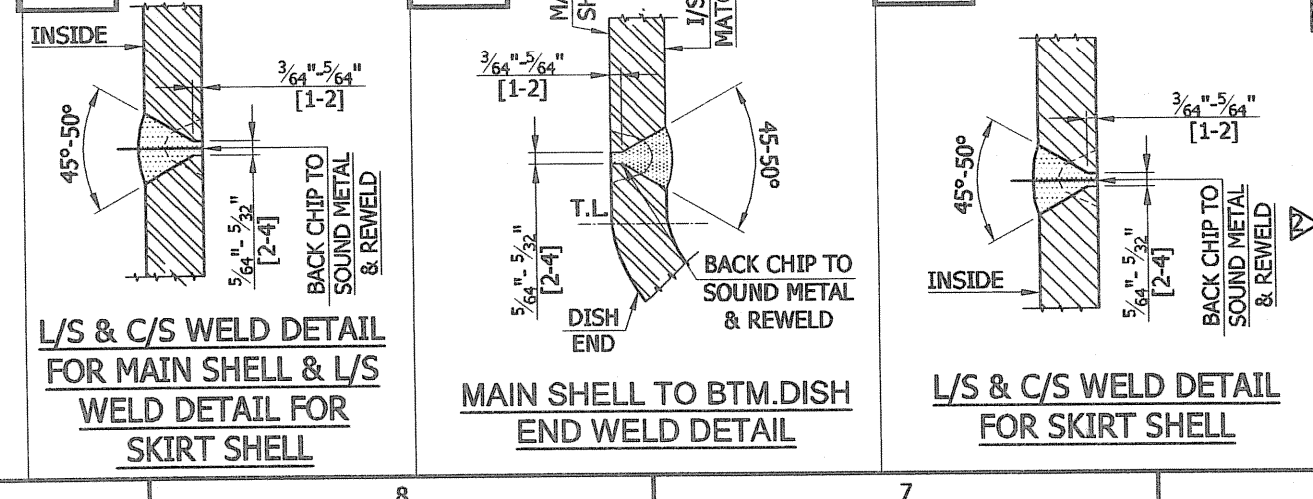

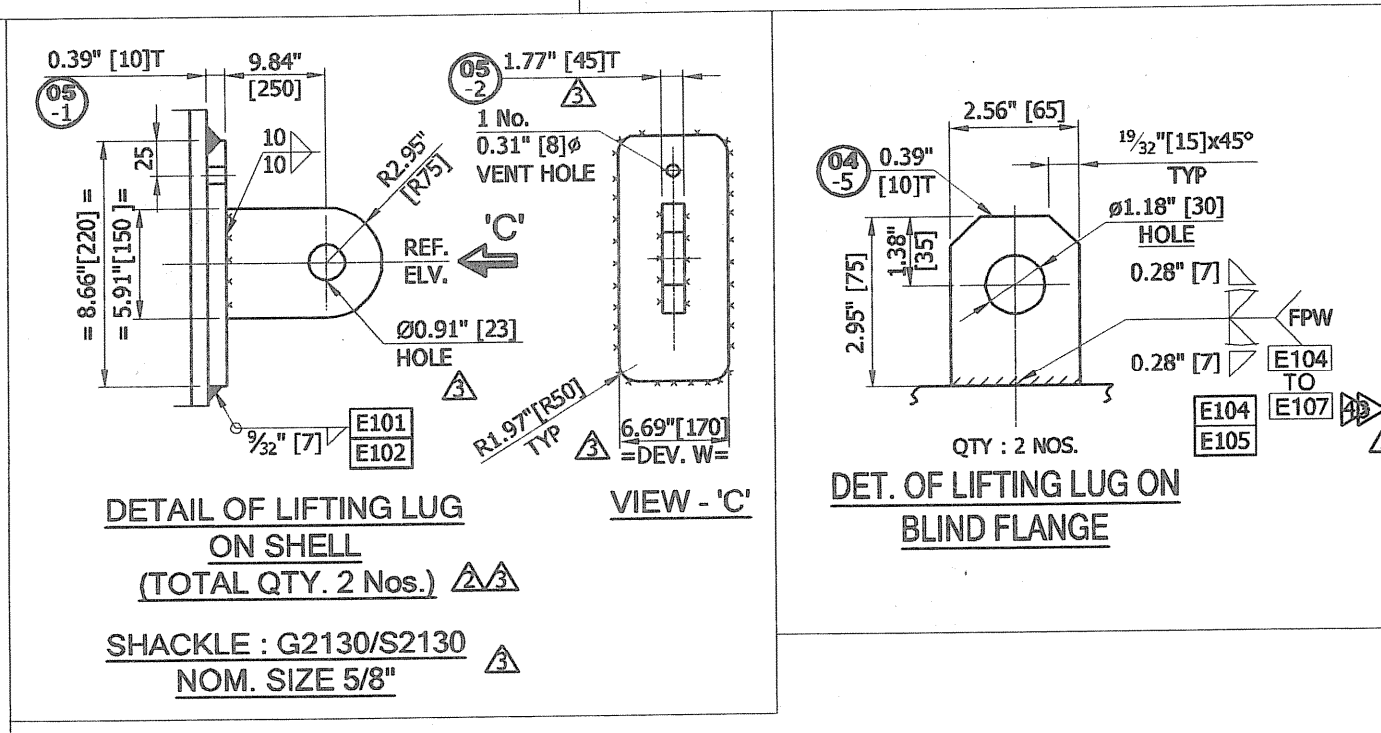

DETAIL OF LIFTING LUG
ON SHELL
(TOTAL QTY. 2 Nos.) 2/3

SHACKLE : G2130/S2130 
NOM. SIZE 5/8"

FOUNDATION LOAD (AT BASE) - ASD CASE		
CONDITION	OPERATING	EMPTY
WIND SHEAR (lbf)	2548	1529
SEISMIC SHEAR (lbf)	5085	3559
WIND MOMENT (ft-lb)	44691	26814
SEISMIC MOMENT (ft-lb)	102252	71577

# 1/4" 1/4" 5/16" SS 316 SPWD GASKET WITH GRAPHITE FILLER AND 1/4" (3.2)T SS 316 INNER & SS OUTER RING. (DIMENSIONS AS PER ASME B 16.20)							
WELD JOINT NO.: A101,A102,C101, B101, B102, E101 TO E105							
					SUB TOTAL OF WEIGHT (Kg)	2260	
3	-2	LIFTING LUG	2	SA 516 GR 70	45T x 150W x 325 LG (REF. DETAIL)	34.4	
3	-1	LIFTING LUG PAD	2	SA 240 GR 316L	10T x 170 DEV.W x 220 LG	5.9	
3	05	LIFTING LUG ASSLY					
2	-5	LIFTING LUG	2	SA 240 GR 316L	10T x 65W x 75 LG	0	
2	-4	STUD WITH 2 NUT	44+5	SA 193 GR B7/SA 194 GR 2H	3/4" UNIC x 185 LG (FULL THRD)	25	
2	-3	GASKET	1+2	#	NPS 30" ASME 150 CL ASME B 16.20		
1	-2	BLIND FLANGE	1	SA 182 F 316L	NPS 30" ASME 150 CL BL RF (rf~70)	340	
1	-1	FLANGE	1	SA 182 F 316L	NPS 30" x BORE 70/2.95 x ASME 150 CL WN RF	800	
3	04	CONN. III ASSLY					
1	-5	RIB PLATE	2	SA 516 GR 70	14T x 30.5W x 143 L	0.96	
1	-4	BTM. SUPPORT PLATE	1	SA 516 GR 70	14T x 150W x 76 L	1.25	
1	-3	TOP SUPPORT PLATE	1	SA 516 GR 70	14T x 150W x 208 L (REF. DETAIL)	3.43	
1	-2	BOSS	1	SA 516 GR 70	6115 x 75 (FINISH SIZE)	6	
1	-1	PLATE FOR TAILING LUG	1	SA 516 GR 70	14T x 208W x 300 L	7	
3	03	TAILING LUG ASSLY					
2	-7	EARTHING LUG	2	SS 304	8T x 50.8W x 127 LG	0.62	
3	-6	DELETED					
1	-5	SUPPORT RIB	8	SA 516 GR 70	20T x 132 W x 208 LG	35	
1	-4	TOP PLATE	4	SA 516 GR 70	40T x 133W x 178 LG	30	
3	-3	BASE PLATE RING	1	SA 516 GR 70	32T x 1023 O/D x 641 T/D	126	
2	-2	BTM SKIRT SHELL	1	SA 516 GR 70	10T x 4155W x 2366 DEV. LG.	771	
2	-1	TOP SKIRT SHELL	1	SA 240 GR 316L	10T x 950W x 2366 DEV. LG.	180	
3	02	SKIRT SHELL ASSLY					
2	-BTM DISHED END		1	SA 240 GR 316L	10T(NOM.) x 985 B.DIA	62	
1	-1	MAIN SHELL	1	SA 240 GR 316L	10T x 2898W x 2366 DEVL	551	
3	01	MAIN SHELL ASSLY					
REV. SR	DESCRIPTION		QTY/	MATERIAL	SIZE	WT. (kg)	REMARKS

PLOT NO.		BILL OF MATERIAL												DATE	
SV1-SV2	2	2.5(5%)	40	0.2 ⁵ [5.6]	-	-	-	-	SKIRT VENT				-	-	-
SO2	1	10 ¹ (250)	40	0.36 ⁹ [9.27]	-	-	-	-	SKIRT INSPECTION OPENING				-	-	-
SO1	1	4 ¹ (100)	40	0.24 ⁶ [6.02]	-	-	-	-	SKIRT OPENING FOR NOZZLE 'B2'				-	-	-
▽ DELETED														-	-
L1/L2, L1/L3, L1/L4	4	50.8 I/D (2" I/D)	-	0.6 ⁶ [16.57]	300	LWN	RF	LEVEL TRANSMITTER (18-L1-D272A/B) (L LEVEL TRIP)				1'-11" [585]	-	-	
L1/L2	2	50.8 I/D (2" I/D)	-	0.6 ⁶ [16.57]	600	LWN	RF	LEVEL GAUGE (18-L1-D272C)				1'-11" [585]	-	-	
M	1	300(75)	-	0.39 ¹ [10]	150	WVN	RF	MAN WAY W/ BLIND & DAVIT				SEE DRG.	-	ASME SEC VIII	
S	1	50.8 I/D (2" I/D)	-	0.6 ⁶ [16.57]	600	LWN	RF	STEAM OUT				1'-11" [585]	-	-	
D	1	2(50)	80S	0.22 ⁵ [5.51]	600	WVN	RF	DRAIN				SEE DRG.	-	-	
V	1	50.8 I/D (2" I/D)	-	0.6 ⁶ [16.57]	300	LWN	RF	VENT				SEE DRG.	-	-	
DELETED														-	-
B4	1	50.8 I/D (2" I/D)	-	0.6 ⁶ [16.57]	600	LWN	RF	FUTURE PUMP MINIMUM FLOW W/ BLIND				1'-11" [585]	-	BLIND	
B3	1	50.8 I/D (2" I/D)	-	0.6 ⁶ [16.57]	600	LWN	RF	SPARE NOZZLE				1'-11" [585]	-	FOR BREF	
B2	1	2(50)	80S	0.22 ⁵ [5.51]	600	WVN	RF	LIQUID OUTLET				SEE DRG.	-	FOR BREF	
B1	1	6(150)	XXS	0.06 ² [1.52]	300	WVN	RF	VAPOR OUTLET				SEE DRG.	-	-	
A	1	3(80)	XXS	0.04 ¹ [1.52]	600	WVN	RF	FEED INLET				1'-11" [585]	DELETED	BLIND	
MARK	QTY.	SIZE NPS(DN)	SCH.	THK.	CLASS	TYPE	FACE	SERVICE				PROJ. FROM CL.	RF PAD T X	REM	
					PIPE	ASME B16.5, B16.47, B FLANGE				△					
NOZZLES AND CONNECTIONS															
6				5				4							

DESIGN DATA		
1	CONSTRUCTION CODE	ASME SECTION VIII DIV.1, EDITION 2019
2	ASME 'U' STAMP REQUIREMENT	YES
3	NATIONAL BOARD REGISTRATION	YES
4	HYDROGEN SERVICE	NO
5	CYCCLIC SERVICE	NO
6	SOUR SERVICE	YES
7	FLUID CIRCULATED / SERVICE	H2S
8	MAWP / MAEWP	Psig [kg/cm²] 150 [10.5461] (LIMITED BY NOZZ. M BLD. / FLG.) / 15
9	MAP (GOVERNING COMPONENT)	Psig [kg/cm²] 230 [16.1706] (LIMITED BY NOZZ. M BLD. / FLG.)
10	DESIGN PRESSURE (INT./EXT.)	Psig [kg/cm²] 105 [7.3821] / FV
11	DESIGN TEMPERATURE (INT./EXT.)	°F (°C) 500 (260) / 300 (149)
12	OPERATING PRESSURE	Psig [kg/cm²] 10 [0.703]
13	OPERATING TEMPERATURE	°F (°C) 105 (40.5)
14	MDMT @ MAWP	°F (°C) 32 (0.0)
15	MDMT @ MAWP	°F (°C) 32 (0.0)
16	LOWEST ALLOWABLE MDMT @ MAWP	°F (°C) 32 (0.0)
17	SHOP HYDRO TEST PRESSURE BASED ON WP CALCULATED UG-99(c) (HORIZONTAL)	Psig [kg/cm²] 312.913[222]
18	SITE HYDRO TEST PRESSURE BASED ON UG-99(b)	Psig [kg/cm²] 220.034[15.469]
19	CORROSION ALLOWANCE (VESSEL) (INTERNAL)	in (mm) 1/2(0.8)
20	RADIOGRAPHY (SHELL / DISH)	100%/100%
21	WELD JOINT EFFICIENCY (SHELL/DISH)	1.0 / 1.0
22	POST WELD HEAT TREATMENT	EXEMPTED AS PER UHA-32
23	POST FORMING HEAT TREATMENT	EXEMPTED AS PER UHA-44
24	IMPACT TEST REQUIREMENT	N/A
25	INSULATION (TYPE / THK.)	in (mm) NONE
26	FIRE PROOFING THK. (ON SKIRT)	in (mm) NONE
27	WIND DESIGN AS PER	ASCE 7-16 EXP CATEGORY C RISK CATEGORY III KZT = 1
28	BASIC WIND SPEED	mph 101
29	SEISMIC DESIGN AS PER	ASCE 7-16 IMPORTANCE FACTOR, I=1.25 SITE CLASS D, S _{ss} =1.616, S ₁ =0.689, F _a =1.0F _v =1.71, S _{ds} =1.077, S _{d1} =0.996, R=3
30	CAPACITY	in³ 83836
31	FLUID GRAVITY (LIQUID)	0.99 @ 105°F
32	PAINTING / CLEANING	AS PER ABQM-PP-00-500520-A
33	INSPECTION BY	ANUPUR / AP / NI
34	WEIGHT	EMPTY WEIGHT ~lb(kg) ~5976 [2711] OPERATING WEIGHT ~lb(kg) ~11331 [5140] HYDRO TEST WEIGHT AT SHOP ~lb(kg) ~9032 [4097]

MATERIAL OF CONSTRUCTION	
SHELL / DISH END	SA 240 GR 316L
SKIRT	SA 240 GR 316L / SA 516 GR 70
BASE PLATE & CHAIRS	SA 516 GR 70
NOZZLE NECKS & PIPE	SA 240 GR 316L/ SA 312 GR 316L
FLANGES (EXTERNAL)	SA 182 F 316L
FITTINGS	SA 403 WP 316L
BOLTS (EXTERNAL)	SA 193 GR B7M / SA 194 GR 2H4
INTERNALS (FIXED)	SS 316L
ANCHOR BOLTS	ASTM F1554 GR 36 (BY OTHER)
* 4.2 SS 316 SPWD GASKET WITH GRAPHITE FILLER, AND 3.2T SS 316 INNER & SS OUTER RING. (DIMENSIONS AS PER ASME B 16.20)	

NOZZLE LOADING DATA		FR	MT	MC	FL
NOZZLE MARK	SIZE NPS(IN)	FL (lb)	FR (lb)	MC (lb-ft-in)	FL (lb)
*B1	6"(150)	1600	1200	1600	2100
*B2, B3, B4, B5	2"(50)	630	470	630	210
A	8"(200)	810	610	810	620

FOR HEAD NOZZLE RESULTANT: (YML2+MCL2) AND RESULTANT (YML2+FC2)

*NOZZLE LOADS ARE PER TABLE 5, ABQM-PP-000-50801-A FOR 300 CLASS FLANGE RATING

*NOZZLE LOADS ARE PER TABLE 5, ABQM-PP-000-50801-A FOR 150 CLASS FLANGE RATING



 THE ANUP ENGG. LTD. INCORPORATED IN INDIA	AS BUILT DRAWING		Reviewed  27/11/23 AI
EN207122-ANUP-9V3-00046	V-1264-TRANS-2021	1 OF 1	TRANSPORTATION DRAWING
EN207122-ANUP-9V3-00020	V-1264-FAD-2021	1 OF 1	EXTERNAL ATTACHMENT DRAWING
EN207122-ANUP-9V3-00073	V-1264-FAD-2021	4 OF 4	SKIRT TEMPLATE DRAWING
EN207122-ANUP-9V3-00028	V-1264-FAD-2021	3 OF 4	NAME PLATE AND GENERAL NOTES DETAILS DRAWING
EN207122-ANUP-9V3-00068	V-1264-FAD-2021	2 OF 4	DETAIL FABRICATION DRAWINGS

AP DOC. NO.		DRG.NO.	SHT.No.	DESCRIPTION	REV.		
REFERENCE DRAWING							
RK	6	23-01-2023	AS BUILT DRAWING		GML	AAS	BMP
	5	30-11-2022	DRAWING REVISED AS MARKED 		SBAL	AAS	BMP
	4	17-09-2022	DRAWING REVISED AS PER CLIENT COMMENT AS MARK. 		VAP	AAS	BMP
	3	20-04-2022	DRAWING REVISED AS PER CLIENT COMMENT AS MARK. 		VAP	KRK	BMP
	2	01-01-2022	DRAWING REVISED AS PER CLIENT COMMENT AS MARK. 		VAP	KRK	BMP
	1	14-10-2021	DRAWING REVISED AS PER CLIENT COMMENT AS MARK. 		VAP	KRK	BMP
	0	29-07-2021	ISSUED FOR APPROVAL		VAP	-	BMP
REV. NO.	DATE		DESCRIPTION		BY	CHD.	APPD.

	REVISIONS	
EQUIPMENT OWNER	Air Products Manufacturing LLC	
ENGINEERING & PROJECT MANAGEMENT		
06.7 98	CONTRACT NO :	

		THE ANUP ENGINEERING LTD. AHMEDABAD										
IND	CLIENT:- WORLD ENERGY PARAMOUNT PARAMOUNT, CA										SHEET NO: 1 OF 4 DRG. NO: V-1264-FAD-2021	REV: 6
	P.O.NO. : 4505426369 DATE 09.07.2021											
TECH SKER	DRL. VAP		<u>18-D-272 ARG2 AMINE REGEN REFLUX DRUM</u> <u>H2S RECOVERY UNIT</u>							ITEM NO. 18-D-272		
	CHD. IGKH											
BOX	APPD. BMP											
	DATE 29-07-2021									QTY ONE		
MARK	SCALE 1 : 19		<u>GENERAL ARRANGEMENT DRAWING</u>									
	NFR'S SERIAL NO. V-1264		AP DOCUMENT NUMBER EN207122-ANUP-9V3-00007				SHEET NO. 1 OF 4		REV. 6		A1	
3		2				1						
ANUP GENERAL NO. : 32												

A vertical number line with points labeled C, D, E, and F. Point D is marked with a triangle and is the midpoint between C and E. Point E is the midpoint between D and F. The segments are labeled with their lengths: CD = 10, DE = 15, and EF = 20.

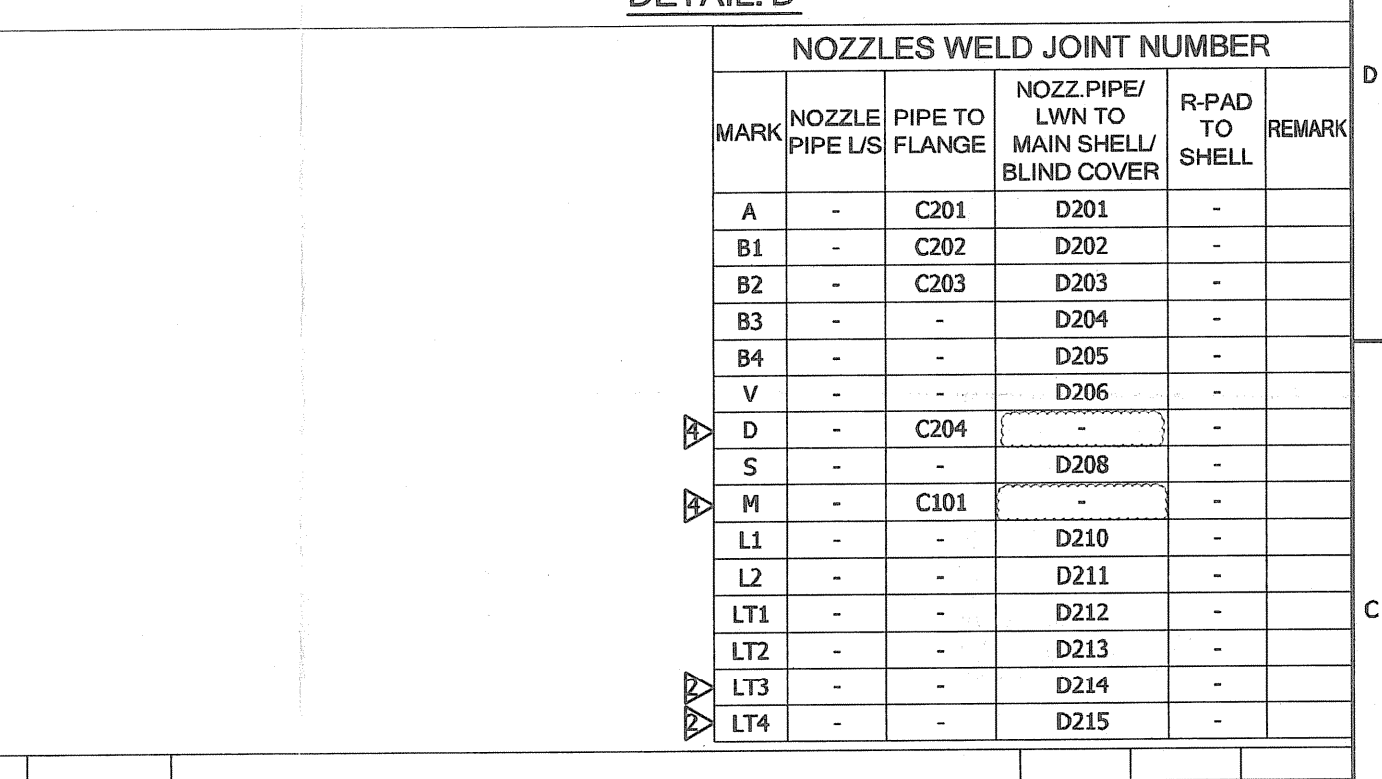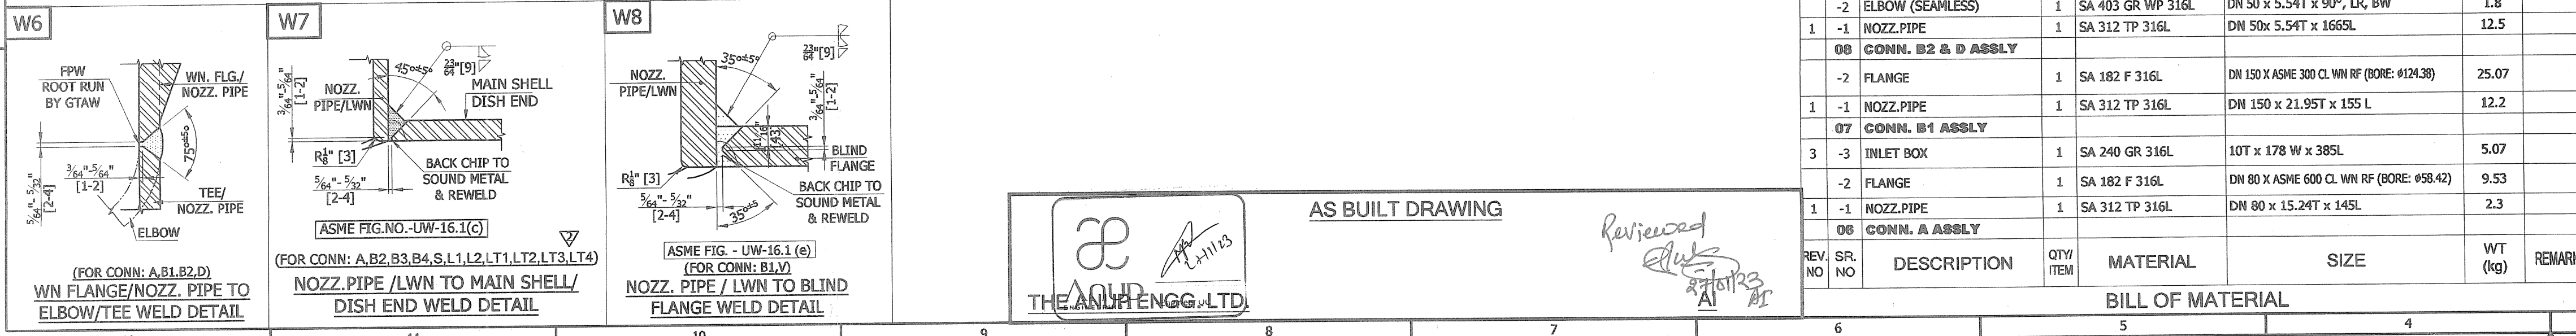


EQUIPMENT OWNER		REVISIONS	

AIR PRODUCTS 


CLIENT:- WORLD ENERGY PARAMOUNT PARAMOUNT, CA		SHEET NO: 2 OF 4		REV: 4
D.NO. : 4505426369 DATE 09.07.2021		DRG. NO: V-1264-FAD-2021		

VAP	<u>18-D-272 ARG2 AMINE REGEN REFLUX DRUM</u>				<u>ITEM NO</u>	
ID.	KRK					<u>18-D-272</u>
PD.	DKB	<u>H2S RECOVERY UNIT</u>				
ITE	20-10-2021	<u>NOZZLES DETAILS DRAWING</u>				<u>QTY</u>
SALE	1 : 19					<u>ONE</u>
SHEET NO. NO.		AP DOCUMENT NUMBER		SHEET NO.	REV.	A1
V-1264		EN207122-ANUP-9V3-00068		2 OF 4	4	
3		2		1		

THIS DRAWING MUST NOT WITHOUT OUR CONSENT BE SHOWN TO ANY PERSON OUTSIDE THE RECIPIENT EMPLOY OR BE COPIED OR USED FOR THE PURPOSE OF MANUFACTURING ANY ARTICLE SHOWN IN THE DRAWING AND THE COPYRIGHT IN THE DRAWING SHALL BE AND REMAIN OUR SOLE PROPERTY. THIS DRAWING TOGETHER WITH ANY COPIES MADE BY THE RECIPIENT SHALL BE RETURNED ON DEMAND TO US.

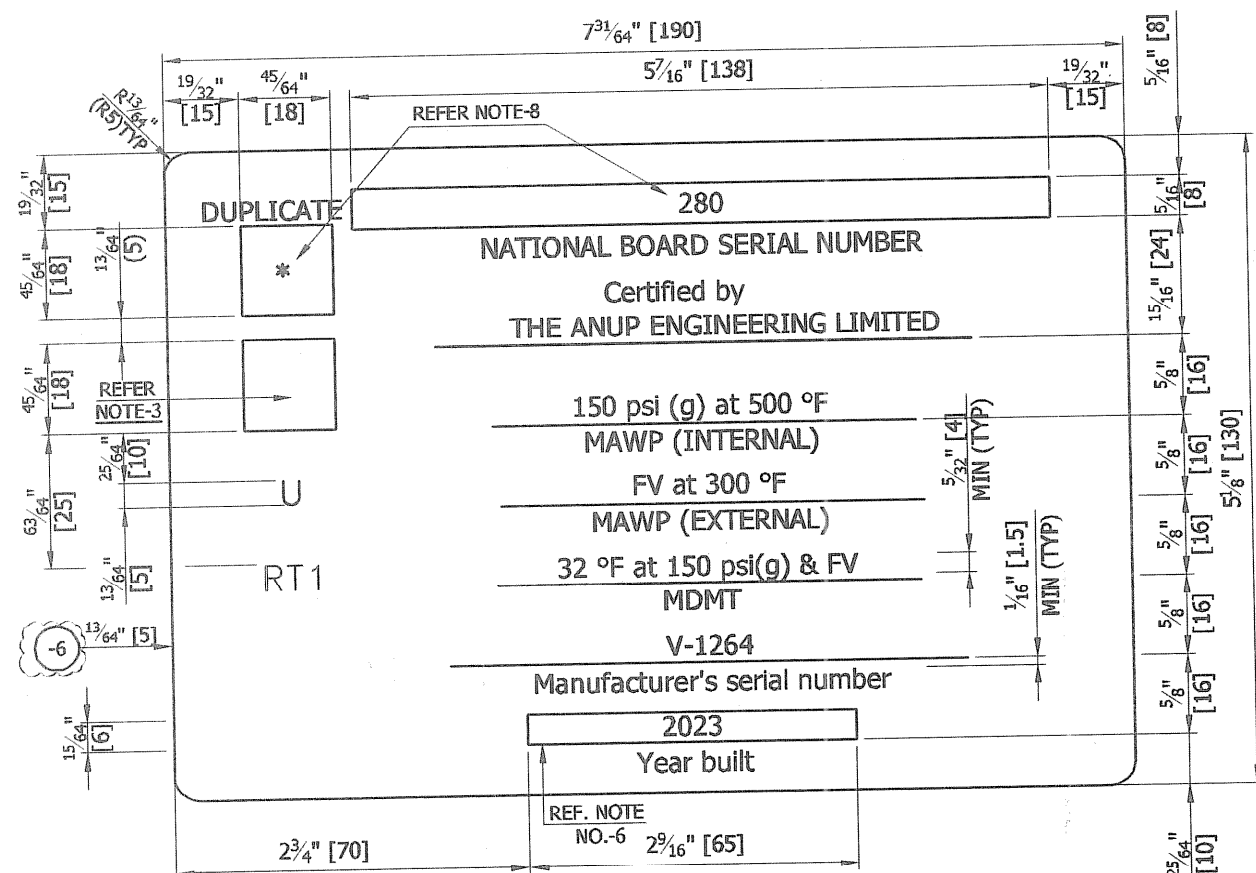


- NOTES:-
- 1) ALL DIMENSIONS ARE IN mm UNLESS OTHERWISE SHOWN.
 - 2) HEIGHT OF CHARACTERS SHALL BE AT LEAST 4 mm & SHALL BE ENGRAVED IN A BLACK ENAMELED BACKGROUND.
 - 3) CERTIFICATION MARK (N) TO BE HARD STAMPED IN PRESENCE OF AI AFTER OBTAINING HIS AUTHORIZATION.
 - 4) NAME PLATE SHALL BE RIVETED TO BRACKET AS PER DRAWING.
 - 5) BRACKET WITH NAME PLATE TO BE LOCATED AS MARKED IN DRG.
 - 6) YEAR BUILT SHALL CORRESPOND TO DATE OF HYDROSTATIC TESTING & SHALL BE HARD PUNCHED AFTER SUCCESSFUL COMPLETION OF HYDRO TEST.
 - 7) ALL HARD STAMPED FACE (BLOCK) SHALL BE RAISED FACE.
 - 8) NATIONAL BOARD SYMBOL AND NATIONAL BOARD SERIAL NUMBER AS ADVISED BY HEAD-QUALITY SHALL BE HARD STAMPED IN PRESENCE OF AI AFTER OBTAINING HIS AUTHORIZATION.
 - 9) DELETED

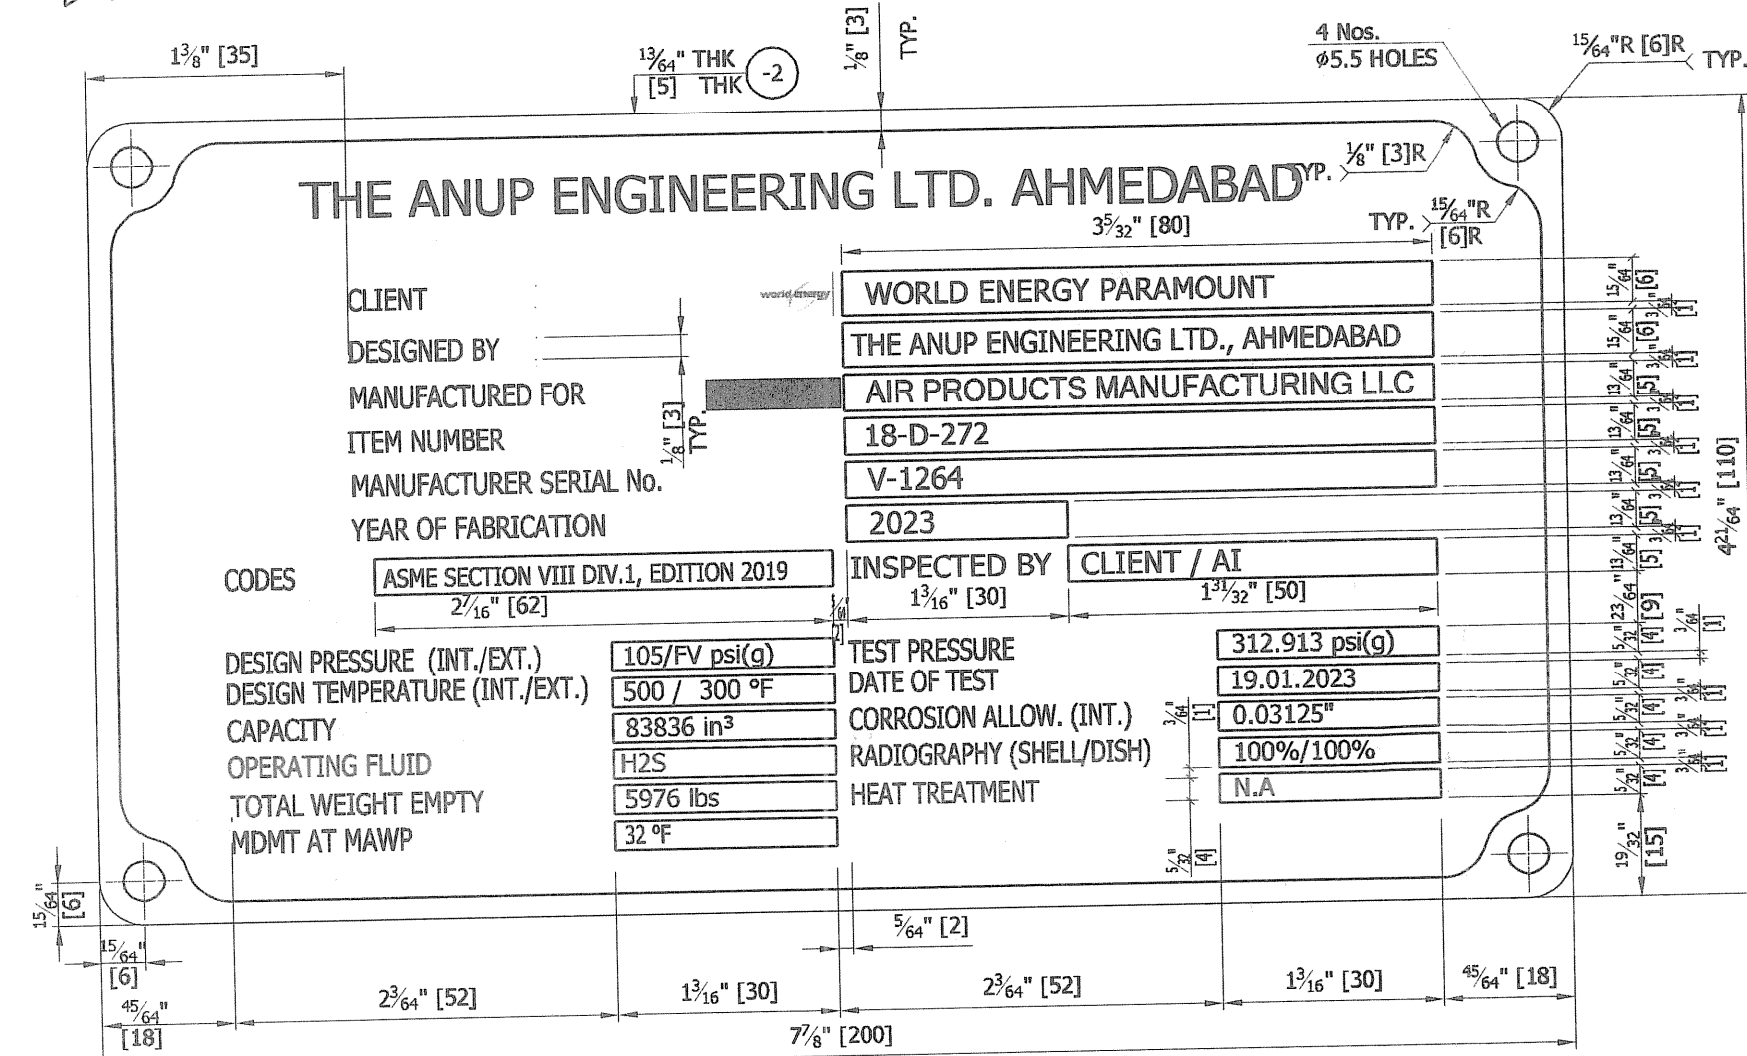

- NOTES:-
- 1) ALL LETTERS, BLOCKS AND BORDER SHALL BE OF RAISED POLISHED FACE.
 - 2) BACK GROUND SHALL BE BLACK.
 - 3) NAME PL. SHALL BE TACK WELDED TO THE BRACKET WHERE NOT POSSIBLE IT MAY BE RIVETED.
 - 4) **TO BE FILLED AFTER HYDROTEST OF EQUIPMENT.

DETAIL OF NAME PL. BRACKET

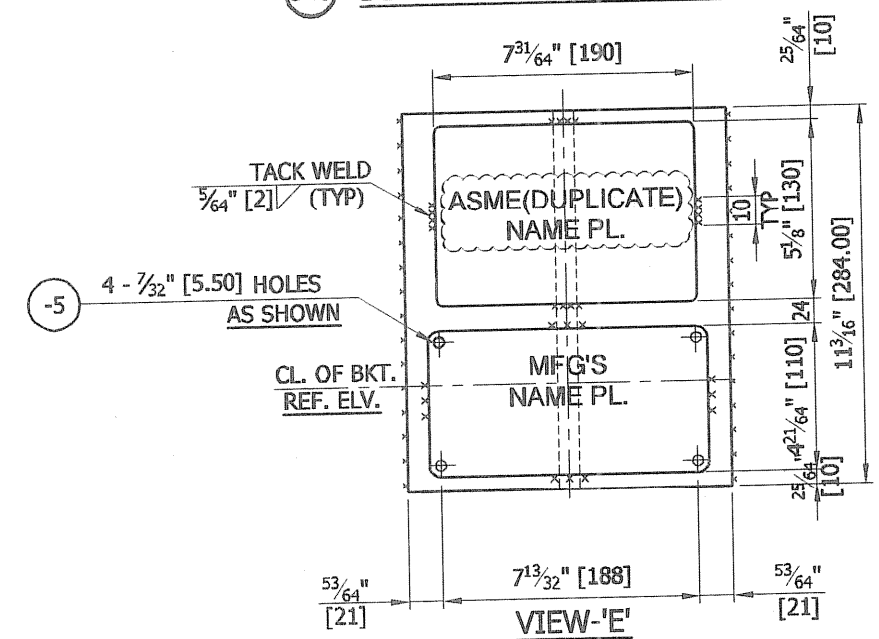

NOTE:
UNDERCUTTING OF SHELL SHALL BE AVOIDED WHEN WELDING BRACKET TO THE VESSEL


GENERAL NOTES:-

- DESIGN**
1. MECHANICAL DESIGN CALCULATION SHALL BE AS PER ASME SEC.VIII-DIV.1 ED. 2019.
 2. CORROSION ALLOWANCE IS 1/16" (0.8) MM
 3. LIFTING LUGS ARE DESIGNED AS PER ASME BTH-1 AND DESIGN CATEGORY B - SERVICE CLASS 0
- MATERIAL**
1. ALL SS PLATES SHALL BE IN FULLY ANNEALED AND PICKLED CONDITION.
 2. ALL FORGING MATERIAL SHALL BE SUPPLIED IN SOLUTION ANNEALED AND QUENCHED CONDITION.
 3. MATERIAL CERTIFICATION SHALL BE AS FOLLOWS
 - a. PRESSURE PARTS: EN 10204 TYPE 3.1 CERTIFICATE FOR AIRPRODUCTS APPROVED COUNTRIES AND TYPE 3.2 FOR NON APPROVED COUNTRIES.
 - b. NON PRESSURE PARTS (DIRECTLY WELDED TO PRESSURE PARTS): EN 10204 TYPE 3.1 CERTIFICATE FOR AIRPRODUCTS APPROVED COUNTRIES AND TYPE 3.2 FOR NON APPROVED COUNTRIES.
 4. POSITIVE MATERIAL IDENTIFICATION (PMI) TO BE PERFORMED FOR ALL PRESSURE CONTAINING COMPONENTS COMPONENTS IN ACCORDANCE WITH ASME-PP-000-500512-A.
 5. ALL NOZZLE FLANGES ARE AS PER ASME B 16.5-2017 FOR SIZES DN 600 (NPS 24) & BELOW AND AS PER ASME B 16.47-2017 FOR SIZES DN 600 (NPS 24).
 6. FLANGE FACING TO BE IN ACCORDANCE WITH ASME B 16.5 SURFACE FINISH: ROUGHNESS Ra 3.2 TO 6.3 µm (Ra 125 TO 250 µin).
 7. SPARE QUANTITY
 - a. MANDATORY SPARE
 - i. GASKET: 200%
 - ii. FASTENERS: 10 % (MIN. 2)
 8. ALL PRESSURE PARTS MATERIAL SHALL MEET THE REQUIREMENT OF TPS NO. LISTED BELOW.


SRL.NO.	MATERIAL	TPS. NO.
1	SA-240 GR 316L	V-1264-68_SA240_TP316L_PL-REV-0
2	SA-182 F316L	V-1264-70_SA182_F316L_STDFORG-REV-0
3	SA-403 WP 316L	V-1264-70_SA403_GRPWP316L-REV-01
4	SA-193 GR B7M	V-1264-70_SA193B7M_STUDS-REV-0
5	SA-194 GR 2HM	V-1264-70_SA1942HM_NUTS-REV-0

9. EXTERNAL SURFACE PREPARATION AND PAINTING SHALL BE AS PER ASME-PP-000-500520-A AND APPROVED PROCEDURE PAINTING PROCEDURE (EN207122-ANUP-9V3-00015)
- FABRICATION**
1. ALL DIMENSIONS ARE IN ft-in (mm) UNLESS NOTED OTHERWISE.
 2. ALL THICKNESSES SPECIFIED ON THE DRAWING ARE MINIMUM AFTER FORMING AND MACHINING.
 3. ROLLING OF PLATES SHALL BE IN LONGITUDINAL DIRECTION OF PLATES.
 4. ALL SHARP EDGES AND CORNERS SHALL BE ROUNDED OFF TO SMOOTH RADIUS.
 5. RAW MATERIAL IDENTIFICATION SHALL BE CARRIED OUT AS PER APPROVED QAP.
 6. WELDING TO BE DONE AS PER THE ASME-PP-000-500530-A APPROVED WELDING PROCEDURE AND WELD TEST PLAN.
 7. ALL BOLT HOLES OF THE NOZZLE FLANGE SHALL STRADDLE CENTERLINE OF THE EQUIPMENT.
 8. ALL MACHINED SURFACES, SUCH AS FLANGE FACES, THREADED BOLT HOLES, THREADS, ETC. SHALL BE PROTECTED DURING THE HEAT TREATMENT.
 9. ALL ATTACHMENTS DIRECTLY WELDED TO PRESSURE PARTS OF EQUIPMENT SHALL BE OF SAME MATERIAL AS THAT OF PRESSURE PART.
 10. NOZZLES SHALL BE LOCATED SO THAT THE NOZZLE, NOZZLE TO VESSEL WELD, AND NOZZLE REINFORCEMENT ARE AT LEAST 2" (50 MM) FROM ALL PRESSURE CONTAINING SHELL AND HEAD WELDS. IF INTERSECTING OR COVERING PRESSURE CONTAINING WELDS CANNOT BE AVOIDED, THE NOZZLE SHALL BE FULLY REINFORCED AND LOW STRESS WELDING DETAILS USED (E.G., GRIND FILLETS TO A SMOOTH CONCAVE RADIUS). PRESSURE CONTAINING WELDS BEHIND REINFORCEMENT SHALL BE 100 PERCENT RADIOGRAPHED AFTER FORMING AND NOZZLE INSTALLATION BUT BEFORE REINFORCING PAD INSTALLATION TO A MINIMUM OF 6 INCHES (150 MM) BEYOND THE NOZZLE TO VESSEL WELD OR THE LIMITS OF THE GASKET SEATING SURFACES OF SHELL BODY FLANGES SHALL BE IN ACCORDANCE WITH THE GASKET MANUFACTURER'S RECOMMENDATIONS OR THE TOLERANCE INDICATED IN ASME PCC-1 APPENDIX D, WHICHEVER IS MORE STRINGENT. FLATNESS CHECK SHALL BE PERFORMED AFTER COMPLETING ALL WELDS.
 12. VESSEL TOLERANCES SHALL BE AS PER ASME-PP-000-500801-A
- INSPECTION AND TESTING**
1. ALL PRESSURE BEARING BUTT WELD JOINTS SHALL BE 100% RT AS PER UW-11(a).
 2. 100 % HT/PT SHALL BE PERFORMED FOR ALL WELDS.
 3. WELDS JOINING NON-PRESSURE CONTAINING COMPONENTS TO PRESSURE CONTAINING COMPONENTS SHALL BE 100% LIQUID PENETRANT OR MAGNETIC PARTICLE EXAMINED (AFTER PWHT, WHEN PWHT IS REQUIRED). THIS APPLIES TO PERMANENT AND NON-PERMANENT (E.G., LIFTING LUGS, TRUNIONS, ETC.) ATTACHMENTS ON THE INSIDE AND OUTSIDE OF THE VESSEL.
 4. WHEN TEMPORARY ATTACHMENTS ARE REMOVED, THE AREA SHALL BE GROUND FLUSH WITH THE SURROUNDING SHELL SURFACE AND LIQUID PENETRANT OR MAGNETIC PARTICLE EXAMINED.
 5. APPLICABLE NDE AND INSPECTION SHALL BE AS PER APPROVED PROCEDURES
 6. ALL TEMPORARY ATTACHMENTS SHALL BE REMOVED BEFORE HYDROSTATIC TESTING.
 7. TEMPORARY ATTACHMENTS SHALL BE REMOVED FLUSH WITH THE VESSEL SHELL AND NONDESTRUCTIVELY EXAMINED (I.E., MAGNETIC PARTICLE EXAMINATION OR DYE PENETRANT EXAMINATION (PT)), IN ADDITION TO VISUAL EXAMINATION, TO ENSURE NO CRACKS HAVE BEEN GENERATED.
- HYDRO TEST**
1. DELETED.
 2. PRESSURE TESTING SHALL BE COMPLETED BEFORE PRIMERS, PAINT, OR OTHER COATINGS ARE APPLIED.
 3. THE HYDROSTATIC TEST MEDIUM SHALL BE CLEAN, FRESH, POTABLE WATER.
 4. THE WELDS OF WELDED ATTACHMENTS PROVIDED WITH VENT HOLES (E.G., REINFORCING PADS, SLIPON FLANGES) SHALL BE LEAK TESTED USING 15PSIG (1 KG/CM2 (G)) PNEUMATIC PRESSURE AND A BUBBLE FORMING SOLUTION PRIOR TO POSTWELD HEAT TREATMENT AND FINAL HYDROSTATIC TEST.
 5. THE VESSEL SHALL BE DRAINED AND THOROUGHLY DRIED IMMEDIATELY UPON THE COMPLETION OF PRESSURE TESTING. THE PROCEDURE FOR DRAINING THE TEST FLUID SHALL PREVENT DEVELOPMENT OF VACUUM PRESSURE WITHIN THE VESSEL OR ITS INTERVALS. THE PROCEDURE SHALL PREVENT DAMAGE TO OR DISLOCATION OF THE INTERVALS.
 6. THE HYDROSTATIC TEST PRESSURE SHALL BE HELD FOR AT LEAST 1 HR.
 7. TEST WATER SHALL NOT BE IN CONTACT WITH AUSTENITIC STAINLESS STEEL FOR GREATER THAN 72 HOURS UNLESS TREATED WITH AN APPROPRIATE BIocide.
 8. VESSELS OR COMPONENTS MADE OF AUSTENITIC STAINLESS STEEL MATERIALS SHALL BE PERFORMED WITH WATER CONTAINING A MAXIMUM OF 50 PPM CHLORIDE.
 9. THE INTERIOR OF THE VESSEL SHALL BE CLEANED IN ACCORDANCE WITH SECTION 4.6.1.2 OF ASME-PP-000-500801-A & APPROVED CLEANING PROCEDURE

- TRANSPORTATION**
1. EQUIPMENT SHALL BE PURGED WITH NITROGEN AT 5 psig (G) PRESSURE.
 2. ADDITIONAL INDICATIONS SUCH AS NORTH/SOUTH/EAST/WEST ALONG WITH CENTER OF GRAVITY
 3. SHALL BE CLEARLY MARKED VESSELS SHALL BE NITROGEN PURGED, FILLED AND HAVE BLIND FLANGES, SERVICE GASKETS, AND FULL BOLTING ON ALL NOZZLES. VENDOR SHALL PROVIDE SPARE DRY NITROGEN BOTTLE FOR ADDITIONAL REQUIREMENT PLEASE REFER PROJECT SPECIFICATION ASME-PP-000-500801-A SECTION 4.6.3 F. 1.1.
 4. VERTICAL VESSELS ARE TO BE MARKED ON THE BASE AND FIRST ONE FOOT OF SKIRT, INDICATING THE NORTH, SOUTH, EAST, AND WEST COORDINATES. THE COORDINATES SHALL BE INDICATED WITH A PAINTED LINE AND LETTER FOR EACH, ACCORDING TO THE ORIENTATION SHOWN ON THE VESSEL DRAWINGS.
 5. THE CENTER OF GRAVITY SHALL BE MARKED ON ALL VERTICAL VESSELS BY PAINTING A CONTINUOUS 3 INCH WIDE CIRCUMFERENTIAL STRIPE. THE LETTERS CG AND SHIPPING WEIGHT IN TONS SHALL BE PAINTED AT 2 LOCATIONS DIAMETRICALLY OPPOSITE AND ADJACENT TO THE STRIPE. THE LOCATION OF THE CENTER OF GRAVITY SPECIFIED ON THE VESSEL FABRICATION DRAWINGS IS THAT OF THE VESSEL AS FABRICATED.
 6. VESSELS OR SECTION OF VESSELS SHALL BE CLEARLY IDENTIFIED BY PAINTING OR DYE STENCILING THE PO NUMBER AND THE VESSEL EQUIPMENT NUMBER IN A CONSPICUOUS LOCATION ON THE SHELL HEAD OR SUPPORT.

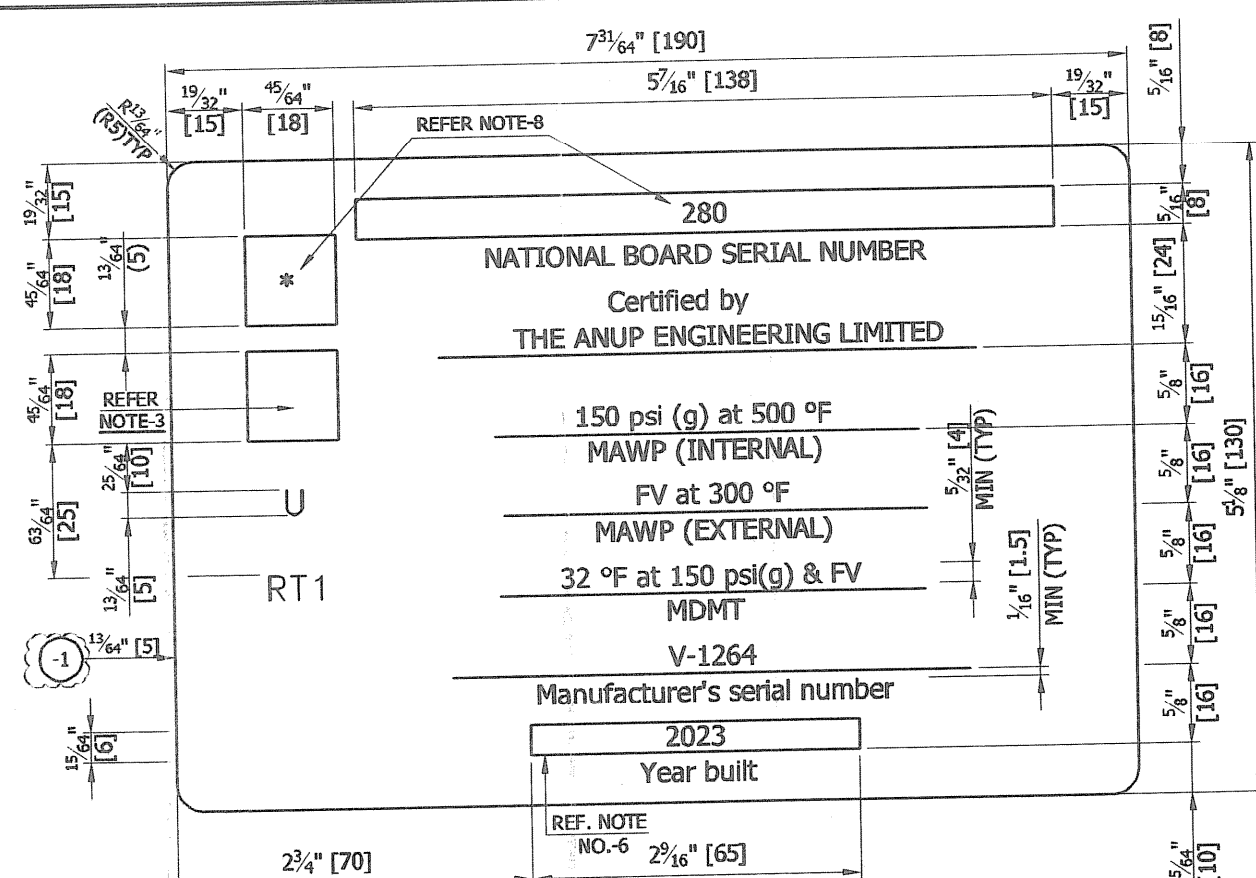

- NOTES:-
- 1) ALL DIMENSIONS ARE IN mm UNLESS OTHERWISE SHOWN.
 - 2) HEIGHT OF CHARACTERS SHALL BE AT LEAST 4 mm & SHALL BE ENGRAVED IN A BLACK ENAMELED BACKGROUND.
 - 3) CERTIFICATION MARK (N) TO BE HARD STAMPED IN PRESENCE OF AI AFTER OBTAINING HIS AUTHORIZATION.
 - 4) NAME PLATE SHALL BE RIVETED TO BRACKET AS PER DRAWING.
 - 5) BRACKET WITH NAME PLATE TO BE LOCATED AS MARKED IN DRG.
 - 6) YEAR BUILT SHALL CORRESPOND TO DATE OF HYDROSTATIC TESTING & SHALL BE HARD PUNCHED AFTER SUCCESSFUL COMPLETION OF HYDRO TEST.
 - 7) ALL HARD STAMPED FACE (BLOCK) SHALL BE RAISED FACE.
 - 8) NATIONAL BOARD SYMBOL AND NATIONAL BOARD SERIAL NUMBER AS ADVISED BY HEAD-QUALITY SHALL BE HARD STAMPED IN PRESENCE OF AI AFTER OBTAINING HIS AUTHORIZATION.

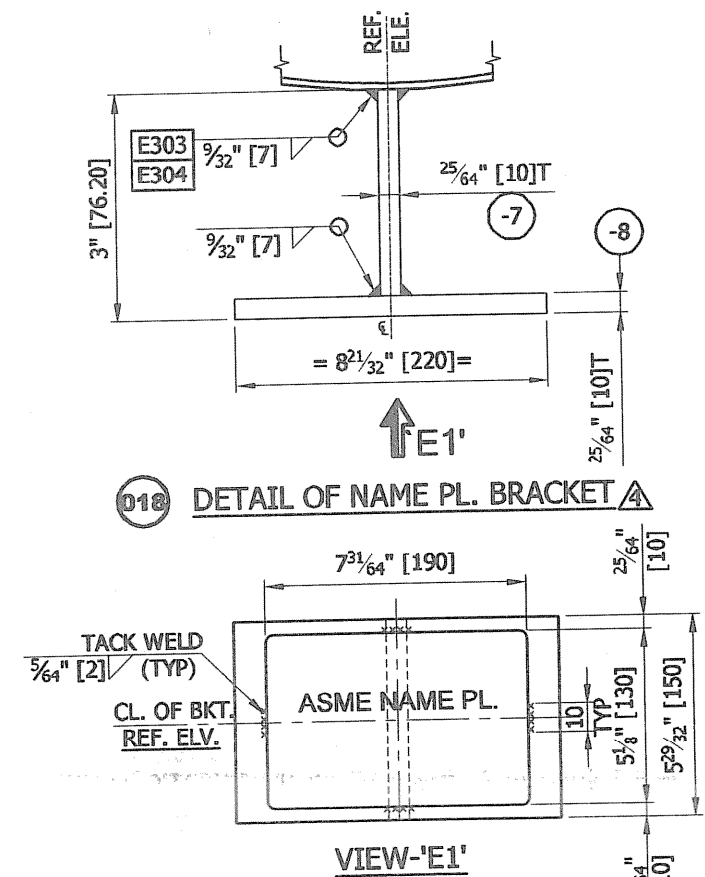

NOTE:
UNDERCUTTING OF SHELL SHALL BE AVOIDED WHEN WELDING BRACKET TO THE VESSEL

4 WELD JOINT NO.: E301 TO E304				SUB TOTAL OF WEIGHT (KG)		6	
4	-8	NAME PLATE BRACKET PLT.-2	1	SA 240 GR 316L	10T x 220W x 150 LG.	2.65	
4	-7	NAME PLATE BRACKET PLT.-1	1	SA 240 GR 316L	10T x 66.2W x 150 LG.	0.8	
4	-6	ASME DUPLICATE NAME PLATE	1	SS 304	5T x 130W x 190 LG	0.99	
4	-5	RIVET	8	ALUMINIUM	Ø5 x 20 LG	-	
4	-4	NAME PLATE BRACKET PLT.-2	1	SA 240 GR 316L	10T x 220W x 284 LG.	3	
4	-3	NAME PLATE BRACKET PLT.-1	1	SA 240 GR 316L	10T x 66.2W x 284 LG.	1.02	
4	-2	MFG'S NAME PLATE	1	SS 304	5T x 110W x 200 LG	0.88	
4	-1	ASME NAME PLATE	1	SS 304	5T x 130W x 190 LG	0.99	
018 NAME PLATE ASSLY							
REV. NO.	SR. NO.	DESCRIPTION	QTY/ITEM	MATERIAL	SIZE	WT. (kg)	REMARK
BILL OF MATERIAL							


APPLICABLE STANDARDS

SR. NO.	STD. NO.	DESCRIPTION	REV. NO.
1	ASME-PP-000-53007-D	VESSEL NAMEPLATE BRACKET	0
2	ASME-PP-000-53026-D	VESSEL VORTEX BREAKERS	0A
3	ASME-PP-000-53008-D	VESSEL GROUNDING LUG	0
4	ASME-PP-000-53021-D	VESSEL VERTICAL MANWAY DAVITS	0
5	ASME-PP-000-53027-D	VESSEL INTERNAL RUNGS	0
6	ASME-PP-000-53006-D	SKIRT OPENING VERTICAL VESSELS	0A
7	ASME-PP-000-53007-D	VESSEL NAMEPLATE BRACKET	0
8	ASME-PP-000-53001-D	MIST ELIMINATOR DETAILS	0A
9	ASME-PP-000-530029-D	SKIRT ATTACHMENT	0A

REFERENCE SPECIFICATIONS

SR. NO.	SPEC. NO.	DESCRIPTION	REV. NO.
1	ASME-PP-000-500550-A	WELDING/AIDE REQUIREMENTS FOR EQUIPMENT	0A
2	ASME-18-088-540321-A	MECHANICAL EQUIPMENT DATA SHEET FOR 18-X-261	0
3	ASME-PP-000-500512-A	POSITIVE MATERIAL IDENTIFICATION (PMI)	0
4	ASME-PP-000-500530-A	PAINTING	0D
5	ASME-PP-000-500540-A	DESIGN OF LIFTING COMPONENTS FOR MECHANICAL EQUIPMENT	0
6	ASME-PP-000-500540-A	GALVANIZING	0A
7	ASME-PP-000-500801-A	DESIGN AND FABRICATION SPECIFICATION FOR VESSELS ASME CODE SECTION VIII, DIVISIONS 1 AND 2	0
8	ASME-PP-000-500840-A	DESIGN AND FABRICATION SPECIFICATION FOR PRESSURE VESSEL INTERNALS	0

AS BUILT DRAWING

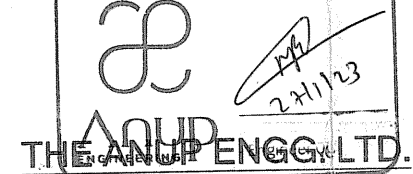

REV. NO.	DATE	DESCRIPTION	BY	CHD.	APPD.
4	23-01-2023	AS BUILT DRAWING	GML	AAS	BMP
3	17-09-2022	DRAWING REVISED AS PER CLIENT COMMENT AS MARK A	VAP	JD	BMP
2	20-04-2022	DRAWING REVISED AS PER CLIENT COMMENT AS MARK A	VAP	KRK	DKB
1	01-01-2022	DRAWING REVISED AS PER CLIENT COMMENT AS MARK A	VAP	KRK	BMP
0	29-07-2021	ISSUED FOR APPROVAL	VAP	KRK	BMP

Air Products Manufacturing LLC

ENGINEERING & PROJECT MANAGEMENT



CONTRACT NO.:

THE ANUP ENGINEERING LTD. AHMEDABAD

CLIENT: WORLD ENERGY PARAMOUNT PARAMOUNT, CA		SHEET NO: 3 OF 4		REV: 4
P.O.NO. : 4505426369 DATE 09.07.2021		DRG. NO: V-1264-FAD-2021		
DRN. VAP		18-D-272 ARG2 AMINE REGEN REFLUX DRUM		ITEM NO. 18-D-272
CHD. -		H2S RECOVERY UNIT		
APPD. BMP		NAME PLATE AND GENERAL NOTES DETAILS DRAWING		QTY ONE
DATE 20-10-2021		SCALE 1 : 19		
MFR'S SERIAL NO.: V-1264		AP DOCUMENT NUMBER EN207122-ANUP-9V3-00028		SHEET NO. 3 OF 4
		REV. 4		4

MFR'S SERIAL NO. : V-1264