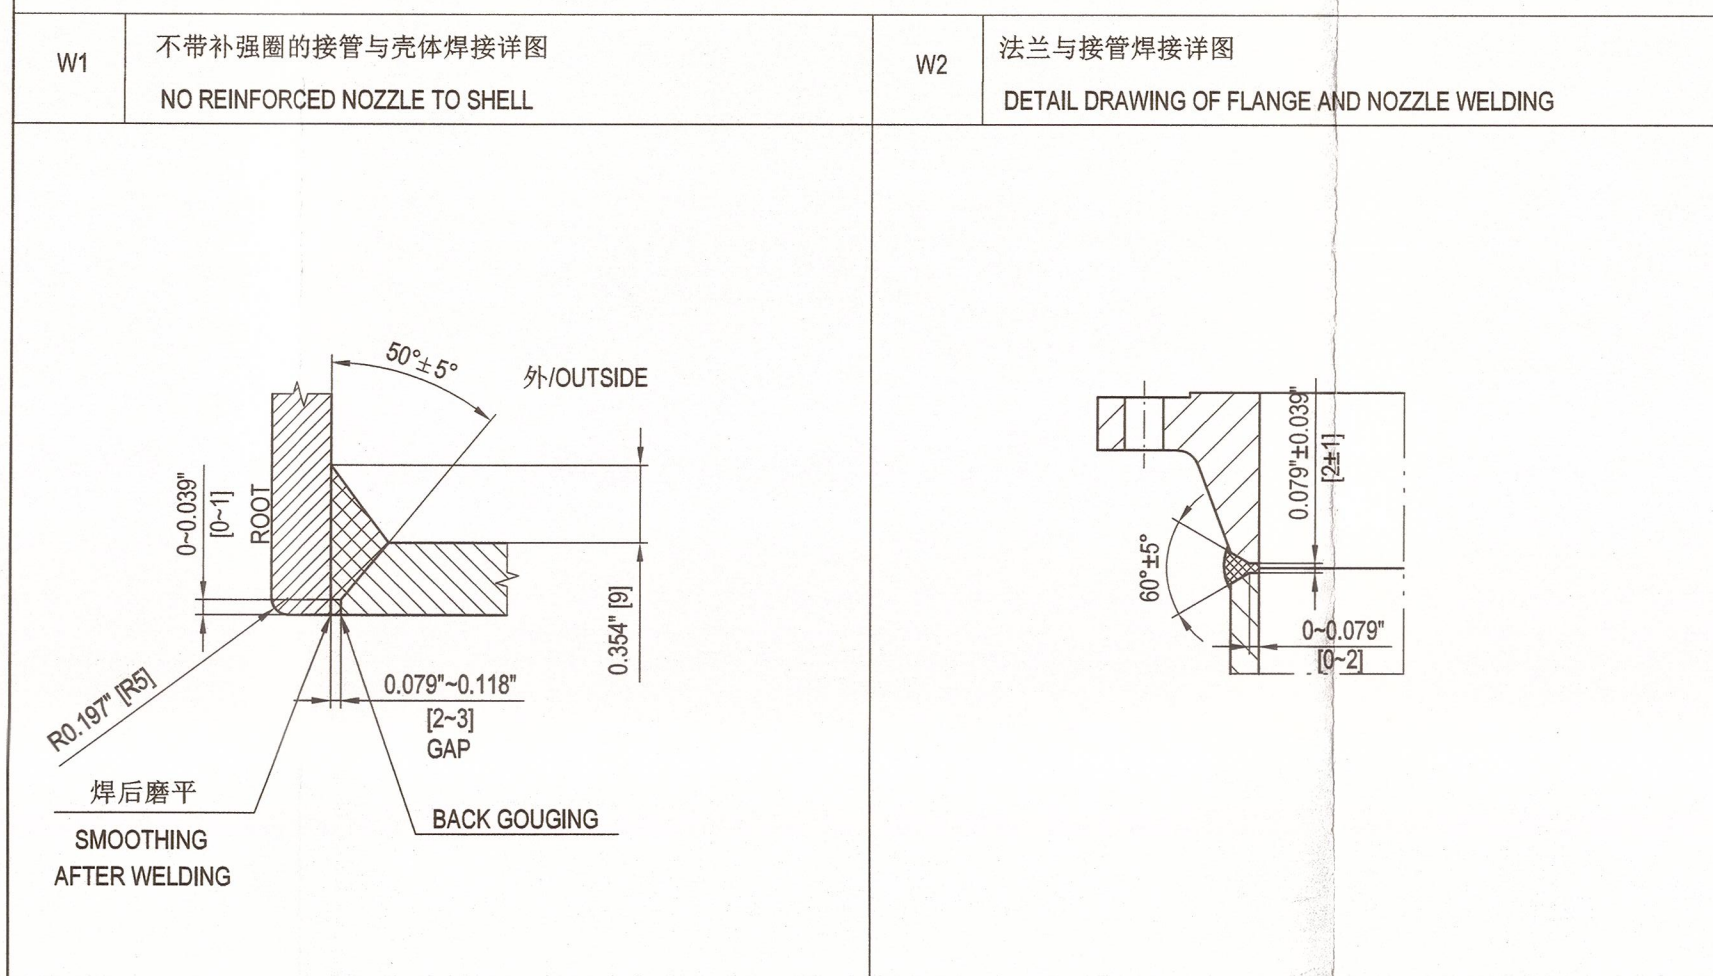
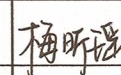
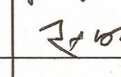


66		接管Ø60.3X5.54 NOZZLE	1	SA-106 Gr.B		1.4	Aux2
65	ASME B16.5-2017	法兰 WN 2"-300# RF SCH80 FLANGE	1	SA-105N		3.8	Aux2
64	ASME B18.2.2-2022	重型六角螺母 5/8"-1UNC-2B HEAVY HEX NUT	64±8	SA-194 Gr.8	/	/	Aux3-4
63	ASME B18.2.1-2012 (R2021)	全螺纹螺栓 5/8"-1UNC-2A L=150 FULL THREADED STUD BOLT	16±2	SA-193 B8	/	/	Aux3-4
62	ASME PCC 1-2019 APPENDIX M	垫圈 5/8" WASHER	32±4	TYPE 6	0.08	2.88	Aux3-4
61	ASME B18.2.2-2022	重型六角螺母 5/8"-1UNC-2B HEAVY HEX NUT	96±12	SA-194 2H	/	/	Aux1-2,TV
60	ASME B18.2.1-2012 (R2021)	全螺纹螺栓 5/8"-1UNC-2A L=150 FULL THREADED STUD BOLT	24±3	SA-193 B7	/	/	Aux1-2,TV
59	ASME B16.20-2017	缠绕垫 2"-300# RF SPIRAL WOUND GASKET	5+10	见注1 SEE NOTE 1	/	/	Aux1-4,TV
58	ASME B16.5-2017	法兰 盖BL 2"-300# RF BLIND FLANGE	2	SA-182 F316L	1.0	2.0	Aux3-4
57	ASME B16.5-2017	法兰 LWN 2"-300# RF B=50.8 FLANGE	2	SA-182 F316L	8.5	17.0	Aux3-4
56	ASME B16.5-2017	法兰 LWN 8"-600# RF B=203.2 FLANGE	2	SA-182 F316L	93.8	188	S1-S2
55	ASME B16.5-2017	法兰 LWN 2"-300# RF B=50.8 FLANGE	1	SA-105N		7.3	TV
54	ASME B16.5-2017	法兰 盖 BL 2"-300# RF BLIND FLANGE	3	SA-105N	1.0	3.0	Aux1-2,TV
53	ASME PCC 1-2019 APPENDIX M	垫圈 5/8" WASHER	48±6	TYPE 4			Aux1-2,TV
52	ASME B16.5-2017	法兰 LWN 3"-600# RF B=76.2 FLANGE	1	SA-105N		25.7	T2
51	ASME B16.5-2017	法兰 LWN 2"-300# RF B=50.8 FLANGE	1	SA-105N		8.5	Aux1
50	ASME B16.5-2017	法兰 LWN 4"-600# RF B=101.6 FLANGE	1	SA-105N		44.4	T1
件 号 PART NO.	图号或标准号 DWG.NO.OR STD.NO.	名 称 DESIGNATION	数 量 QTY.	材 料 MATERIAL	单 重 WEIGHT	单 重 TOTAL 重量 (kg)	备 注 REMARKS

			
Air Product Project Number EN207123	Fluor Project Number A8KM	设计项目 DESIGN ITEM	
Project Name World Energy Renew Utilities USTL	RFQ No. A8KM4-403-RQ	设计阶段 DESIGN PHASE	
Purchase Order Number 4505600575	PO/Contract No A8KM4-403-PC-6	详细设计 Detail Design	
Air Products Open Text document number EN207123-WUXI-9V3-00029	Project Area Utilities	设备位号 18-X-1800	
Client WORLD ENERGY PARAMOUNT	Client Doc No:	ITEM NO WXC6714-03	
05 竣工图/AS BUILT	Mei Xinyao Shengfang Zhao	Kevin Yang 03-Apr-23	
04 供批准//ISSUED FOR APPROVAL	Mei Xinyao Shengfang Zhao	Kevin Yang 17-Nov-22	
03 供批准//ISSUED FOR APPROVAL	Mei Xinyao Shengfang Zhao	Kevin Yang 16-Sep-22	
02 供批准//ISSUED FOR APPROVAL	Mei Xinyao Shengfang Zhao	Kevin Yang 12-Aug-22	
01 供批准//ISSUED FOR APPROVAL	Mei Xinyao Shengfang Zhao	Kevin Yang 09-Jun-22	
版次/REV1 版次说明/DESCRIPTION	设计/PREPARED 审核/REVIEWED 批准/APPROVED	日期/DATE	

本图纸版权为无锡化工装备股份有限公司财产,未经本公司许可不得转让或重复给第三方。
 The copyright of this drawing is the property of China Wuxi Chemical Equipment Co.,Ltd.(WCE),unauthorized disclosure or disposition to the third party is not permitted.

		无锡化工装备股份有限公司 WUXI CHEMICAL EQUIPMENT CO., LTD.	
设计 PREPARED 审核 REVIEWED 批准 APPROVED	  	T-100061 Recirculating Exchanger NOZZLE DETAIL DRAWING 比例: 1:4 版次: REV. 05	第 3 页 共 6 页 PAGE 3 OF 6

Note: 1.SPIRAL WOUND GRAPHITE FILLER SS316L WINDINGS, WITH SS316L INNER RING AND SS316L CENTRING RING