


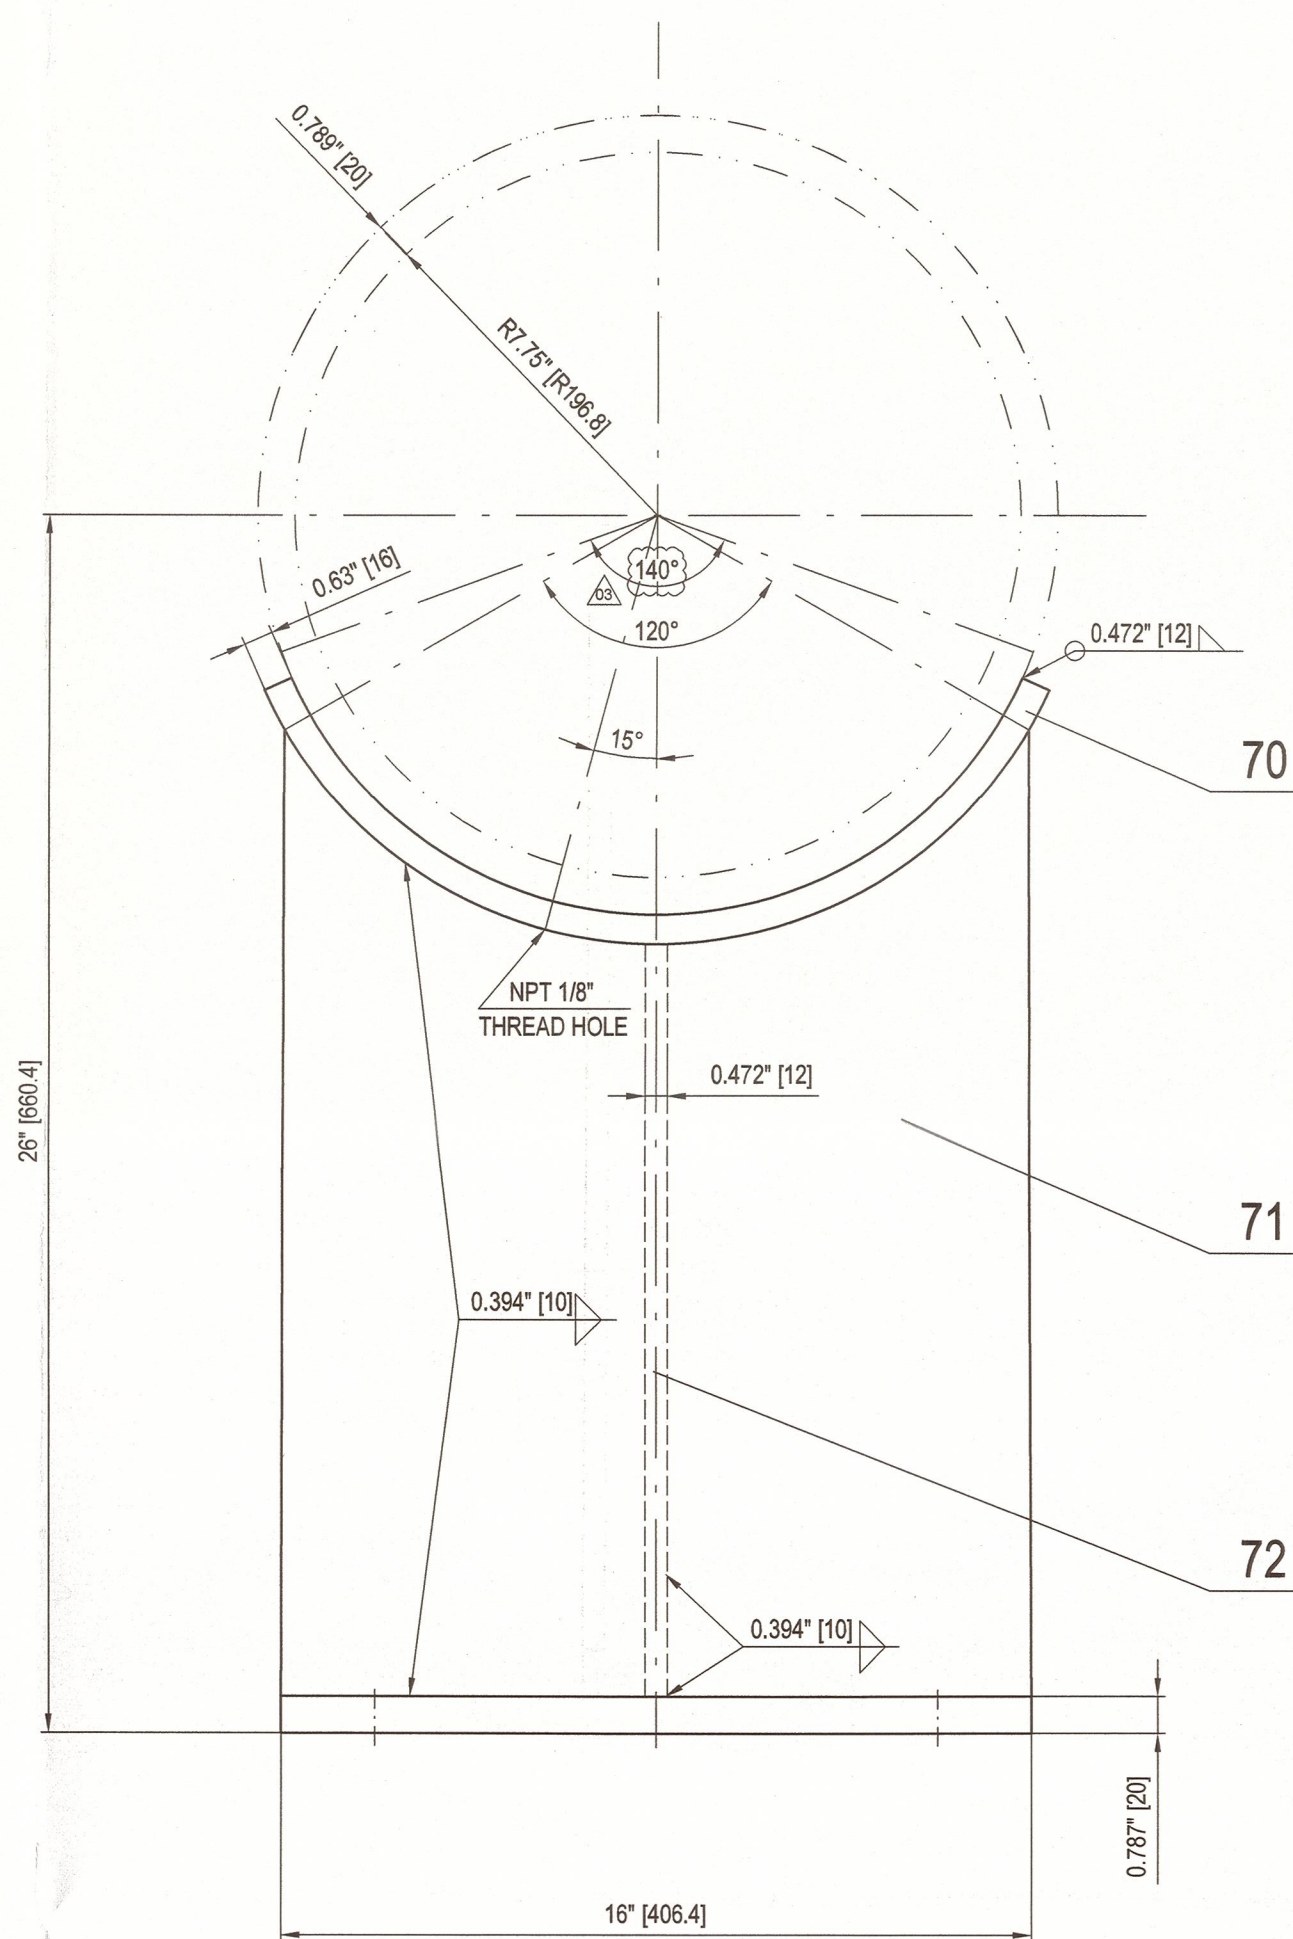
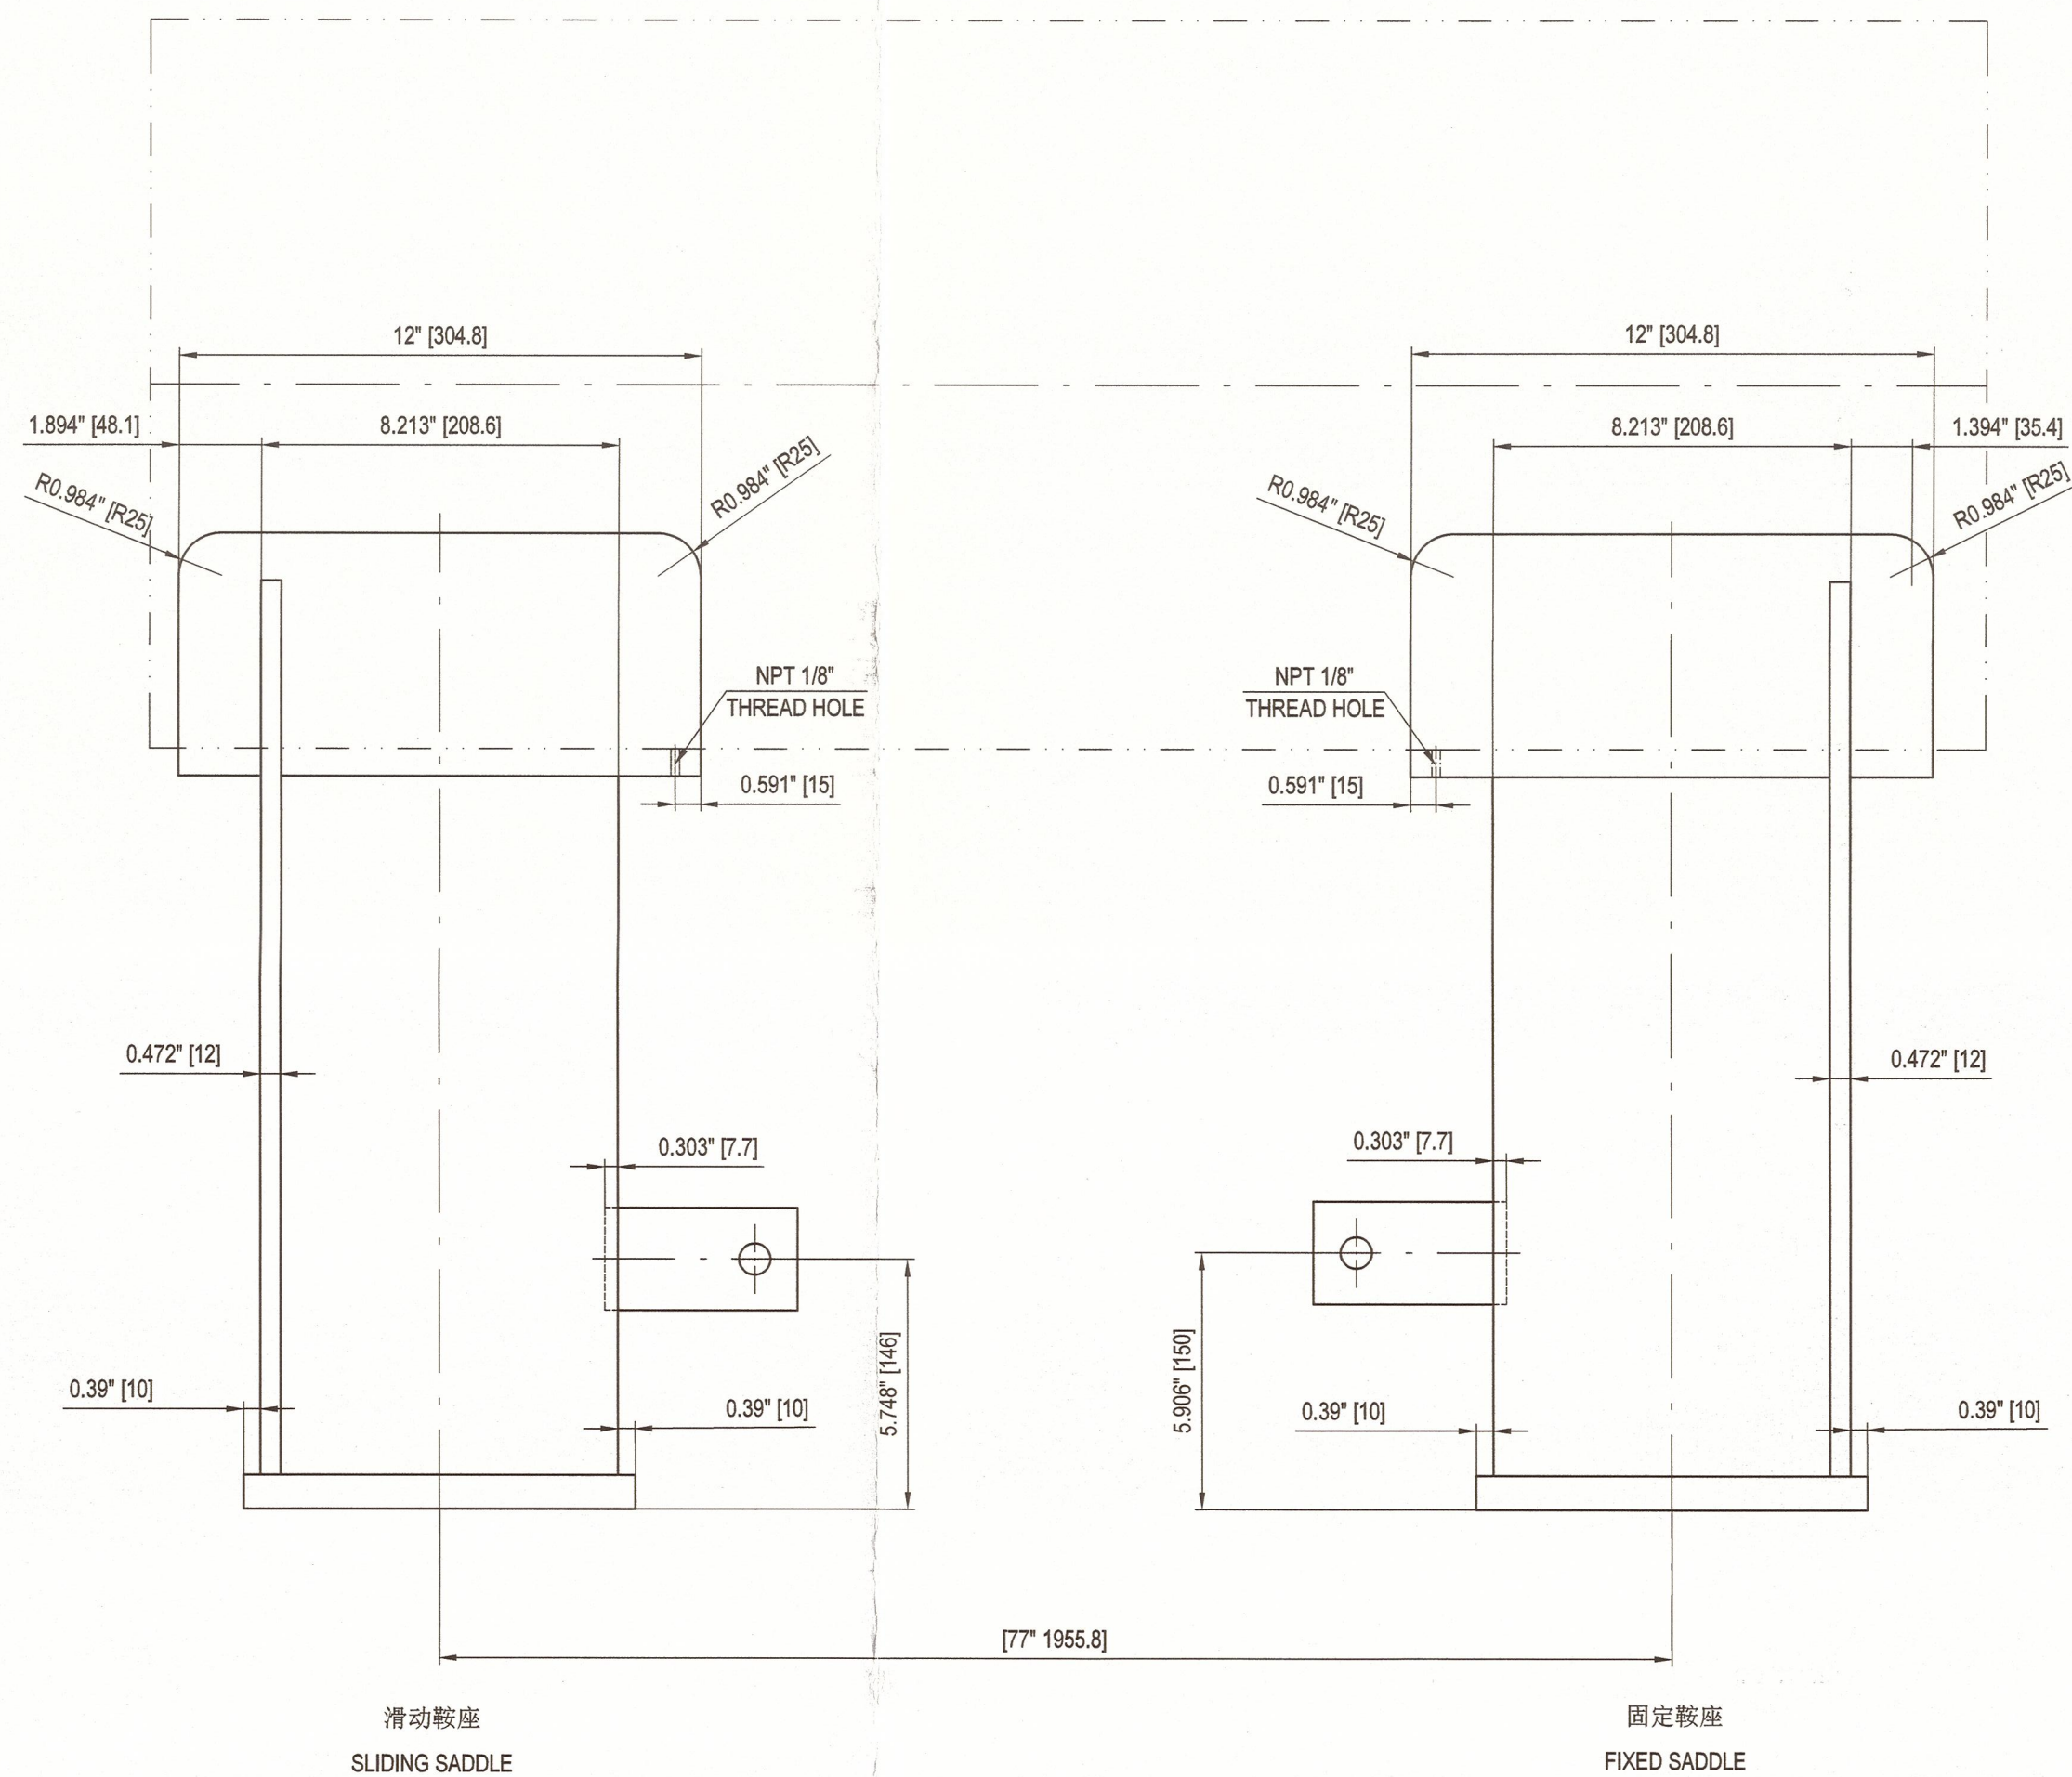
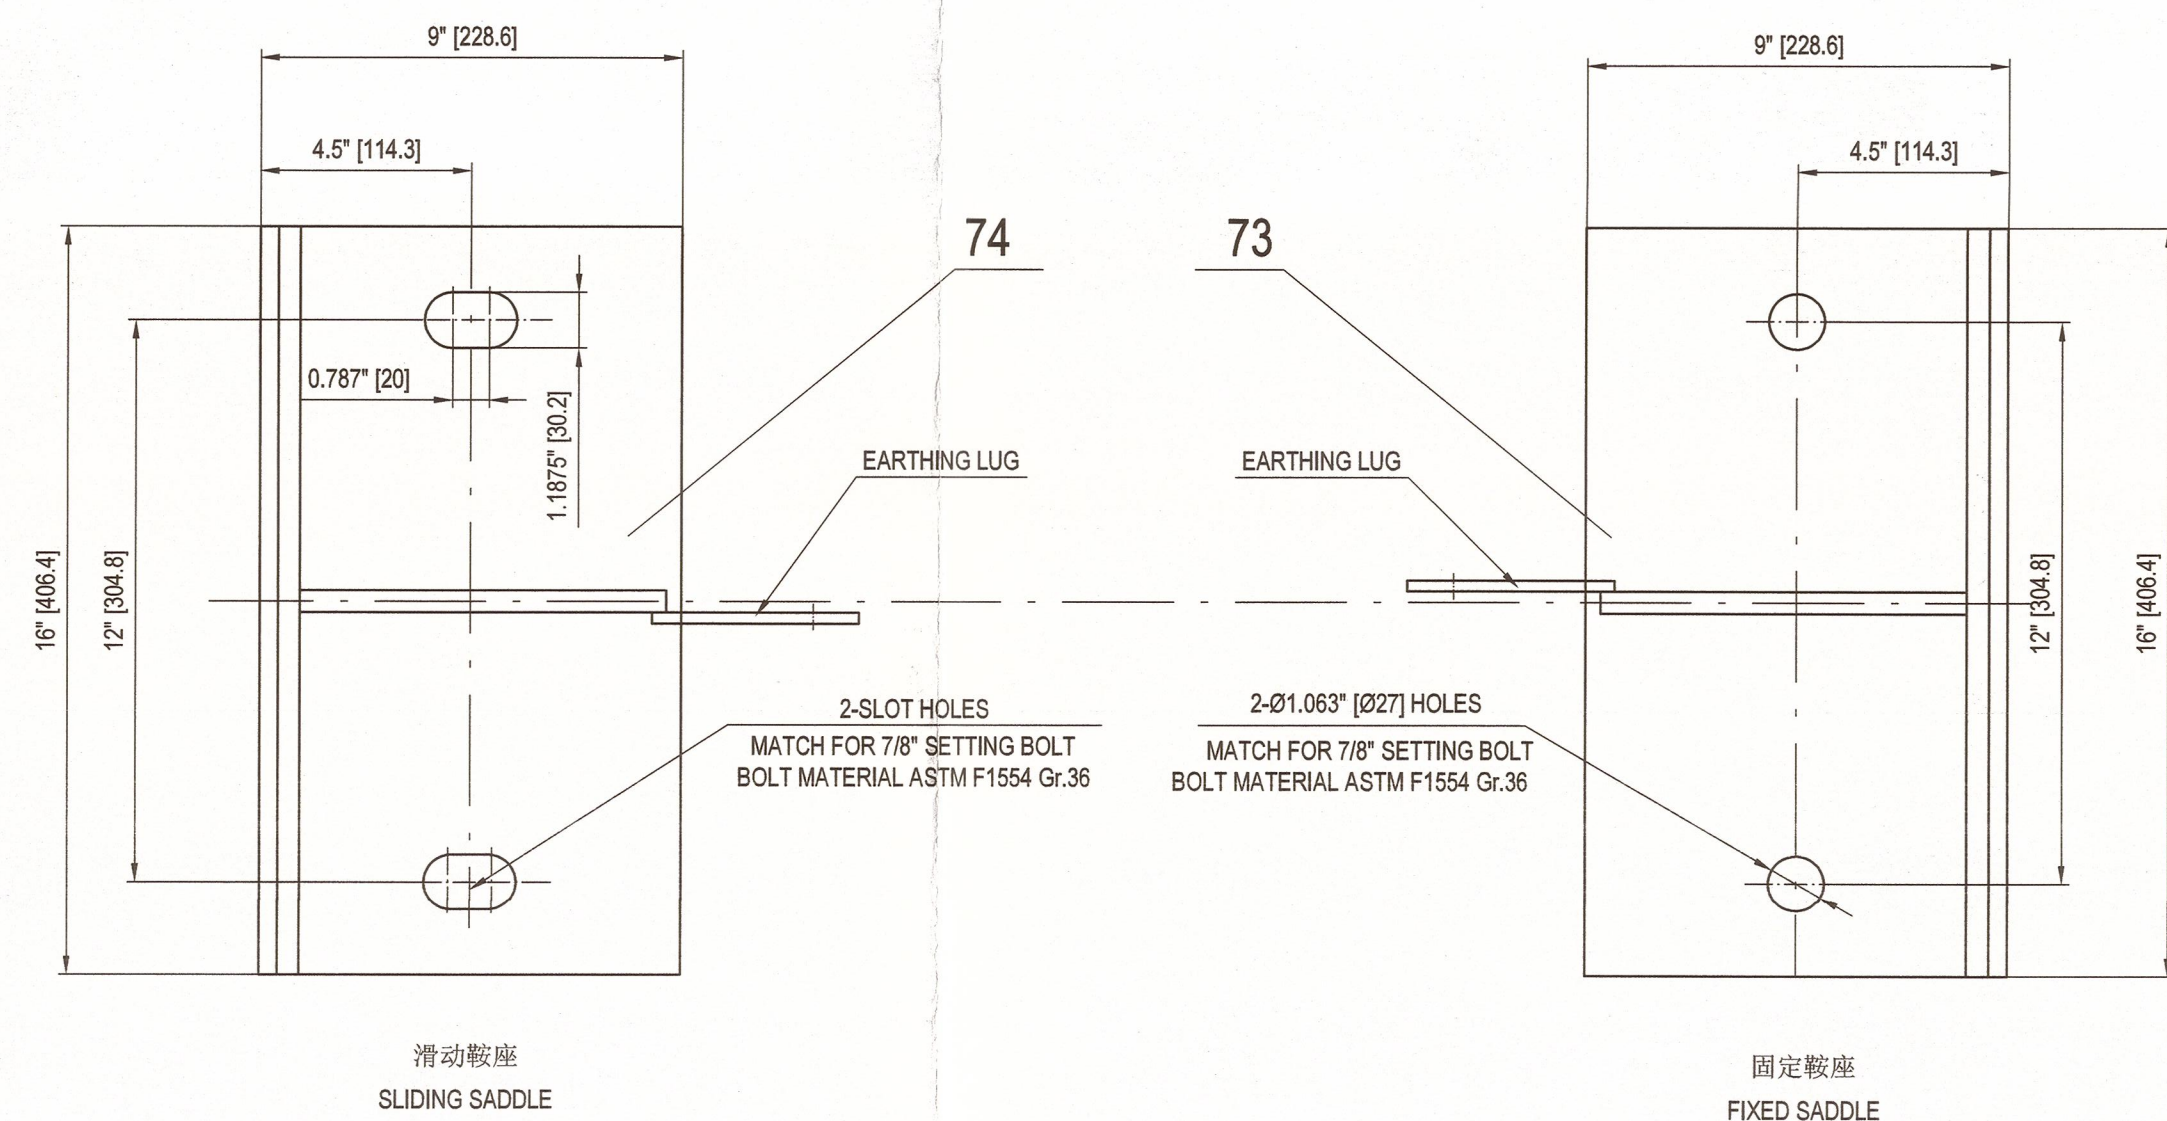


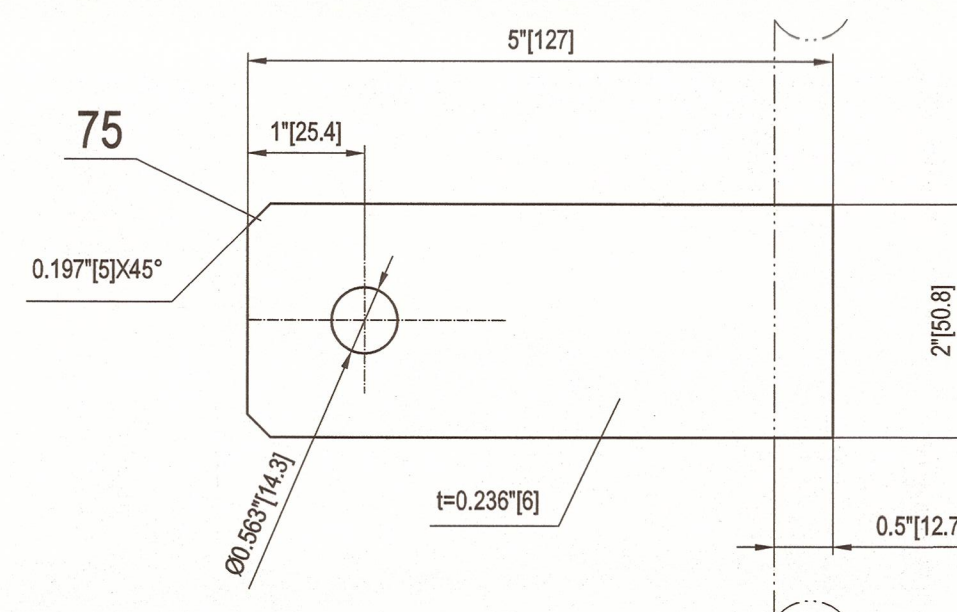

接地耳详图  
EARTHING LUG DETAIL DRAWING

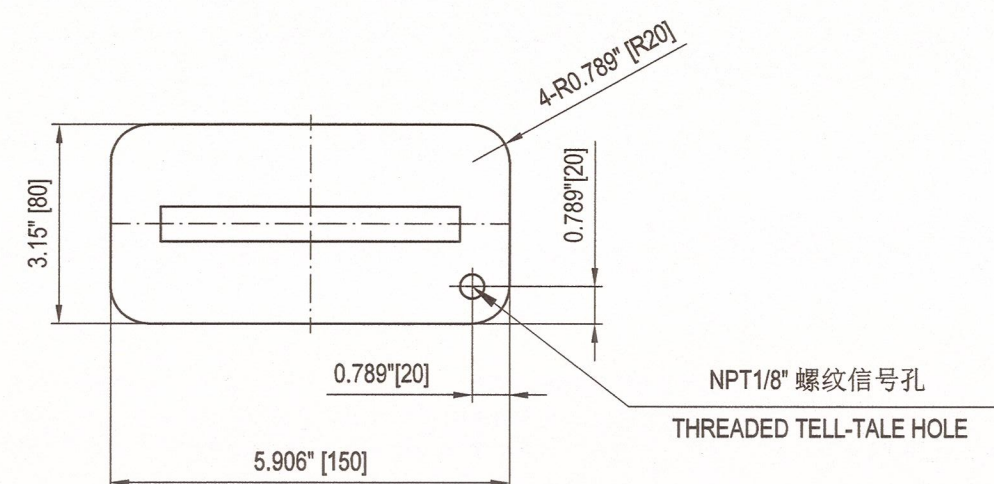

管箱吊耳 2 详图  
CHANNEL LIFTING LUG 2 DETAIL

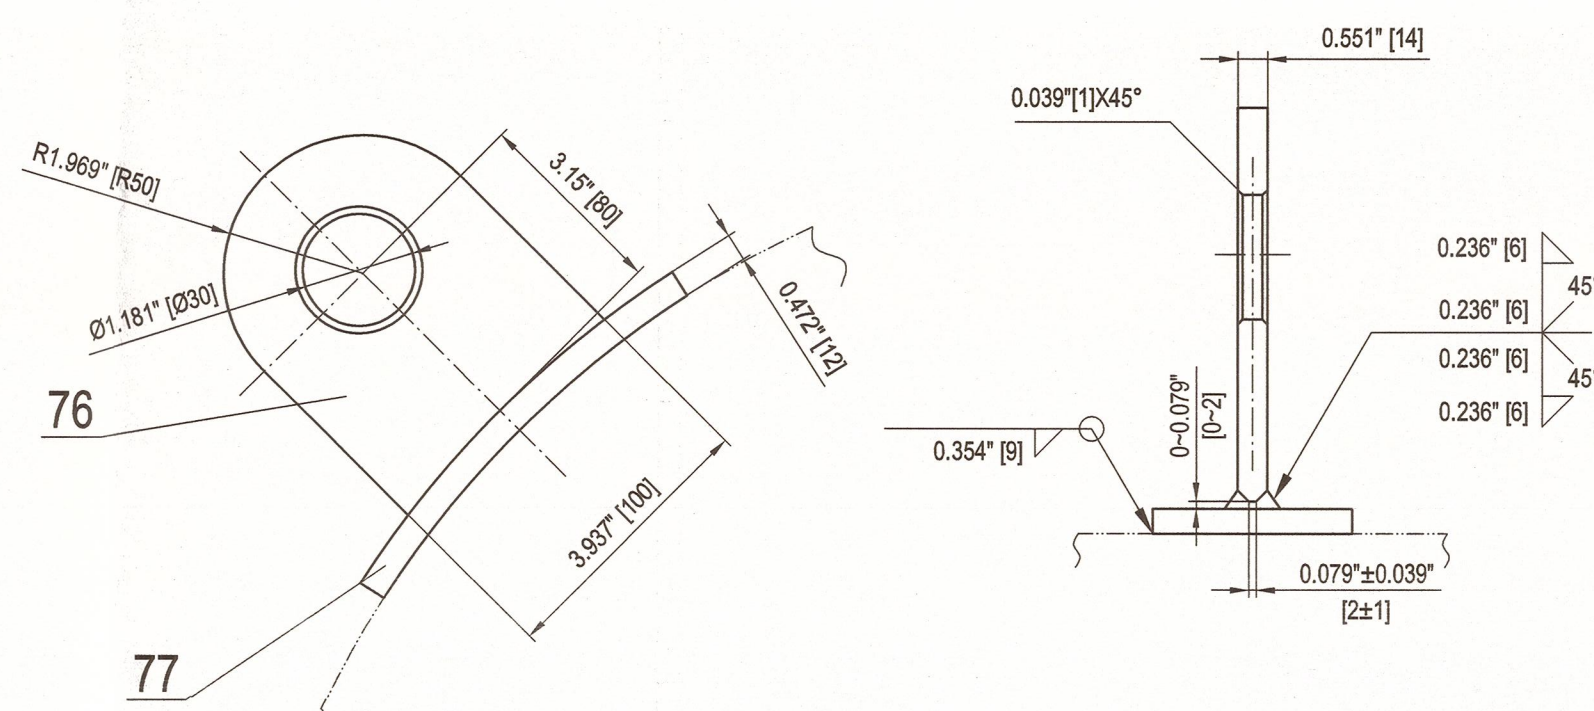

As Built

|                |                             |                                   |            |                 |                    |                            |                        |
|----------------|-----------------------------|-----------------------------------|------------|-----------------|--------------------|----------------------------|------------------------|
| 77             |                             | 垫板 t=12<br>WEAR PLATE             | 1          | SA-516 Gr.70N   |                    | 2.2                        |                        |
| 76             |                             | 管箱吊耳2 t=14<br>CHANNEL LIFTING LUG | 1          | SA-516 Gr.70N   |                    | 2.8                        |                        |
| 75             |                             | 接地耳 t=6<br>EARTHING LUG           | 2          | SS.304          | 0.3                | 0.6                        |                        |
| 74             |                             | 底板 t=20<br>BASE PLATE             | 1          | SA-516 Gr.70N   |                    | 17.5                       | 滑动鞍座<br>SLIDING SADDLE |
| 73             |                             | 底板 t=20<br>BASE PLATE             | 1          | SA-516 Gr.70N   |                    | 17.5                       | 固定鞍座<br>FIXED SADDLE   |
| 72             |                             | 筋板 t=12<br>RIB PLATE              | 2          | SA-516 Gr.70N   | 7.62               | 15.24                      |                        |
| 71             |                             | 腹板 t=12<br>WEB PLATE              | 2          | SA-516 Gr.70N   | 18.76              | 37.52                      |                        |
| 70             |                             | 垫板 t=16<br>WEAR PLATE             | 2          | SA-240 316L     | 13.9               | 27.8                       |                        |
| 件号<br>PART NO. | 图号或标准号<br>DWG.NO.OR STD.NO. | 名 称<br>DESIGNATION                | 数量<br>QTY. | 材 料<br>MATERIAL | 单 重<br>EACH WEIGHT | TOTAL<br>重量 (kg)<br>WEIGHT | 备 注<br>REMARKS         |

|                                                                                                                                                                                                                     |                         |                                   |                                   |                |                 |                      |                                    |             |
|---------------------------------------------------------------------------------------------------------------------------------------------------------------------------------------------------------------------|-------------------------|-----------------------------------|-----------------------------------|----------------|-----------------|----------------------|------------------------------------|-------------|
| AIR PRODUCTS                                                                                                                                                                                                        |                         |                                   | FLUOR                             |                |                 |                      |                                    |             |
| Air Products Project Number                                                                                                                                                                                         |                         | EN207123                          | Fluor Project Number              |                | A8KM            |                      |                                    |             |
| Project Name                                                                                                                                                                                                        |                         | World Energy Renew Utilities US7L | RFQ No.                           |                | A8KM-4-403-RQ   |                      |                                    |             |
| Purchase Order Number                                                                                                                                                                                               |                         | 4505600575                        | PO/Contract No                    |                | A8KM-4-403-PO-6 |                      |                                    |             |
| Air Products Open Text document number                                                                                                                                                                              |                         | EN207123-WUXI-9V3-00029           | Project Area                      |                | Utilities       |                      |                                    |             |
| Client                                                                                                                                                                                                              |                         | WORLD ENERGY PARAMOUNT            |                                   | Client Doc No: |                 |                      |                                    |             |
| 05                                                                                                                                                                                                                  | 竣工图/AS BUILT            |                                   | Mei Xinyao                        | Shengfang Zhao | Kevin Yang      | 03-Apr-23            |                                    |             |
| 04                                                                                                                                                                                                                  | 供批准/ISSUED FOR APPROVAL |                                   | Mei Xinyao                        | Shengfang Zhao | Kevin Yang      | 17-Nov-22            |                                    |             |
| 03                                                                                                                                                                                                                  | 供批准/ISSUED FOR APPROVAL |                                   | Mei Xinyao                        | Shengfang Zhao | Kevin Yang      | 16-Sep-22            |                                    |             |
| 02                                                                                                                                                                                                                  | 供批准/ISSUED FOR APPROVAL |                                   | Mei Xinyao                        | Shengfang Zhao | Kevin Yang      | 12-Aug-22            |                                    |             |
| 01                                                                                                                                                                                                                  | 供批准/ISSUED FOR APPROVAL |                                   | Mei Xinyao                        | Shengfang Zhao | Kevin Yang      | 09-Jun-22            |                                    |             |
| 版次 REV                                                                                                                                                                                                              |                         | 版次说明/DESCRIPTION                  |                                   | 设计/REVIEWED    |                 | 批准/DATE              |                                    |             |
| 本图版权为无锡化工装备股份有限公司财产,未经本公司许可不得转让或复写给第三方。<br>The copyright of this drawing is the property of China Wuxi Chemical Equipment Co.,Ltd.(WCE),unauthorized disclosure or duplication to the third party is not permitted. |                         |                                   |                                   |                |                 |                      |                                    |             |
| WCE                                                                                                                                                                                                                 |                         |                                   | 无锡化工装备股份有限公司                      |                |                 | 设计项目<br>DESIGN ITEM  | World Energy<br>Renewables Project |             |
|                                                                                                                                                                                                                     |                         |                                   | WUXI CHEMICAL EQUIPMENT CO., LTD. |                |                 | 设计阶段<br>DESIGN PHASE | 详细设计<br>Detail Design              |             |
| 设计<br>PREPARED                                                                                                                                                                                                      | 梅昕尧                     | 2023.4.3                          | T-100001 Recirculating Exchanger  |                |                 |                      | 设备位号<br>ITEM NO.                   | 18-X-1800   |
| 审核<br>REVIEWED                                                                                                                                                                                                      | 梅昕尧                     | 2023.4.3                          | SADDLE DETAIL DRAWING             |                |                 |                      | 图号<br>DWG. NO.                     | WXCE6714-04 |
| 批准<br>APPROVED                                                                                                                                                                                                      |                         | 2023.4.3                          | 比例:<br>SCALE                      | 1:4            | 版次:<br>REV.     | 05                   | 第 4 页 共 6 页<br>PAGE 4 OF 6         |             |