
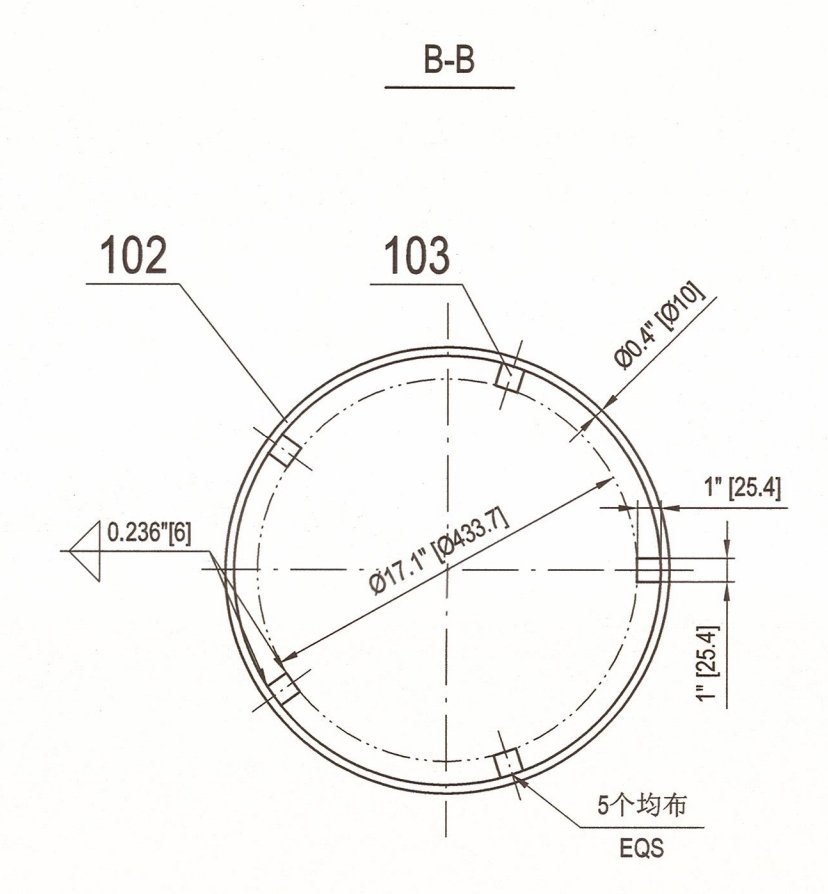
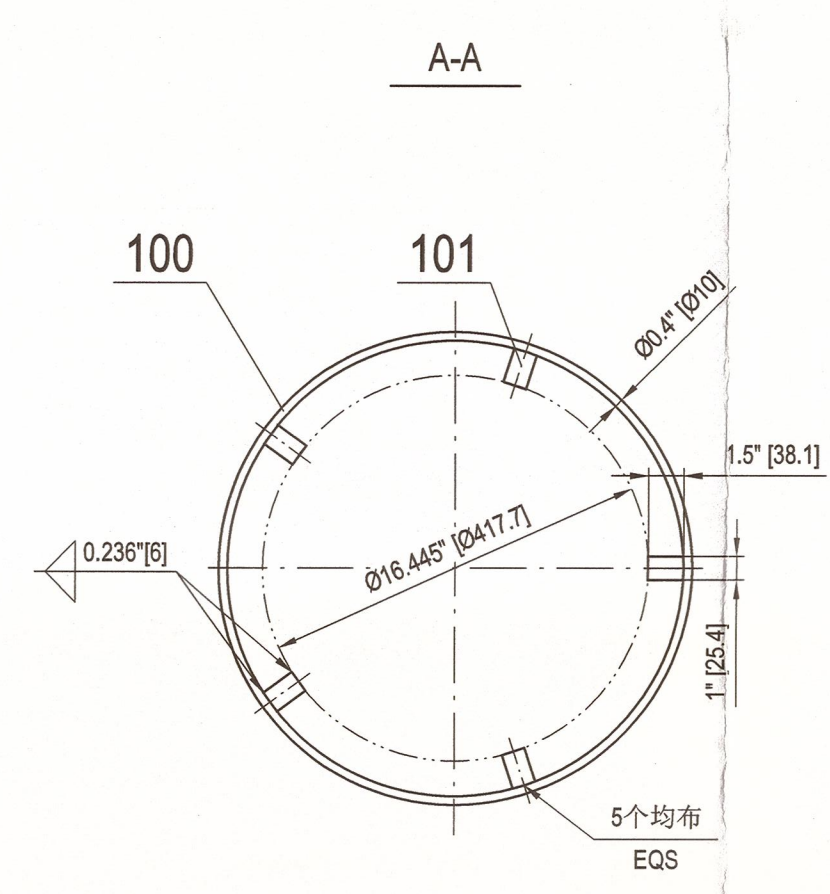


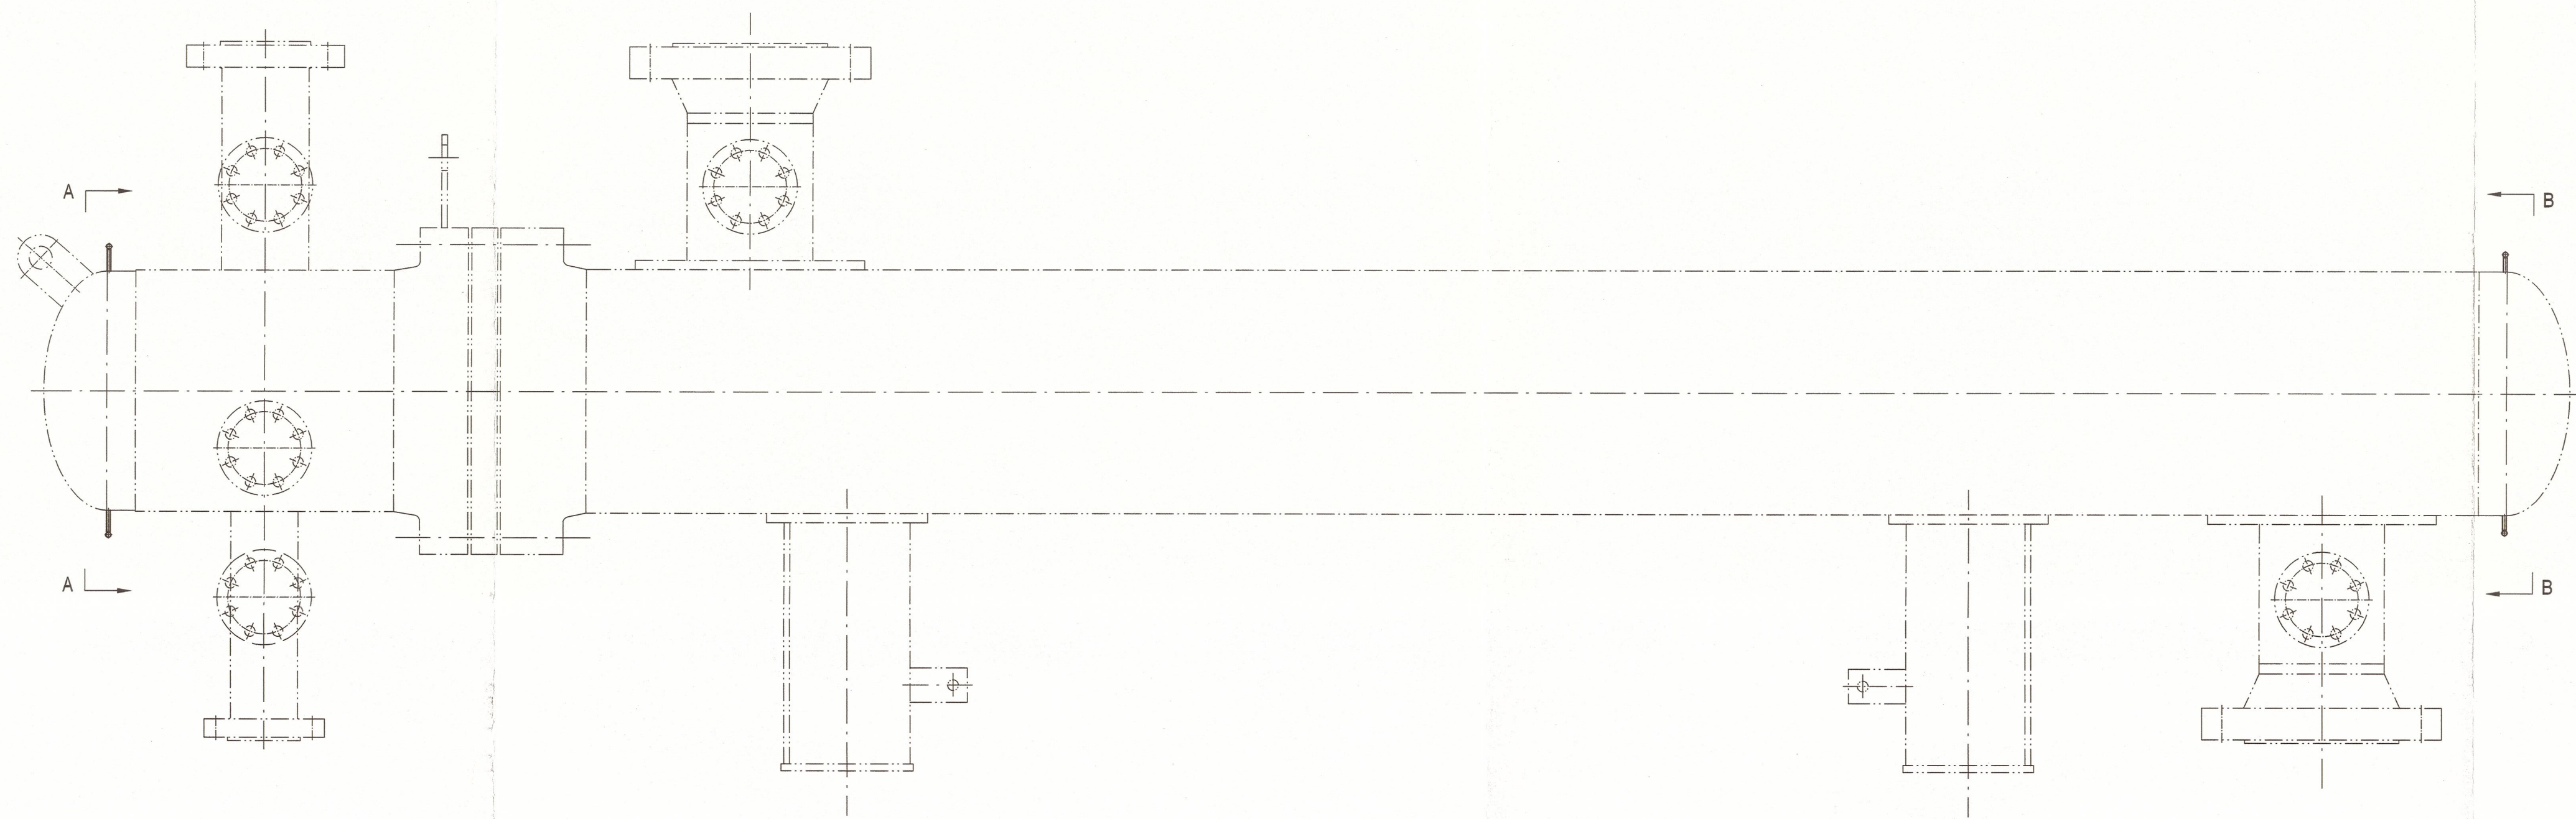

As Built

103		支撑筋板 t=6 INSULATION SUPPORT CLIP	5	SA-240 316L			
102		保温支撑环 Ø10 INSULATION SUPPORT RING	1	SA-479 316L		0.8	
101		支撑筋板 t=6 INSULATION SUPPORT CLIP	5	SA-516 Gr.70N			
100		保温支撑环 Ø10 INSULATION SUPPORT RING	1	SA-36		0.9	
件号 PART NO.	图号或标准号 DWG. OR STD. NO.	名 称 DESCRIPTION	数量 QTY.	材 料 MATERIAL	单件 EACH 重量 WT. (kg)	总计 SUM	备 注 REMARK
AIR PRODUCTS			FLUOR				
Air Products Project Number		EN207123		Fluor Project Number		A8KM	
Project Name		World Energy Renew Utilities US7L		RFQ No.		A8KM-4-403-RQ	
Purchase Order Number		4505600575		PO/Contract No		A8KM-4-403-PO-6	
Air Products Open Text document number		EN207123-WUXI-SV3-00029		Project Area		Utilities	
Client		WORLD ENERGY PARAMOUNT		Client Doc No:			
04	竣工图/AS BUILT		Mei Xinyao	Shengfang Zhao	Kevin Yang	03-Apr-23	
03	供批准/ISSUED FOR APPROVAL		Mei Xinyao	Shengfang Zhao	Kevin Yang	17-Nov-22	
02	供批准/ISSUED FOR APPROVAL		Mei Xinyao	Shengfang Zhao	Kevin Yang	16-Sep-22	
01	供批准/ISSUED FOR APPROVAL		Mei Xinyao	Shengfang Zhao	Kevin Yang	12-Aug-22	
00	供批准/ISSUED FOR APPROVAL		Mei Xinyao	Shengfang Zhao	Kevin Yang	09-Jun-22	
版次 REV	版次说明/DESCRIPTION		设计/Prepared		审核/Reviewed	批准/Approved	日期/DATE
The copyright of this drawing is the property of China Wuxi Chemical Equipment Co., Ltd. (WCE). Unauthorized disclosure or duplication to the third party is not permitted.							
WCE 无锡化工装备股份有限公司 WUXI CHEMICAL EQUIPMENT CO., LTD.			设计项目 DESIGN ITEM		World Energy Renewables Project		
设计 PREPARED 审核 REVIEWED 批准 APPROVED			T-100001 Recirculating Exchanger INSULATION CLIP DETAIL DRAWING		设计阶段 DESIGN PHASE		
					详细设计 Detail Design		
					设备位号 ITEM NO.		
					18-X-1800		
					图 号 DWG. NO.		
					WXCE6714-07		
			比例: 1:8 SCALE		第 6 页 共 6 页 PAGE 6 OF 6		
			版 次: 04 REV.				