
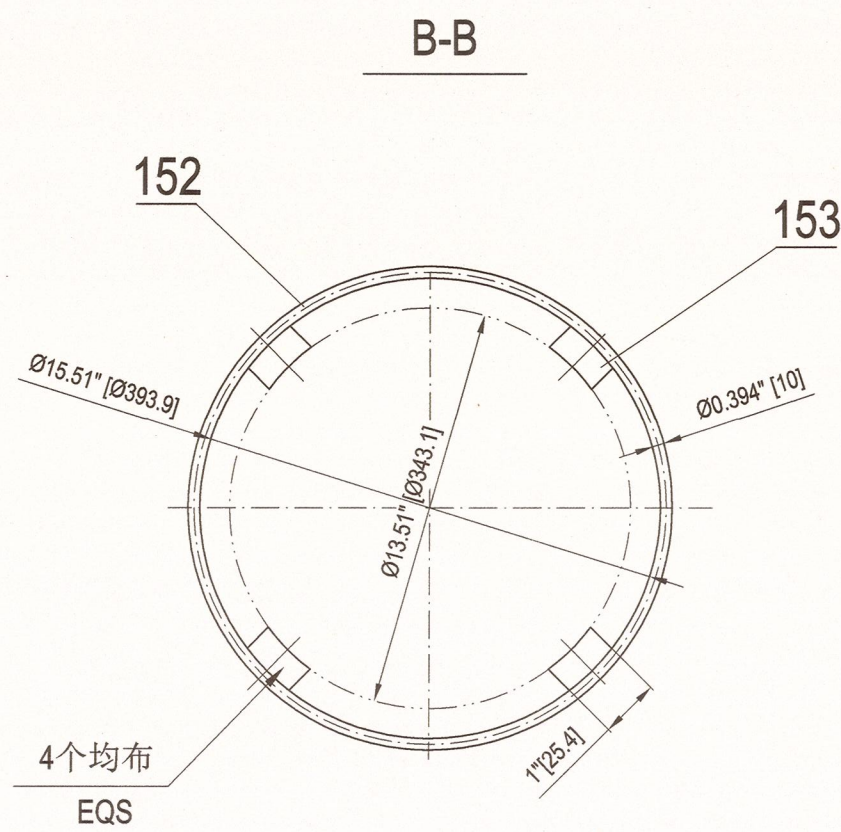


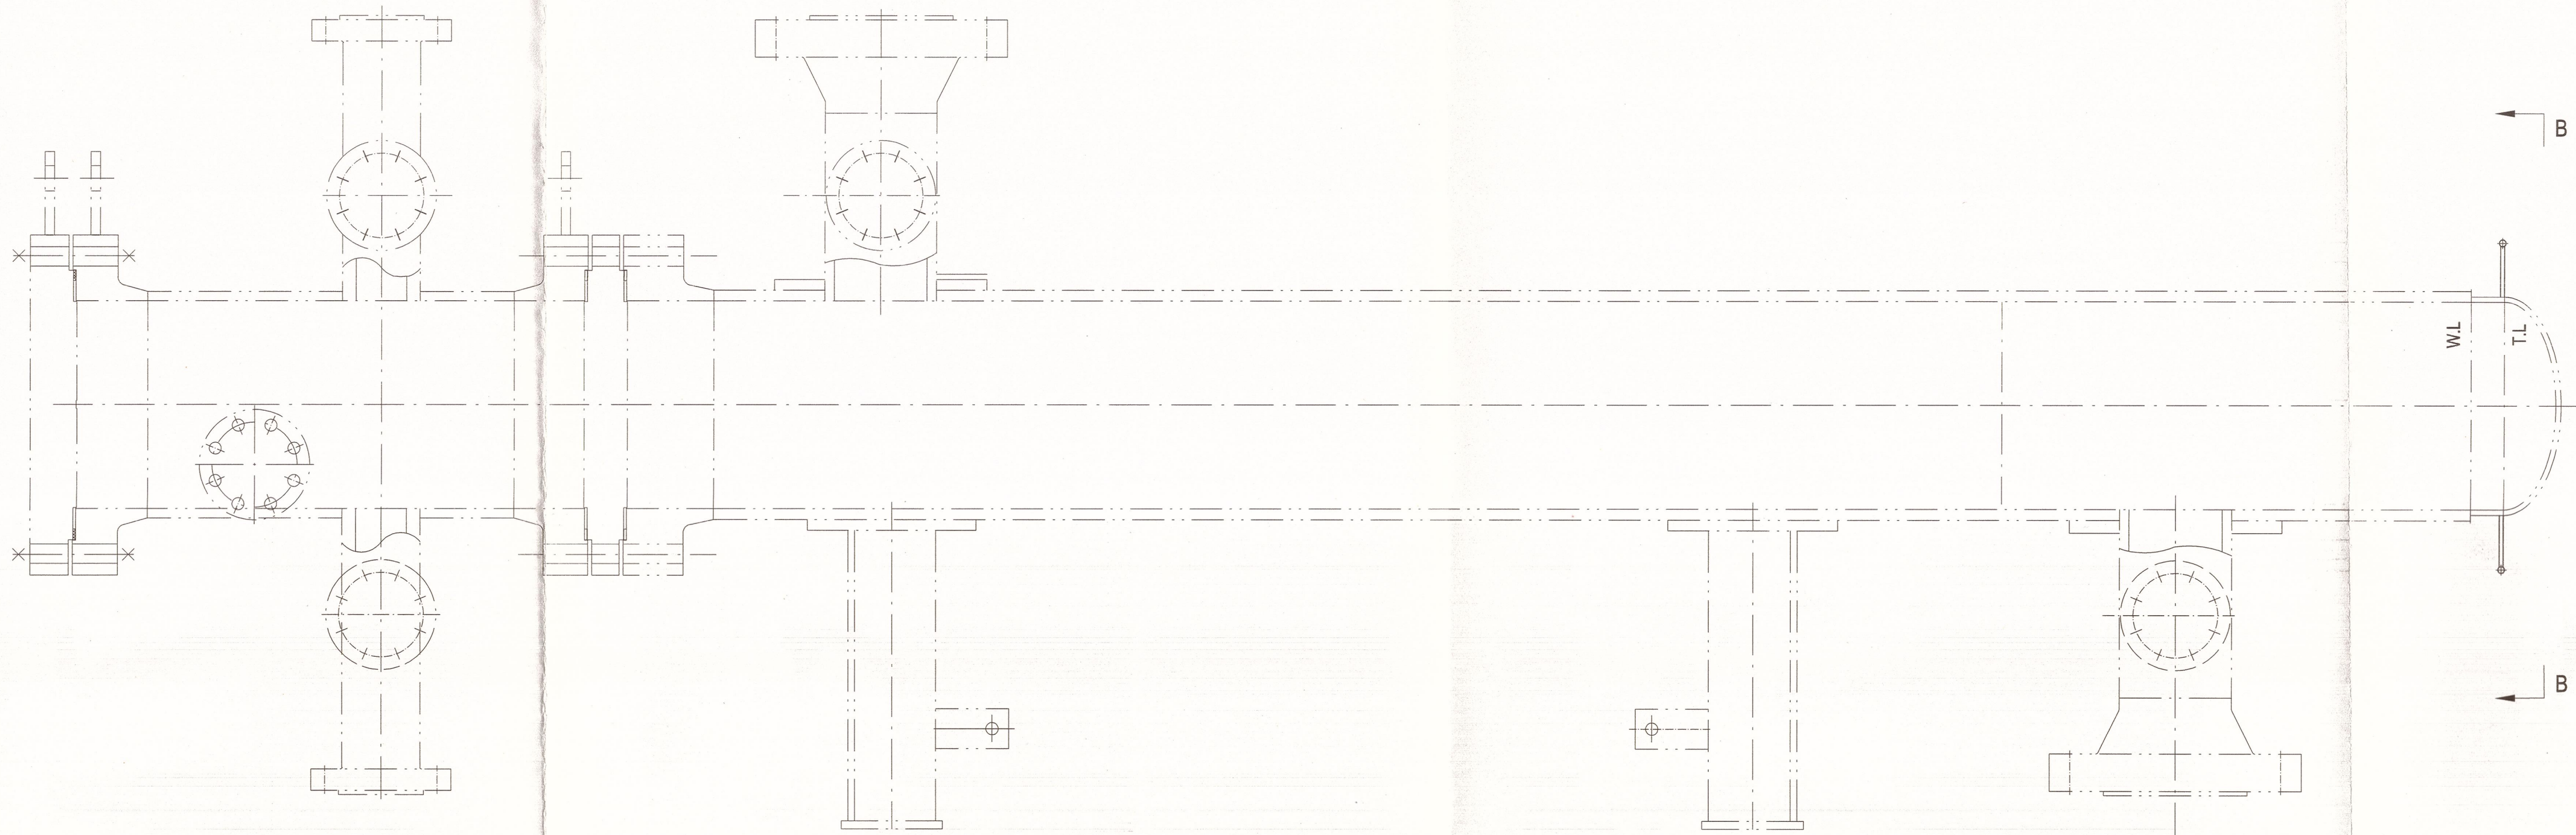


As Built

153		支撑筋板 t=6 INSULATION SUPPORT CLIP	4	SA-240 316L	0.1	1.2	
152		保温支撑环 Ø10 INSULATION SUPPORT RING	1	SA-479 316L		2.1	
151		删除 DELETE					
150		删除 DELETE					
件号 PART NO.	图号或标准号 DWG. OR STD. NO.	名 称 DESCRIPTION	数量 QTY.	材 料 MATERIAL	单件 EACH 重量 WT. (kg)	总计 SUM	备 注 REMARK

AIR PRODUCTS			FLUOR		
Air Products Project Number EN207123			Fluor Project Number A8KM		
Project Name World Energy Renew Utilities US7L			RFQ No. A8KM-4-403-RQ		
Purchase Order Number 4505800575			PO/Contract No A8KM-4-403-PO-6		
Air Products Open Text document number EN207123-WUXI-9V3-00013			Project Area Utilities		
Client WORLD ENERGY PARAMOUNT			Client Doc No:		
03	竣工版/AS BUILT	Hu Wenchao	Shengfang Zhao	Kevin Yang	10-Mar-23
02	供批准/ISSUED FOR APPROVAL	Hu Wenchao	Shengfang Zhao	Kevin Yang	28-Oct-22
01	供批准/ISSUED FOR APPROVAL	Hu Wenchao	Shengfang Zhao	Kevin Yang	29-Sep-22
版次 REV	版次说明/DESCRIPTION	设计/PREPARED	审核/REVIEWED	批准/APPROVED	日期/DATE

The copyright of this drawing is the property of China Wuxi Chemical Equipment Co., Ltd.(WCE), unauthorized disclosure or duplication to the third party is not permitted.					
WCE 无锡化工装备股份有限公司 WUXI CHEMICAL EQUIPMENT CO., LTD.			设计项目 DESIGN ITEM World Energy Renewables Project		
设计 PREPARED 胡文超			设计阶段 DESIGN PHASE 详细设计 Detail Design		
审核 REVIEWED 2023.2.10			设备位号 ITEM NO. 18-X-1804		
批准 APPROVED 2023.2.10			图 号 DWG. NO. WXCE9718-06		
比例: 1:8 SCALE			版 次: 03 REV.		
			第 1 页 共 1 页 PAGE 1 OF 1		

标准铭牌详图
DETAIL OF STANDARD NAME PLATE

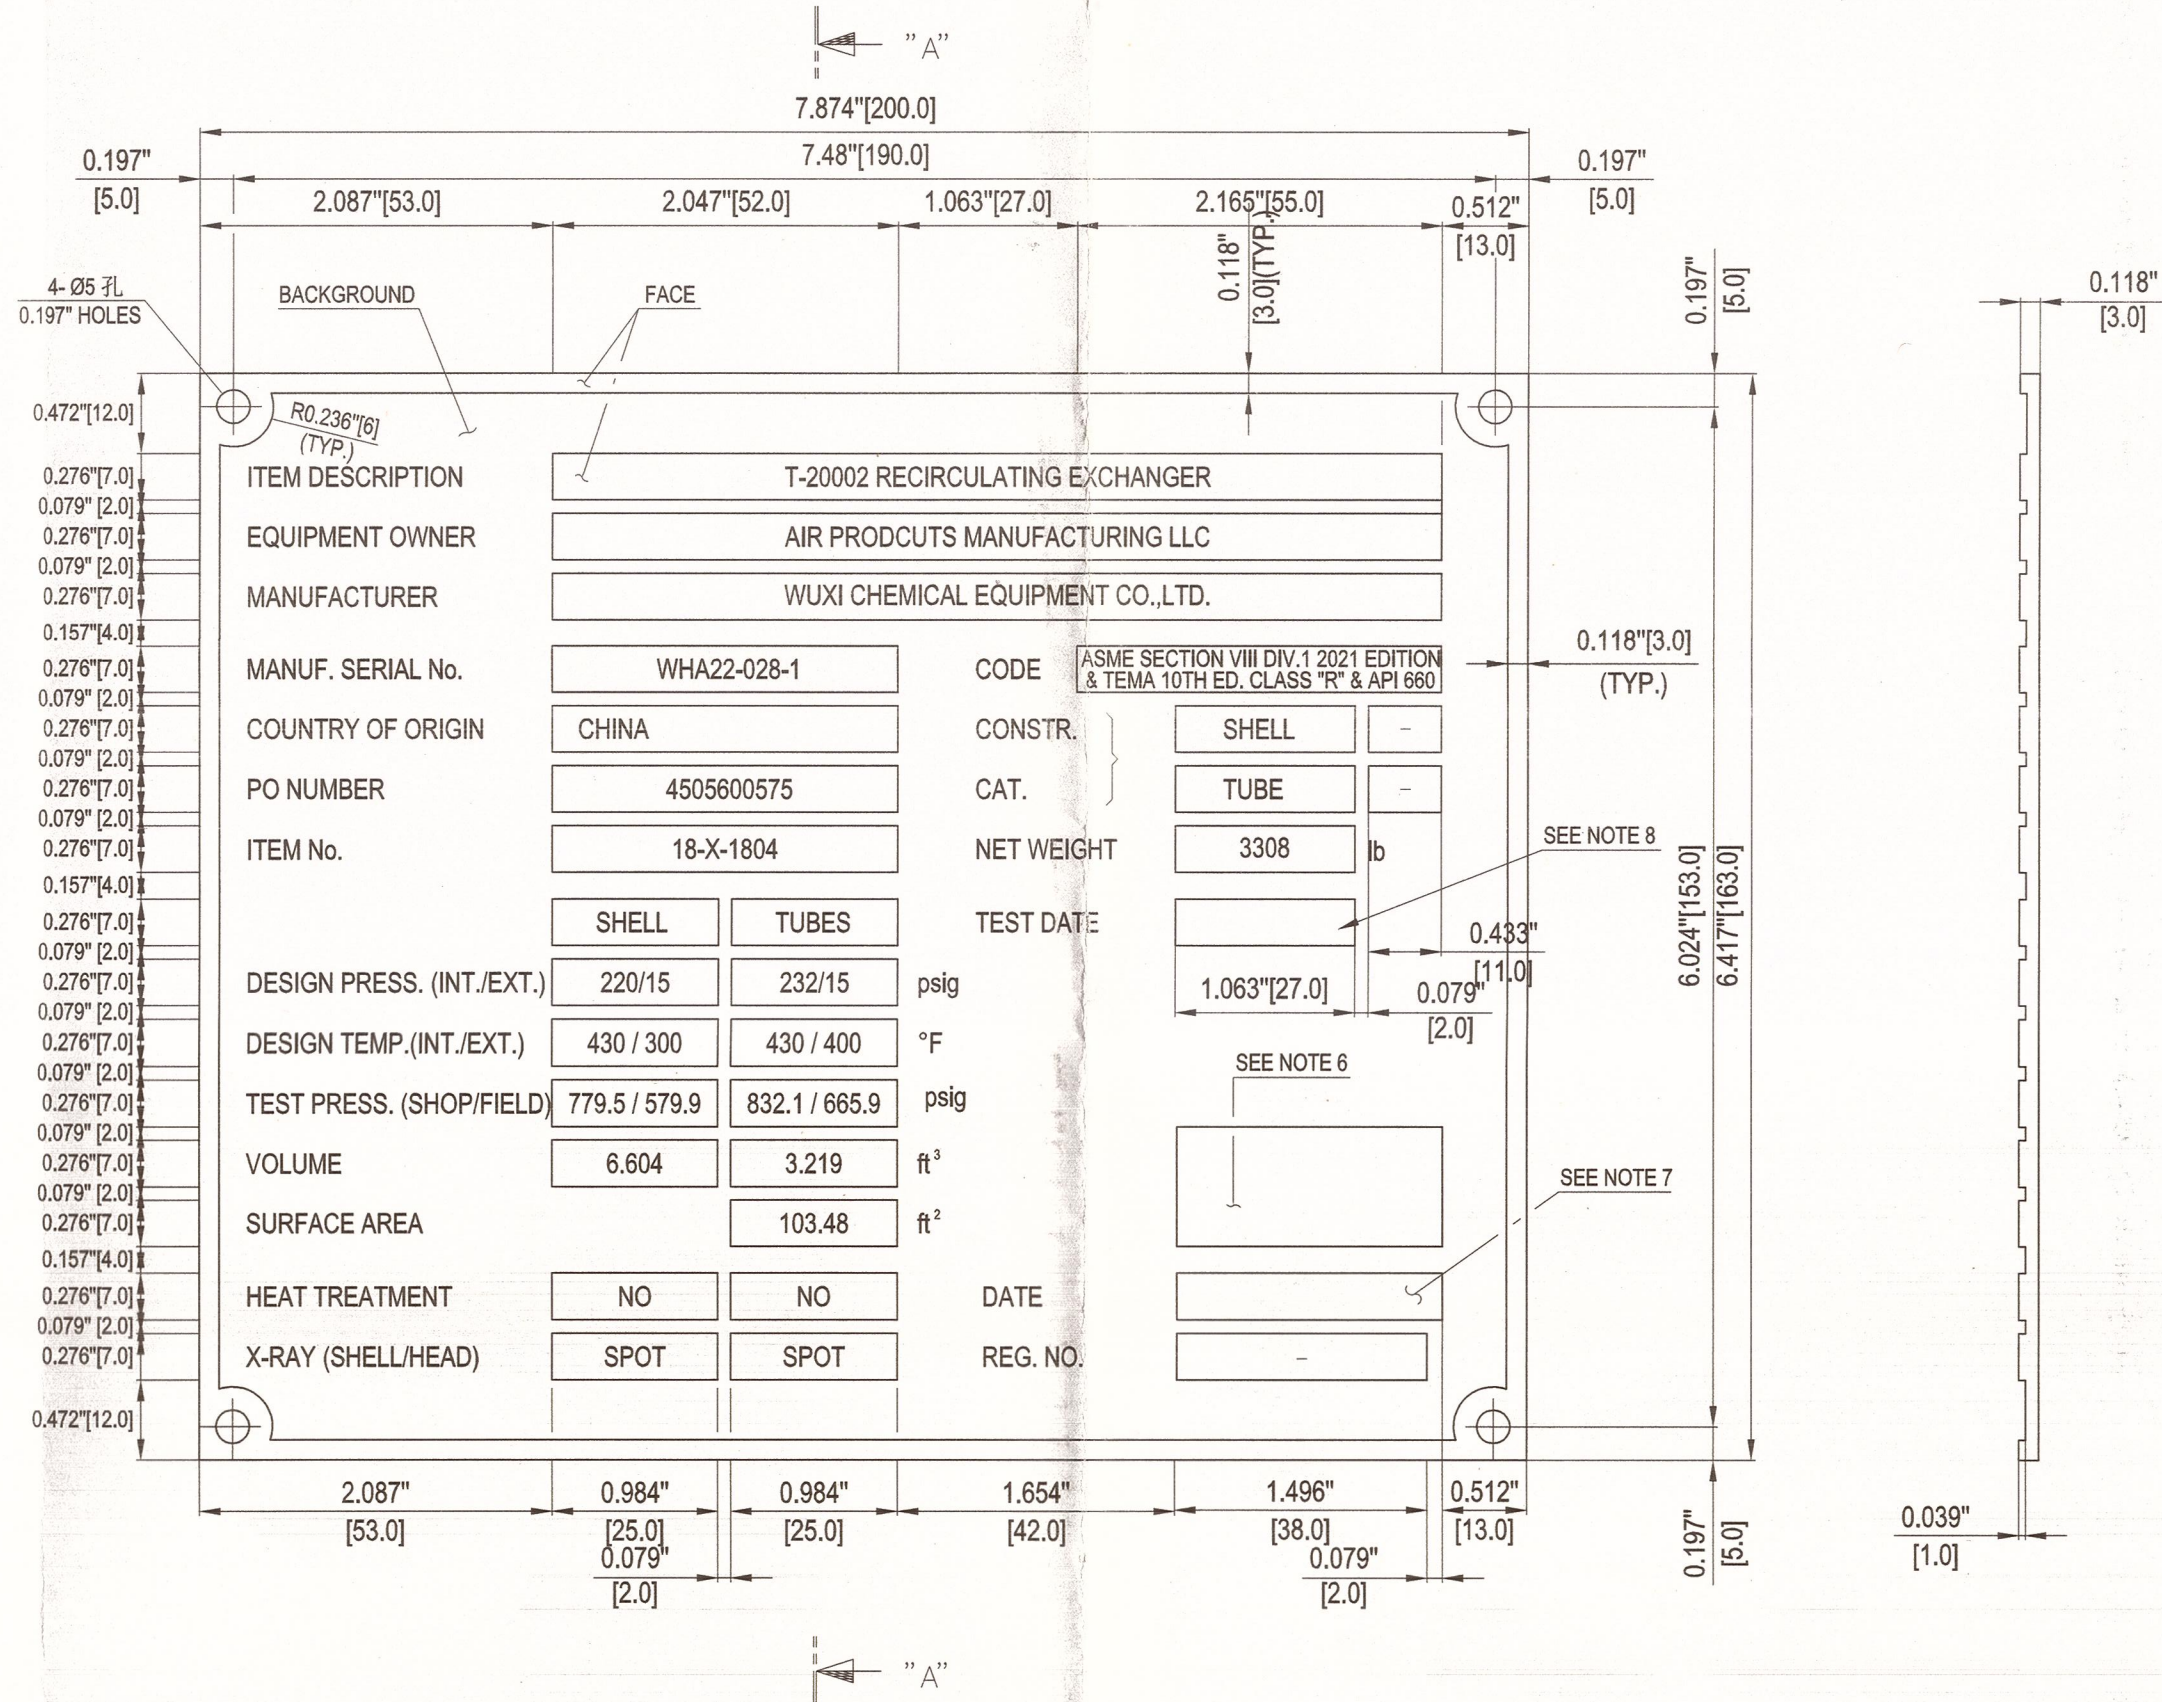

注:

- 除注明外, 所有尺寸均以英制为准, 括号外为英制尺寸, 括号内为米制尺寸。
- 完成后: 铭牌表面抛光处理包括采用铸印字, 背影凸起, 并涂上黑色油漆。
- 日期: 抛光表面要插入的日期 (英文)。标志可用蚀刻或模压方法标在铭牌上, 标志字符高度不小于0.157" [4mm], 字符深度不少于0.004" [0.1mm]。
- 铭牌位置见设备装配图。
- 水压试验后由AI和质量控制检验员一起进行钢印。

*1: *2:

- 批准钢印空间。
- 批准日期。(示例: 2019年3月1日)
- 试验日期指压力试验日期。
- REG. NO.: 注册号。

NOTES



- ALL DIMENSIONS SHALL BE IN US CUSTOMARY UNIT AS PRIMARY UNIT AND METRIC UNIT SHOWN IN BRACKET, UNLESS OTHERWISE SPECIFIED.
- FINISH: "FACE" MACHINED AND POLISHED INCLUDING CAST LETTERING. BACKGROUND KNURLD AND PAINTED BLACK.
- DATE: DATE ON POLISHED SURFACE IS TO BE INSERTED (IN THE ENGLISH LANGUAGE) BY MEANS OF ENGRAVING OR HARD STAMPING AND MUST BE CLEARLY LEGIBLE. THE HEIGHT OF THE LETTERING SHOULD BE APPROX. 0.157" [4mm]. THE DEPTH OF THE LETTERING SHOULD BE APPROX. 0.004" [0.1mm].
- FOR NAME PLATE LOCATION, SEE ASSY DWG. OF EQUIPMENT
- STAMPING SHALL BE MADE BY Q.C INSPECTOR AFTER HYDROSTATIC TEST WITH CONCURRENCE OF AI

*1: *2:

- SPACE FOR AUTHORITY APPROVAL STAMP.
- DATE OF AUTHORITY APPROVAL. (EXAMPLE: 01 MAR 2019)
- TEST DATE MEANS DATE OF PRESSURE TEST.
- REG. NO.: REGISTRATION NUMBER.
- 10 LETTERS AND FIGURES ON ASME NAME PLATES SHALL NOT BE LESS THAN 0.157" (4 MM) HIGH.

SECTION "A"-"A"

ASME 铭牌详图
DETAIL OF ASME NAME PLATE

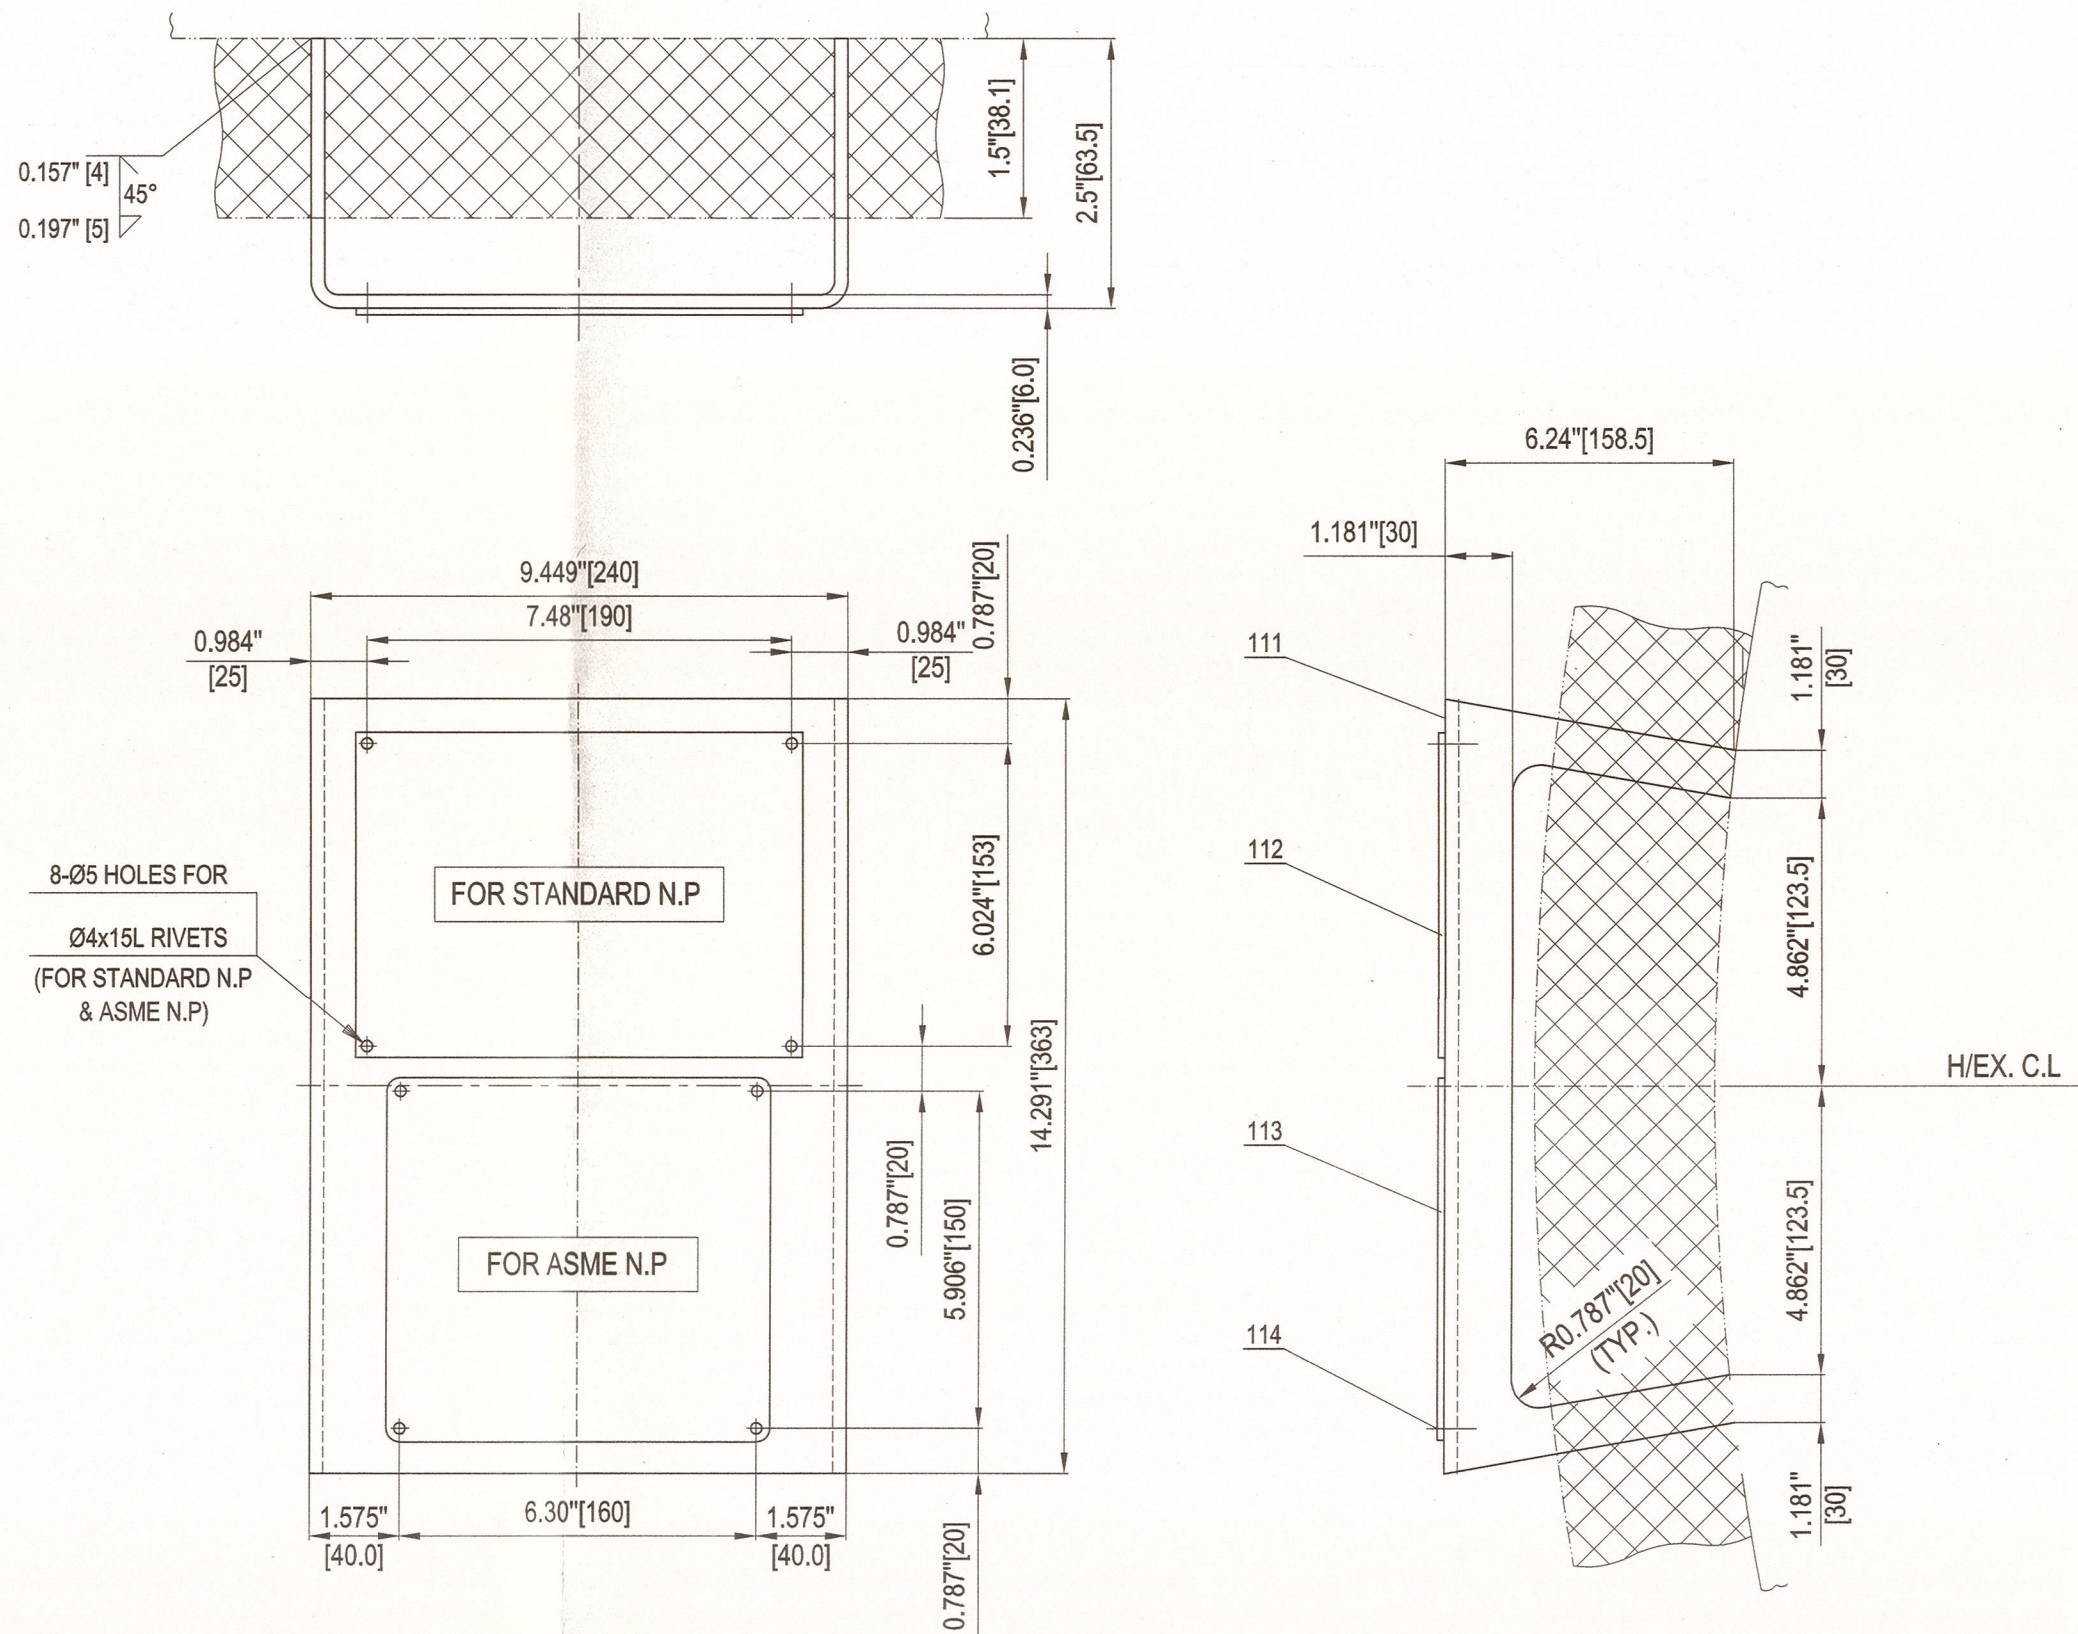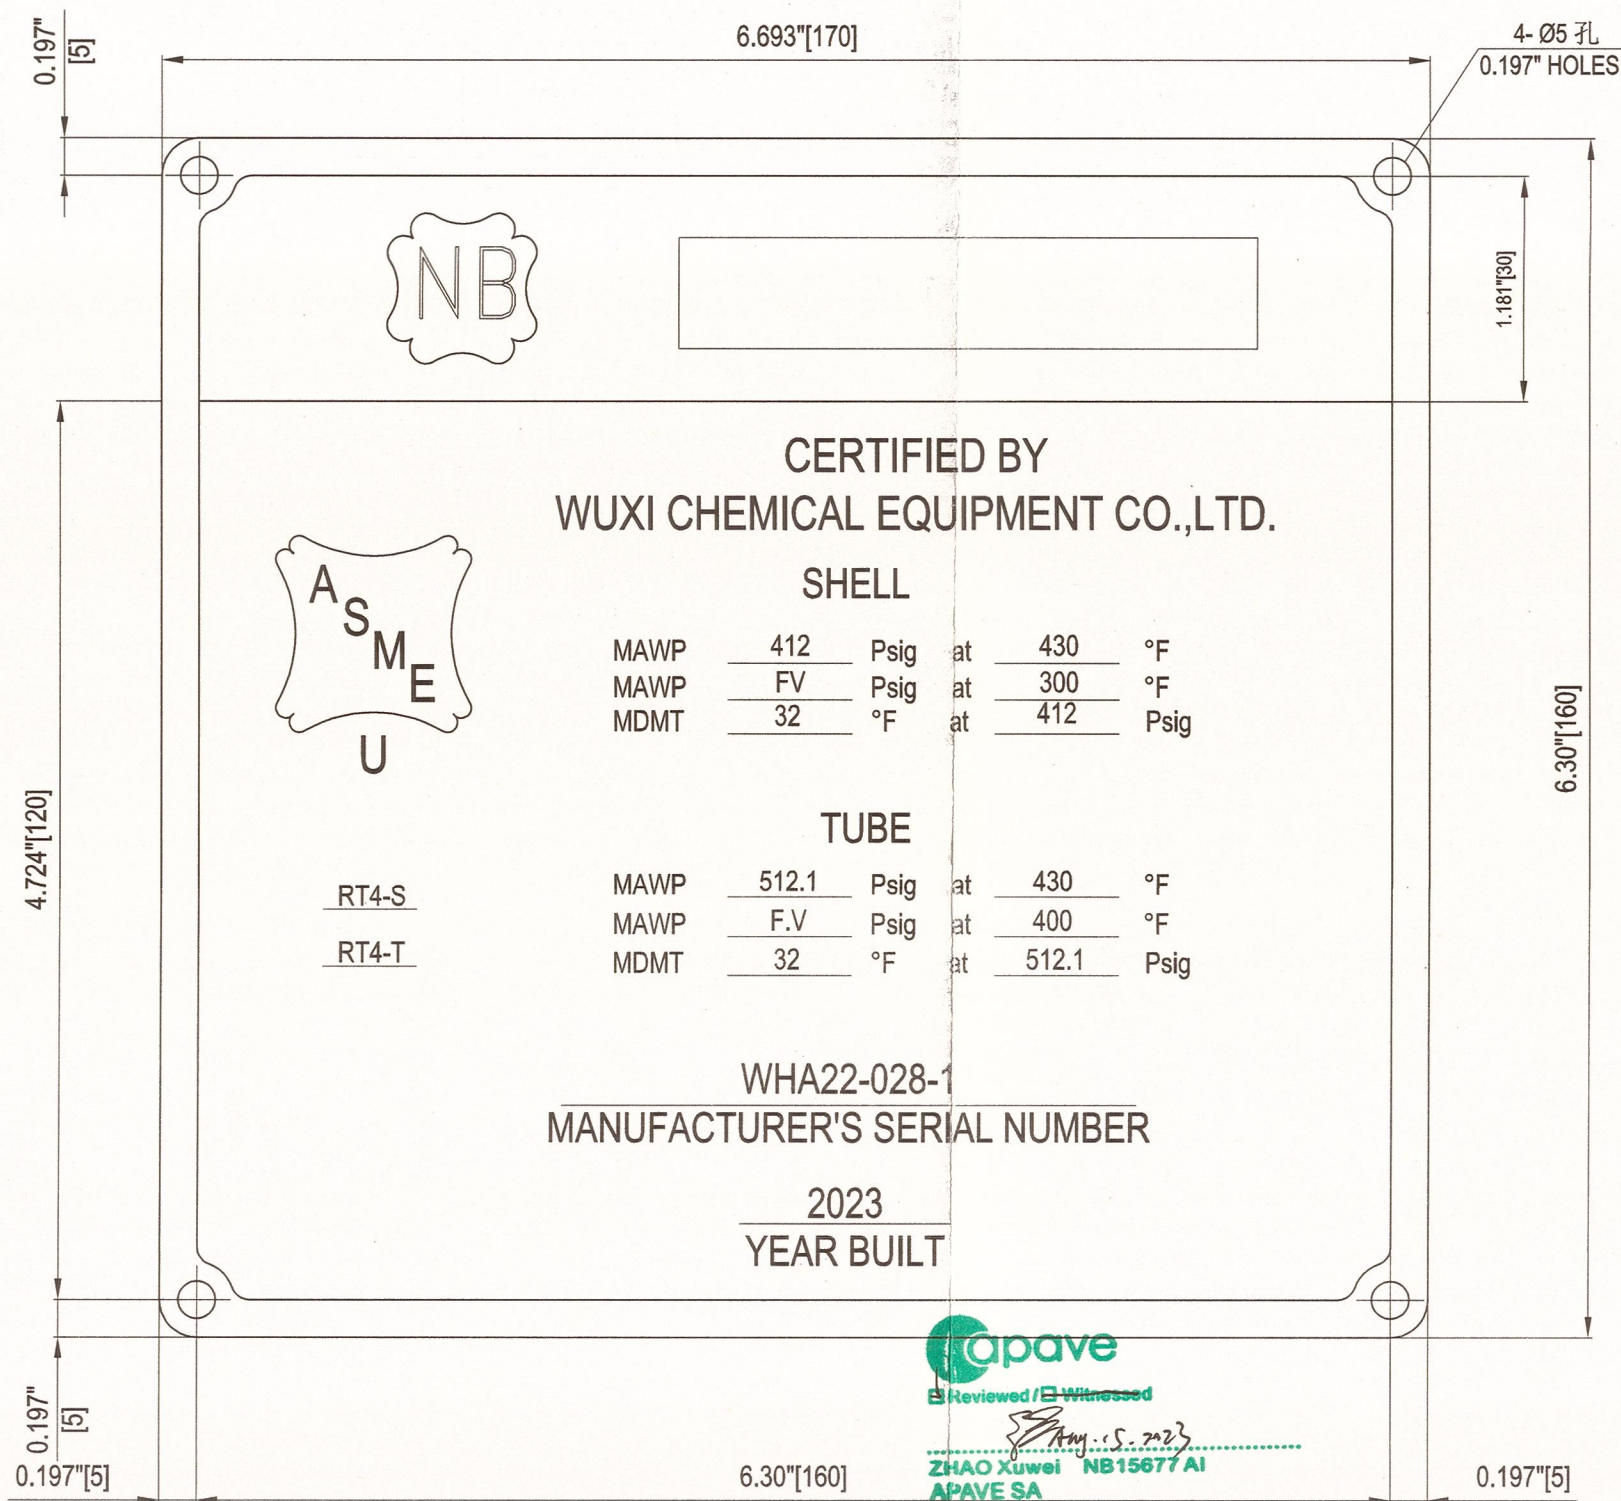

As Built

Engineer in Responsible Charge

Sign: Date: 2023.3.10
(Name)

114		铆钉 Ø4x14 RIVET	8	SS304		/	
113		ASME铭牌 t=3 ASME NAMEPLATE	1	SS304		0.4	
112		标准铭牌 t=3 STANDARD NAMEPLATE	1	SS304		0.7	
111		支架 t=6 BRACKET	1	SA-240 316L		3.9	
件号 PART NO.	图号或标准号 DWG. OR STD. NO.	名 称 DESCRIPTION	数量 QTY.	材 料 MATERIAL	单件EACH 重量 WT. (kg)	总计SUM	备 注 REMARK
AIR PRODUCTS  FLUOR 							
Air Products Project Number		EN207123	Fluor Project Number		A8KM		
Project Name		World Energy Renewables Project	RFQ No.		A8KM-4-403-RQ		
Purchase Order Number		4505800575	PO/Contract No		A8KM-4-403-PC-6		
Air Products Open Text document number		EN207123-WUXI-SV3-00013	Project Area		Utilities		
Client		WORLD ENERGY PARAMOUNT	Client Doc No:				
04	竣工版/AS BUILT	Hu Wenchao	Shengfang Zhao	Kevin Yang	10-Mar-23		
03	供批准/ ISSUED FOR APPROVAL	Hu Wenchao	Shengfang Zhao	Kevin Yang	28-Oct-22		
02	供批准/ ISSUED FOR APPROVAL	Hu Wenchao	Shengfang Zhao	Kevin Yang	29-Sep-22		
01	供批准/ ISSUED FOR APPROVAL	Hu Wenchao	Shengfang Zhao	Kevin Yang	17-Jun-22		
版次 REV	版次说明/DESCRIPTION		设计/PREPARED	审核/REVIEWED	批准/APPROVED	日期/DATE	

WCE 无锡化工装备股份有限公司 WUXI CHEMICAL EQUIPMENT CO., LTD.		设计项目 DESIGN ITEM	World Energy Renewables Project
设 计 PREPARED	审核 REVIEWED	设计阶段 DESIGN PHASE	详细设计 Detail Design
审 核 REVIEWED	批 准 APPROVED	设备位号 ITEM NO.	18-X-1804
图 号 DWG. NO.		图 号 DWG. NO.	WXCE8718-05
比例: 1:6 SCALE		版 次: 04 REV.	第 1 页 共 1 页 PAGE 1 OF 1