



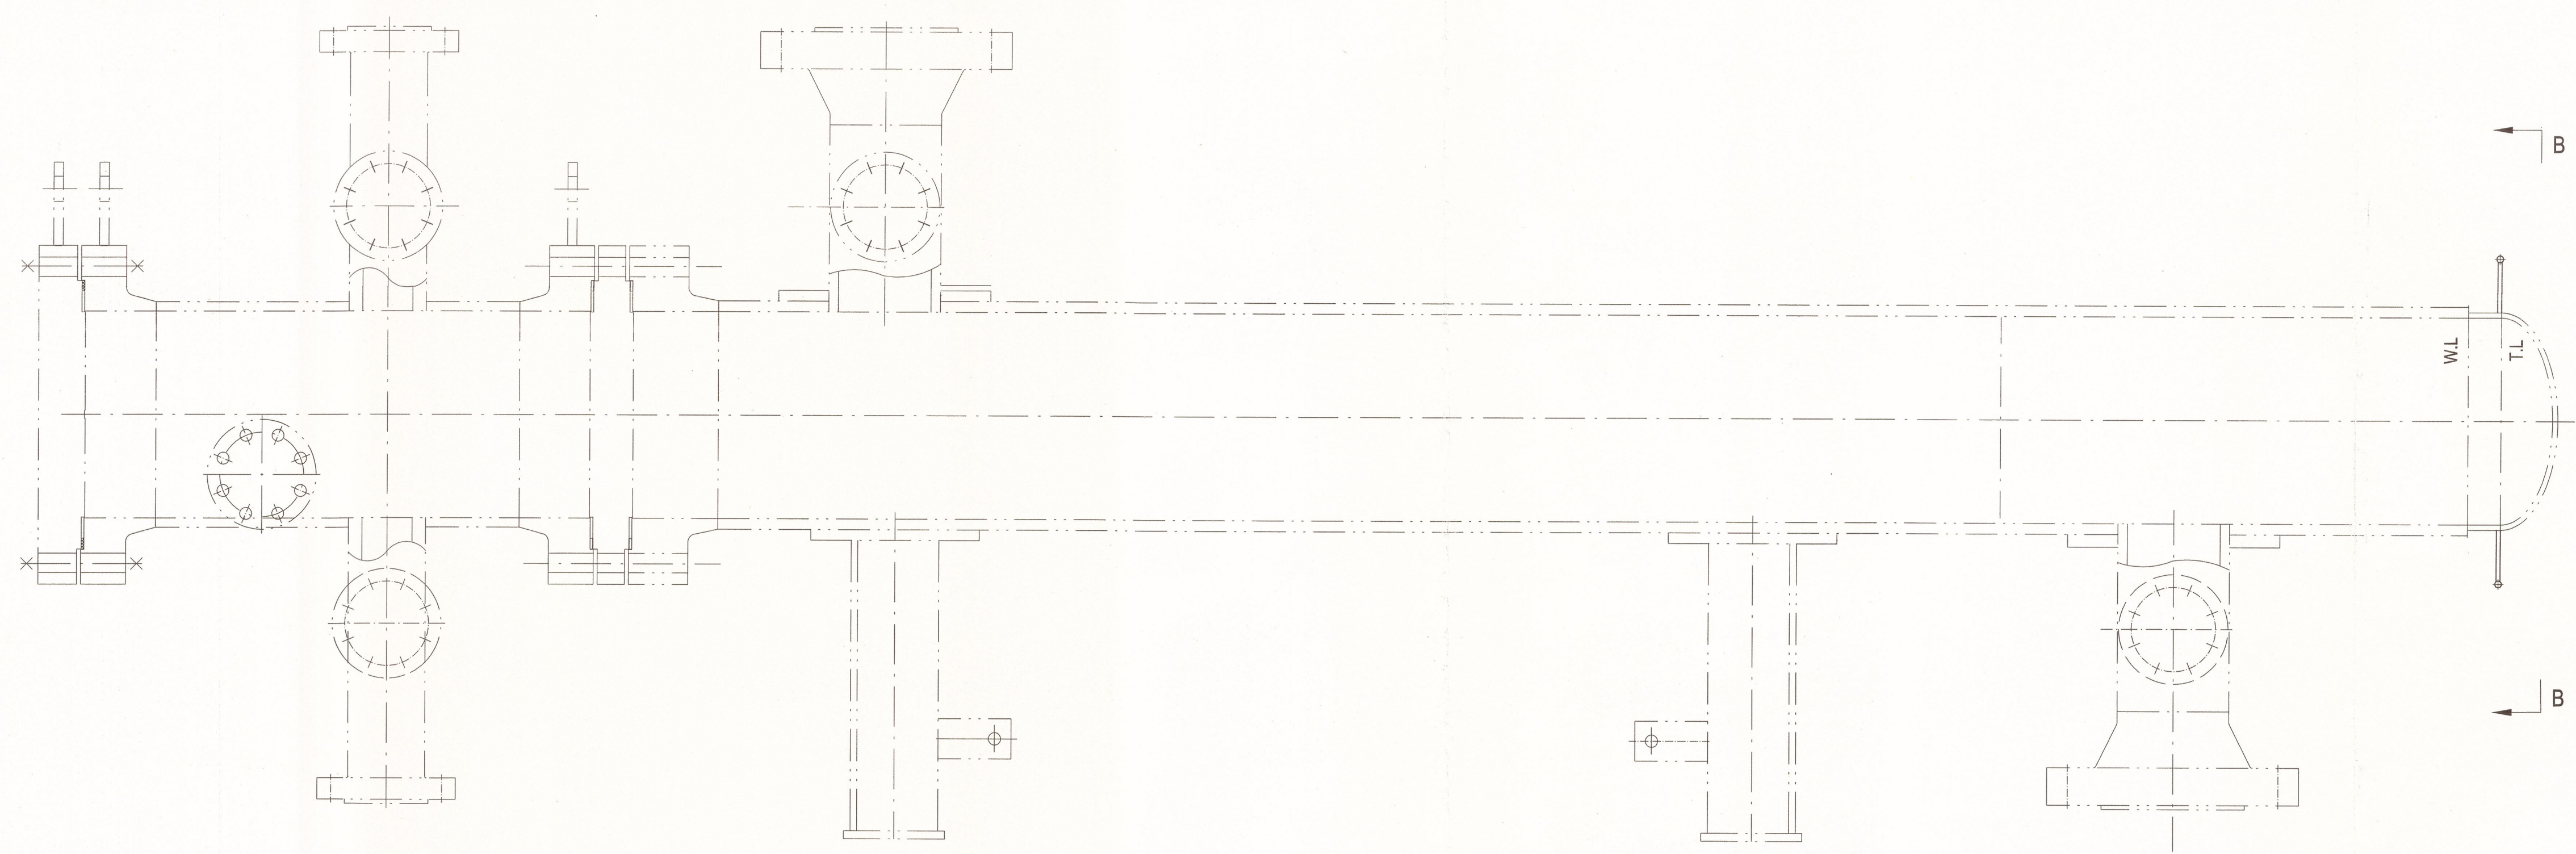

B
WL
TL
B

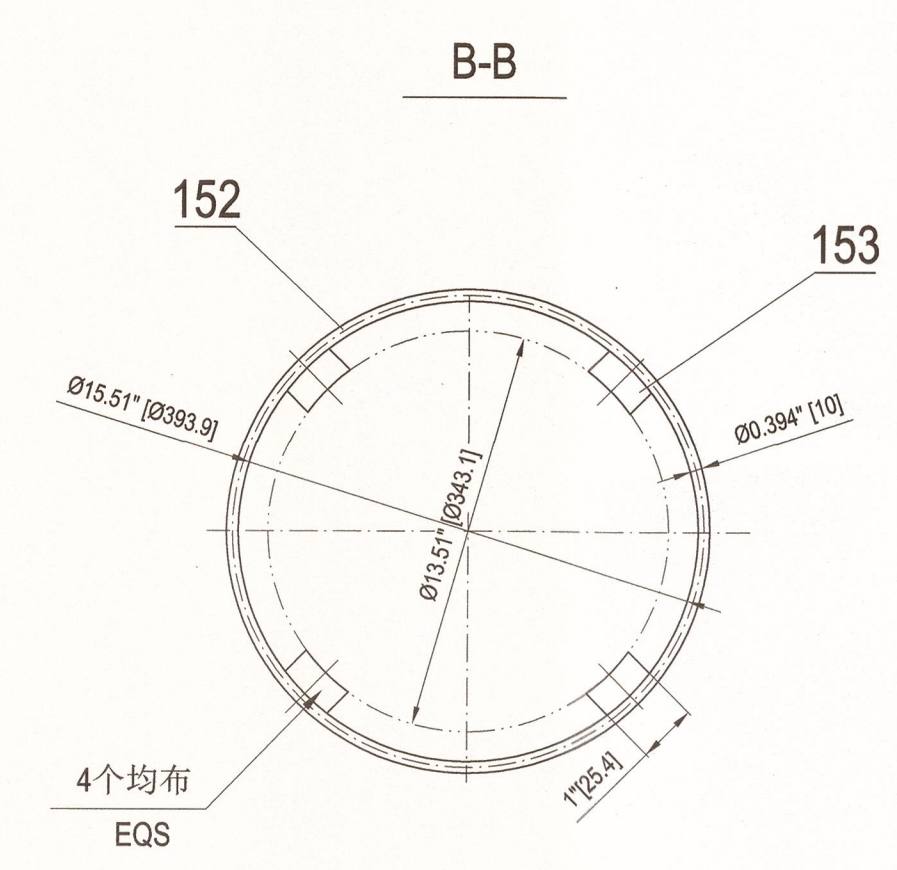

As Built

153	支撑筋板 t=6 INSULATION SUPPORT CLIP	4	SA-240 316L	0.1	1.2	
152	保温支撑环 Ø10 INSULATION SUPPORT RING	1	SA-479 316L		2.1	
151	删除 DELETE					
150	删除 DELETE					
件号 PART NO.	图号或标准号 DWG. OR STD. NO.	名 称 DESCRIPTION	数量 QTY.	材 料 MATERIAL	单件 EACH 重量 WT. (kg)	总计 SUM 备 注 REMARK
AIR PRODUCTS			FLUOR			
Air Products Project Number		EN207123	Fluor Project Number		A8KM	
Project Name		World Energy Renew Utilities US7L	RFQ No.		A8KM-4-403-RQ	
Purchase Order Number		4505600575	PO/Contract No		A8KM-4-403-PO-6	
Air Products Open Text document number		EN207123-WUXI-9V3-00014	Project Area		Utilities	
Client		WORLD ENERGY PARAMOUNT	Client Doc No:			
03	竣工版/AS BUILT		Hu Wenchao	Shengfang Zhao	Kevin Yang	10-Mar-23
02	供批准/ ISSUED FOR APPROVAL		Hu Wenchao	Shengfang Zhao	Kevin Yang	28-Oct-22
01	供批准/ ISSUED FOR APPROVAL		Hu Wenchao	Shengfang Zhao	Kevin Yang	29-Sep-22
版次: REV.	版次说明/DESCRIPTION		设计/PREPARED	审核/REVIEWED	批准/APPROVED	日期/DATE
本图纸版权为无锡化工装备股份有限公司财产,未经本公司许可不得转让或复制给第三方。 The copyright of this drawing is the property of China Wuxi Chemical Equipment Co.,Ltd.(WCE),unauthorized disclosure or duplication to the third party is not permitted.						
WCE 无锡化工装备股份有限公司 WUXI CHEMICAL EQUIPMENT CO., LTD.			设计项目 DESIGN ITEM		World Energy Renewables Project	
			设计阶段 DESIGN PHASE		详细设计 Detail Design	
设 计 PREPARED	胡文超	2022.2.10	T-20003 Recirculating Exchanger		设备位号 ITEM NO.	18-X-1805
审 核 REVIEWED	2023.3.10	INSULATION SUPPORT DETAIL DRAWING		图 号 DWG. NO.	WXCE8719-06	
批 准 APPROVED	2023.3.10	比 例: SCALE	1:8	版 次: REV.	03	第 1 页 共 1 页 PAGE 1 OF 1