
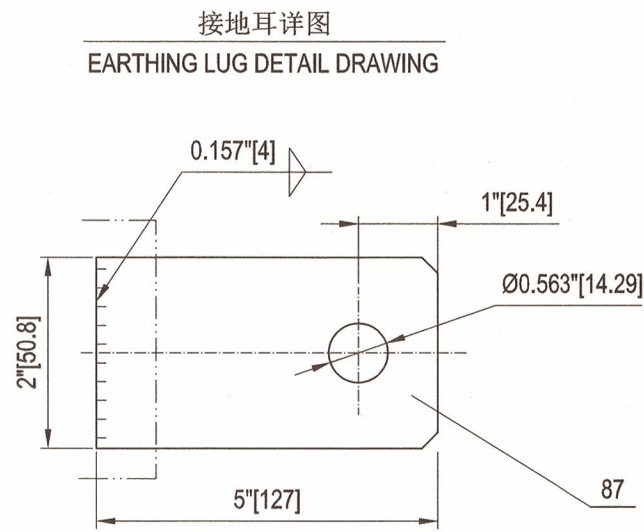
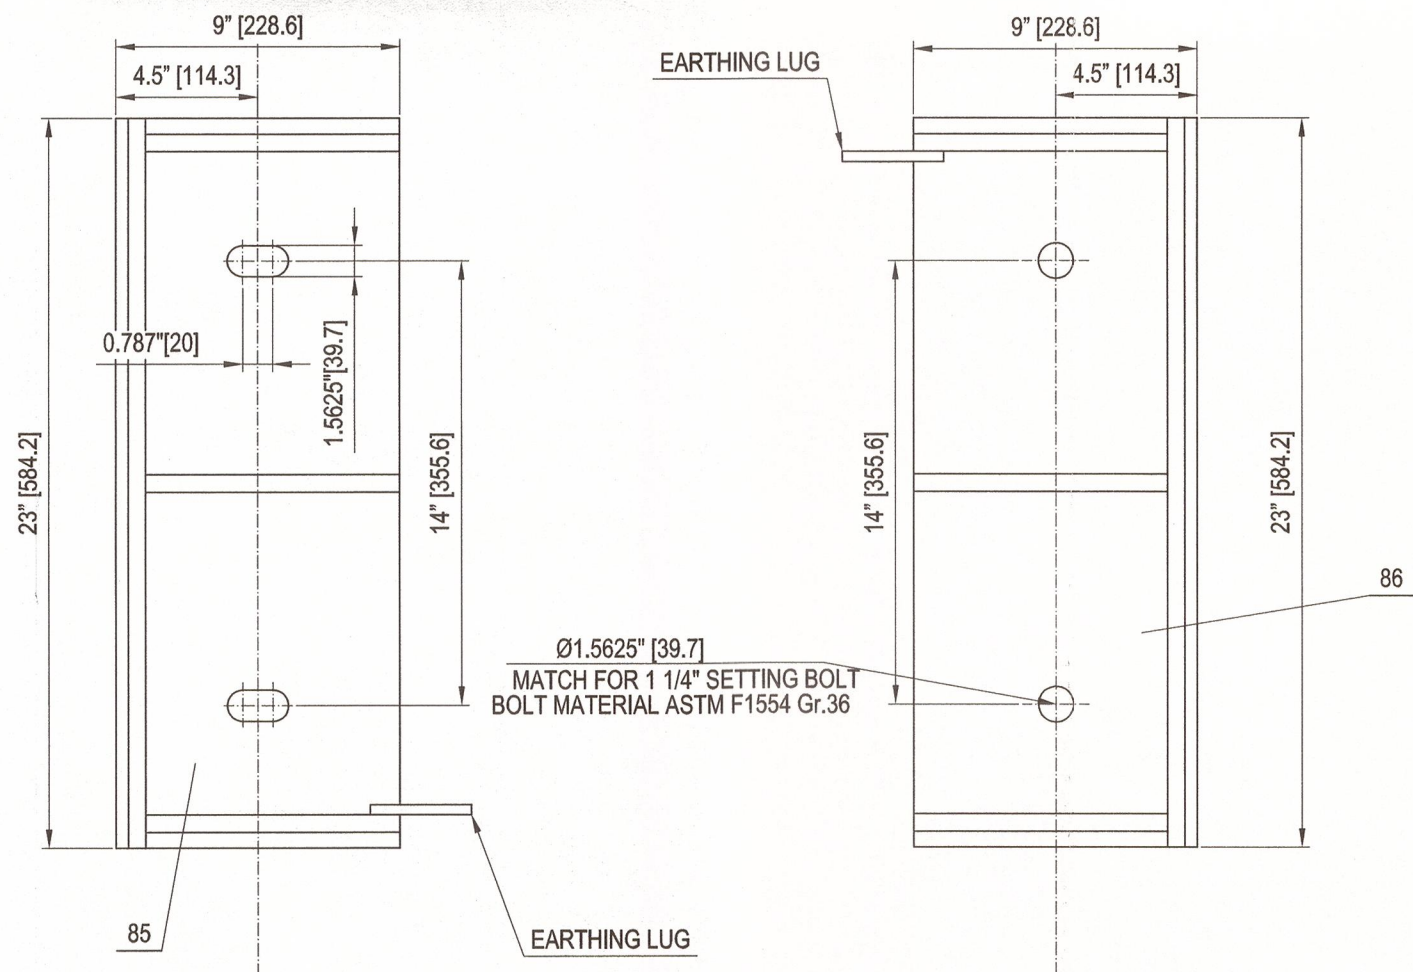
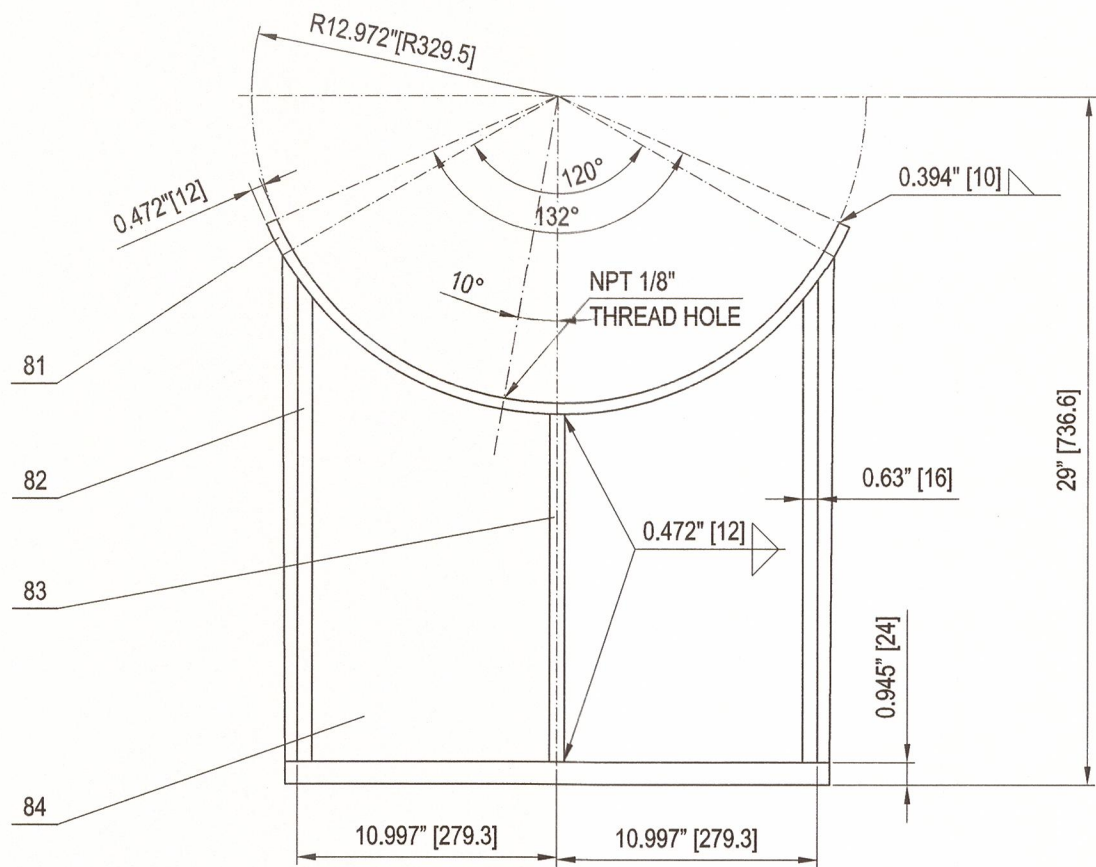


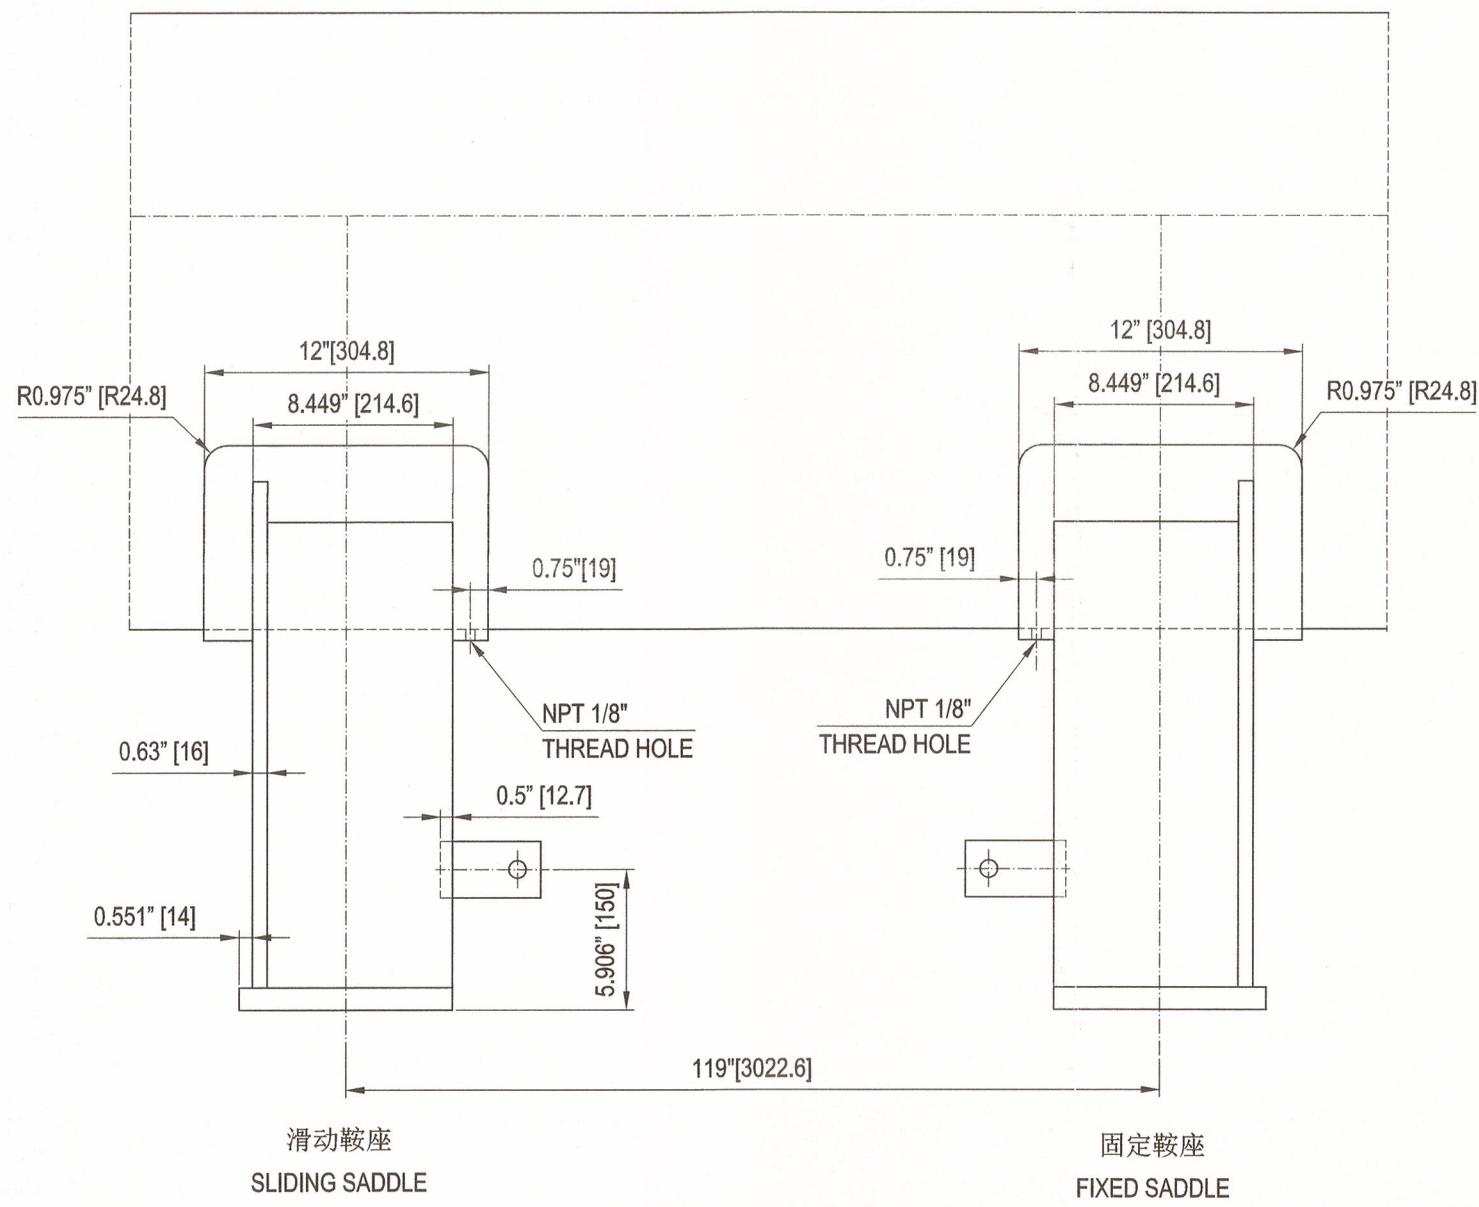

As Built

87		接地耳 t=6 EARTHING LUG	2	SA-240 304	0.2	0.4	
86		底板 t=24 BASE PLATE	1	SA-516 Gr.70N		25.0	
85		底板 t=24 BASE PLATE	1	SA-516 Gr.70N		25.0	
84		筋板 t=16 RIB PLATE	2	SA-516 Gr.70N	3.0	6.0	
83		腹板 t=16 WEB PLATE	2	SA-516 Gr.70N	25.7	51.4	
82		筋板 t=16 RIB PLATE	4	SA-516 Gr.70N	6.5	26.0	
81		垫板 t=12 WEAR PLATE	2	SA-516 Gr.70N	25.2	50.4	
件号 PART NO.	图号或标准号 DWG.NO.OR STD.NO.	名称 DESIGNATION	数量 QTY.	材料 MATERIAL	单重 WEIGHT (kg)	总重 TOTAL WEIGHT	备注 REMARKS

AIR PRODUCTS				FLUOR			
Air Products Project Number		EN207123		Fluor Project Number		A8KM	
Project Name		World Energy Renew Utilities US7L		RFQ No.		A8KM-4403-RQ	
Purchase Order Number		4505600575		PO/Contract No		A8KM-4403-PO-6	
Air Products Open Text document number		EN207123-WUXI-9V3-00155		Project Area		Utilities	
Client		WORLD ENERGY PARAMOUNT		Client Doc No:			
05	竣工版/AS BUILT		Hu Wenchao	Shengfang Zhao	Kevin Yang	27-Mar-23	
04	供批准/ISSUED FOR APPROVAL		Hu Wenchao	Shengfang Zhao	Kevin Yang	17-Nov-22	
03	供批准/ISSUED FOR APPROVAL		Hu Wenchao	Shengfang Zhao	Kevin Yang	13-Sep-22	
02	供批准/ISSUED FOR APPROVAL		Hu Wenchao	Shengfang Zhao	Kevin Yang	16-Aug-22	
01	供批准/ISSUED FOR APPROVAL		Hu Wenchao	Shengfang Zhao	Kevin Yang	16-Jun-22	
版次 REV		版次说明/DESCRIPTION		设计/PREPARED		审核/REVIEWED	批准/APPROVED 日期/DATE
本图纸版权为无锡化工装备股份有限公司财产, 未经本公司许可不得借出或复制或修改第三方。 The copyright of this drawing is the property of China Wuxi Chemical Equipment Co., Ltd. (WCE). Unauthorized disclosure or duplication to the third party is not permitted.							
WCE 无锡化工装备股份有限公司 WUXI CHEMICAL EQUIPMENT CO., LTD.				设计项目 DESIGN ITEM		World Energy Renewables Project	
				设计阶段 DESIGN PHASE		详细设计 Detail Design	
设计 PREPARED	胡文超		2023.3.27	Caustic Dilution Cooler		设备位号 ITEM NO.	
审核 REVIEWED	赵胜芳		2023.3.27	SADDLE DETAIL DRAWING		图号 DWG. NO.	
批准 APPROVED	孙文超		2023.3.27	比例 SCALE	NA	版次 REV.	05
						第 1 页 共 1 页 PAGE 1 OF 1	