
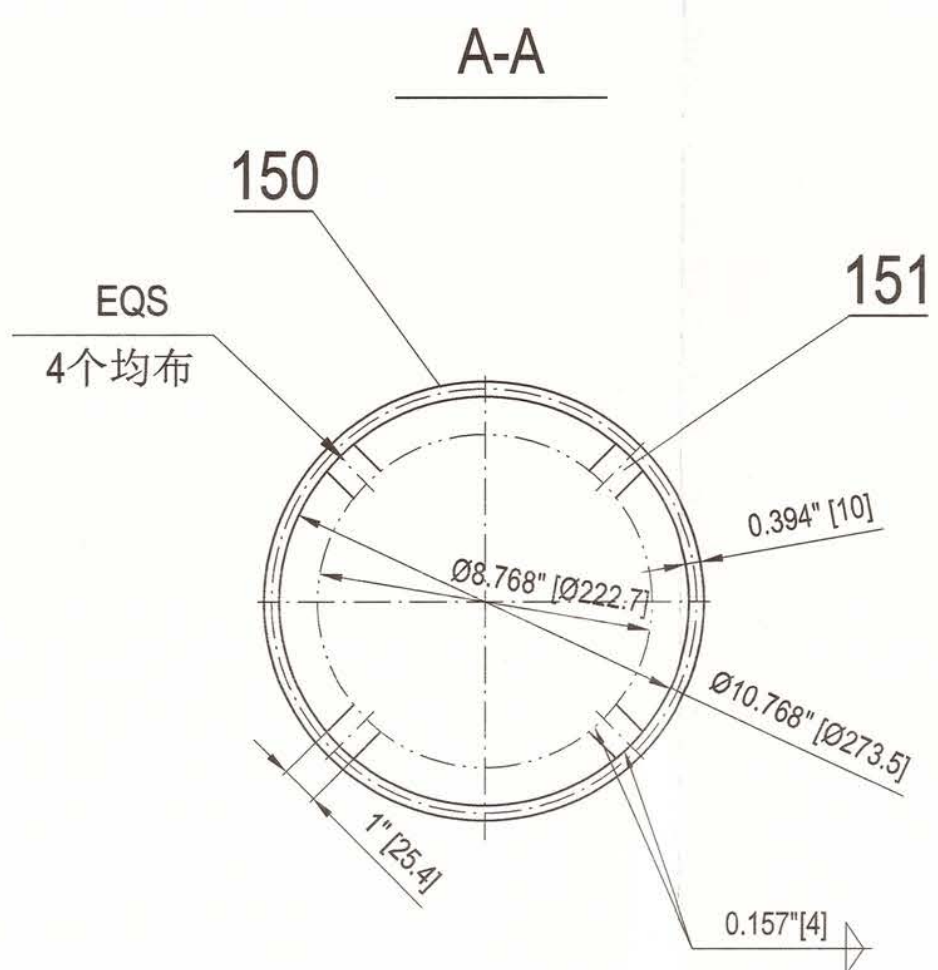


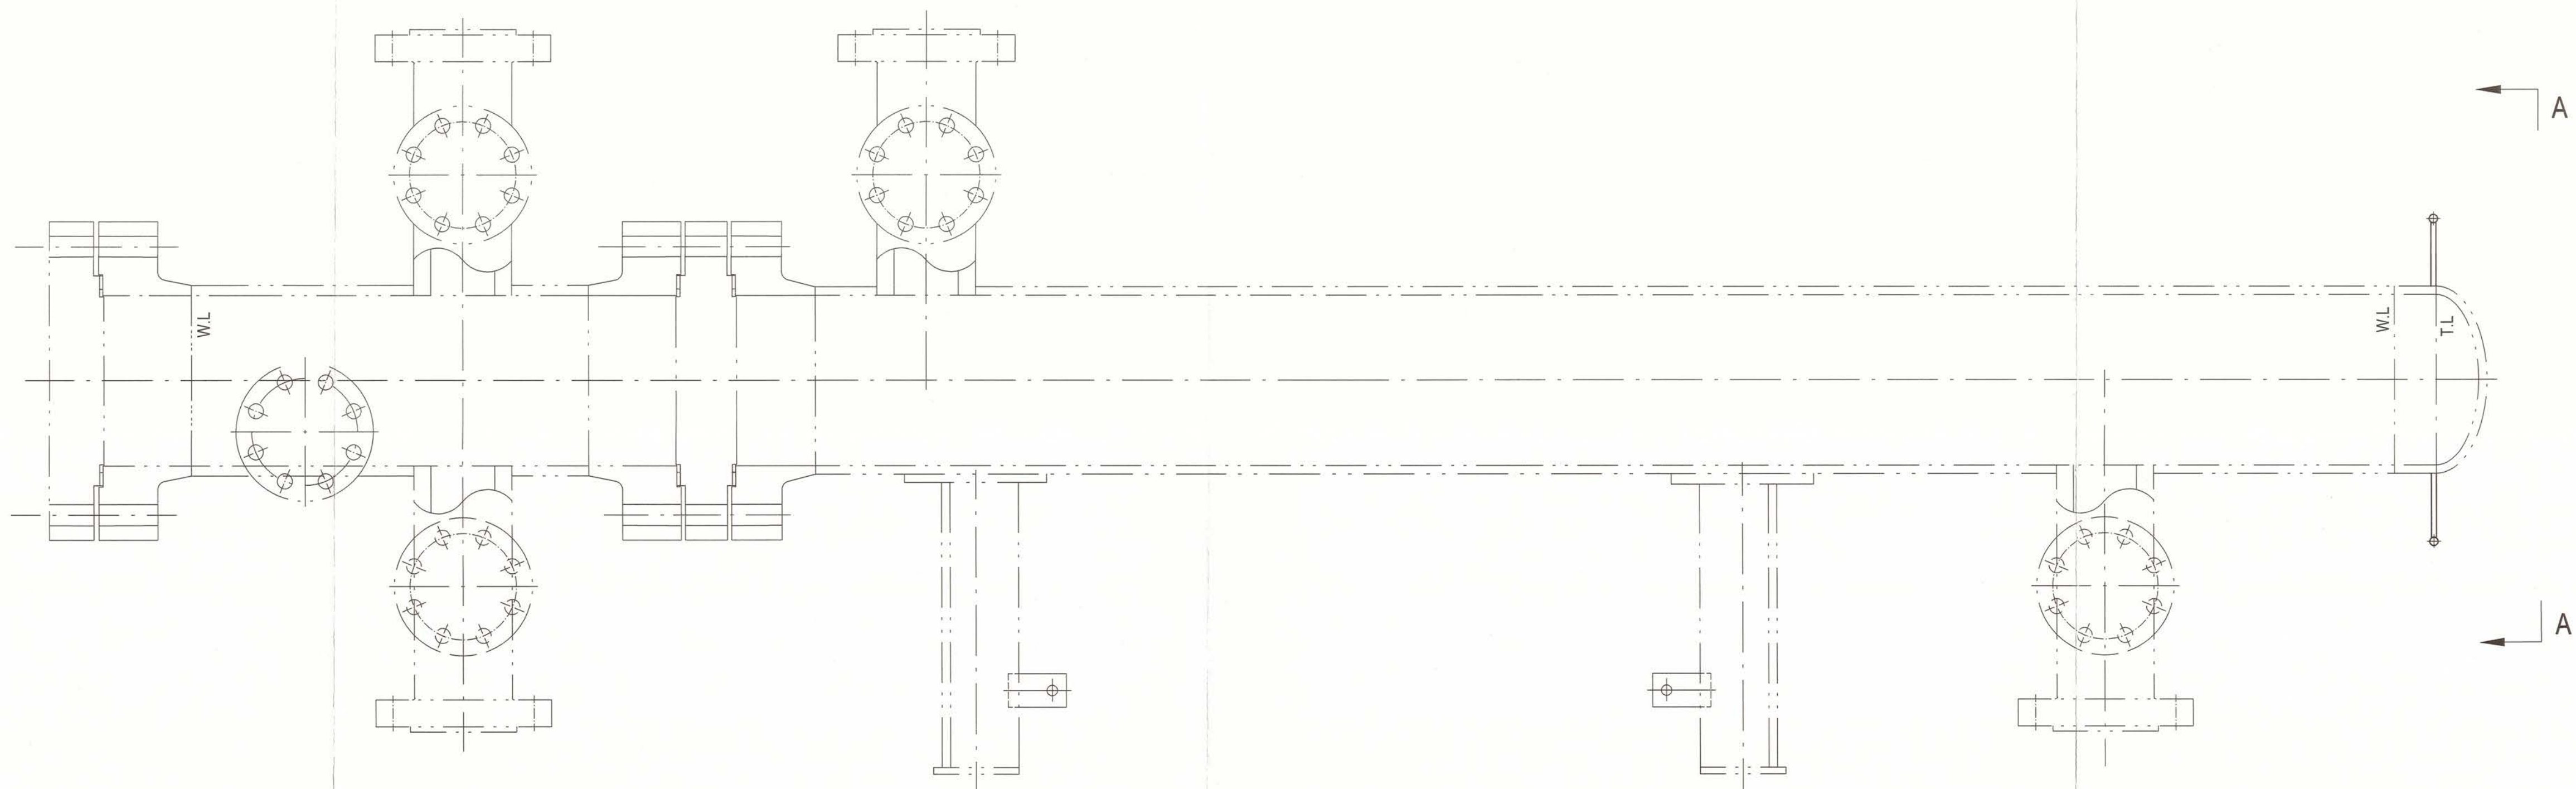

|                                                                                                                                                                                                                         |                            |                                      |                                   |                      |                        |                                    |                            |
|-------------------------------------------------------------------------------------------------------------------------------------------------------------------------------------------------------------------------|----------------------------|--------------------------------------|-----------------------------------|----------------------|------------------------|------------------------------------|----------------------------|
| 151                                                                                                                                                                                                                     |                            | 支撑筋板 t=6<br>INSULATION SUPPORT CLIP  | 4                                 | SA-240.S32205        | 0.1                    | 1.2                                |                            |
| 150                                                                                                                                                                                                                     |                            | 保温支撑环 Ø10<br>INSULATION SUPPORT RING | 1                                 | SA-479.S32205        |                        | 2.1                                |                            |
| 件号<br>PART NO.                                                                                                                                                                                                          | 图号或标准号<br>DWG. OR STD. NO. | 名 称<br>DESCRIPTION                   | 数量<br>QTY.                        | 材 料<br>MATERIAL      | 单件 EACH<br>重量 WT. (kg) | 总计 SUM<br>重量 WT. (kg)              | 备注<br>REMARK               |
| AIR PRODUCTS                                                                                                                                                                                                            |                            |                                      | FLUOR                             |                      |                        |                                    |                            |
| Air Products Project Number                                                                                                                                                                                             |                            | EN207131                             |                                   | Fluor Project Number |                        | A8KM                               |                            |
| Project Name                                                                                                                                                                                                            |                            | World Energy Renewables Project      |                                   | RFQ No.              |                        | A8KM-4-412-RQ                      |                            |
| Purchase Order Number                                                                                                                                                                                                   |                            | 4505729451                           |                                   | PO/Contract No.      |                        | A8KM-4-412-PO-1                    |                            |
| Air Products Open Text<br>document number                                                                                                                                                                               |                            | EN207131-WUXI-9V3-00026              |                                   | Project Area         |                        | Utilities                          |                            |
| Client                                                                                                                                                                                                                  |                            | WORLD ENERGY PARAMOUNT               |                                   | Client Doc No:       |                        |                                    |                            |
| 03                                                                                                                                                                                                                      | 竣工图/AS BUILT               |                                      | WenChao Hu                        | Shengfang Zhao       | Kevin Yang             | 12-May-23                          |                            |
| 02                                                                                                                                                                                                                      | 供批准/ISSUED FOR APPROVAL    |                                      | WenChao Hu                        | Shengfang Zhao       | Kevin Yang             | 17-Feb-23                          |                            |
| 01                                                                                                                                                                                                                      | 供批准/ISSUED FOR APPROVAL    |                                      | WenChao Hu                        | Shengfang Zhao       | Kevin Yang             | 17-Oct-22                          |                            |
| 00                                                                                                                                                                                                                      | 供批准/ISSUED FOR APPROVAL    |                                      | WenChao Hu                        | Shengfang Zhao       | Kevin Yang             | 30-Jun-22                          |                            |
| 版次 REV                                                                                                                                                                                                                  |                            | 版次说明/DESCRIPTION                     |                                   | 设计/DESIGNED          |                        | 审核/REVIEWED                        |                            |
|                                                                                                                                                                                                                         |                            |                                      |                                   | 批准/APPROVED          |                        | 日期/DATE                            |                            |
| 本图版权为无锡化工装备股份有限公司所有,未经本公司许可不得转让或复制给第三方.<br>The copyright of this drawing is the property of China Wuxi Chemical Equipment Co.,Ltd.(WCE) and unauthorized disclosure or duplication to the third party is not permitted. |                            |                                      |                                   |                      |                        |                                    |                            |
| WCE 无锡化工装备股份有限公司<br>WUXI CHEMICAL EQUIPMENT CO., LTD.                                                                                                                                                                   |                            |                                      |                                   | 设计项目<br>DESIGN ITEM  |                        | World Energy<br>Renewables Project |                            |
|                                                                                                                                                                                                                         |                            |                                      |                                   | 设计阶段<br>DESIGN PHASE |                        | 详细设计<br>Detail Design              |                            |
|                                                                                                                                                                                                                         |                            |                                      |                                   | 设备位号<br>ITEM NO.     |                        | 18-X-1811                          |                            |
|                                                                                                                                                                                                                         |                            |                                      |                                   | 图 号<br>DWG. NO.      |                        | WXCE6884-06                        |                            |
| 设计<br>PREPARED                                                                                                                                                                                                          | 日期/DATE                    | 2023.5.12                            | T-2002 Recirculating Exchanger    |                      |                        |                                    |                            |
| 审核<br>REVIEWED                                                                                                                                                                                                          | 日期/DATE                    | 2023.5.12                            | INSULATION SUPPORT DETAIL DRAWING |                      |                        |                                    |                            |
| 批准<br>APPROVED                                                                                                                                                                                                          | 日期/DATE                    | 2023.5.12                            | 比例<br>SCALE                       | 1:6                  | 版次<br>REV.             | 03                                 | 第 1 页 共 1 页<br>PAGE 1 OF 1 |