

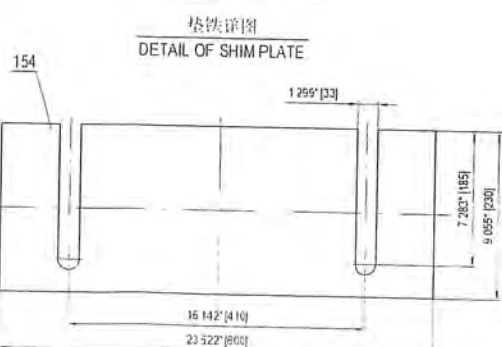
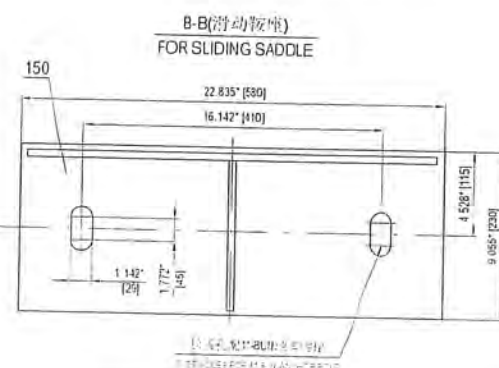
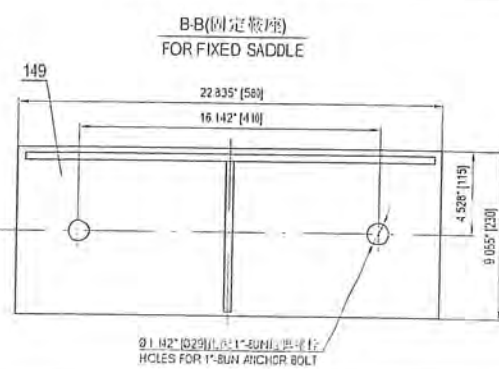
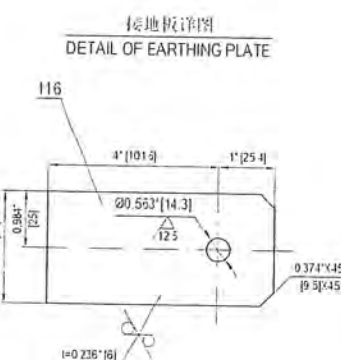
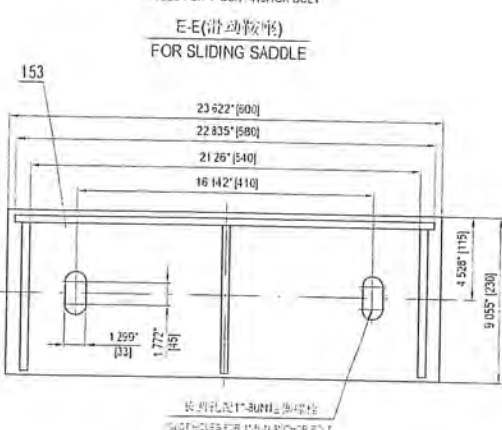
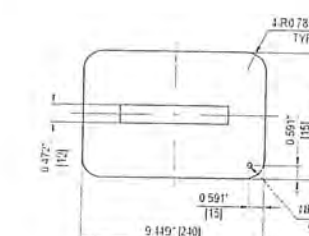
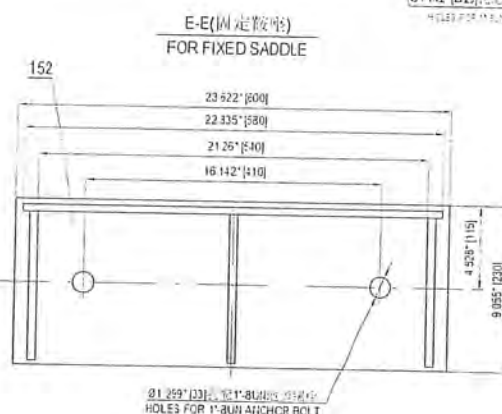
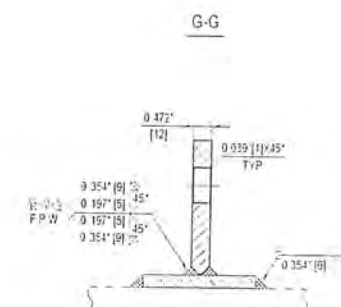
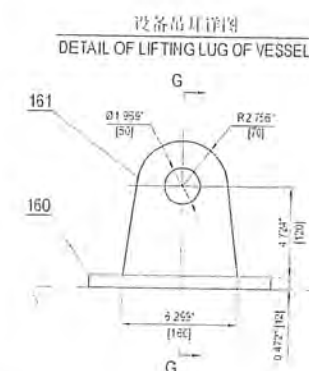
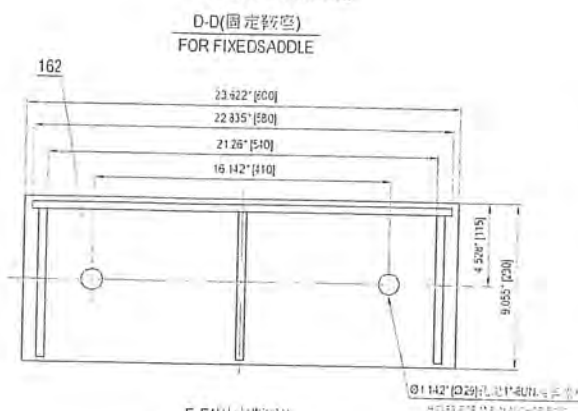
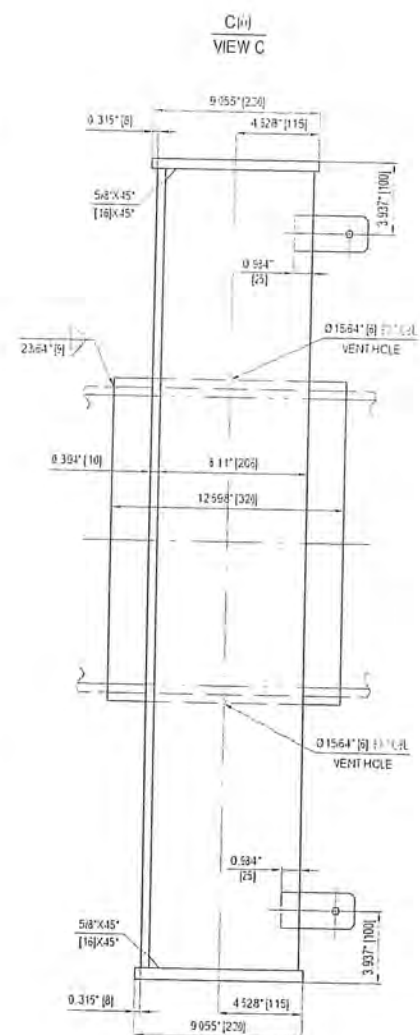
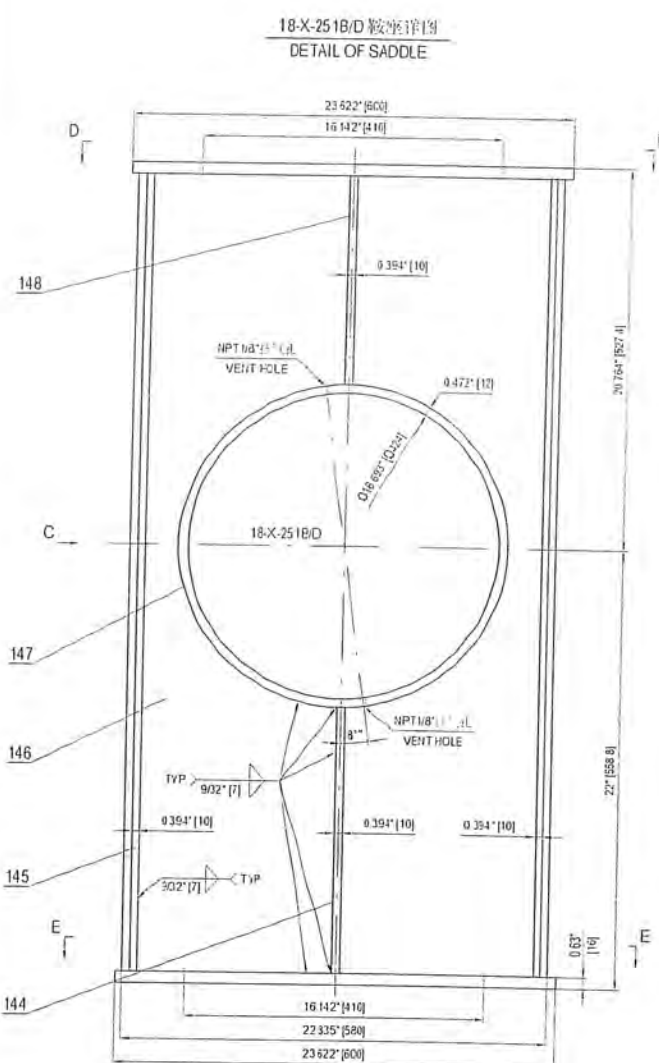
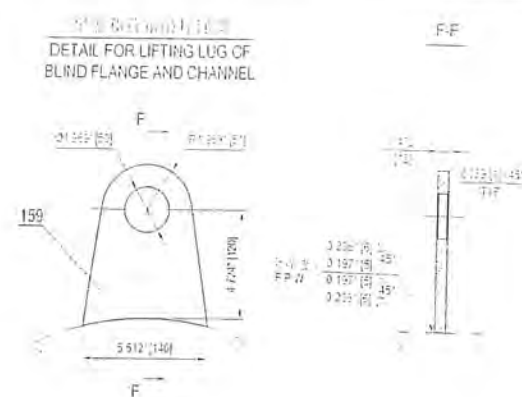
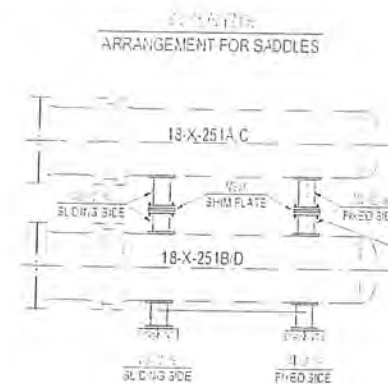
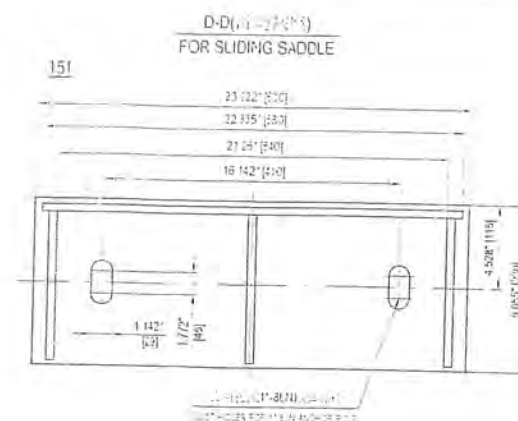


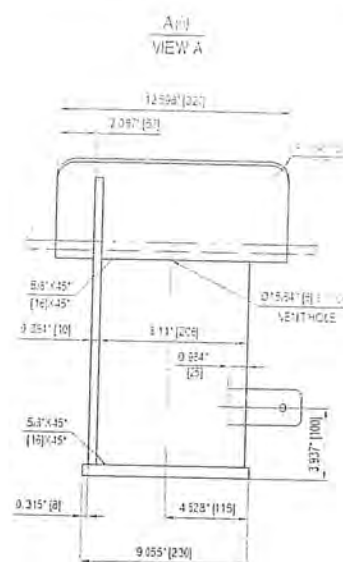

Note:
1. A group of adjusting plate thickness is two pieces of 2mm, and two pieces of 1mm respectively.

2. List of Supplying Materials and their pieces or items and the quantities respectively							Total weight (kg)
162	螺母 M16 BOTTOM PLATE	1	SA-516 Gr 70		16.8	18-X-251BD 18-X-251BD	
161	吊钩 M12 LIFTING LUG	3	SA-516 Gr 70	25	10.0		
160	吊钩 M12 LIFTING LUG PAD	4	SA-240 332265	23	9.2		
159	吊钩 M12 LIFTING LUG	12	SA-516 Gr 70	23	13.8		
158	ASME FCC-1-2019 APPENDIX M 吊钩 M WASHER	1-4	Type 4	9.4	3.2		
157	ASME B16.2-1922 吊钩 M HEAVY HEX NUT	3-8	SA-194 Gr 2H	9.4	3.2		
156	ASME B16.2-1922 吊钩 M FULL THREAD STUD SCLE	2-2	SA-193 Gr B7	9.7	1.1		
155	吊钩 M10 EARTHING PLATE	4	SS 304	9.4	1.6		
154	吊钩 SHM PLATE	2	SA-516 Gr 70	19.8	21.6	18-X-251BD 18-X-251BD	
153	螺母 M16 BOTTOM PLATE	1	SA-516 Gr 70		16.8	18-X-251BD 18-X-251BD	
152	螺母 M16 BOTTOM PLATE	1	SA-516 Gr 70		16.8	18-X-251BD 18-X-251BD	
151	螺母 M16 BOTTOM PLATE	1	SA-516 Gr 70		16.8	18-X-251BD 18-X-251BD	
150	螺母 M16 BOTTOM PLATE	1	SA-516 Gr 70		16.8	18-X-251BD 18-X-251BD	
149	螺母 M16 BOTTOM PLATE	1	SA-516 Gr 70		16.8	18-X-251BD 18-X-251BD	
148	螺母 M10 RIB	2	SA-516 Gr 70	17	9.4		
147	螺母 M12 BASE PLATE	2	SA-240 332265	41.2	56.4		
146	螺母 M10 WEB PLATE	2	SA-516 Gr 70	35.5	31.8		
145	螺母 M10 RIB	2	SA-516 Gr 70	17.9	35.8		
144	螺母 M10 RIB	2	SA-516 Gr 70	6.0	12.0		
143	螺母 M12 BASE PLATE	2	SA-240 332265	15.9	31.8		
142	螺母 M10 RIB	2	SA-516 Gr 70	18	9.2		
141	螺母 M10 WEB PLATE	2	SA-516 Gr 70	12.7	25.1		
材料号 PART NO	图号或材料号 DRAWING NO	名称 DESCRIPTION	材料 MATERIAL	数量 QTY	重量 WEIGHT	重量 TOTAL WEIGHT	

AIR PRODUCTS						FLUOR
Air Products Product Number		/	Fluor Project Number		AKM	
Project Name		World Energy Renewables Project		RFO No	AKM-4-10-RD	
Purchase Order Number		4505288221		POM Contract Area		
Air Product Code AIR-PROD-179230		EN287122-WU/LI/2Y-00155		Project Site		
Client		WORLD ENERGY PARAMOUNT		Client Doc No		
05	发 IAS BUILT		Jianhui Ban	Chengqun Yuan	Hu Yang	
06	供照会 / ISSUED FOR APPROVAL		Jianhui Ban	Chengqun Yuan	Hu Yang	
07	供照会 / ISSUED FOR APPROVAL		Jianhui Ban	Chengqun Yuan	Hu Yang	
08	供照会 / ISSUED FOR APPROVAL		Jianhui Ban	Chengqun Yuan	Hu Yang	
09	供照会 / ISSUED FOR APPROVAL		Jianhui Ban	Chengqun Yuan	Hu Yang	
10	发 IAS REVISED DESCRIPTION		Jianhui Ban	Chengqun Yuan	Hu Yang	
11	发 IAS PREPARED BY		Jianhui Ban	Chengqun Yuan	Hu Yang	
12	发 IAS REVIEWED BY		Jianhui Ban	Chengqun Yuan	Hu Yang	
13	发 IAS DATE		Jianhui Ban	Chengqun Yuan	Hu Yang	
14	发 IAS PROJECT NO.		Jianhui Ban	Chengqun Yuan	Hu Yang	
15	发 IAS PROJECT NAME		Jianhui Ban	Chengqun Yuan	Hu Yang	
16	发 IAS PROJECT LOCATION		Jianhui Ban	Chengqun Yuan	Hu Yang	
17	发 IAS PROJECT OWNER		Jianhui Ban	Chengqun Yuan	Hu Yang	
18	发 IAS PROJECT CONTACT		Jianhui Ban	Chengqun Yuan	Hu Yang	
19	发 IAS PROJECT PHONE		Jianhui Ban	Chengqun Yuan	Hu Yang	
20	发 IAS PROJECT FAX		Jianhui Ban	Chengqun Yuan	Hu Yang	
21	发 IAS PROJECT E-MAIL		Jianhui Ban	Chengqun Yuan	Hu Yang	
22	发 IAS PROJECT WEBSITE		Jianhui Ban	Chengqun Yuan	Hu Yang	
23	发 IAS PROJECT ADDRESS		Jianhui Ban	Chengqun Yuan	Hu Yang	
24	发 IAS PROJECT CITY		Jianhui Ban	Chengqun Yuan	Hu Yang	
25	发 IAS PROJECT STATE		Jianhui Ban	Chengqun Yuan	Hu Yang	
26	发 IAS PROJECT COUNTRY		Jianhui Ban	Chengqun Yuan	Hu Yang	
27	发 IAS PROJECT ZIP CODE		Jianhui Ban	Chengqun Yuan	Hu Yang	
28	发 IAS PROJECT POSTAL CODE		Jianhui Ban	Chengqun Yuan	Hu Yang	
29	发 IAS PROJECT TAX ID NUMBER		Jianhui Ban	Chengqun Yuan	Hu Yang	
30	发 IAS PROJECT VAT NUMBER		Jianhui Ban	Chengqun Yuan	Hu Yang	
31	发 IAS PROJECT REGISTRATION NUMBER		Jianhui Ban	Chengqun Yuan	Hu Yang	
32	发 IAS PROJECT BUSINESS LICENSE NUMBER		Jianhui Ban	Chengqun Yuan	Hu Yang	
33	发 IAS PROJECT SOCIAL SECURITY NUMBER		Jianhui Ban	Chengqun Yuan	Hu Yang	
34	发 IAS PROJECT EMPLOYMENT CONTRACT NUMBER		Jianhui Ban	Chengqun Yuan	Hu Yang	
35	发 IAS PROJECT LABOR AGREEMENT NUMBER		Jianhui Ban	Chengqun Yuan	Hu Yang	
36	发 IAS PROJECT COLLECTIVE CONTRACT NUMBER		Jianhui Ban	Chengqun Yuan	Hu Yang	
37	发 IAS PROJECT TRADE UNION REGISTERED NUMBER		Jianhui Ban	Chengqun Yuan	Hu Yang	
38	发 IAS PROJECT LABOR DISPUTE CASE NUMBER		Jianhui Ban	Chengqun Yuan	Hu Yang	
39	发 IAS PROJECT LABOR DISPUTE CASE FILE NUMBER		Jianhui Ban	Chengqun Yuan	Hu Yang	
40	发 IAS PROJECT LABOR DISPUTE CASE DECISION NUMBER		Jianhui Ban	Chengqun Yuan	Hu Yang	
41	发 IAS PROJECT LABOR DISPUTE CASE DECISION FILE NUMBER		Jianhui Ban	Chengqun Yuan	Hu Yang	
42	发 IAS PROJECT LABOR DISPUTE CASE DECISION DECISION NUMBER		Jianhui Ban	Chengqun Yuan	Hu Yang	
43	发 IAS PROJECT LABOR DISPUTE CASE DECISION DECISION FILE NUMBER		Jianhui Ban	Chengqun Yuan	Hu Yang	
44	发 IAS PROJECT LABOR DISPUTE CASE DECISION DECISION DECISION NUMBER		Jianhui Ban	Chengqun Yuan	Hu Yang	
45	发 IAS PROJECT LABOR DISPUTE CASE DECISION DECISION DECISION FILE NUMBER		Jianhui Ban	Chengqun Yuan	Hu Yang	
46	发 IAS PROJECT LABOR DISPUTE CASE DECISION DECISION DECISION DECISION NUMBER		Jianhui Ban	Chengqun Yuan	Hu Yang	
47	发 IAS PROJECT LABOR DISPUTE CASE DECISION DECISION DECISION DECISION FILE NUMBER		Jianhui Ban	Chengqun Yuan	Hu Yang	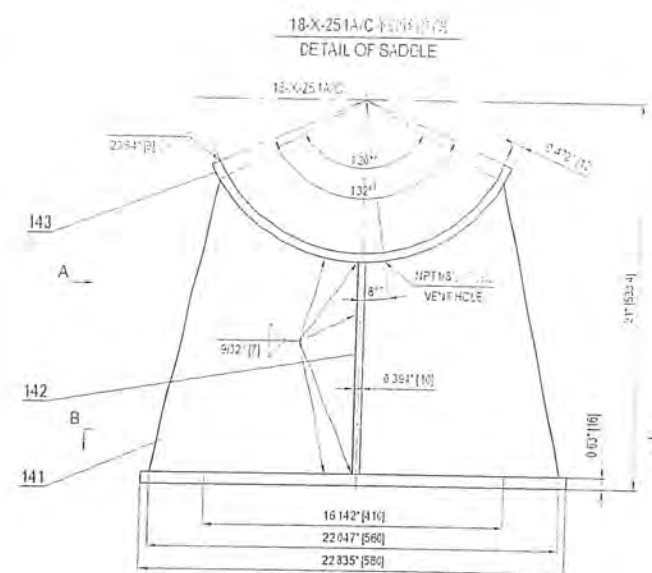
103	ASME SECTION 3 ASME NAMEPLATE		1	SS 304		0.4
102	STANDARD NAMEPLATE		1	SS 304		0.7
101	支吊架 BRACKET		1	SA-20 30205		3.0
序号 PART NO	图号/图名/号 DRAWING NO/NAME	名称 DESCRIPTION	数量 QTY	材料 MATERIAL	比例 SCALE	备注 REMARK



**AIR
PRODUCTS**

World energy



FLUOR

Air Products Project Number		Fluor Project Number	
Project Name	World Energy Renewables Project	RFO No	APKM
Purchase Order Number	4505583221	PO/Contract No	APKM-4-119-RD
Air Products "Contract" quantity number	EN007122-WU11-2V3-00163	Project Area	
Client	WORLD ENERGY PARAMOUNT	Client Doc No	

05	竣工 AS BUILT	Jianhui Ban	Chengyan Yuan	Hu Yang	12-Sep-23
04	供货单 IS USED FOR APPROVAL	Jianhui Ban	Chengyan Yuan	Hu Yang	20-Jun-23
04	供货单 IS USED FOR APPROVAL	Jianhui Ban	Chengyan Yuan	Hu Yang	17-Apr-23
03	供货单 IS USED FOR APPROVAL	Jianhui Ban	Chengyan Yuan	Hu Yang	27-Feb-23
设计/REV	设计/设计 DESCRIPTION	设计/ PREPARED	审核/ REVIEWED	批准/ APPROVED	日期/ DATE

本图纸属无锡化工装备股份有限公司资产, 未经授权, 不得转让或复制, 违者必究。
 The copyright of this drawing is the property of Wuxi Chemical Equipment Co., Ltd. (WCE), and without the company's authorization, it is not permitted to be transferred or copied.



WUXI CHEMICAL EQUIPMENT CO., LTD.

设计/项目
DESIGN ITEM

设计/名称
DESIGN NAME

设计/详细
DESIGN DETAIL

审核/项目
REVIEWED ITEM

审核/名称
REVIEWED NAME

审核/详细
REVIEWED DETAIL

设计/ PREPARED	审核/ REVIEWED	批准/ APPROVED	Food/ E/ HSE/ E exchanges	图号/ NAMEPLATE DETAIL DRAWING	设计/ 项目 DESIGN ITEM	审核/ 项目 REVIEWED ITEM	图号/ NAMEPLATE DETAIL DRAWING
2023.9.12	2023.9.12	2023.9.12	SCALE 1:1		18-C-251A-CR		WCE68825-05

第 1 页 共 1 页

PAGE 1 OF 1

图号/ NAMEPLATE DETAIL DRAWING

18-C-251A-CR