


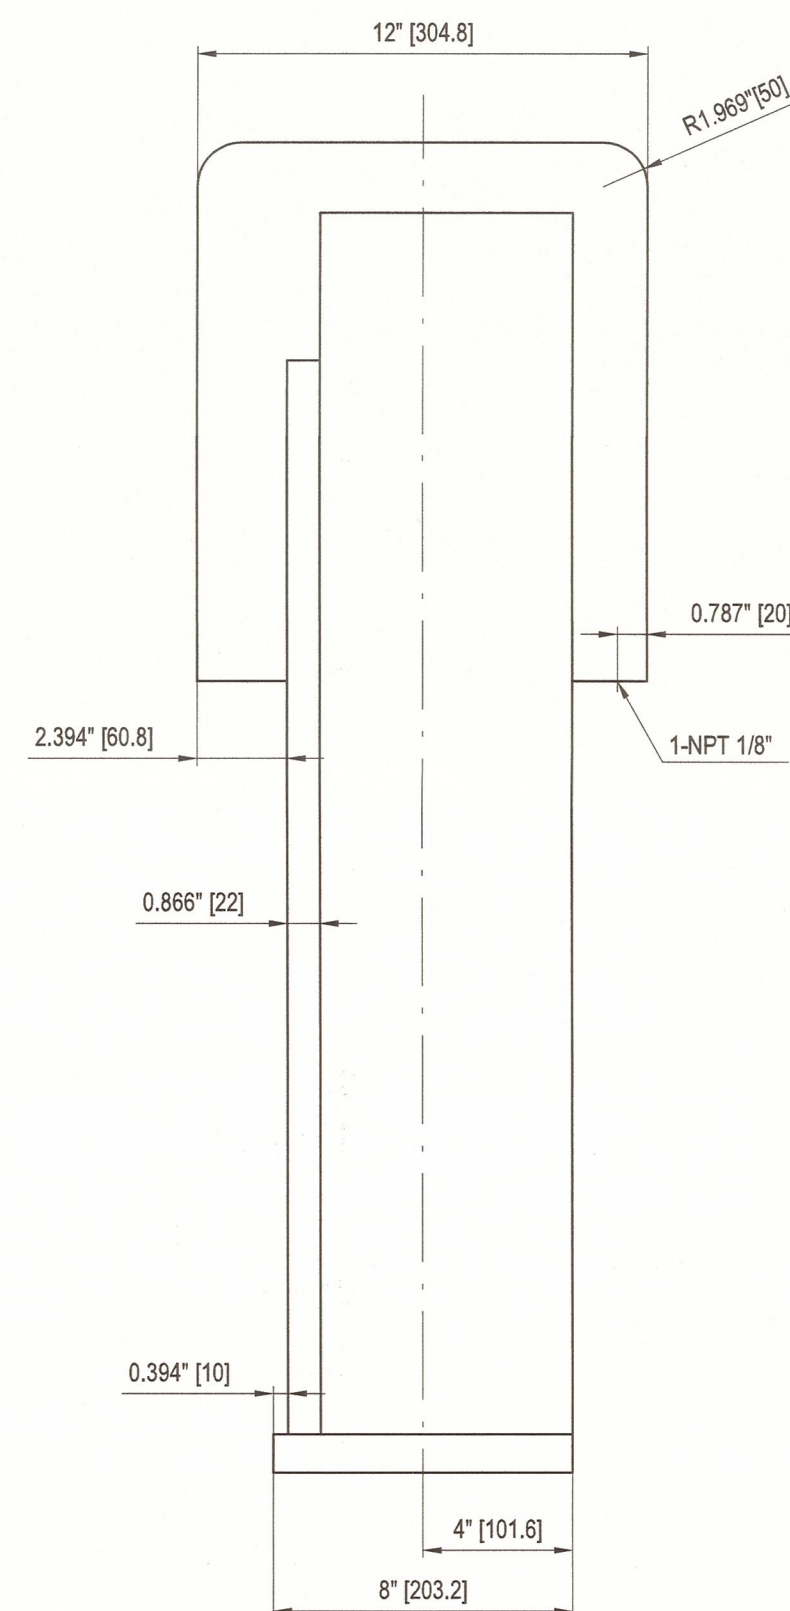
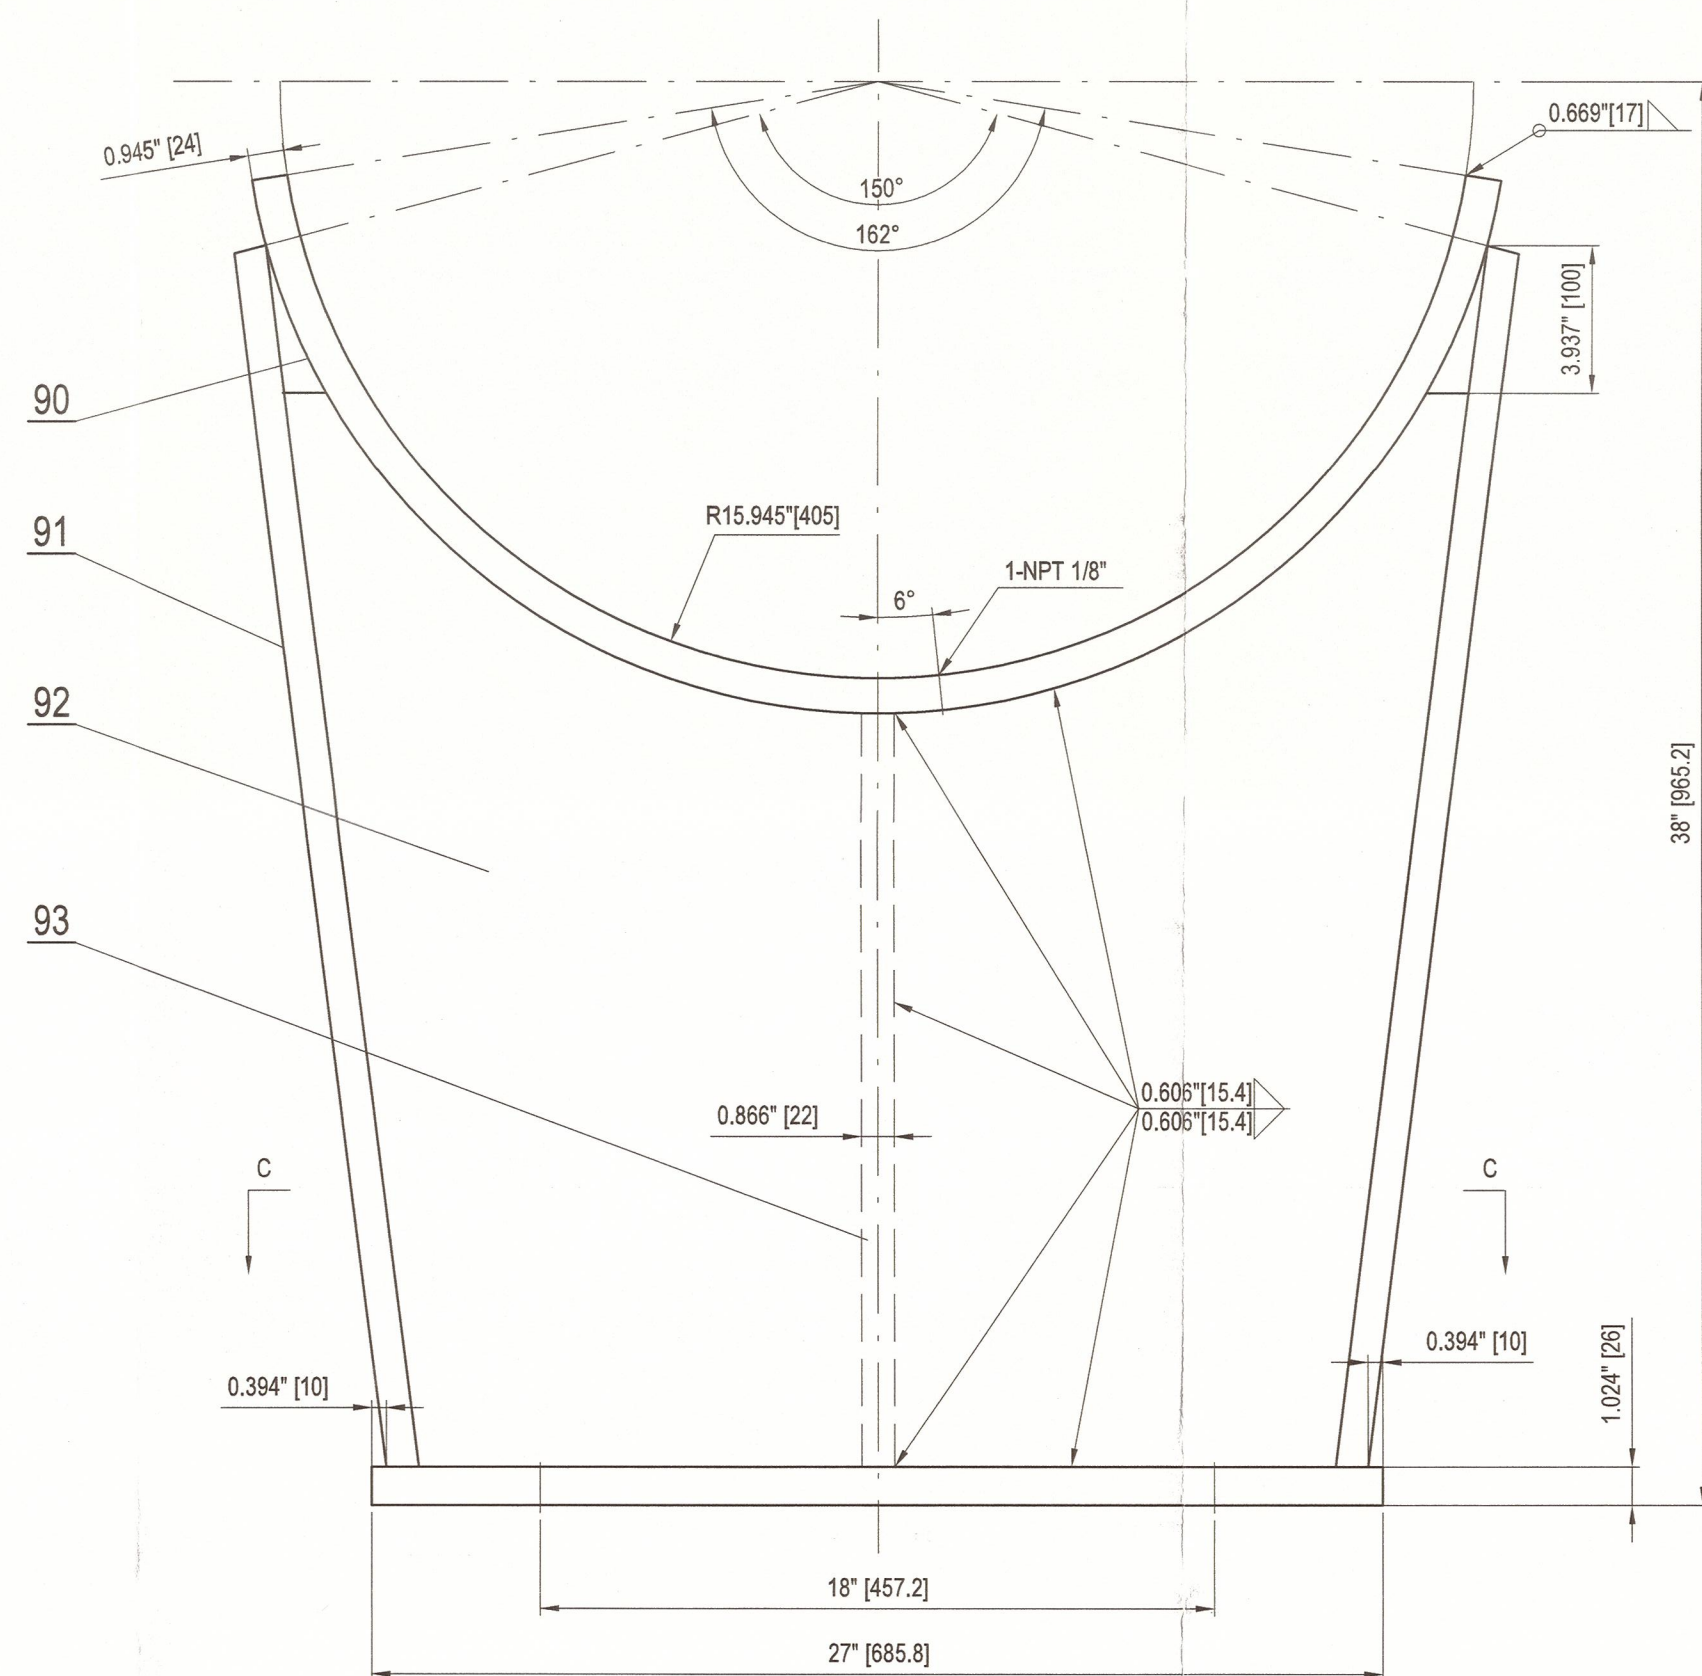


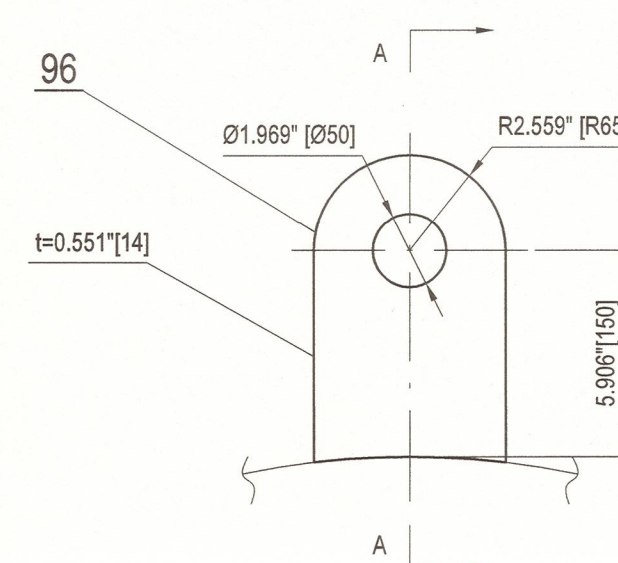


管箱,平盖吊耳详图
DETAIL OF LIFTING LUG FOR CHANNEL

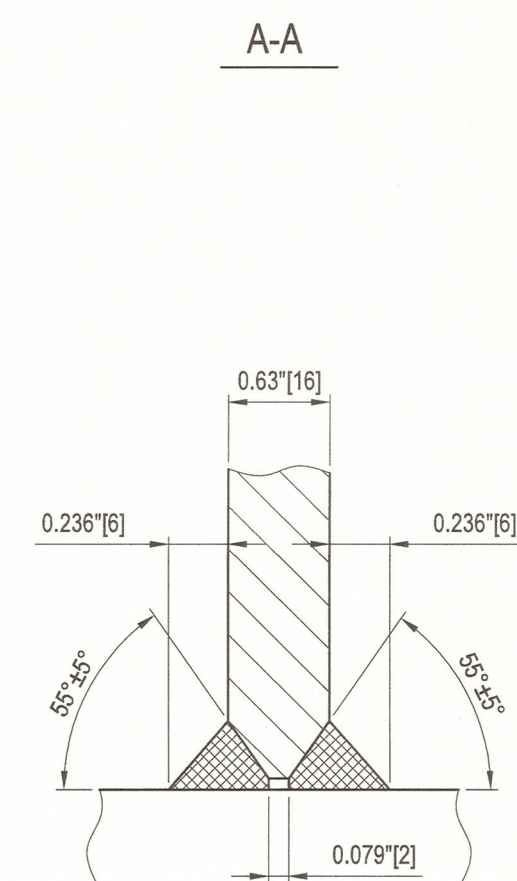


接地板详图
DETAIL OF EARTHING LUG


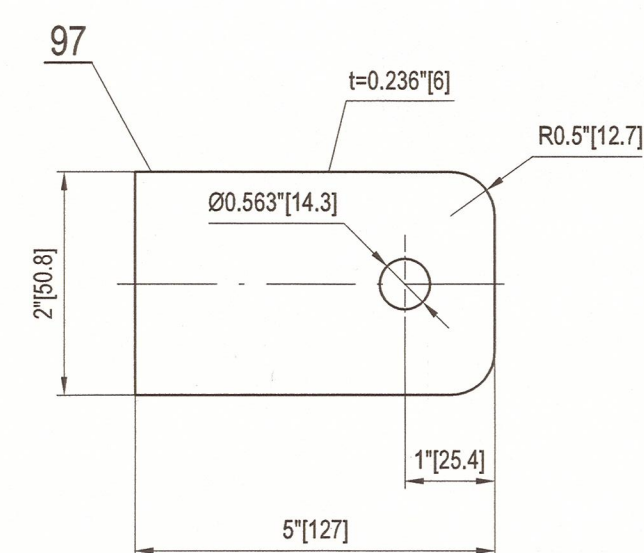


FLAMMABLE SERVICE
(SHELL & TUBE SIDE)

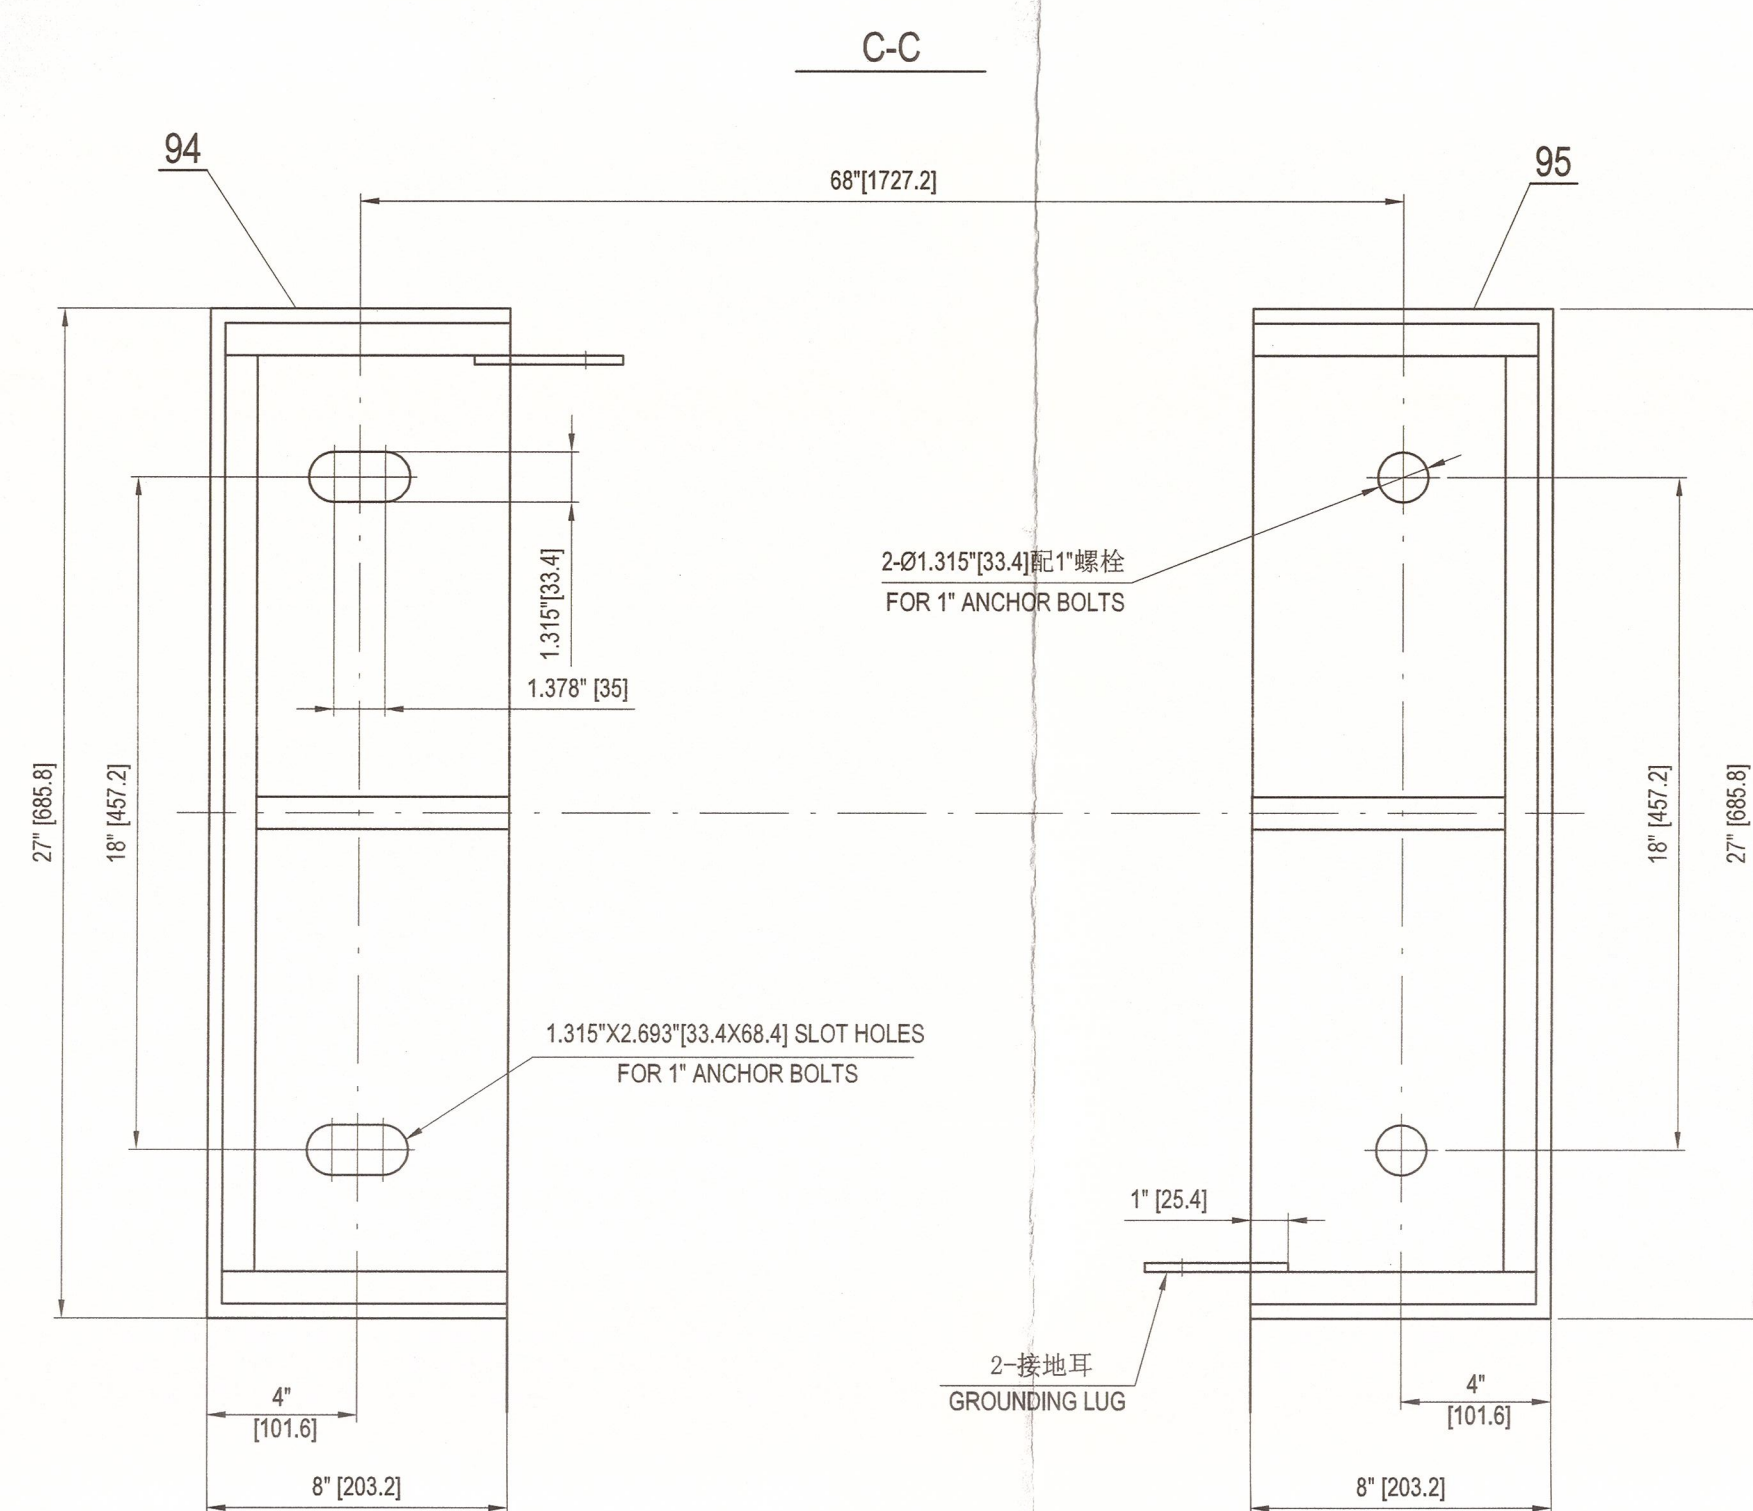

99		DELETED					
98		DELETED					
97		接地板 t=6 EARTHING LUG	2	SS304	0.5	1.0	
96		吊耳 t=16 LIFTING LUG	3	SA-516 Gr.70N	1.0	3.0	
95		底板 t=26 BASE PLATE	1	SA-516 Gr.70N		28.4	
94		底板 t=26 BASE PLATE	1	SA-516 Gr.70N		28.4	
93		筋板 t=22 RIB PLATE	2	SA-516 Gr.70N	11.5	23.0	
92		腹板 t=22 WEB PLATE	2	SA-516 Gr.70N	51.0	102	
91		筋板 t=22 RIB PLATE	4	SA-516 Gr.70N	18.5	74.0	
90		垫板 t=24 WEAR PLATE	2	SA-516 Gr.70N	69.7	140	
件号 PART NO.	图号或标准号 DWG. OR STD. NO.	名 称 DESCRIPTION	数量 QTY.	材 料 MATERIAL	单件 EACH 重量 WT. (kg)	总计 SUM	备注 REMARK

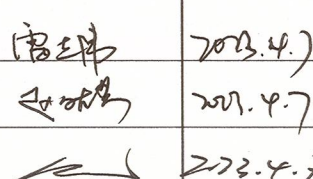					
Air Project Number		EN207119	Fluor Project Number		ABKM
Project Name		World Energy Renewables Project	RFQ No.		ABKM-L4-403-RQ
Purchase Order Number		4056000572	PO/Contract No.		ABKM-L4-403-PO-1
Air Products Open Text document number		EN207119-WUXI-9V3-00074	Project Area		Renewable Jet Fuel Unit B
Client		World ENERGY PARAMOUNT			
Client Doc No:					
04	竣工图/AS BUILT	Zhiwei Lei	Shengfang Zhao	Kevin Yang	07-Apr-23
03	供货批准/ISSUED FOR APPROVAL	Zhiwei Lei	Shengfang Zhao	Kevin Yang	13-Oct-22
02	供货批准/ISSUED FOR APPROVAL	Zhiwei Lei	Shengfang Zhao	Kevin Yang	11-Aug-22
01	供货批准/ISSUED FOR APPROVAL	Zhiwei Lei	Shengfang Zhao	Kevin Yang	15-Jun-22
00	供货批准/ISSUED FOR APPROVAL	Zhiwei Lei	Shengfang Zhao	Kevin Yang	18-Apr-22
版次/REV.		版次说明/DESCRIPTION		设计/PREPARED 审核/REVIEWED 批准/APPROVED	日期/DATE
本图纸版权为无锡化工装备股份有限公司所有,未经本公司许可不得转让或复制给第三方。 The copyright of this drawing is the property of China Wuxi Chemical Equipment Co., Ltd.(WCE).Unauthorized disclosure or duplication to the third party is not permitted.					
		无锡化工装备股份有限公司 WUXI CHEMICAL EQUIPMENT CO., LTD.			项目设计 设计阶段 设计阶段 PHASE 详细设计 Detail Design
设计 PREPARED 审核 REVIEWED 批准 APPROVED		Product Fractionator Feed/Btms Exchanger No.2 SADDLE AND LIFTING LUG DETAIL DRAWING		设备代号 ITEM NO. 图号 DWG. NO.	World Energy Renewables Project 详细设计 Detail Design 18-X-361 WXC6711-04
		比例: SCALE 1:5		版次: REV. 04	第 1 页 共 1 页 PAGE 1 OF 1

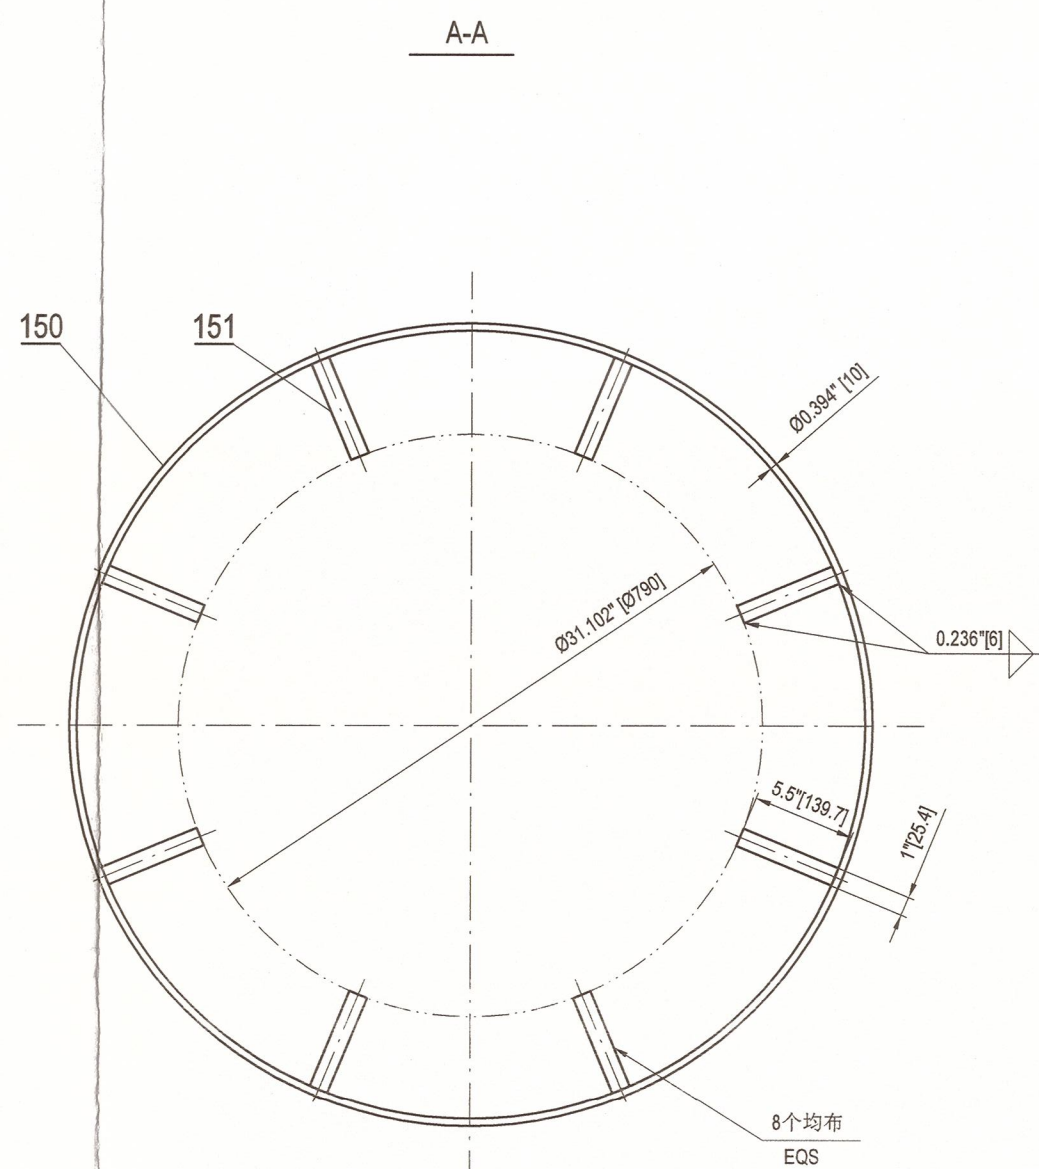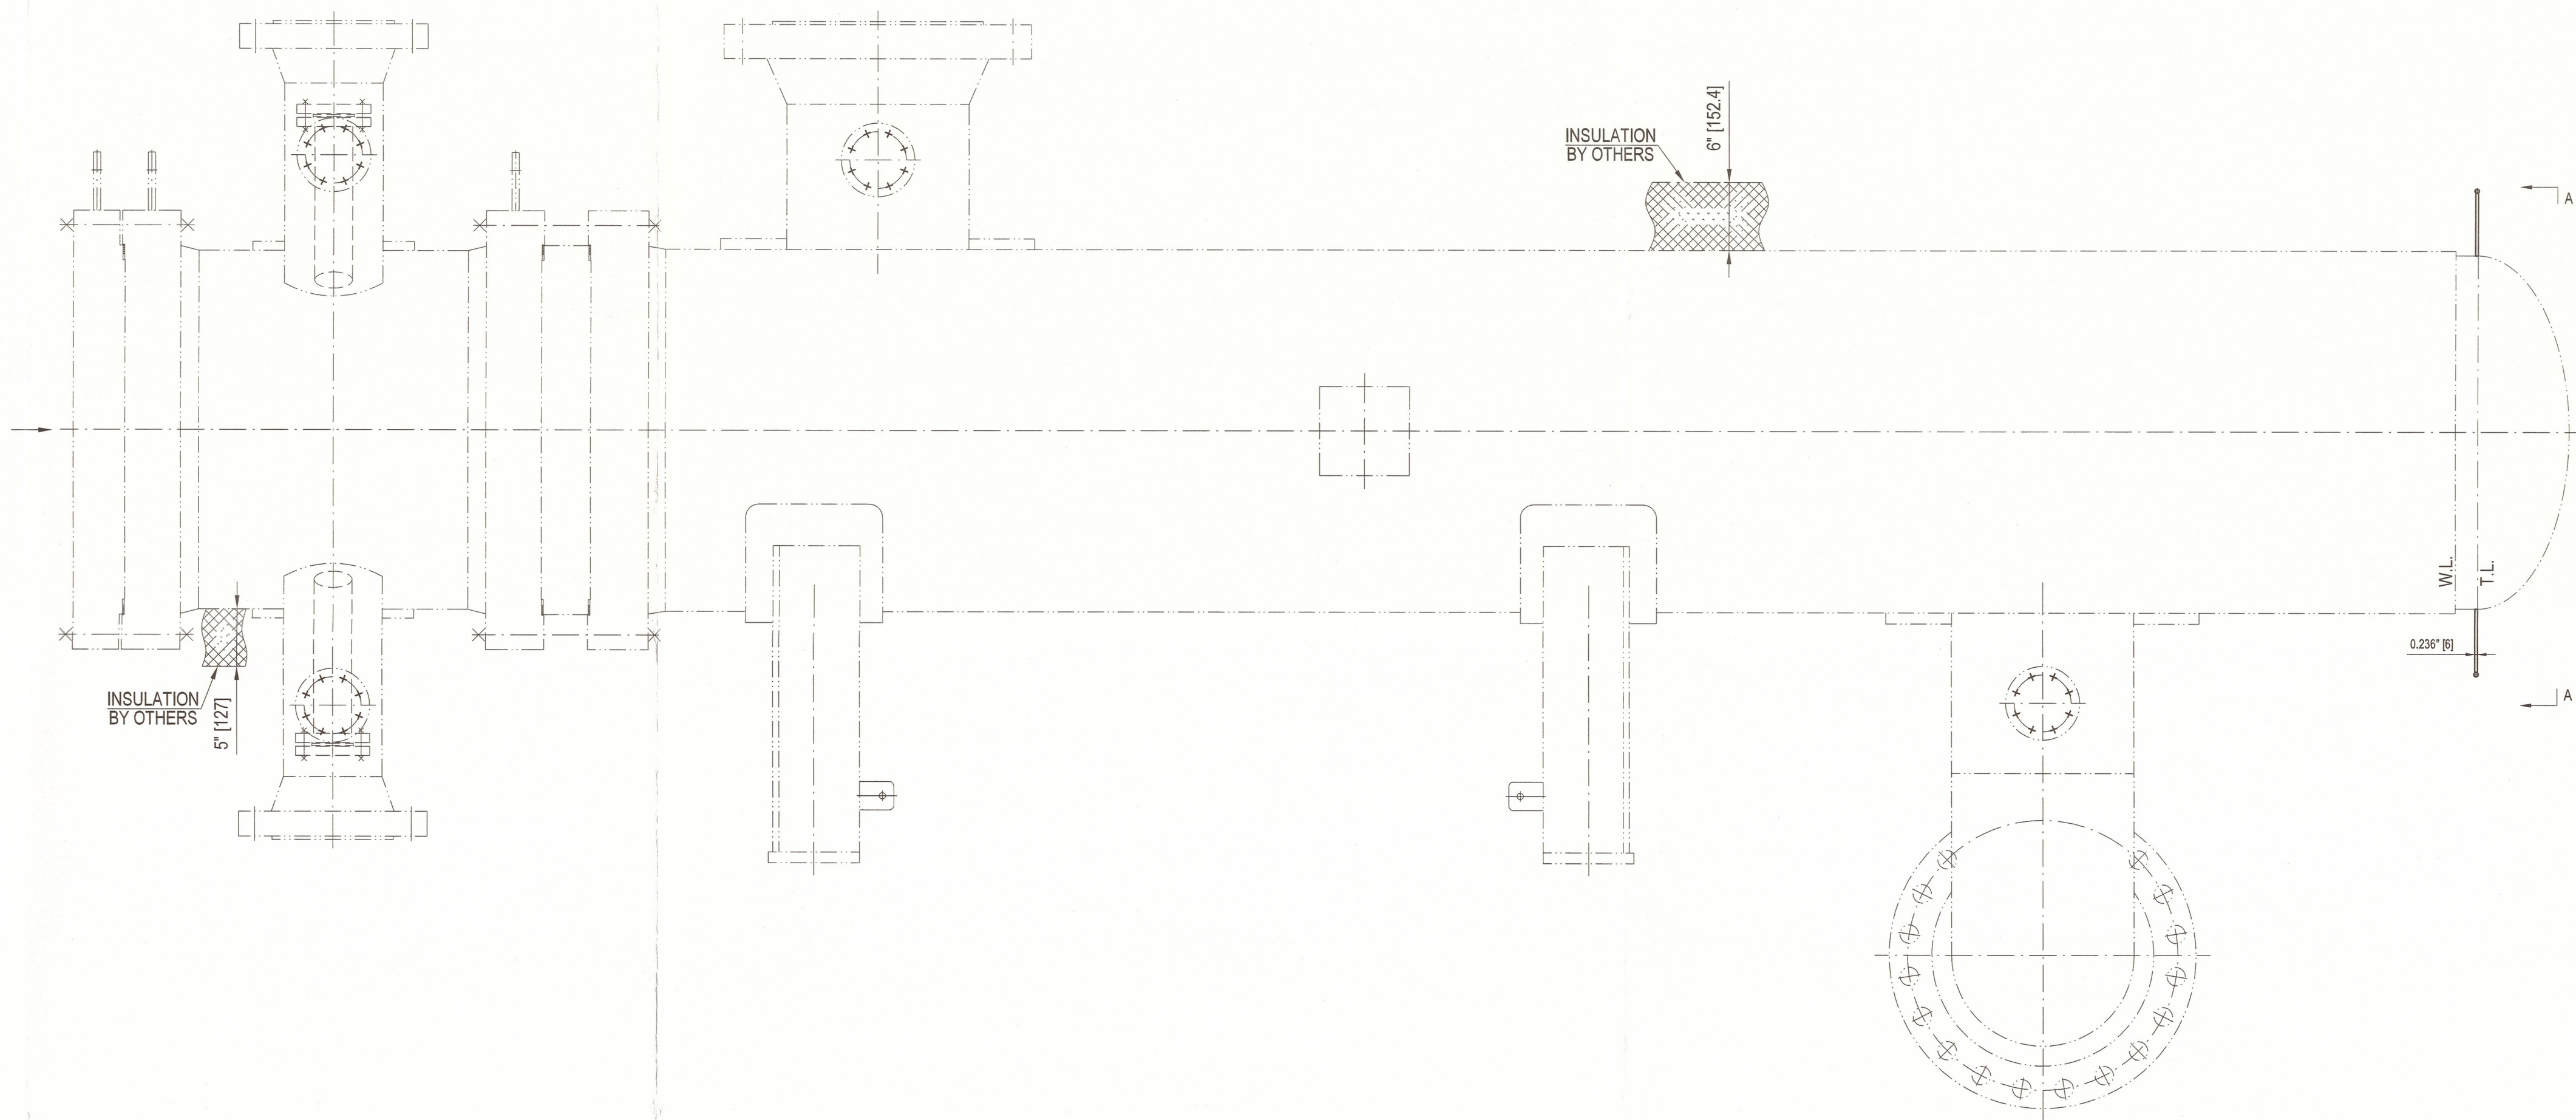


FLAMMABLE SERVICE
(SHELL & TUBE SIDE)

As Built

151		支撑筋板 t=6 INSULATION SUPPORT CLIP	8	SA-516 Gr.70N	0.2	1.6	
150		保温支撑环 Ø10 INSULATION SUPPORT RING	1	SA-36		2.1	
件号 PART NO.	图号或标准号 DWG. OR STD. NO.	名 称 DESCRIPTION	数量 QTY.	材 料 MATERIAL	单件 EACH 重量 WT. (kg)	品计 SUM	备 注 REMARK

AIR PRODUCTS			FLUOR			
Air Products Project Number			Fluor Project Number			ABKM
Project Name			RFQ No.			ABKM-4-403-RQ
Purchase Order Number			PO/Contract No			ABKM-4-403-PO-1
Air Products Open Text document number			Project Area			Renewable Jet Fuel Unit B
Client			Client Doc No:			
03	竣工图/AS BUILT		Zhiwei Lei	Shengfang Zhao	Kevin Yang	07-Apr-23
02	供批准/ISSUED FOR APPROVAL		Zhiwei Lei	Shengfang Zhao	Kevin Yang	13-Oct-22
01	供批准/ISSUED FOR APPROVAL		Zhiwei Lei	Shengfang Zhao	Kevin Yang	11-Aug-22
00	供批准/ISSUED FOR APPROVAL		Zhiwei Lei	Shengfang Zhao	Kevin Yang	15-Jun-22
版次 REV.	版次说明/DESCRIPTION		设计/PREPARED		审核/REVIEWED	批准/APPROVED 日期/DATE

WCE 无锡化工装备股份有限公司 WUXI CHEMICAL EQUIPMENT CO., LTD.			设计项目 DESIGN ITEM World Energy Renewables Project	
设计 PREPARED			设计阶段 DESIGN PHASE World Energy Renewables Project	
审核 REVIEWED			设备位号 ITEM NO. 18-X-361	
批准 APPROVED			图 号 DWG. NO. WXCE6711-06	
比例: 1:10 SCALE			版次: 03 REV.	
			第 1 页 共 1 页 PAGE 1 OF 1	

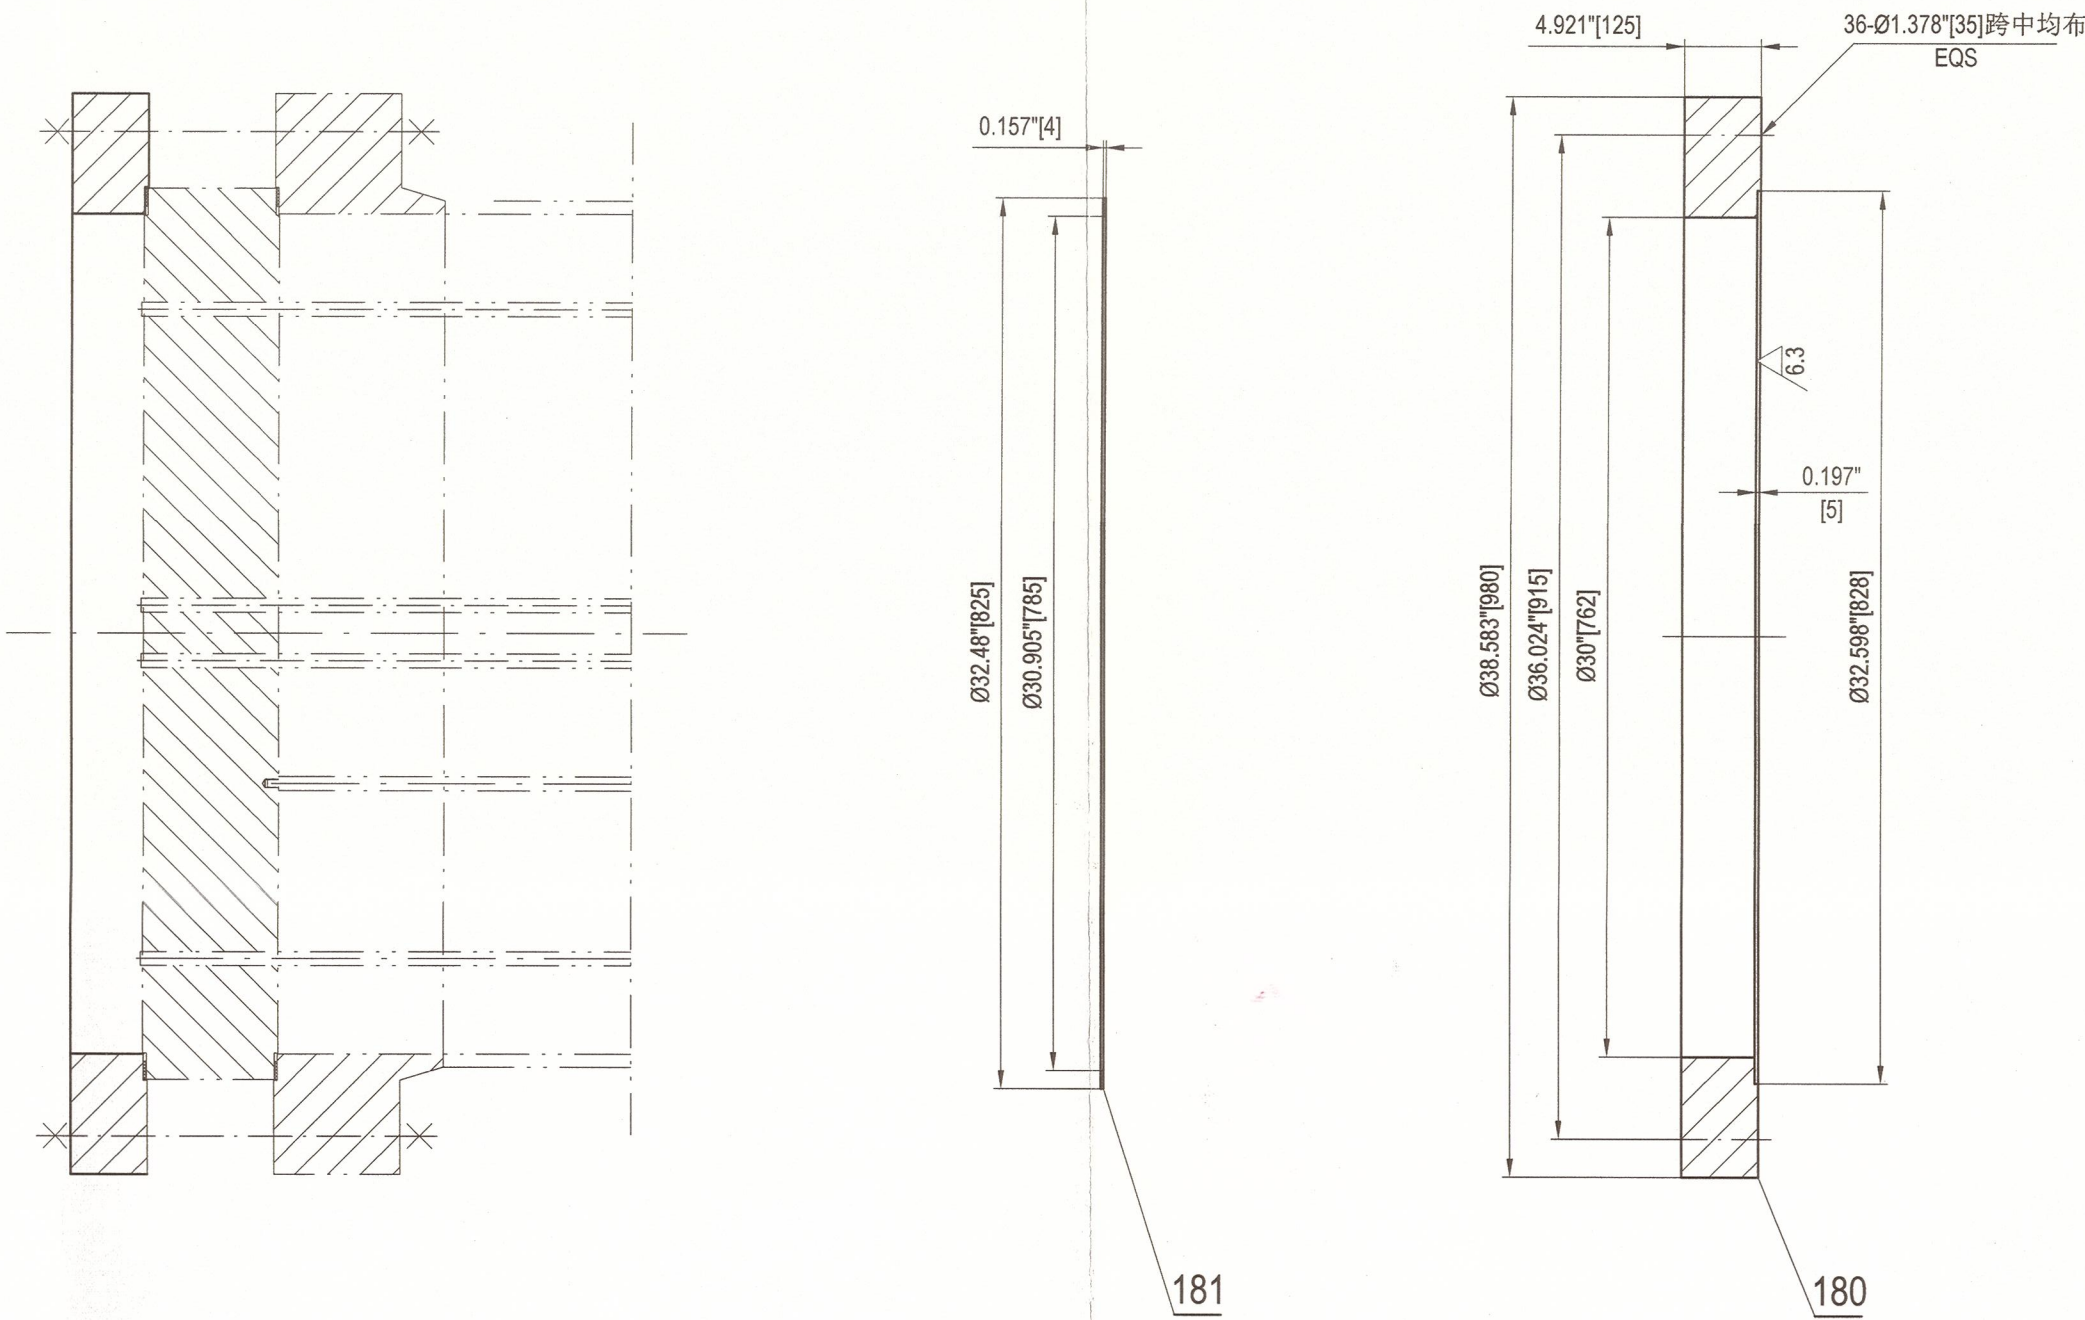

FLAMMABLE SERVICE
(SHELL & TUBE SIDE)

As Built

181		垫片 GASKET	1	PTFE		/	
180		试压环 TEST RING	1	SA-266 Gr.2N		285	
件号 PART NO.	图号或标准号 DWG. OR STD. NO.	名 称 DESCRIPTION	数量 QTY.	材 料 MATERIAL	单件 EACH 重量 WT. (kg)	总计 SUM	备注 REMARK
AIR PRODUCTS			FLUOR				
Air Products Project Number		EN207119	Fluor Project Number		A8KM		
Project Name		World Energy Renewables Project	RFQ No.		A8KM-4-403-RQ		
Purchase Order Number		4505600572	PO/Contract No		A8KM-4-403-PO-1		
Air Products Open Text document number		EN207119-WUXI-9V3-00074	Project Area		Renewable Jet Fuel Unit B		
Client		WORLD ENERGY PARAMOUNT	Client Doc No:				
02	竣工图/ AS BUILT		Zhiwei Lei	Shengfang Zhao	Kevin Yang	07-Apr-23	
01	供批准/ ISSUED FOR APPROVAL		Zhiwei Lei	Shengfang Zhao	Kevin Yang	13-Oct-22	
00	供批准/ ISSUED FOR APPROVAL		Zhiwei Lei	Shengfang Zhao	Kevin Yang	11-Aug-22	
版次 REV.	版次说明/DESCRIPTION		设计/PREPARED	审核/REVIEWED	批准/APPROVED	日期/DATE	
本图纸版权为无锡化工装备股份有限公司财产,未经本公司许可不得转让或复制给第三方. The copyright of this drawing is the property of China Wuxi Chemical Equipment Co.,Ltd.(WCE),unauthorized disclosure or duplication to the third party is not permitted.							
WCE 无锡化工装备股份有限公司 WUXI CHEMICAL EQUIPMENT CO., LTD.					设计项目 DESIGN ITEM	World Energy Renewables Project	
					设计阶段 DESIGN PHASE	详细设计 Detail Design	
设 计 PREPARED	富正伟	2023.4.7	Product Fractionator Feed/Btms Exchanger No.2		设备位号 ITEM NO.	18-X-361	
审 核 REVIEWED	李成林	2023.4.7	TEST RING DETAIL DRAWING		图 号 DWG. NO.	WXCE6711-08	
批 准 APPROVED	李成林	2023.4.7	比例: SCALE	1:10	版 次: REV.	02	第 1 页 共 1 页 PAGE 1 OF 1