


标准铭牌详图
DETAIL OF STANDARD NAME PLATE

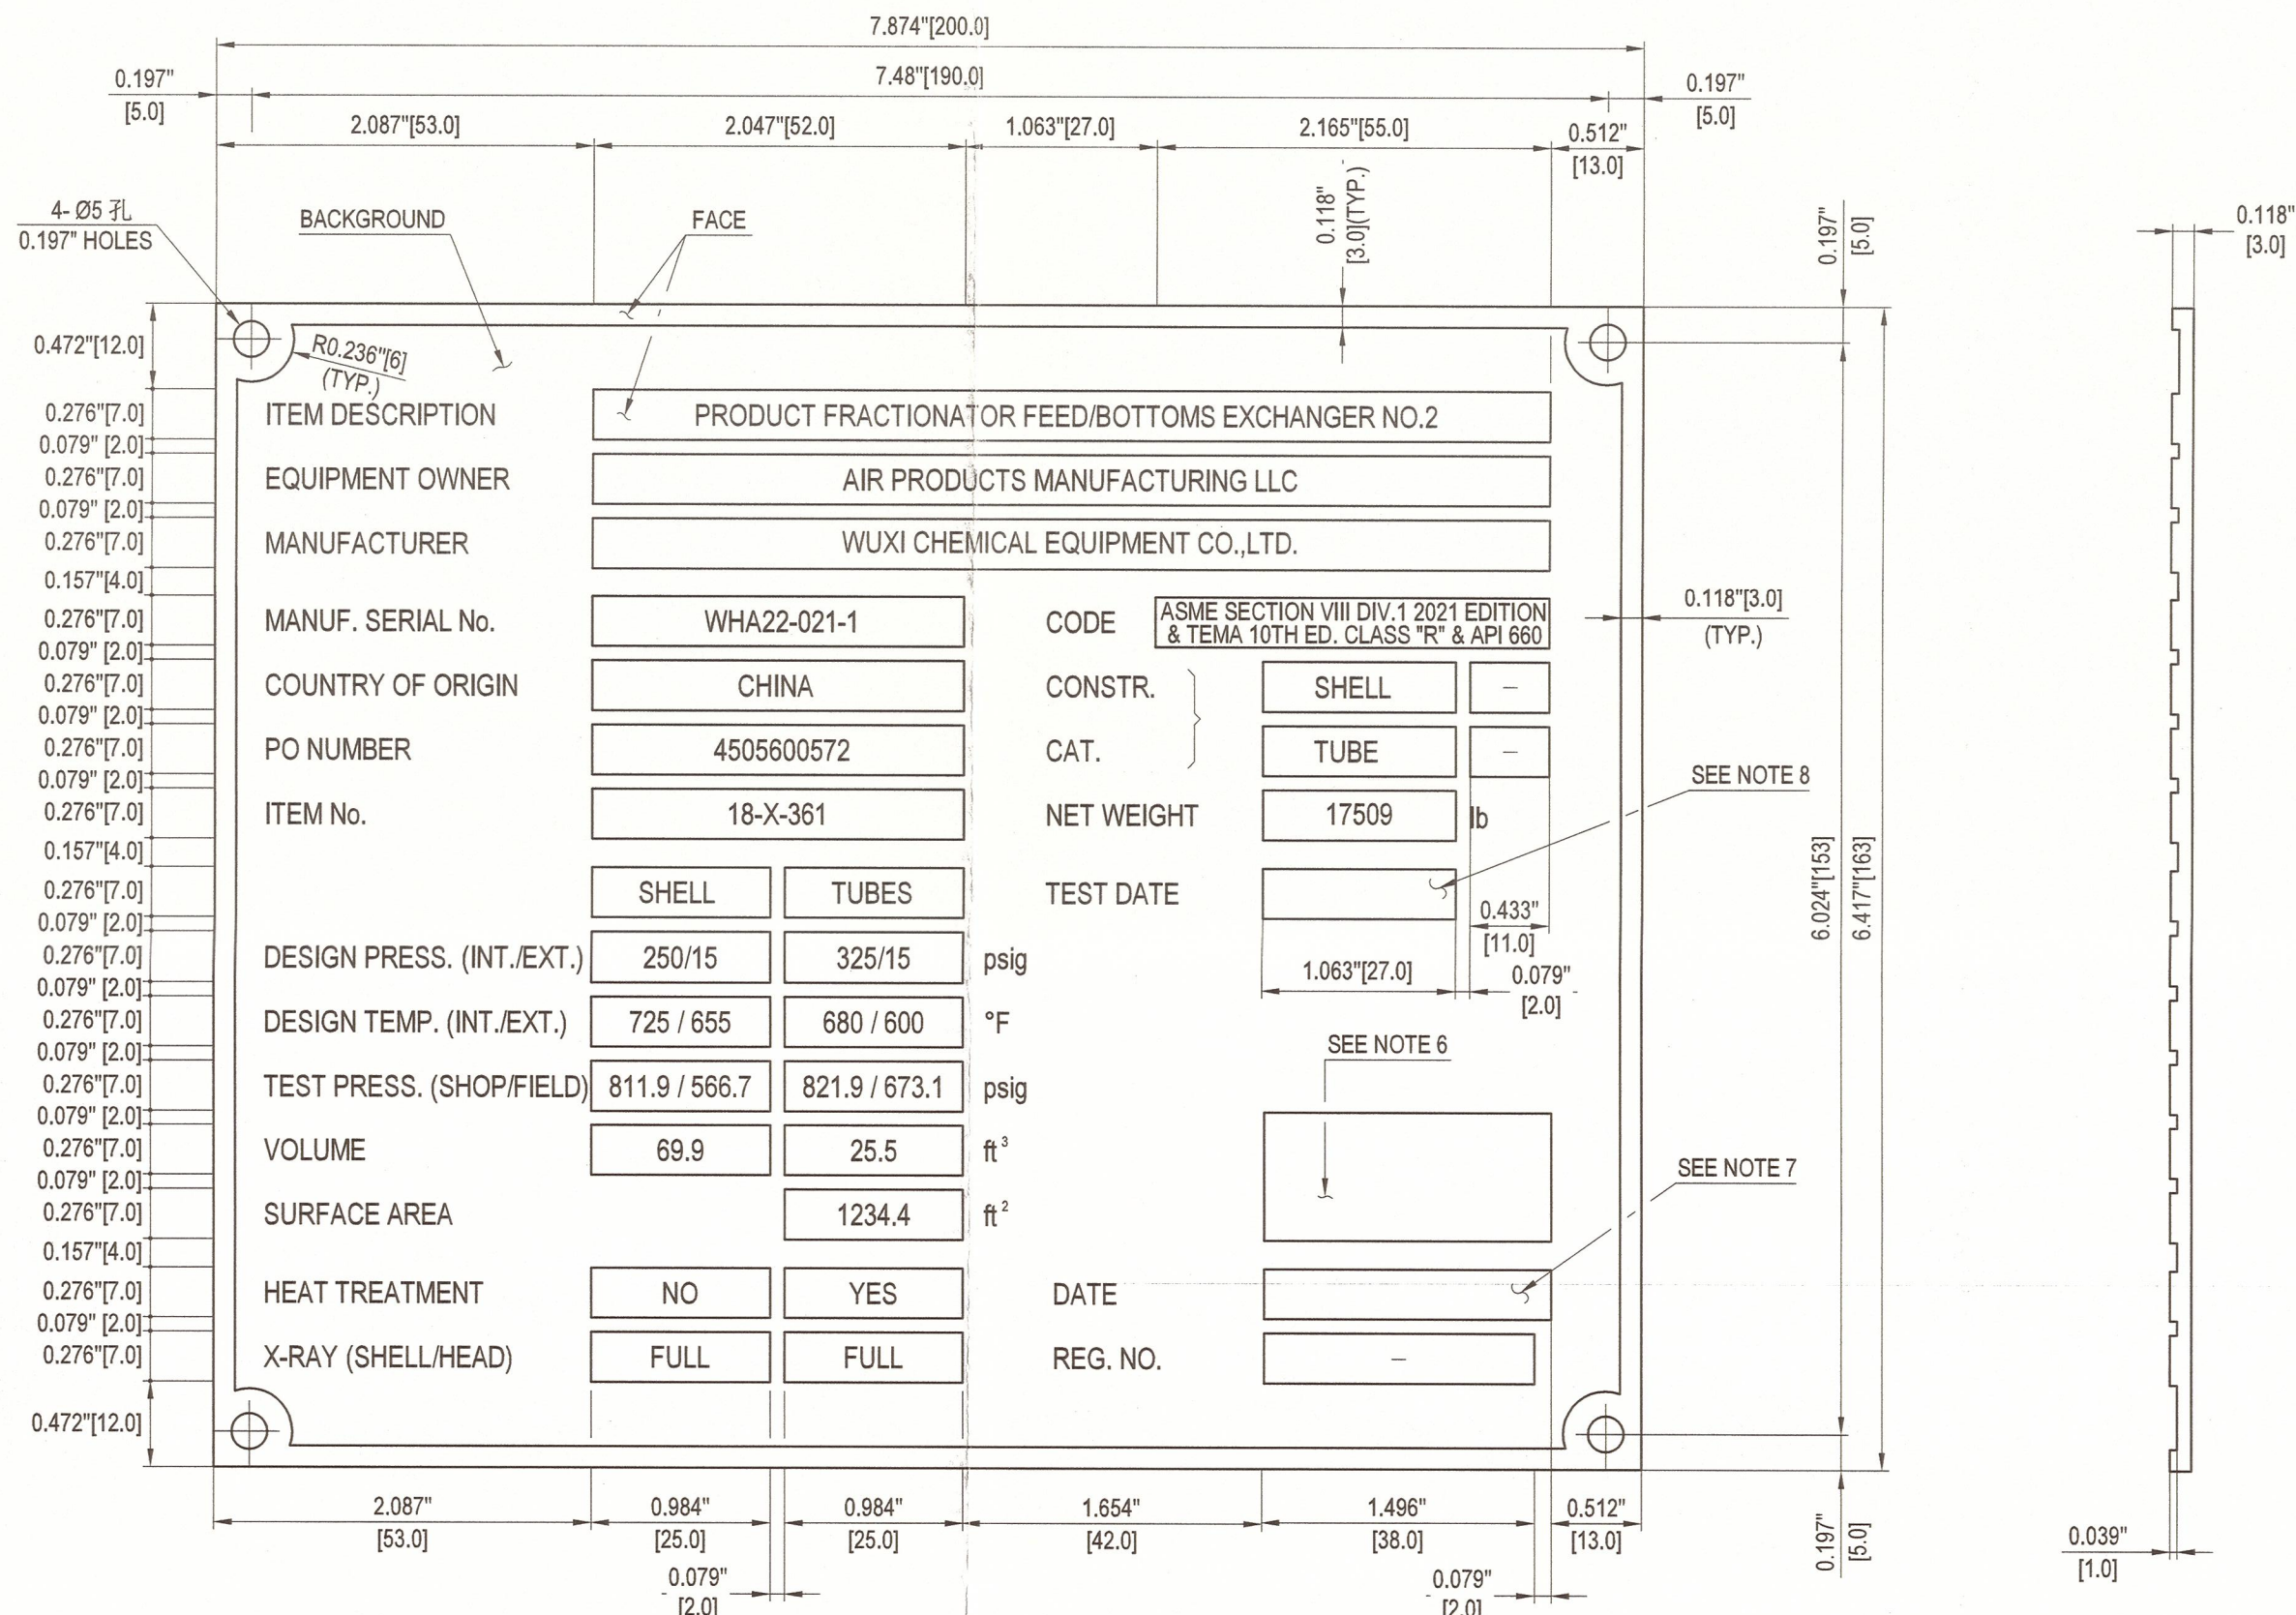

- 注:
- 除注明外, 所有尺寸均以英制为准, 括号外为英制尺寸, 括号内为米制尺寸。
 - 完成后: 铭牌表面抛光处理包括采用铸印字, 背影凸起, 并涂上黑色油漆。
 - 日期: 抛光表面要插入的日期 (英文)。标志可用蚀刻或模压方法标在铭牌上, 标志字符高度不小于0.157" [4mm], 字符深度不少于0.004" [0.1mm]。
 - 铭牌位置见设备装配图。
 - 水压试验后由AI和质量控制检验员一起进行钢印。

*1: NB *2: SMe U

- 批准钢印空间。
- 批准日期。 (示例: 2019年3月1日)
- 试验日期指压力试验日期。
- REG. NO.: 注册号。

NOTES



- ALL DIMENSIONS SHALL BE IN US CUSTOMARY UNIT AS PRIMARY UNIT AND METRIC UNIT SHOWN IN BRACKET, UNLESS OTHERWISE SPECIFIED.
- FINISH: "FACE" MACHINED AND POLISHED INCLUDING CAST LETTERING. BACKGROUND KNURLD AND PAINTED BLACK.
- DATE: DATE ON POLISHED SURFACE IS TO BE INSERTED (IN THE ENGLISH LANGUAGE) BY MEANS OF ENGRAVING OR HARD STAMPING AND MUST BE CLEARLY LEGIBLE. THE HEIGHT OF THE LETTERING SHOULD BE APPROX. 0.157" [4mm]. THE DEPTH OF THE LETTERING SHOULD BE APPROX. 0.004" [0.1mm].
- FOR NAME PLATE LOCATION, SEE ASS'Y DWG. OF EQUIPMENT
- STAMPING SHALL BE MADE BY Q.C INSPECTOR AFTER HYDROSTATIC TEST WITH CONCURRENCE OF A.I

*1: NB *2: SMe U

- SPACE FOR AUTHORITY APPROVAL STAMP.
- DATE OF AUTHORITY APPROVAL. (EXAMPLE: 01 MAR 2019)
- TEST DATE MEANS DATE OF PRESSURE TEST.
- REG. NO.: REGISTRATION NUMBER.
- LETTERS AND FIGURES ON ASME NAME PLATES SHALL NOT BE LESS THAN 0.157" (4 MM) HIGH.

SECTION "A"-"A"

ASME铭牌详图
DETAIL OF ASME NAME PLATE

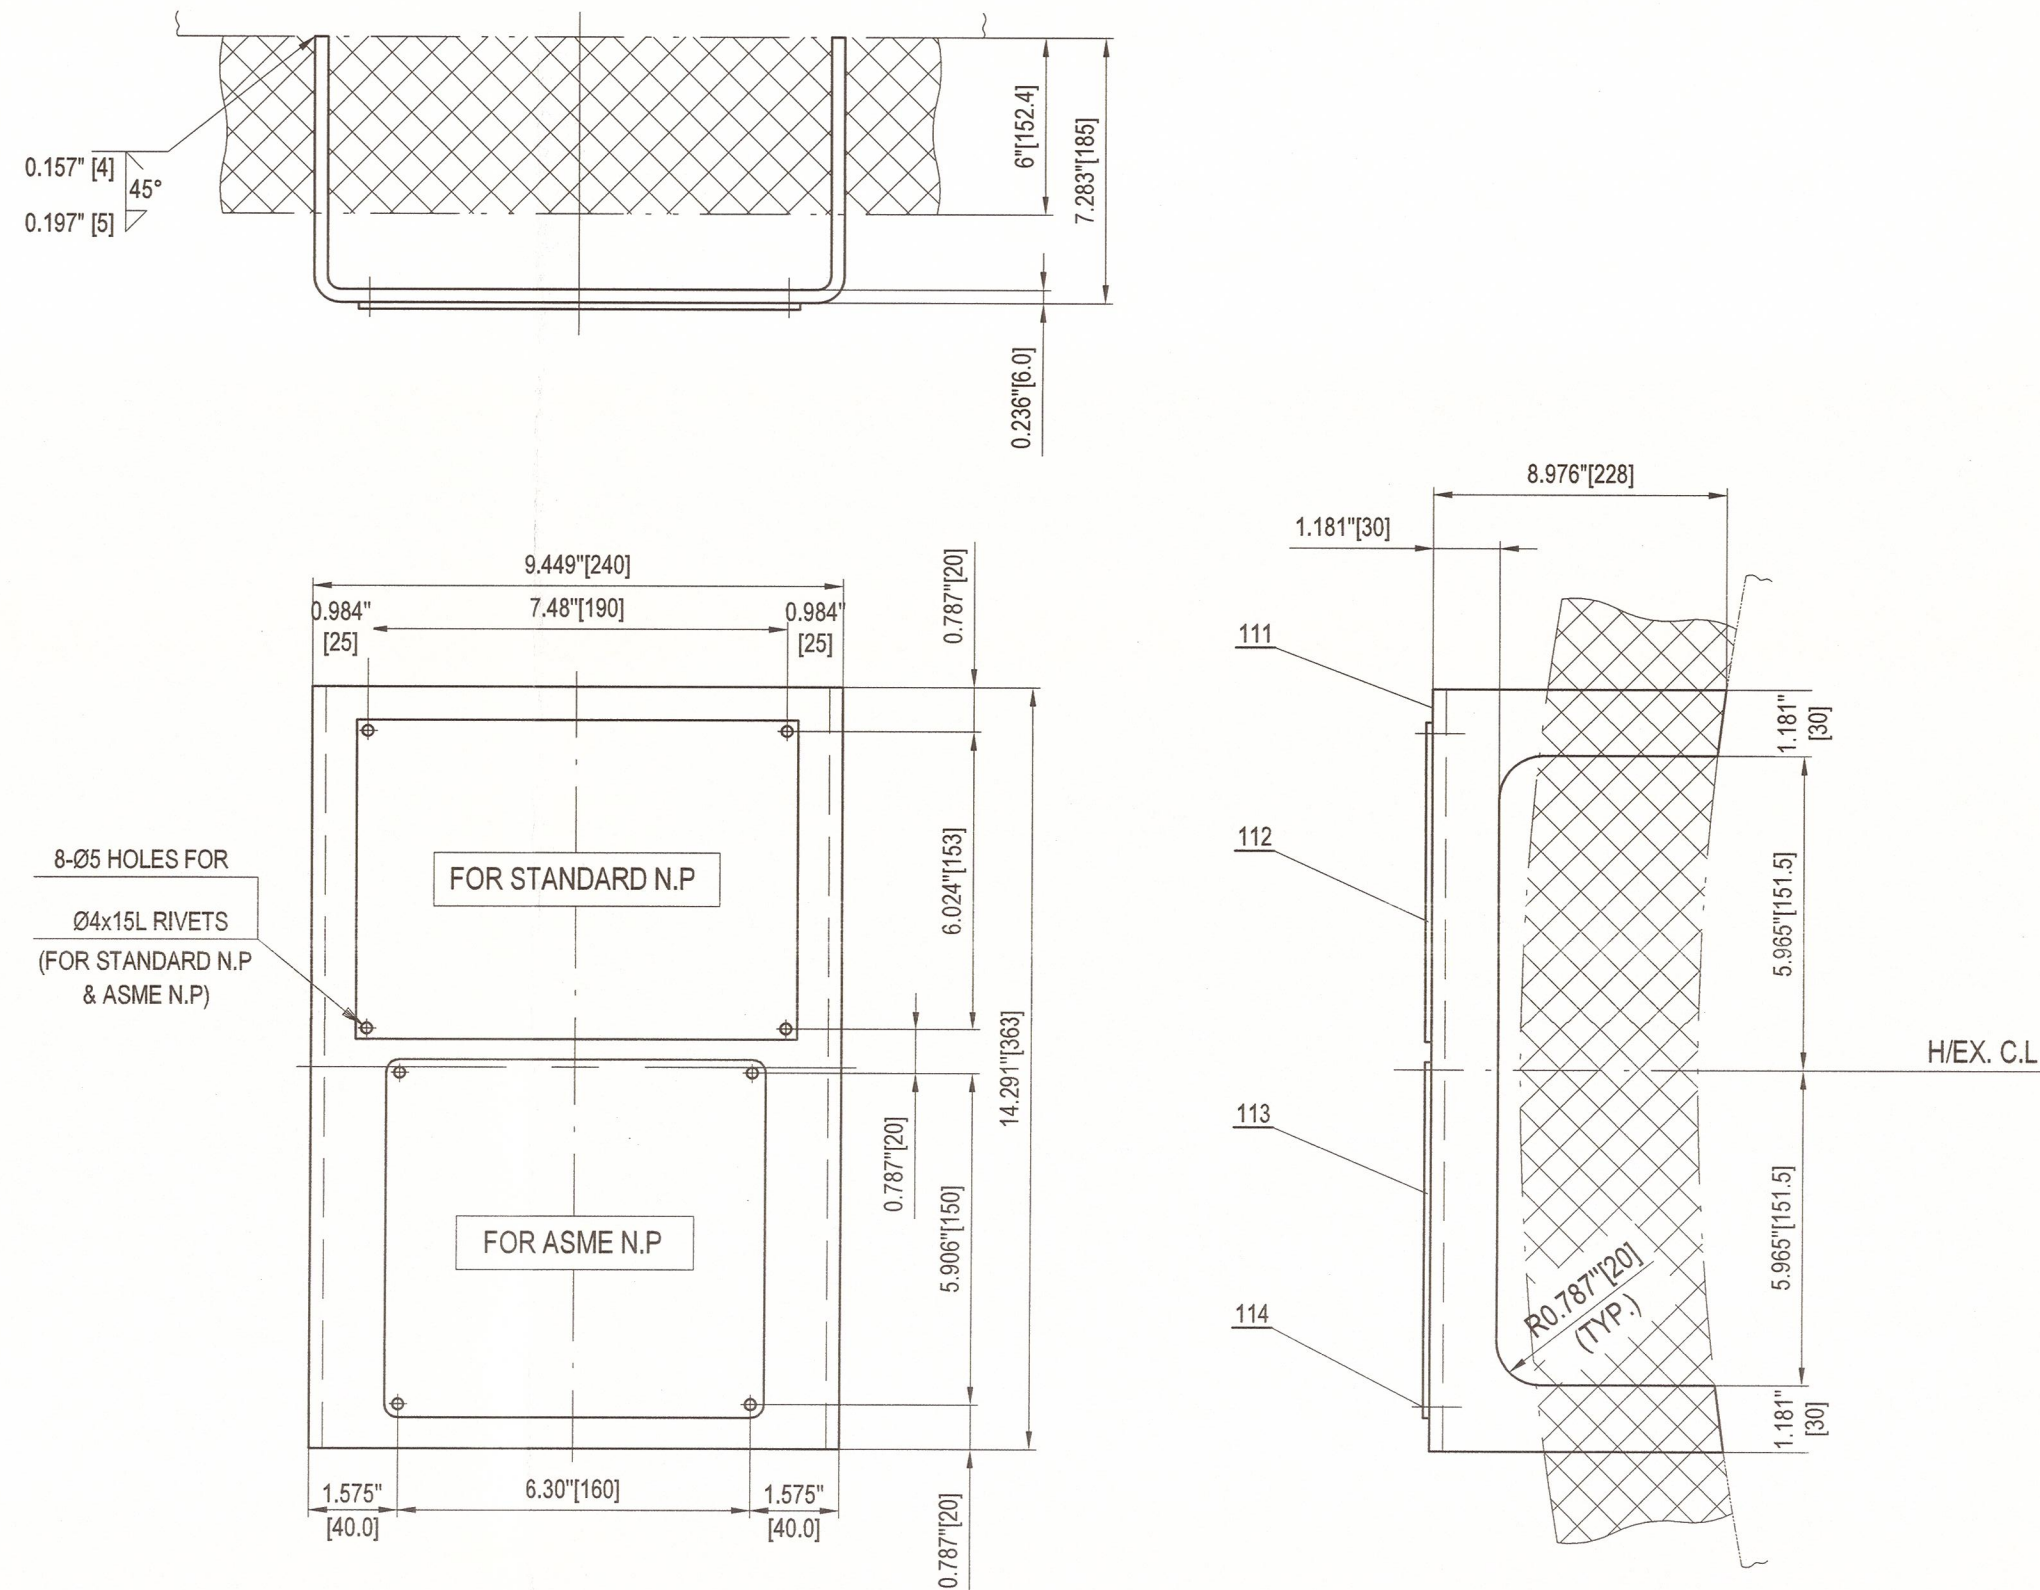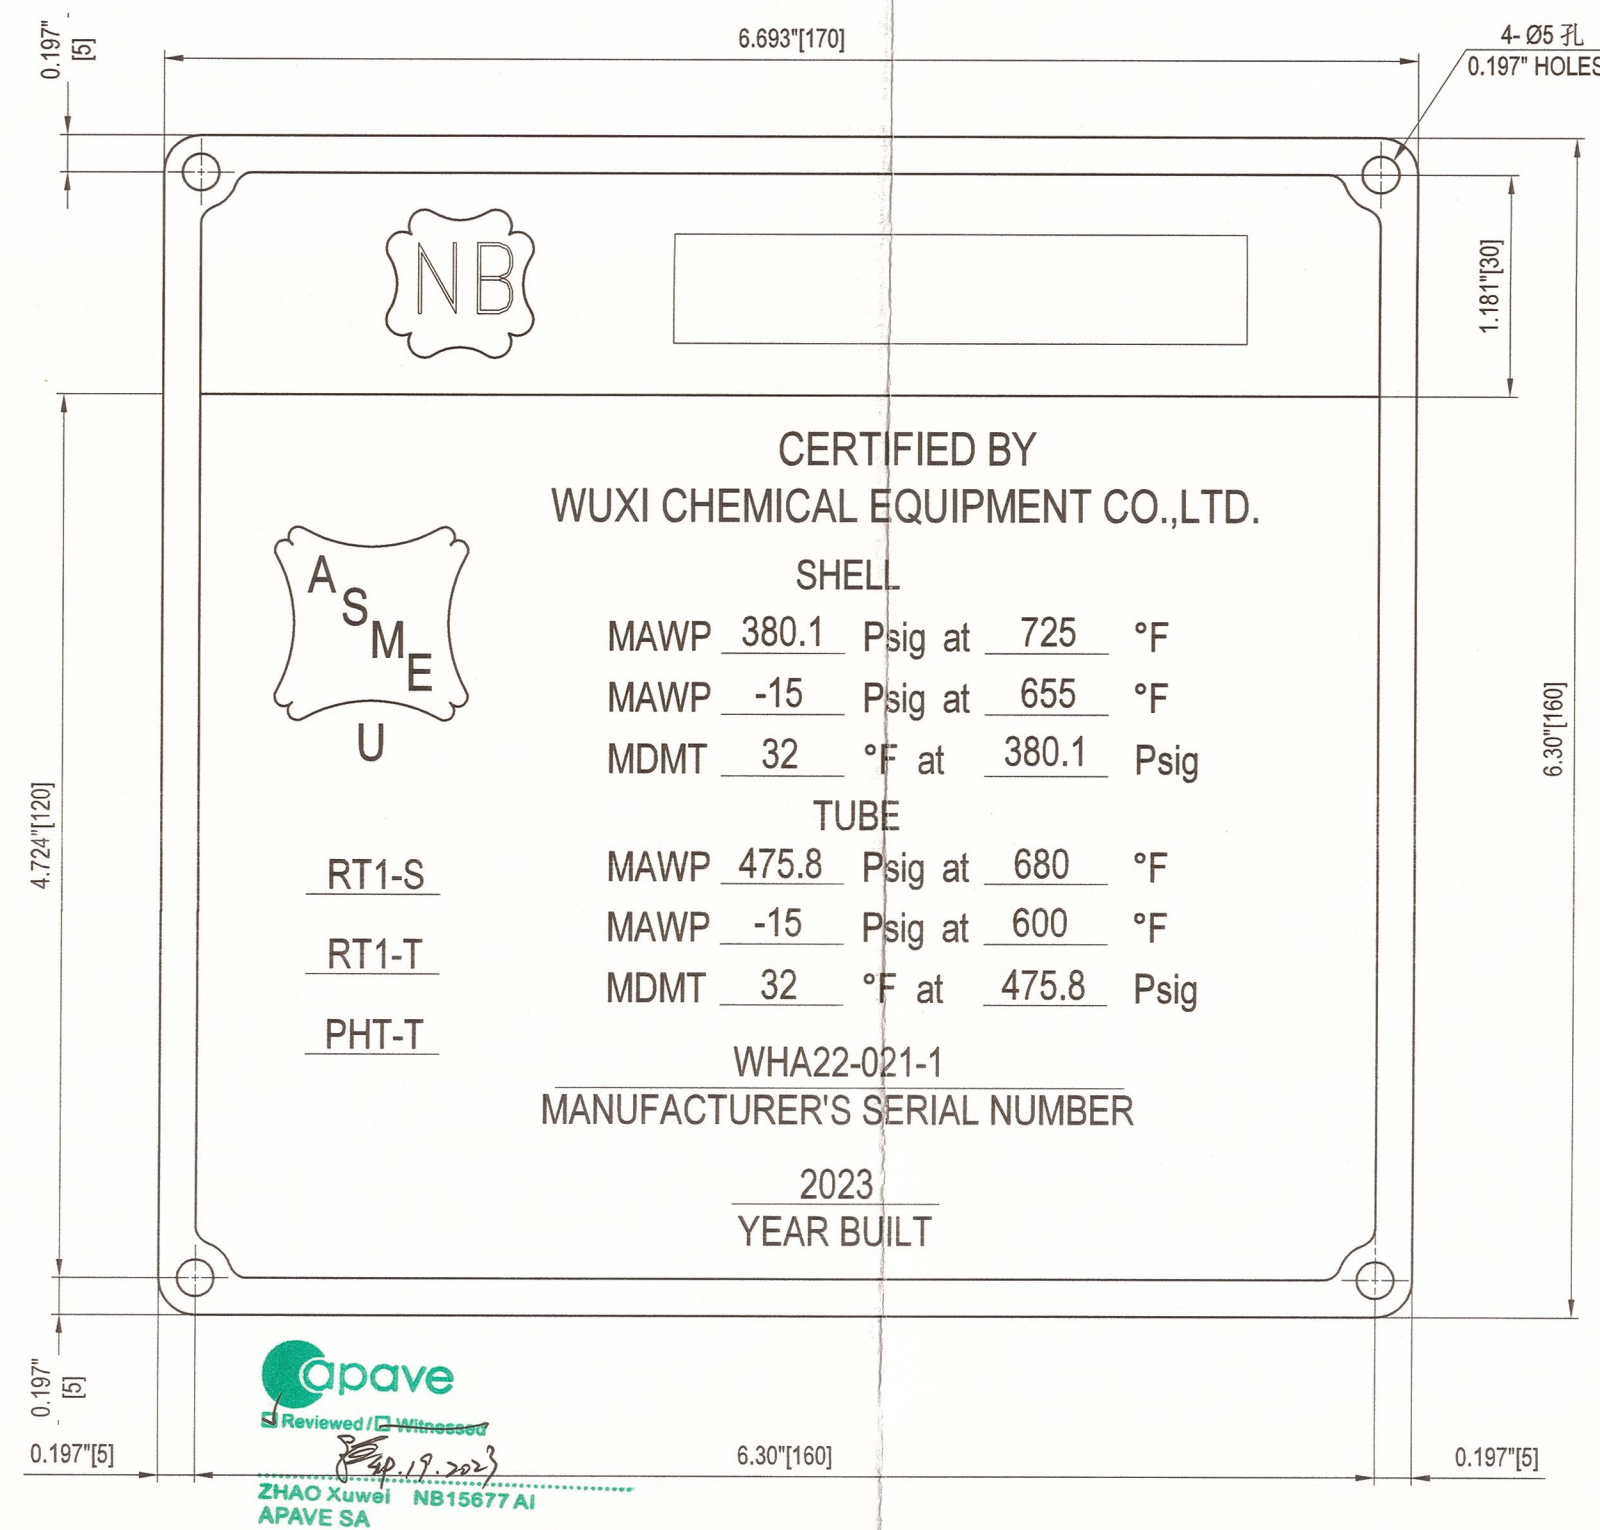

114		铆钉 Ø4x14 RIVET	8	SS304	/	
113		ASME铭牌 t=3 ASME NAMEPLATE	1	SS304	0.4	
112		标准铭牌 t=3 STANDARD NAMEPLATE	1	SS304	0.7	
111		支架 t=6 BRACKET	1	SA-516 Gr.70N	3.9	
件号 PART NO.	图号或标准号 DWG. OR STD. NO.	名称 DESCRIPTION	数量 QTY.	材料 MATERIAL	单件EACH 总计SUM 重量 WT. (kg)	备注 REMARK
AIR PRODUCTS			FLUOR.			
Air Products Project Number		EN207119	Fluor Project Number		A8KM	
Project Name		World Energy Renewables Project	RFQ No.		A8KM-4-403-RQ	
Purchase Order Number		4505600572	PO/Contract No		A8KM-4-403-PO-1	
Air Products Open Text document number		EN207119-WUXI-9V3-00074	Project Area		Renewable Jet Fuel Unit B	
Client		WORLD ENERGY PARAMOUNT		Client Doc No:		
04	竣工图/ AS BUILT		Zhiwei Lei	Shengfang Zhao	Kevin Yang	07-Apr-23
03	供批准/ ISSUED FOR APPROVAL		Zhiwei Lei	Shengfang Zhao	Kevin Yang	13-Oct-22
02	供批准/ ISSUED FOR APPROVAL		Zhiwei Lei	Shengfang Zhao	Kevin Yang	11-Aug-22
01	供批准/ ISSUED FOR APPROVAL		Zhiwei Lei	Shengfang Zhao	Kevin Yang	15-Jun-22
00	供批准/ ISSUED FOR APPROVAL		Zhiwei Lei	Shengfang Zhao	Kevin Yang	18-Apr-22
版次 REV.		版次说明/DESCRIPTION	设计/ PREPARED	审核/ REVIEWED	批准/ APPROVED	日期/ DATE
本图版权归为无锡化工装备股份有限公司财产,未经本公司许可不得转让或复制给第三方. The copyright of this drawing is the property of China Wuxi Chemical Equipment Co., Ltd.(WCE) unauthorized disclosure or duplication to the third party is not permitted.						
WCE			无锡化工装备股份有限公司 WUXI CHEMICAL EQUIPMENT CO., LTD.			World Energy Renewables Project
设计 PREPARED 审核 REVIEWED 批准 APPROVED			Product Fractionator Feed/Btms Exchanger No.2 NAMEPLATE DETAIL DRAWING		设计项目 DESIGN ITEM	World Energy Renewables Project
					设计阶段 DESIGN PHASE	详细设计 Detail Design
					设备位号 ITEM NO.	18-X-361
					图号 DWG. NO.	WXCE6711-05
比例: 1:1			版次: 04	第 1 页 共 1 页 PAGE 1 OF 1		