


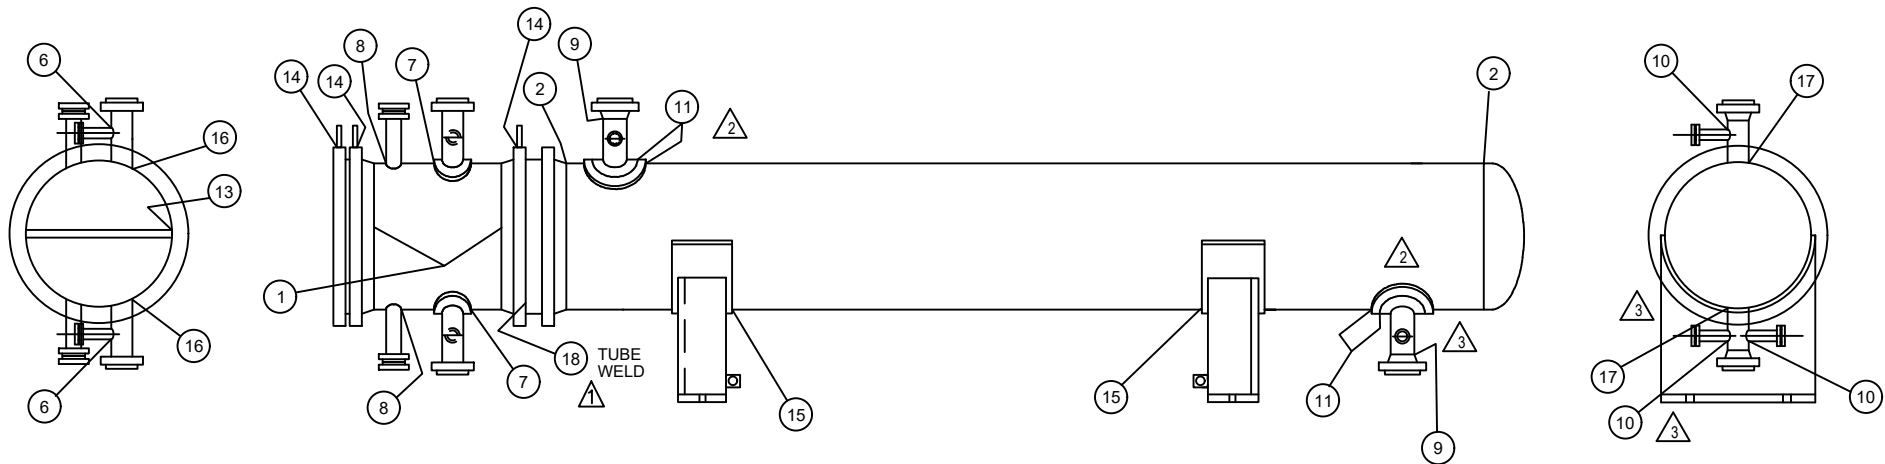

	X-RAY	U.T.	M.T.	P.T.	W.F.M.T.	BRINELL	MK.
CHANNEL CIRCULAR SEAM	X		X	X	X	X	(1)
SHELL CIRCULAR SEAM	X		X	X	X	X	(2)
DELETED							
DELETED							
DELETED							
CHANNEL AUX. TO PIPE		X	X	X	X	X	(6)
CHANNEL WELD PAD TO CYLINDER		X	X	X	X	X	(7)
CHANNEL V & D TO CYLINDER		X	X	X	X	X	(8)
SHELL NOZZLE FLANGE TO PIPE	X	X	X	X	X	X	(9)
SHELL AUX. TO PIPE			X	X	X	X	(10)
SHELL WELD PAD TO CYLINDER		X	X	X	X	X	(11)
DELETED							
PASS PLATE TO CYLINDER		X	X	X	X	X	(13)
LIFT LUG WELDS			X	X			(14)
SUPPORT PAD TO CYLINDER			X	X	X	X	(15)
CHANNEL NOZZLE TO CYLINDER		X	X	X			(16)
SHELL NOZZLE TO CYLINDER		X	X	X			(17)
TEMPORARY ATTACHMENT LOCATIONS			X	X			
TUBE SEAL WELD				X			(18)



PROJECT NAME: WORLD ENERGY RENEWABLES PROJECT
 EQUIPMENT OWNER: AIR PRODUCTS MANUFACTURING LLC
 SERVICE: STRIPPER FEED / DEBUTANIZER BOTTOMS EXCHANGER
 LOCATION: WORLD ENERGY, PARAMOUNT, CA. USA
 PRODUCT: STRIPPER FEED / DEBUTANIZER BOTTOMS EXCHANGER
 ITEM NO.: 18-X-372A
 AIR PRODUCTS P.O. NO.: 4505600057 / A8KM-4-402-PO-2
 AP PROJECT NO: EN-20-7120
 VDR CODE NO.: QD07
 SERIAL NO.: S21-13258-9
 ENGINEER: EG
 CUSTOMER / CLIENT: WORLD ENERGY PARAMOUNT

			NDE MAP		
			DWN. BY	Fabsco SHELL & TUBE, LLC	
			B.W.		
			DATE		
			5/24/22		
			CKD. BY	DWG. No.	REV.
			MO	S21-13258-9-19	3
NO.	DATE	REVISIONS			
(A)	4/21/23	REV. "AS BUILT" / FABSCO AS/DD			
(A)	1/10/23	REV. PER CUST. COMMENTS DD/DG			
(A)	7/12/2022	REV./CUST. COMMENTS GD/DD			