


Allowable Piping Forces & Moments

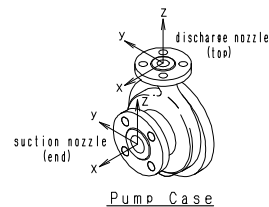

Fsx	Fsy	Fsz	Fdx	Fdy	Fdz
300	240	200	160	130	200
Msx	Msy	Msx	Mdx	Mdy	Mdz
700	350	530	340	170	260

NOTE : F = force (lb) W = moment (lb-ft)

S = suction nozzle

d = discharge nozzle

See the figure for orientation of nozzle loads (x,y,z)

The allowable force & moment is 2 times the value shown in table.

Description: Canned Motor Pump (Sealless Pump)


Customer : World Energy Paramount
 Equipment Owner : Air Products Manufacturing LLC
 APCI No. : EN207123-TEI-9V3-00022 & EN207123-TEI-9V3-00008
 Order No. : 4505499562
 Job No. : A8KM
 Project Name : World Energy Renewable Project
 Item No. : 18-P-1857 A/B
 Item Name : Aqueous Ammonia Loading Pump
 Model : F41-416C4XM-0508TG1-AV
 Total Weight (includes baseplate) : 530lbs (240kg)

Note

- Center of gravity
- A connection port for the pneumatic test for the secondary containment shell.
After the test, this will be plugged and welded to close.
- Anchor Bolts shall be supplied by Other

NOZZLE

- a...Casing Drain ASME150Lb 3/4" RF
 b...Rotor Cavity Drain ASME150Lb 3/4" RF
 c...Terminal Box for Power NPT1
 d...Terminal Box for Protection NPT3/4
 e...Pressure Transmitter NPT1/2

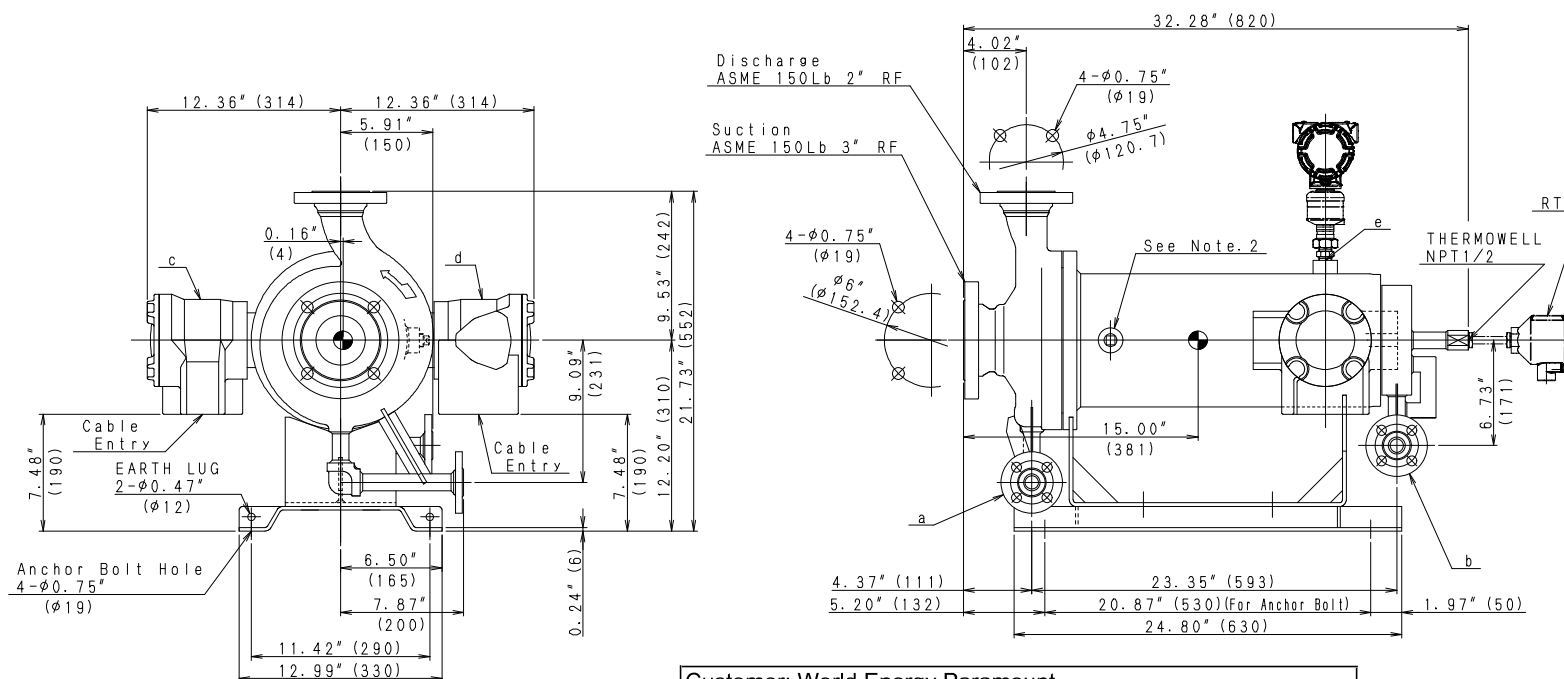

Customer: World Energy Paramount
 Equipment Owner: Air Products Manufacturing LLC
 APCI No: EN207123-TEI-9V3-00022 , EN207123-TEI-9V3-00008
 Order No: 4505499562
 Job No: A8KM
 Project Name: World Energy Renewables Project
 Item No: 18-P-1857 A/B
 Item Name: Aqueous Ammonia Loading Pump
 Model:F41-416C4XM-0508TG1-AV

REV. NO.	REVISIONS	DATE	DRN	CHKD	APPD
C	Rewritten	May-24-22	KN	MM	
B	Rewritten	Feb-2-22	KN	MM	KA

DWG. TITLE

GENERAL ARRANGEMENT DRAWING

VENDOR



株式会社 帝国電機製作所
 TEIKOKU ELECTRIC MFG. CO., LTD.

SCALE	SIZE	SHEET	REV.
1:6	A2	1/1	C

DWG. No. 6L-6144

AS-BUILT

6M-0946

TERMINAL BOX-A
(For power)LEFT SIDE FROM
PUMP SUCTION

NPT 1

SOURCE SIDE

NPT 3/4

PROTECTION SIDE

TERMINAL BOX-B
(For protection)RIGHT SIDE FROM
PUMP SUCTION

NPT 3/4

PROTECTION SIDE

TERMINAL MARK

<T. BOX-A>

U·V·W·····POWER SOURCE (M6)

1·2·····THERMOCOUPLE (M4)

G1·G2·····TRG METER (M4)

TERMINAL MARK

<T. BOX-B>

U·V·W·····NOT USED

1, 2, G2·····RTD (for stator liner) (M4)

G1·····NOT USED

No.	NAME
1	TERMINAL BOX
2	TERMINAL COVER
3	TERMINAL PLATE
4	EARTH TERMINAL
5	GASKET
6	O-RING
7	TRG METER
8	O-RING

FP1520A

REVISIONS

AS-BUILT

Customer: World Energy Paramount
Equipment Owner: Air Products Manufacturing LLC
APCI No: EN207123-TEI-9V3-00021, EN207123-TEI-9V3-00014
Order No: 4505499562
Job No: A8KM
Project Name: World Energy Renewables Project
Item No: 18-P-1857 A/B
Item Name: Aqueous Ammonia Loading Pump
Model:F41-416C4XM-0508TG1-AV

APPROVED

CHECKED

DRAWN

E. Fujimura
Oct. 22, '21

SCALE

FREE

DWG. TITLE

端子箱

TERMINAL BOX

S HERMETIC SEALS (WITH O-RING)

DWG. NO.



株式会社 帝国電機製作所

TEIKOKU ELECTRIC MFG. CO., LTD.

6M-0946

6 L - 6 1 5 6

NOTE

Bearing A···with spiral & straight grooves

Bearing B···with spiral grooves



NO.	NAME OF PARTS	NO.	NAME OF PARTS
01	CASING	48	SET SCREW
02	IMPELLER		
14	R. B. HOUSING	53 A	SPRING WASHER
15 A	BEARING B	53 B	SPRING WASHER
15 B	BEARING A	53 C	SPRING WASHER
16	SHAFT	54	PLAIN WASHER
17	SHAFT SLEEVE	55 A	WASHER
18	THRUST COLLAR	55 B	WASHER
19	ROTOR ASSY	55 C	WASHER
20	STATOR ASSY	56 A	ADJUSTING WASHER
21	ROTOR CAN	56 B	ADJUSTING WASHER
22	STATOR CAN	57 A	LOCK WASHER
24	TERMINAL BOX ASSY	57 B	LOCK WASHER
		58 A	KEY
32	F. B. HOUSING	58 B	KEY
40	BASE		
41	HOLDER	64	SPACER
46 A	BOLT	66 A	GASKET
46 B	BOLT	66 B	GASKET
46 C	BOLT		
46 D	BOLT	900	THERMOWELL
46 E	BOLT		
46 F	BOLT		

FP1520A

REVISIONS

Customer: World Energy Paramount
Equipment Owner: Air Products Manufacturing LLC
APCI No: EN207123-TEI-9V3-00020 , EN207123-TEI-9V3-00015
EN207123-TEI-9V3-00019
Order No: 4505499562
Job No: A8KM
Project Name: World Energy Renewables Project
Item No: 18-P-1857 A/B
Item Name: Aqueous Ammonia Loading Pump
Model: F41-416C4XM-0508TG1-AV

AS-BUILT

APPROVED

CHECKED

DRAWN

E. Fujimura
Oct. 25, '21

SCALE

FREE

DWG. TITLE 構造断面図

SECTIONAL VIEW DRAWING

TYPE: F-V

DWG. NO.

株式会社 帝国電機製作所
TEIKOKU ELECTRIC MFG. CO., LTD.

6 L - 6 1 5 6

(1/1)

FM1257A

P-34513

AS-BUILT

AS-BUILT**ESTIMATED PERFORMANCE CURVE**

Date : Mar. 07. 2022
No : E29P0058-00
Dwg. No. : SFP-1520A

Item No. 18-P-1857 A/B

Item Name

Aqueous Ammonia Loading Pump

Model **F41-416C4XM-0508TG1-AV**

Frequency 60 Hz

Voltage 460 V

Phase 3

Pole 2

Output 14.8/11 HP/kW

Current 21 A

Total Head 80.7 ft

Capacity 150 gpm 34.07 m3/h

Min.Flow 44.91 gpm 10.2 m3/h


Liquid 19% Aqueous Ammonia

Temp. 70 degF

S.G. 0.93

NPSHavail. 10.6 ft Vis. 1.1 mPas

NPSHreq. 7.6 ft

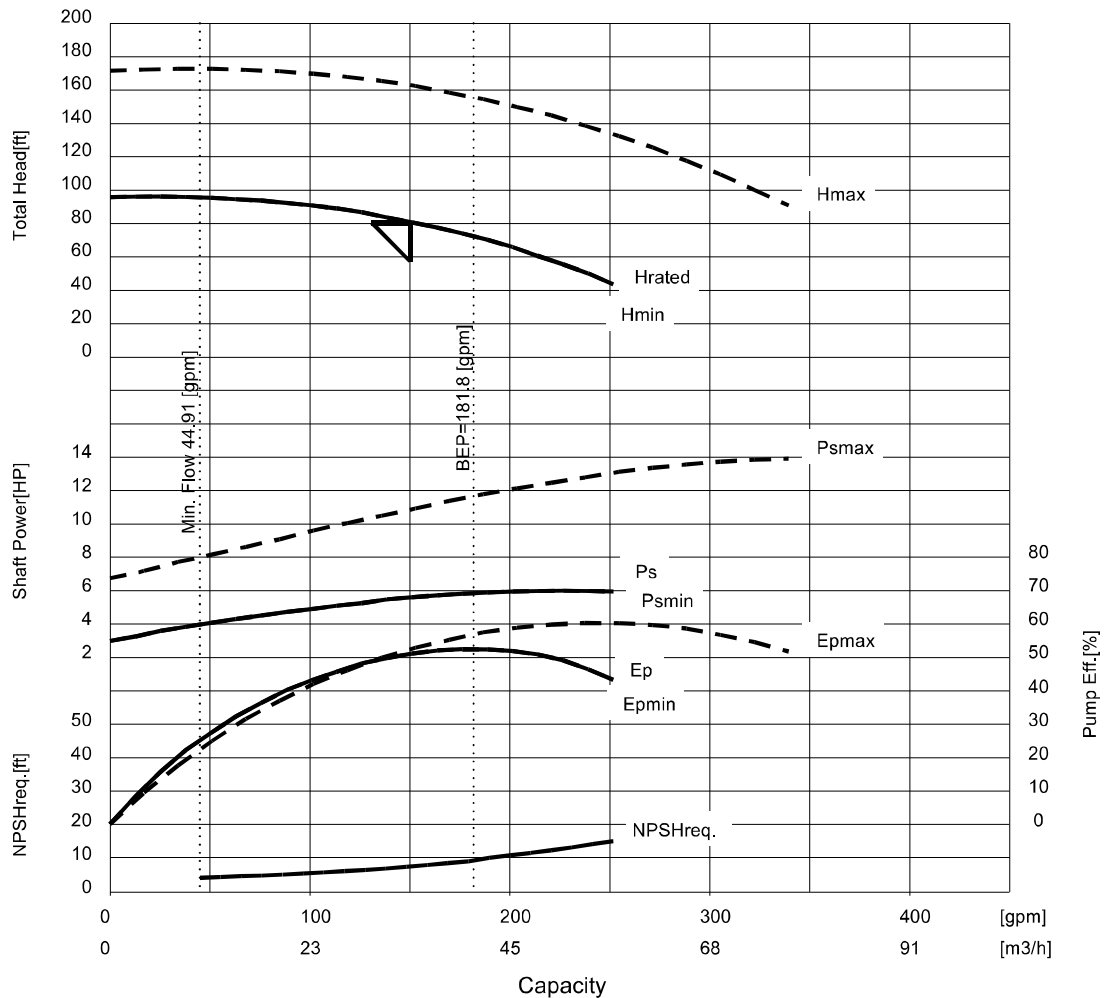**Remarks :**

- Shut-off head : 95.7ft
- 81.1ft, 51.1%, 5.58HP, 3558rpm @ rated flow
- 251.8gpm, 5.94HP @ EOC
- 13.91HP @ EOC (max. dia.)

- Ns : 1375, SSS : 10111
- Impeller Dia(mm):166(Max)/ 130(Rated)/ 130(Min)
- Impeller Dia(in.):6.53(Max)/ 5.12(Rated)/ 5.12(Min)
- Proposal Curve E29P0058-00

D	Mar.7.2022	Revised(K.Nakazumi)	
C	Feb.2.2022	Revised(K.Nakazumi)	
B	Oct.25.2021	Revised(E.Fujimura)	
REV.	Date	Description	


APPROVED BY	CHECKED BY	DRAWN BY
K.Akashi	M.Morii	K.Nakazumi

TEIKOKU ELECTRIC MFG. CO., LTD.

UNIS Version 3.6.6

NDTS12_07

6M-0947

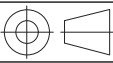


SYMBOLS	NAME
R S T	POWER SOURCE
U V W	POWER TERMINAL
MC	MAGNETIC CONTACTOR
TRG	TEIKOKU ROTARY GUARDIAN (Bearing wear and rotating direction indicator.)

熱電対 THERMOCOUPLE	
耐熱クラス THERMAL CLASS	220
設定温度 SETTING CUTOFF TEMP.	190℃/374°F

RESISTANCE TEMPERATURE DETECTOR (RTD)	
ELEMENT	Pt100Ω at 0℃ (R100/R0=1.3851)
CLASS	A (IEC 60751)
LEAD CONNECTION	3 LEAD-TYPE
MEASURING CURRENT	< 1 mA
TEMPERATURE RANGE	-94℃~+500℃
NUMBER OF ELEMENT	SINGLE


R S T

TEIKOKU SUPPLY

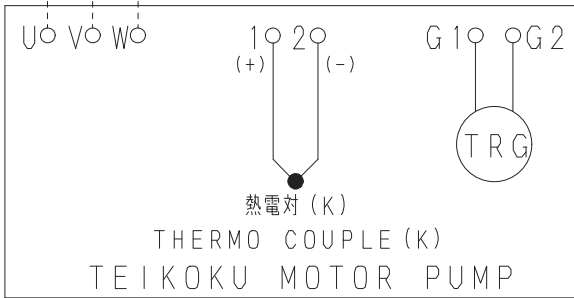

TERMINAL BOX-A (For power)
LEFT SIDE FROM PUMP SUCTION

TEIKOKU SUPPLY

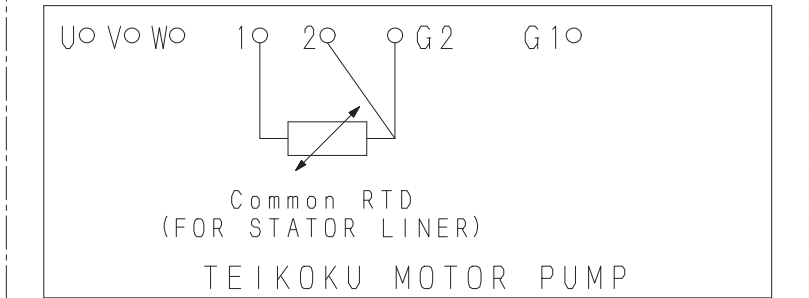

TERMINAL BOX-B (For protection)
RIGHT SIDE FROM PUMP SUCTION








FP1520A

REVISIONS	B
Revised	Feb. 1' 22
E. Fujimura	

AS-BUILT

APPROVED	CHECKED	DRAWN	SCALE	DWG. TITLE
<i>Kakochi</i>	<i>M. Mori</i>	E. Fujimura Oct. 22 '21	FREE	結線図 CONNECTION DIAGRAM
DWG. NO.				6M-0947
株式会社 帝国電機製作所 TEIKOKU ELECTRIC MFG. CO., LTD.				B


SPARE PARTS LIST

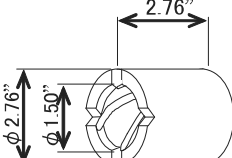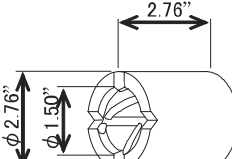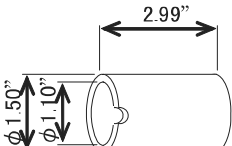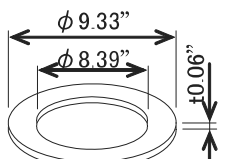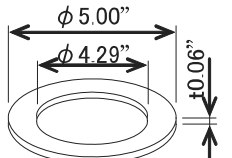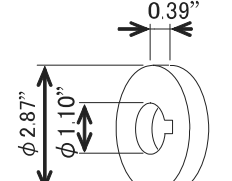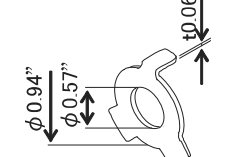TYPE				SP-FP1520A		1
F-V, R 410-T						1
No.	PARTS NAME	DIMENSION	MATERIAL	FOR 1SETS	TOTAL	REMARKS
1	BEARING B		Carbon Graphite	1	4	#15A 70 × 38 × 70 (mm) ID No. 4D1794-01-6430-K
2	BEARING A (with spiral & straight grooves)		Carbon Graphite	1	4	#15B 70 × 38 × 70 (mm) ID No. 4D1799-01-6430-K
3	SHAFT SLEEVE		316 SS (SUS316) + Stellite	2	4	#17 38 × 28 × 76 (mm) ID No. 4C1164-01-6200-K
4	GASKET		PTFE (T/#9007-LC)	1	4	#66A 237 × 213 × 1.5 (mm) ID No. 4H1588-10-9900
5	GASKET		PTFE (T/#9007-LC)	1	4	#66B 127 × 109 × 1.5 (mm) ID No. 4H1588-08-9900
6	THRUST COLLAR		316 SS (SUS316) + Stellite	2	4	#18 73 × 28 × 10 (mm) ID No. 4C1167-01-6200-K
7	LOCK WASHER		316L SS (SUS316L)	2	2	#57A, #57B 24 × 14.5 × 1.5 (mm) ID No. 4G5928-01-0430
REV.		 株式会社 帝国電機製作所 TEIKOKU ELECTRIC MFG. CO., LTD.		APPROVED	CHECKED	DRAWN
				K. Akashi	M. Mor i i	K. Nakazumi Oct. 22. '21

FP1520A

AS-BUILT

4N-9587-04

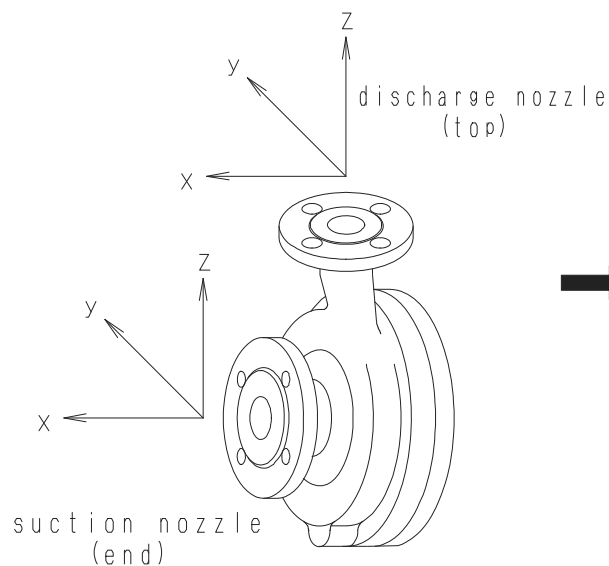CASING

#No	PUMP TYPE	F _{sx}	F _{sy}	F _{sz}	F _{dx}	F _{dy}	F _{dz}	M _{sx}	M _{sy}	M _{sz}	M _{dx}	M _{dy}	M _{dz}
1	0204	200	160	130	160	130	200	340	170	260	340	170	260
2	0405	200	160	130	160	130	200	340	170	260	340	170	260
3	0408	300	240	200	160	130	200	700	350	530	340	170	260
4	0508	300	240	200	160	130	200	700	350	530	340	170	260
5	0810	400	320	260	240	200	300	980	500	740	700	350	530
6	1015	700	560	460	320	260	400	1700	870	1300	980	500	740
7	1520	1100	850	700	560	460	700	2600	1300	1900	1700	870	1300
8	0305	200	160	130	160	130	200	340	170	260	340	170	260
9	1012	550	440	360	320	260	400	1340	685	1020	980	500	740
10	0608	300	240	200	200	165	250	700	350	530	520	260	395
11	0815	400	320	260	320	260	400	980	500	740	980	500	740

NOTE : F = force (lb) M = moment (lb-ft)

s = suction nozzle

d = discharge nozzle

See the figure for orientation of nozzle loads (x, y, z)

The allowable force & moment is twice
of the value shown in table.

FJ1962A

REVISIONS	B	C	D	E	AS-BUILT	APPROVED	CHECKED	DRAWN	SCALE	DWG. TITLE		
	Revised Apr. 26 '17 N. Kaiami	Revised May. 30 '17 N. Kaiami	#10 Added Oct. 21 '19 H. Koike	#11 Added Oct. 8 '21 Y. Iguchi		K. Akashi	M. Morii	K. Nakazumi Mar. 6 '17	FREE	ALLOWABLE PIPING FORCES AND MOMENTS		
										T/USA	API 685 (2nd)	
										DWG. NO.	4N-9587-04	




株式会社 帝国電機製作所

TEIKOKU ELECTRIC MFG. CO., LTD.

E

1
4N-7613

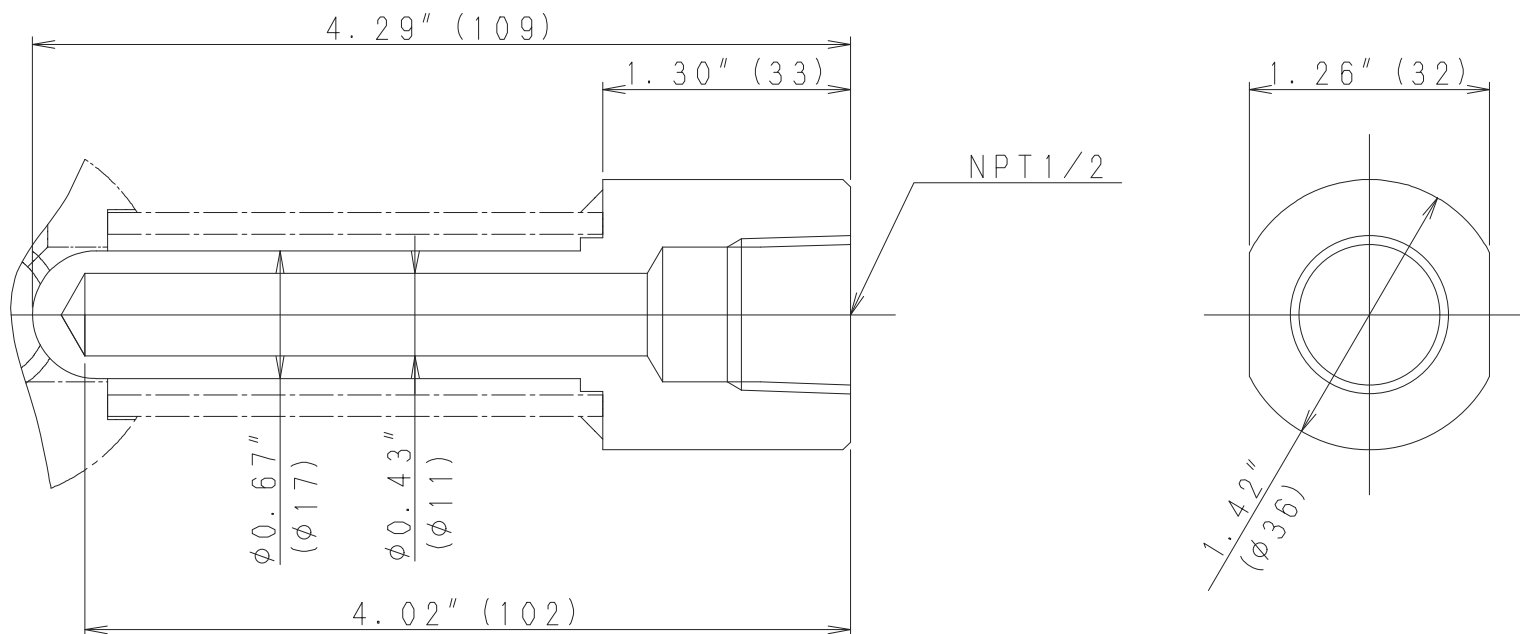

FC1250A
FC1251A

D
REVISIONS

B
Rewritten
Jul. 30 '21
K. Nakazumi

AS-BUILT

APPROVED

Kakuh

CHECKED

M. Mori

DRAWN

K. Nishizuka
Oct. 1 '10

SCALE

FREE

DWG. TITLE

THERMOWELL

DWG. NO.




株式会社 帝国電機製作所

TEIKOKU ELECTRIC MFG. CO., LTD.

4N-7613

B

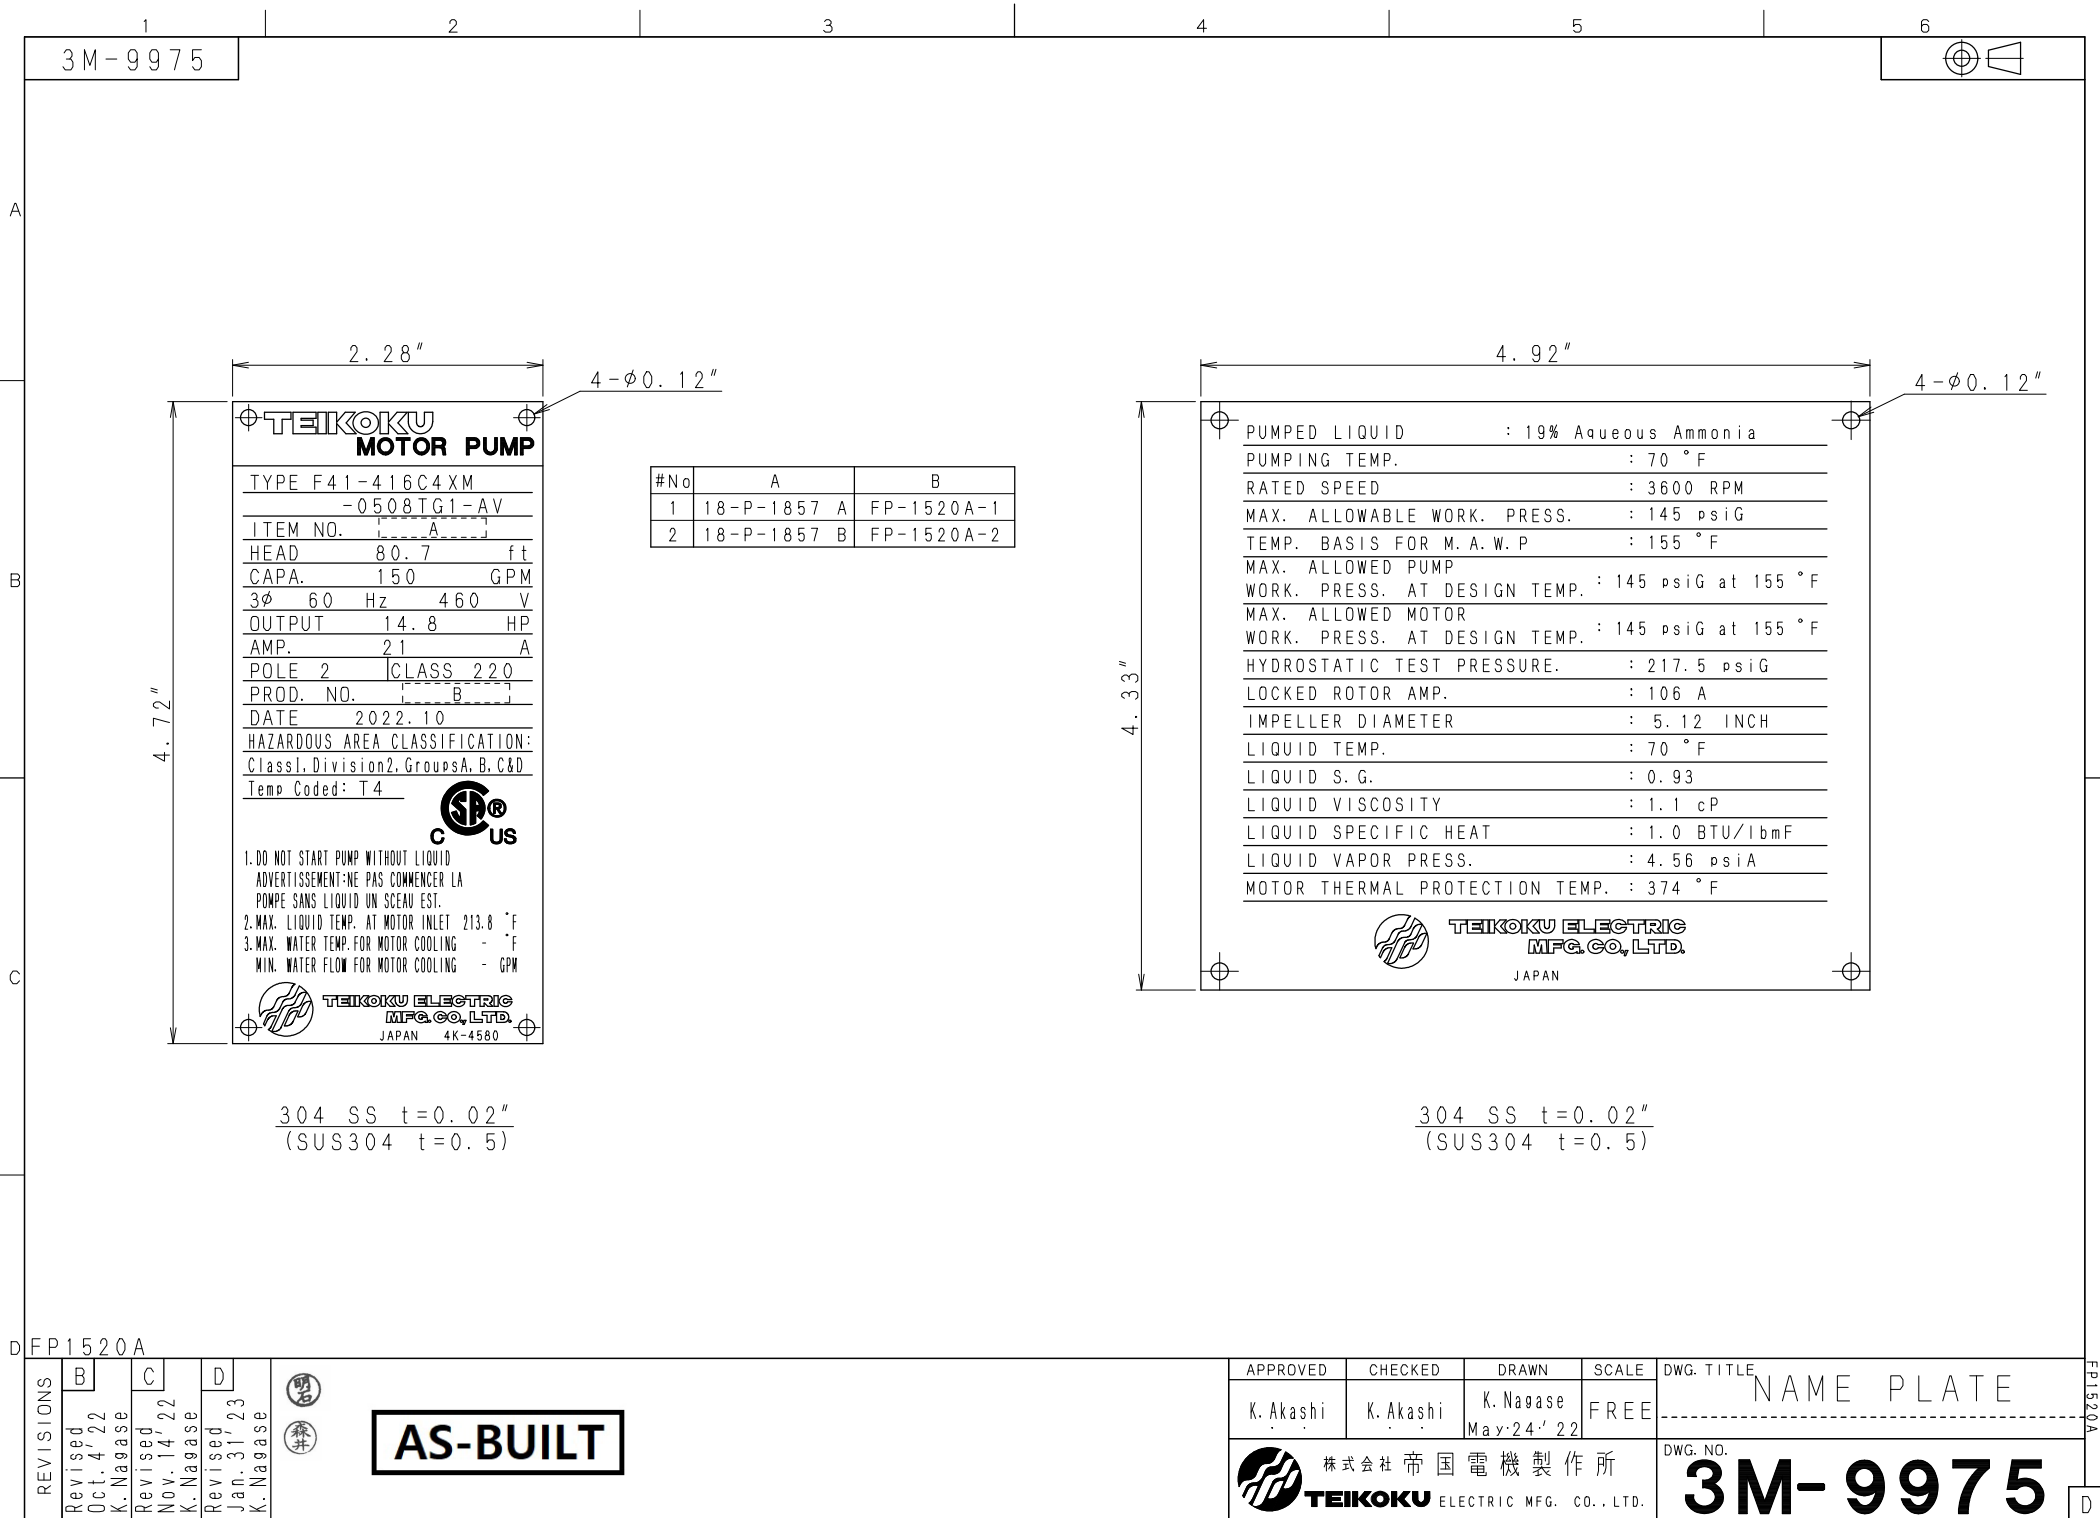

TEIKOKU MOTOR PUMP

Installation Manual

IMPORTANT INFORMATION

- Before operating your canned motor pump, read this “Caution Notes for Your Safety” to ensure correct and safe operation or work. It is essential for your safety.

TEIKOKU ELECTRIC MFG. CO., LTD.

AS-BUILT

1. CAUTION NOTES FOR YOUR SAFETY TEIKOKU Canned motor Pumps

FOR YOUR SAFETY (1)

Hazards are listed at two levels DANGER & CAUTION




Ignoring this warning can cause serious injury or even death

DANGER


Ignoring this warning can cause personal injury and/or damage to the pump

CAUTION**DO NOT RUN DRY!**

If the pump is allowed to run dry, the bearings, sleeves and other components could be damaged and serious overheating of the motor windings can occur.

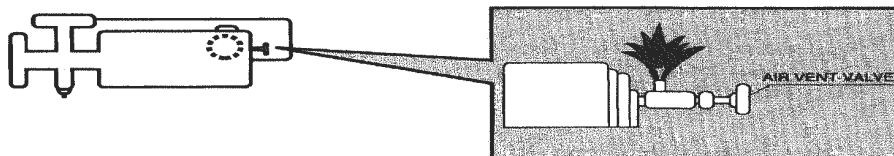
**OPEN VENT VALVE SLOWLY!**

You must exercise caution, even when the pump is not operating, internal pressures can be high at any time. For toxic liquids, proper safety methods must be observed.

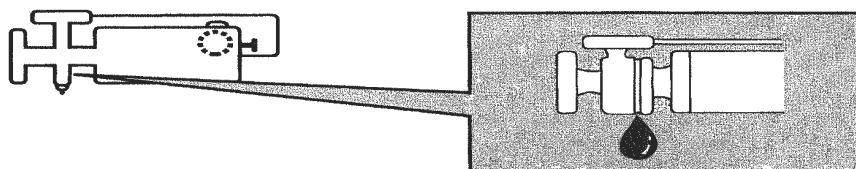**AVOID RAPID TEMPERATURE CHANGES!**

Large changes in temperature must be avoided. Rapid changes can cause leaks to occur in gaskets. Published procedures for proper heating and cooling must be followed. If published procedures are not available check with Teikoku before operating the equipment.

 **HOT - DO NOT TOUCH!**

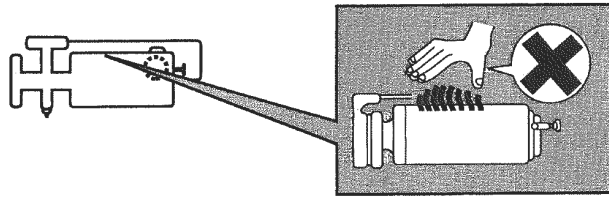

Motor and pump can be hot, even when pumping cold liquids.


FOR YOUR SAFETY (2)

TEIKOKU Canned motor Pumps

Hazards are listed at two levels


DANGER & CAUTION

 **IF MOTOR TRIPS, DO NOT RESTART BEFORE DETERMINING THE CAUSE!**

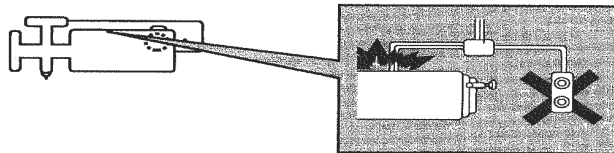

Restarting the motor before ascertaining the cause may result in excessive heat causing pump or motor failure.


 **DO NOT REMOVE INTERNAL BOLTS IN TERMINAL BOX!**

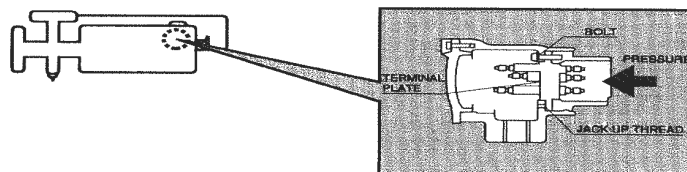

If it is necessary to remove the terminal box for any reason, first loosen the bolts by 2 or 3 turns to check if any internal pressure or liquid is present. You must take measures if the possibility exists that the gas or liquid is toxic or hazardous to personnel or the environment.



DO NOT REMOVE ANY BOLTS ON PUMP, MOTOR OR DRAIN PLUGS!

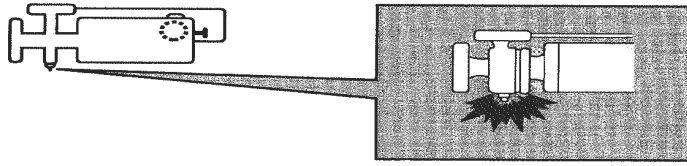

The internal pressure can be higher than the atmosphere. Always loosen the drain plug slowly to relieve any internal pressure before attempting to disassemble the pump. You must take adequate precautions if the liquid in the pump could be hazardous to personnel or the environment.



ALWAYS ASSUME THAT THERE IS LIQUID LEFT IN THE PUMP!

There is always the possibility that residual liquid could remain in the pump and motor in spite of through decontamination. Pay particular attention to the clearance between the shaft and the impeller, bearings, sleeves, bearing housings and gaskets. You must take adequate precautions to protect personnel and the environment if the liquid could be considered hazardous.



This pump has been evaluated for use with water only.