


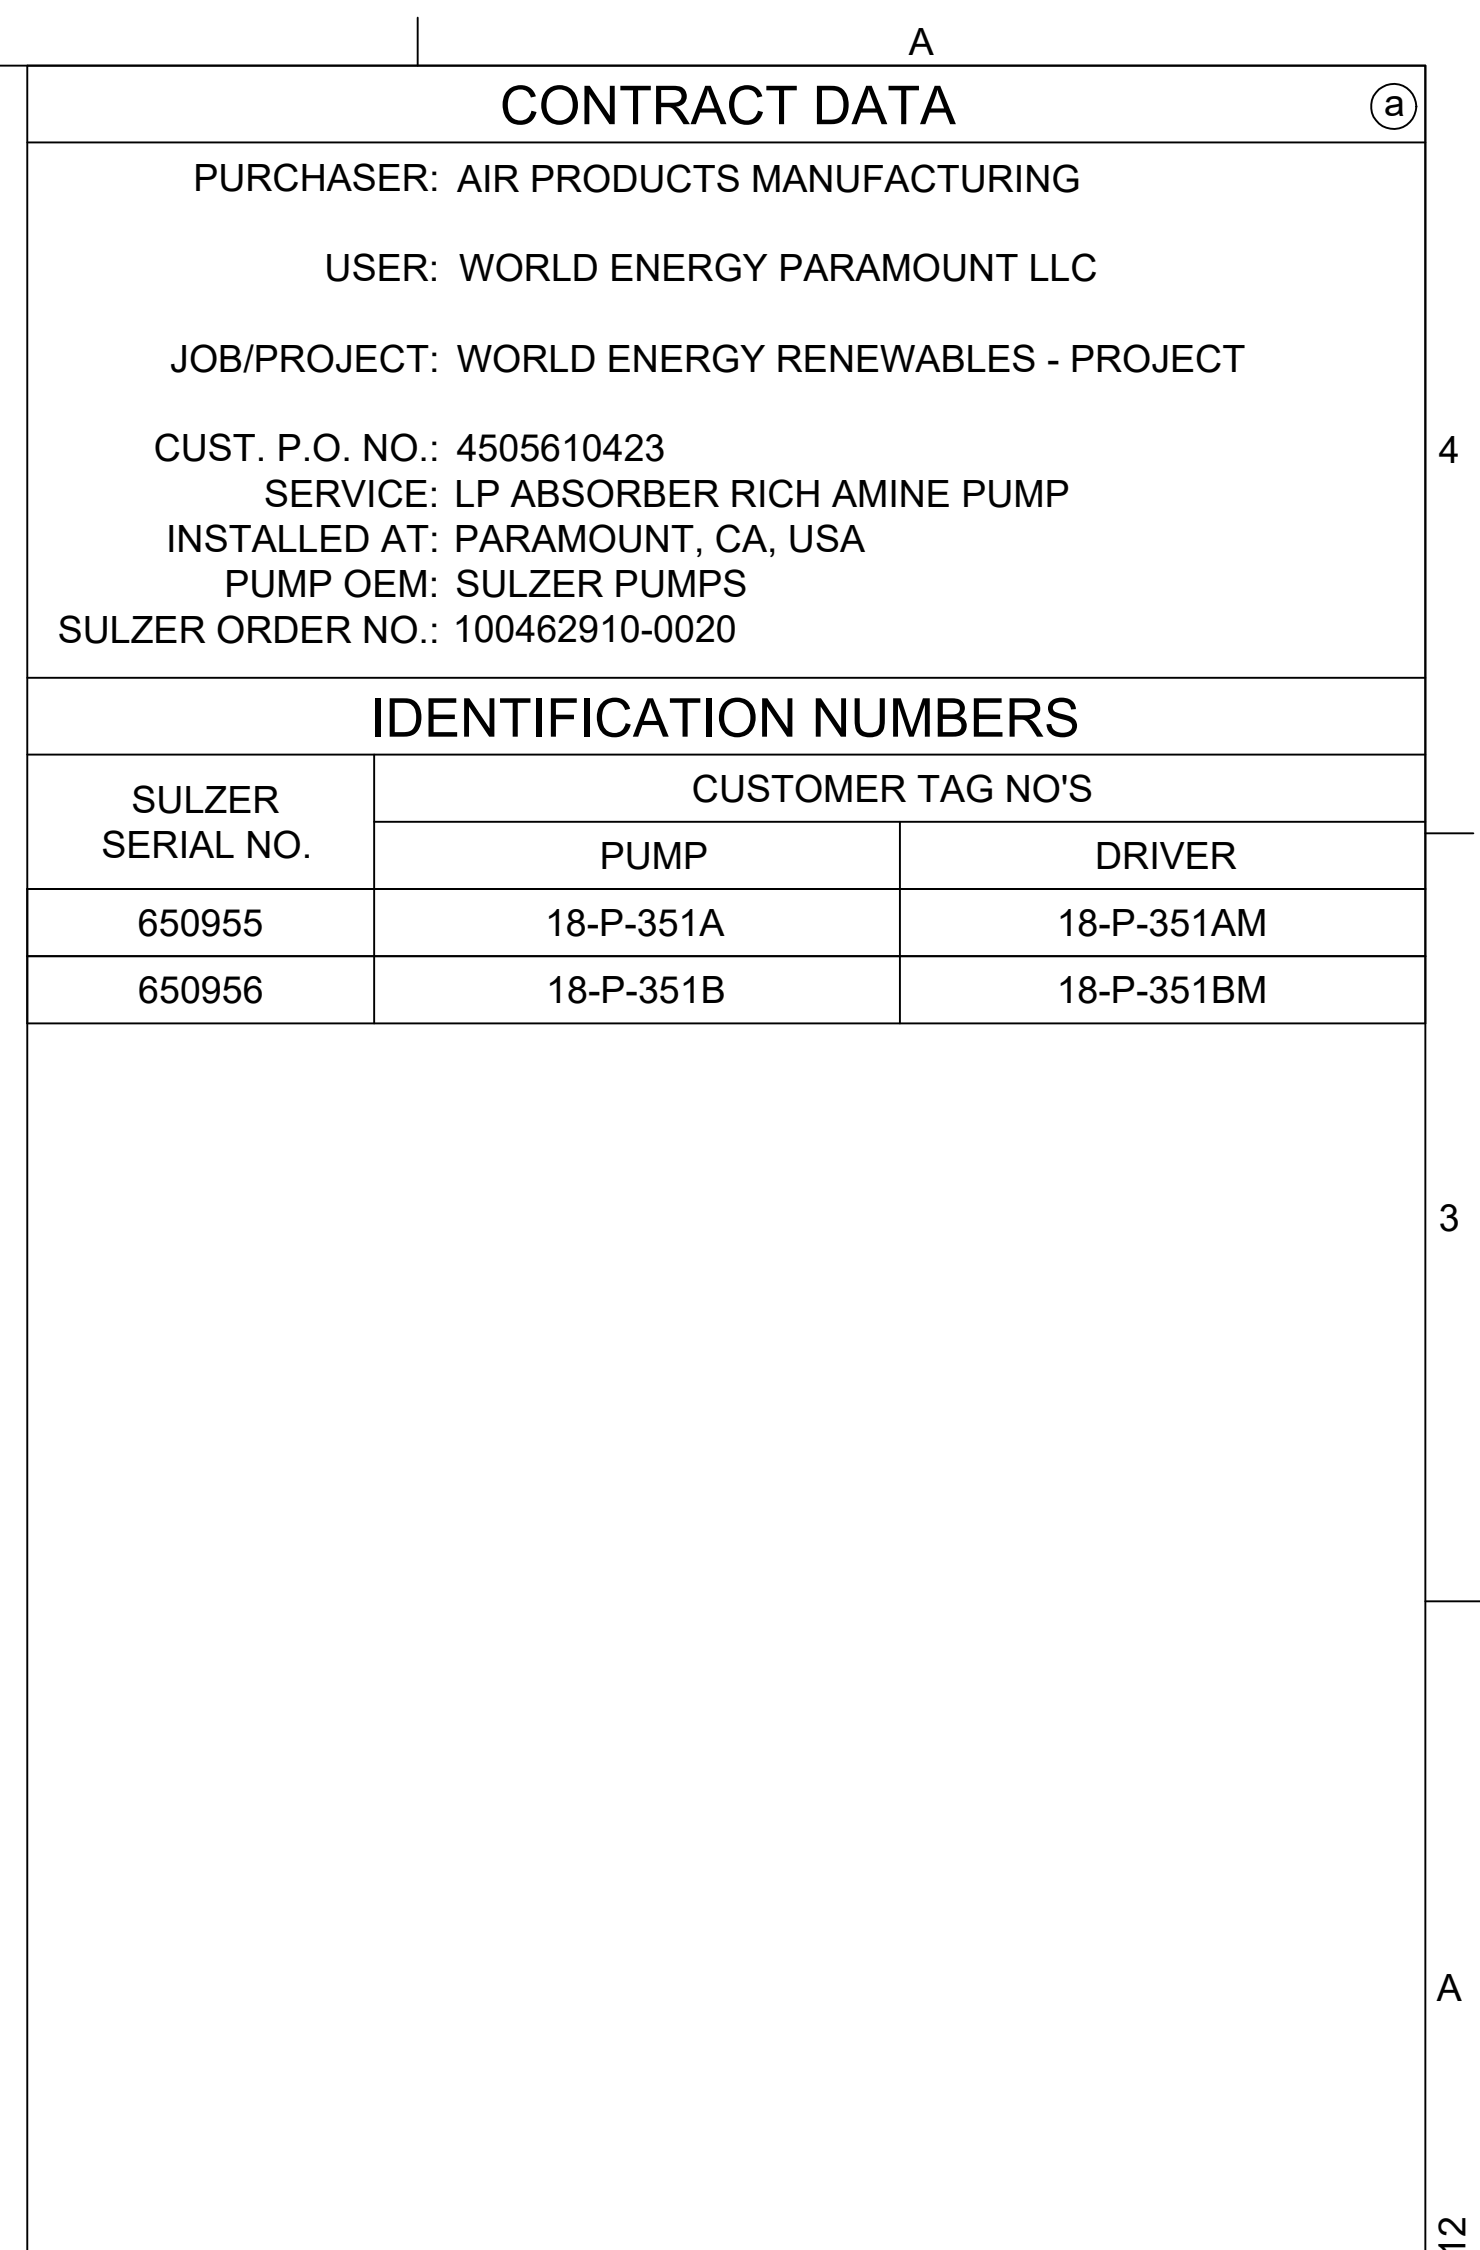

										02/20			
b	AS BUILT REVISION				03/08/2023		03/08/2023		03/08/2023				
					J. PELCASTRE		S.JIMENEZ		C.GONZALEZ				
REV.	MODIFICATION				MODIFIED		CHECKED		APPROVED				
SEP. PARTS LIST		-	FORMAT C	DESIGN GROUP			SPMX			3RD ANGLE PROJECTION			
REPLACED BY			-	SUBSTITUTE FOR				-			ORIGINAL SCALE	----	
OHH 2 X 3 X 8-1		CROSS SECTION BALL / BALL BEARING OIL RING LUB. W/ FAN CROSS SECTION DRAWING								DRAWN:		30/03/2022	
										J. PELCASTRE			
-										CHECKED:		30/03/2022	
100462910-0020		APPROVED:		30/03/2022		C.GONZALEZ							
SULZER		PART NO.	EN	PCS1004629100020-01						1 / 1			
		-											
Ksl											ACAD / ANSI C-SIZE / 22 x 17		