
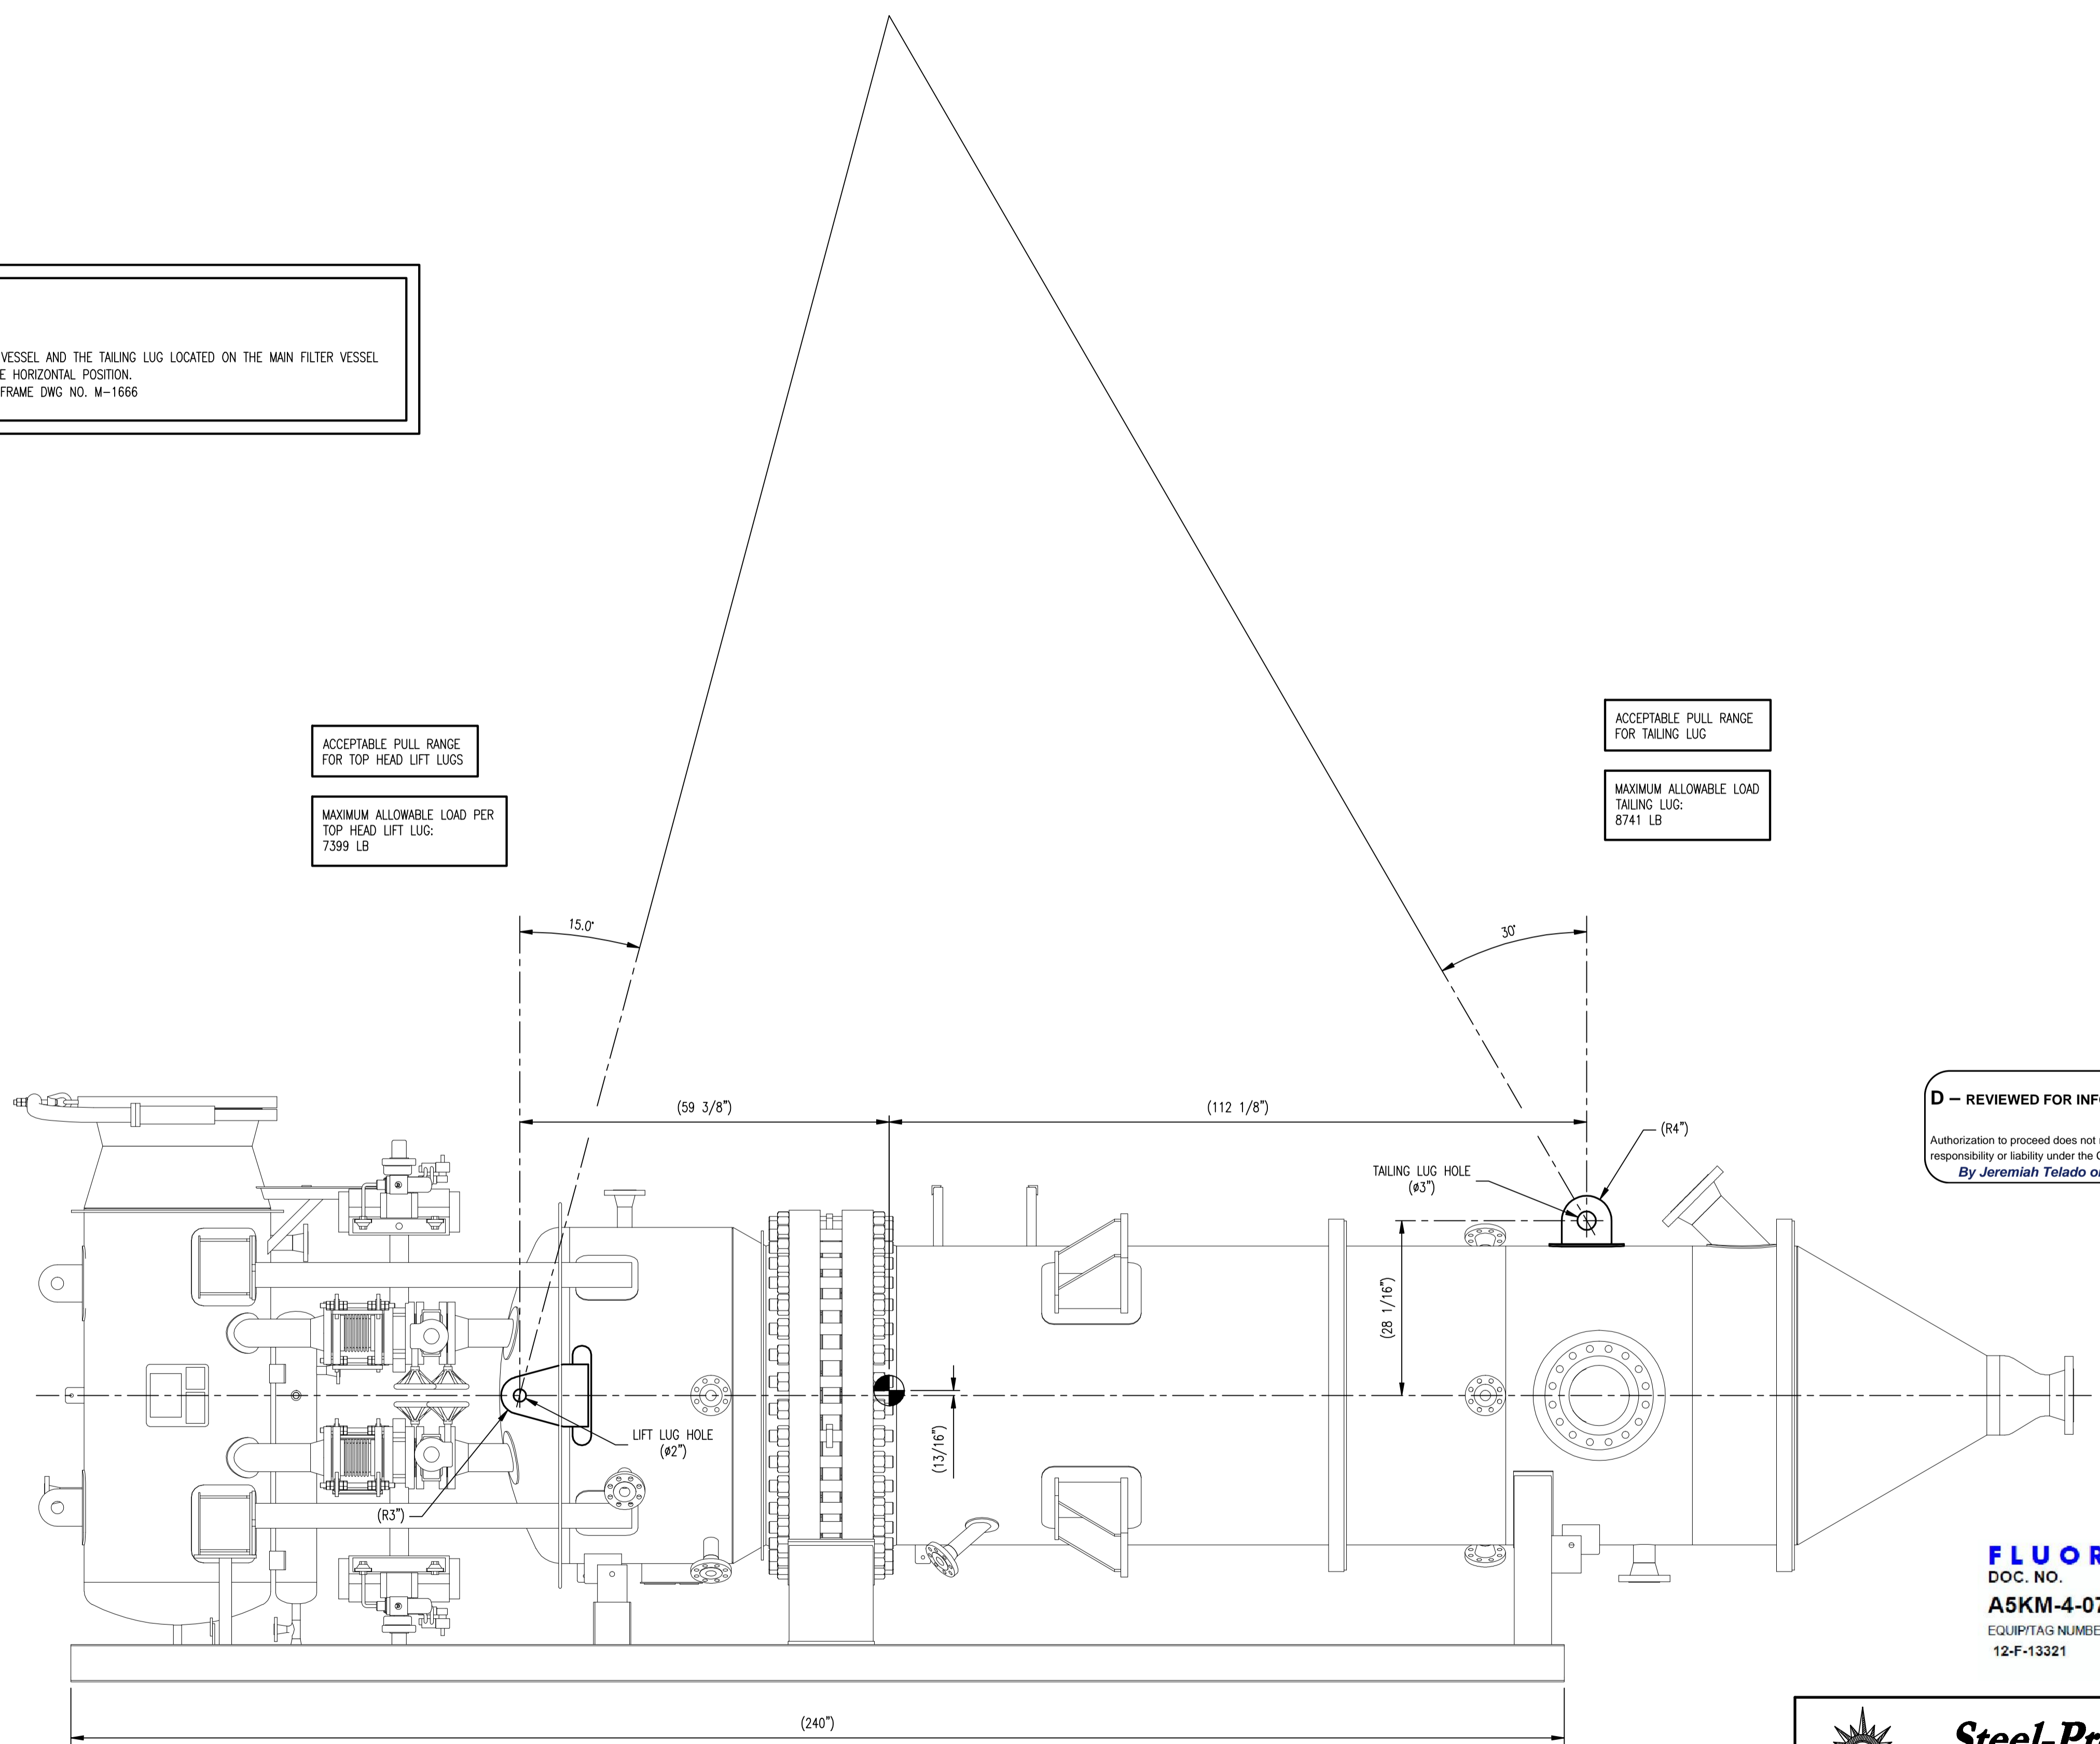


NOTES:
 1.) VESSEL ASY & SHIPPING SUPPORT CRADLE ESTIMATED WEIGHT: 21864 LB
 2.) VESSEL ASY ESTIMATED WEIGHT: 20538 LB
 3.) ONLY LIFT THE VESSEL ASY & SHIPPING SUPPORT CRADLE WITH THE (2) LUGS ON THE TOP HEAD OF THE MAIN FILTER VESSEL AND THE TAILING LUG LOCATED ON THE MAIN FILTER VESSEL
 4.) SHIPPING SUPPORT CRADLE IS ONLY INTENDED TO STAY ATTACHED TO THE VESSEL ASY WHEN THE VESSEL ASY IS IN THE HORIZONTAL POSITION.
 5.) REFERENCE DWGS: MOTT FILTER VESSEL GENERAL ASSEMBLY DWG NO. 9354100, STEEL-PRO FILTER VESSEL TRANSPORT FRAME DWG NO. M-1666

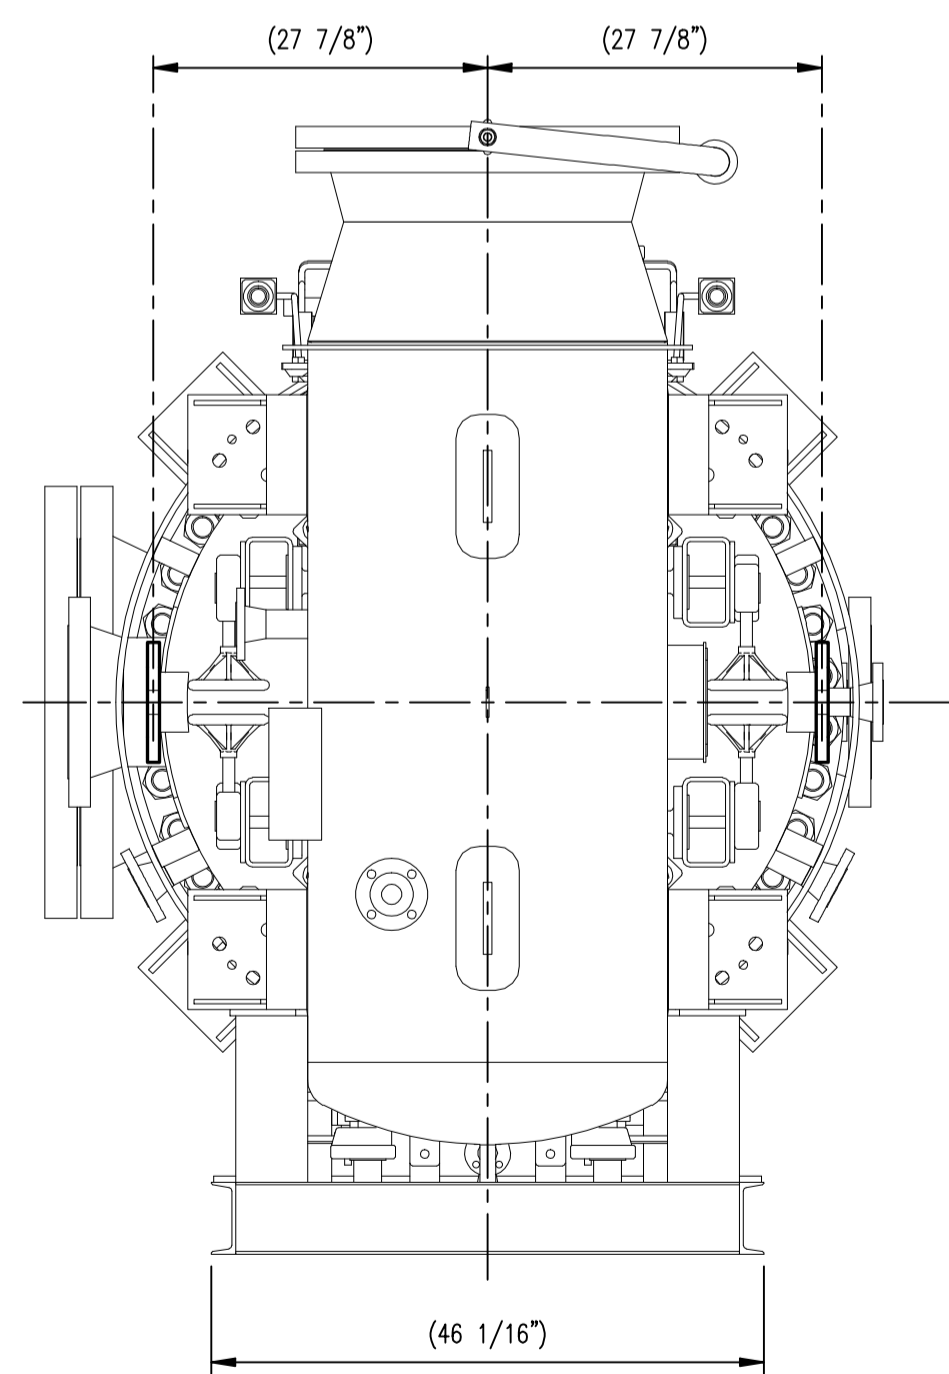

ACCEPTABLE PULL RANGE FOR TOP HEAD LIFT LUGS

MAXIMUM ALLOWABLE LOAD PER TOP HEAD LIFT LUG: 7399 LB

ACCEPTABLE PULL RANGE FOR TAILING LUG

MAXIMUM ALLOWABLE LOAD TAILING LUG: 8741 LB

FLUOR.
 D - REVIEWED FOR INFORMATION ONLY
 Authorization to proceed does not relieve Contractor/Supplier of its responsibility or liability under the Contract and or Purchase Order.
 By Jeremiah Telado on Apr 01, 2015

FLUOR 00A5KM23
 DOC. NO. REC'D: 24-MAR-2015
 A5KM-4-0701-01-00070-1
 EQUIP/TAG NUMBER
 12-F-13321 12-F-14321

Steel-Pro Incorporated
 P.O. Box 449 * Rockland, Maine 04841

TITLE: FILTER VESSEL LIFT LIMITATIONS TRUCK UNLOAD & SET DOWN LIFT		CUST. MOTT CORP.		P.O. NO. 0006905-1	
APPROVALS	DATE	S.O. NO. 20725	QTY	---	
DRAWN J BUCK	03/20/15	DWG. NO. M-1667	REV.	0	
ENGR. CHK.		SCALE AS NOTED	SHEET	1 OF 2 SHEETS	
Q.C. CHK.					
QUOTE/SALES CHK.					

CUSTOMER: FLUORREC
CONTRACT/PROJ No: A5KM
PROJ NAME: REC SILICON REACTOR 2828 PROJECT
CUSTOMER PO No: A5KM-4-0701-01-0000004
ITEM/TAG No: 12-F-13321 & 12-F-14321
EQUIP DESCRPT: EFFLUENT FILTERS


FLUOR		FLUOR TO COMPLETE	
TO BE COMPLETED BY VENDOR	PDDM RECD DATE:	FLUOR TO COMPLETE	FLUOR REV.
CONTRACT No: A5KM			
P.O. NUMBER: A5KM-4-0701-01-0000004		A - PROCEED	
FIRST ISSUE: YES <input checked="" type="checkbox"/> NO <input type="checkbox"/>		B - PROCEED, CHANGE AS NOTED & RESUBMIT	
EDR CODES: C20		C - DO NOT PROCEED, CHANGE AS NOTED & RESUBMIT	
ITEM/TAG NUMBERS: 12-F-13321 TO 12-F-14321		D - REVIEWED FOR INFORMATION ONLY	
FLUOR CONTROL NUMBER BY FLUOR		Q - QUALITY IS BELOW STANDARDS, CORRECT & RESUBMIT	
		AUTHORIZATION TO PROCEED DOES NOT RELIEVE CONTRACTOR/VENDOR OF ITS RESPONSIBILITY OR LIABILITY UNDER THE CONTRACT/PURCHASE ORDER.	

REV	DESCRIPTION	BY	ENGR	QC	DATE
0	FOR APPROVAL				03/20/15

4	Engineering Contractor:	Fluor Inc., Aliso Viejo, CA	Service Name & Tag Number:	HOT EFFLUENT GAS FILTERS 12-F-13321 / 14321	Quantity:	2 Required	DATE:	04/08/15	SHEET No.:	1 of 2	4
1	End User:	REC, Moses Lake, WA	Mott Catalogue No.:	(2) - Mott Cat. No. 93(54x48)100-124-2-2-C*(2R)*(CD)* w/ Automatic On-Line Cleaning	Fluor PO No.:	A5KM-4-0701-01					1
1	Filteration Vendor:	Mott Corp.	Application:	Continuous Removal of Silicon Dust Fines in a Hot Hydrogen Gas Stream	Fluor Project ID:	Reactor 25/26 Project					1
1	Each Filter Vessel (FV):	54" OD CI 300 TP304/304L SS X 21.8 Ft. H Filter Vessel including: (4) - 4" CI 300 SS Auto Backpulse Vvls., (4) - 4" CI 300 SS Manual Isolation Vvls., (4) - 4" CI 300 SS Exp. Joints, Wiring, J-Box									1
1	Each Accumulator Tank (AT):	30" OD CI 150 TP304/304L SS X 7.4 Ft. OAL X 3.8 Ft. H X 29 F13 Volume Horizontal Accumulator Tank including (1) - 6" CI 150 SS Instrument Air Manifold for Auto Backpulse Valve Actuators									1
1	Auxiliaries	(2) - Local Control Panels w/ NEMA TP316 SS Enclosures, A/B CompactLogix PLC, Intrinsically Safe Barriers, 10" Maple Systems Color Touch HMI, Heater, Alarms, Pilot Lights, Z-Purge, etc.									

1	STRUCTURAL DESIGN, LAYOUT & COMPONENTS: MOTT GSV DOWNFLOW GAS FILTER VESSEL DESIGN WITH AUTOMATIC ON-LINE CLEANING SYSTEM											
2	FV Flanged Top Head Bonnet (Diameter X Height):	54" OD X 48" OD X 60" H	Tubeheet:	52.25" OD X 3" Thick	Est. Unit Filter Vessel System Assembly Dry Weight:	25,800 Lb.						
3	FV Flanged Lower Shell (Diameter X Height):	48" OD X 198" H	J-Box NEC Class:	Class 1 Div 2 Groups B/C/D, NEMA 4X Enclosures	Est. Unit Filter Vessel System Shipping Weight:	27,000 Lb						
4	AT (Dia X Length X Height):	30" OD x 89" OAL x 46" OAH	Control Panel NEC Class:	Unclassified NEMA 4 Enclosures	Est. Unit Filter System Shipping Dimensions:	28 FT L x 5.5 FT W x 8.5 FT H						

Operating / Design	Pressure	Temperature	Corrosion Allowance & MDMT
5 FILTER VESSEL (ASME Section VIII Div 1 Code)			
Operating	4.8 psig	750 °F / 950 °F	0.0625 in. Vessel
Internal Design MAWP	60 psig	980 °F / 0 °F	0.125 in. Vessel Nozzles
External Design	FV	980 °F	-20 °F MDMT
10 ACCUMULATOR TANK (ASME Section VIII Div 1 Code)			
Operating	80 - 100 psig	32 To 120 °F	0.0625 in. Vessel
Internal Design MAWP	150 psig	500 °F / 0 °F	0.125 in. Vessel Nozzles
External Design	FV	500 °F	-20 °F MDMT
14 TUBESHEET (ASME Section VIII Div 1 Code)			
Operating Differential	0.35 To 0.66 psi	750 °F / 950 °F	0.0625 in.
Diff Pressure Design	30 psi	980 °F / 0 °F	-20 °F MDMT
17 INSTRUMENT AIR PIPE MANIFOLD (ASME B31.3 Code)			
Operating	80 - 110 psig	32 To 120 °F	0.0625 in.
Design MAWP & External	165 psig & FV	250 °F / 0 °F	-20 °F MDMT
20 TUBESHEET (ASME Section VIII Div 1 Code)			
52.25" OD x 3" Thk x (124) - 21/2" NPT Holes @ 3.125" Pitch, 45° Square Pattern & RF Both Sides			
22 FILTER VESSEL, TUBESHEET, ACCUMULATOR & INST. AIR MANIFOLD MATERIAL:			
Plate & Pipe (ANSI B 36.10):	SA-240 TP304/304L SS Plate, SA-312 TP304/304L SS Smls/Wld Pipe		
Butt Wld Pipe Fittings (B16.9):	SA-403 TP304/304L SS Smls & Wld		
Flanges & Forged Cplgs (B16.11):	SA-182 TP304/304L SS (Flanges per B16.5 & B16.47 Series B)		
Fasteners:	SA-193 B8 SS Stud Bolts & SA-194 Gr 8 SS Hvy Hex Nuts		

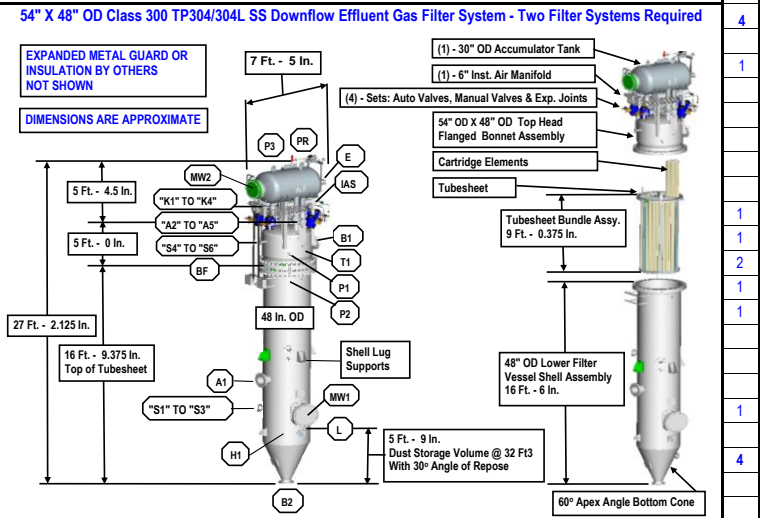

HYDROGEN GAS TEMP. INSIDE ACCUMULATOR TANK MUST ALWAYS BE MAINTAINED AT A TEMPERATURE THAT IS GREATER THAN THE DEW POINT TEMPERATURE OF THE EFFLUENT GAS THAT IS BEING FILTERED.
 Filter Vendor to provide/attach Stn Stl ID Nameplates with Nozzle Tag ID Numbers to Each Nozzle Using Stn Stl Wire

29	(4) - 4" Class 300 Flanged Fast Acting Auto Butterfly Valve Assembly w/ CF8M Stn Stl Bodies, Inlet Filter and Regulator, Single Acting Fail Closed (Spring-To-Close) Actuator, Limit Switch, Position Indicator,	
31	Air Relay, Stn Stl Intrinsically Safe Solenoid Valve w/ Manual Override, Check Valve & Quick Exhausts.	
32	(4) - 4" Class 300 Flanged Manual Isolation Butterfly Valves with w/ CF8M Stn Stl Bodies & Gear Operators	
EXPANSION JOINTS FOR EACH FILTER VESSEL:		
34	(4) - 4" Class 300 Flanged TP321 SS Tied Expansion Joints with TP304/304L SS Flanges & Internal Liners	
MOTT CARTRIDGE ELEMENT DATA:		
36	Quantity & Mott Element Cat. No.:	(124) - Cat # 2240-D40-100-C*-2-C*(2R)* Elements per Filter Vessel
37	Element Material & Grade:	TP 304L Stn Stl Porous Media Grade 2 with TP304/304L SS Hardware
38	Element Size & Open End Seal:	2.5" OD x 100" Porous Length x 2-1/2" NPT Nitronic 60 SS Adapter
39	Element Design Pressure:	59 psi Collapse Pressure & 214 psi Burst Pressure @ 980 °F
APPURTENANCES & SPECIAL FLUOR REQUIREMENTS FOR EACH FILTER VESSEL		
41	Insulation Clips & Rings:	Yes, Filter Vessel & Accumulator Tank (Exp. Metal Guard By Others)
42	Filter Vessel Grounding Lugs:	(1) - Filter Top Head Bonnet, (1) - Filter Shell & (1) - Accumulator Tank
43	Filter Vessel (FV) Supports:	(4) - Lower Shell Lug Supports
44	Accumulator Tank (AT) Supports:	(4) Sets - TP304 SS Vertical Angles & Base Plates Installed
45	Filter Vessel (FV) Lifting Lugs:	(2) - FV Top Head Bonnet Assembly w/ (1) - Lower Shell Tailing Lug
46	Accumulator Tank Lifting Lugs:	(2) - Accumulator (Lifting of Accumulator & FV Top Head Assembly)
47	Tubesheet Lifting Lugs:	(2) - Top Side of Tubesheet (Bundle Frame Assembly Lift)
48	Filter Vessel Bottom Cone:	Polished Internal Surface of Bottom Cone at 32 Ra Surface Finish
49	Manway Davit Arm Assemblies:	Filter 24" MW-1 (without Davit) & Accumulator 24" MW-2 (with Davit)
50	Gaskets & Fasteners:	1 Installed Set Gaskets & Fasteners + 1 Set Commissioning Gaskets
51	Nitrogen Gas Pressure Blanket:	Filter Vessel Assemblies Shipped Pressurized with 0.25 psig GN2
52	Shipping Support Frame:	Filter Vessel Assemblies Shipped on Horizontal CS Structural Frames

NOZZLE SCHEDULE: 54" OD X 48" OD CLASS 300 TP304/304L SS EFFLUENT GAS FILTER VESSEL						
Nozzle Identification	Mark	Size (In.)	Qty.	Class	Type & Facing	
Effluent Gas Inlet - Lower Shell	A1	10"	1	300	RFWN ASME B16.5	
Clean Gas Outlet - Top Head Bonnet	B1	10"	1	300	RFWN ASME B16.5	
Dust Solids Outlet - Bottom Cone	B2	6"	1	300	RFWN ASME B16.5	
Backpulse Gas Inlets	A2 - A5	4"	4	300	RFWN ASME B16.5	
Filter Vessel Body Flanges	BF	48"	2	300	RFWN B16.47 Series B	
Hi, Lo Pressure Diff. Measurement Across Tubesheet	P1, P2	2"	2	300	RFWN ASME B16.5	
Temp. Measurement - Top Head	T1	2"	1	300	RFWN ASME B16.5	
Level Measurement - Bottom Shell	L	3"	1	300	RFWN ASME B16.5	
Clean Out Handhole Connection - Bottom Shell	H1	6"	1	300	RFWN ASME B16.5	
Fabrication Inspection without Davit Arm Assembly	MW1	24"	1	300	RFWN ASME B16.5	
Shipping Support Nozzles Top Head	S4 - S6	2"	3	300	RFWN ASME B16.5	
Shipping Support Nozzles Lower Shell	S1 - S3	2"	3	300	RFWN ASME B16.5	

53	DESIGN CODES & FLUOR SPECIFICATION REQUIREMENTS	
54	Design Code:	Filter Vessels & Accumulators: ASME Sect VIII Div 1 & Piping: B31.3
55	ASME Code Stamp (FV & AT):	ASME U Stamp & National Board Registration Required
56	Inspection & NDE Requirements:	Inspection Test Plan, Quality Plan, Test Reports & FAT
57	Impact / Hardness / Ferrite Tests:	ASME Sect VIII, Div 1 Code, Fluor Specs. & Ferrite Testing 10% Welds
58	PWHT, Stress Relieve:	ASME Section VIII, Div. 1 Code, Fluor Specs.
59	VT, PT, RT, UT & Pressure Test:	ASME Section VIII, Div. 1 Code, Fluor Specs. & UT of Tubesheets
60	Clean, Degrease & Passivate:	Clean all wetted surfaces per REC Spec. # STN-GEN-00002F
61	Clean, Degrease & Passivate Use:	"Simple Green" as Degreaser and Citric Acid for Passivation
62	Clean, Degrease & Passivate Chemicals are:	Not to contain alkali metals (i.e. NaOH) or phosphates (i.e. Phosphoric Acid)

NOZZLE SCHEDULE: 30" OD CLASS 150 TP304/304L SS ACCUMULATOR TANK						
Nozzle Identification	Mark	Size (In.)	Qty.	Class	Type & Facing	
Accumulator Gas (GH2) Inlet	E	1"	1	150	RFWN ASME B16.5	
Backpulse Gas (GH2) Outlets	K1 - K4	4"	4	300	RFWN ASME B16.5	
Pressure Measurement	P3	2"	1	150	RFWN ASME B16.5	
Pressure Relief & Vent	PR	2"	1	150	RFWN ASME B16.5	
Bottom Drain	D1	2"	1	150	RFWN ASME B16.5	
Manway Inspection with Davit Arm Assembly	MW2	24"	1	150	RFWN ASME B16.5	


63	FLUOR/REC SPECS.: DESIGN, MATERIAL, FAB, WELDING, QA, CLEANING & TESTING	
64	Fluor/REC Attachment "A":	Items To Be Purchased Bill of Material (BOM), Rev. 3 dated 02/26/15 (4 pgs.)
65	Fluor/REC Filter Data Sheet # 59-12-F-13321	Effluent Filters, Rev. 3 dated 12/22/14 (3 shfts.)
66	Fluor/REC Attachment "C":	"Engineering Documents And Notes" Rev. 4 dated 02/26/15 (14 pgs) - DOCS
67	Fluor PDDM Form A5KM.206.F0520	dated 10/22/14 (9 pgs) - DOCS
68	Fluor SDDC Form 000.255.SD.4000 Rev.1	dated 09/17/14 (2 pgs): Supplier Dwg Data Commitment - DOCS
69	Fluor Form 000.450.F2001 Rev.1	dated 09/18/14 (4 pgs): Quality & Cert. Requirements - INSPECTION
70	REC Spec. No. STN-VES-00023 Rev. 1	dated 3/8/12 (39 pgs) - VESSEL FABRICATION

NOZZLE SCHEDULE: 6.625" OD CLASS 150 TP304/304L SS INSTRUMENT AIR PIPE MANIFOLD						
Nozzle Identification	Mark	Size (In.)	Qty.	Class	Type & Facing	
Inst. Air Supply Inlet	IAS	1"	1	150	RFWN ASME B16.5	
Inst. Air Drain	IAD	1"	1	150	RFWN ASME B16.5	
Inst. Air Vent	IAV	3/4"	1	150	RFWN ASME B16.5	
Inst. Air to Valve Actuators	IA1 - IA4	3/4"	4	Lt Wt	Socket Weld Unions	

0	SHEET NO.:	1 OF 2	DATE:	09/25/14 EFM	ISSUE/REV.:	0	DESCRIPTION:	Based upon Fluor PO No. A5KM-4-0701-01 and attached specifications except Material-Of-Construction is TP304 SS NOT TP304H SS	0
1	MOTT CORPORATION		DATE:	10/20/14 EFM	ISSUE/REV.:	1	Revisions requested by REC/Fluor and recorded in Fluor Conference Note CN-R2526-00010 documenting the 10/09/14 REC/Fluor/Mott Project Kick-Off Review Meeting.	1	
2	BUSINESS CONFIDENTIAL		DATE:	11/14/14 EFM	ISSUE/REV.:	2	Re-named Nozzle "T2" as "T1" on Sht. # 1, Added Dew Point Temperatures of Hydrogen Gas & Nitrogen Gas on Sht. # 2	2	
3			DATE:	12/12/14 EFM	ISSUE/REV.:	3	Changed Gaskets to TP304/304L SS Spiral Wound Mica Fill, TP304/304L SS Inner & Outer Rings on Line # 27, Sht # 1	3	
4			DATE:	04/08/15 EFM	ISSUE/REV.:	4	Revised Dimensions, Added TP304/304L SS, Added Plogopite Mica Fill for Gaskets, Updated Fluor & REC Specs per REC PO # A5KM-4-0701-01/A5KM10000 CO # 1 & CO # 2	4	

REV	MFVSC # 12-F-13321 / 14321: MOTT FILTER VESSEL SPECIFICATION FOR CUSTOMER - BUSINESS CONFIDENTIAL				Mott Sales Order No.: SO2010865	REV		
4	Engineering Contractor:	Fluor Inc., Aliso Viejo, CA	Service Name & Tag Number:	HOT EFFLUENT GAS FILTERS 12-F-13321 / 14321	Quantity: 2 Required	DATE: 04/08/15 SHEET No.: 2 of 2	4	
1	End User:	REC, Moses Lake, WA	Mott Catalogue No.:	(2) - Mott Cat. No. 93(54x48)100-124-2.5-2-C*(2R)*(C/D)* w/ Automatic On-Line Cleaning	Fluor PO No.:	A5KM-4-0701-01	1	
	Filteration Vendor:	Mott Corp.	Application:	Continuous Removal of Silicon Dust Fines in a Hot Hydrogen Gas Stream	Fluor Project ID:	Reactor 25/26 Project		
1	Each Filter Vessel (FV):	54" x 48" OD CI 300 TP304/304L SS X 21.8 Ft. H Filter Vessel including: (4) - 4" CI 300 SS Auto Backpulse Vlv., (4) - 4" CI 300 SS Manual Isolation Vlv., (4) - 4" CI 300 SS Exp. Joints, Wiring, J-Box					1	
1	Each Accumulator Tank (AT):	30" OD CI 150 TP304/304L SS X 7.4 Ft. OAL X 3.8 Ft. H X 29 F3 Volume Horizontal Accumulator Tank including (1) - 6" CI 150 SS Instrument Air Manifold for Auto Backpulse Valve Actuators					1	
1	Auxiliaries	(2) - Local Control Panels w/ NEMA TP316 SS Enclosures, A/B CompactLogix PLC, Intrinsically Safe Barriers, 10" Maple Systems Color Touch HMI, Heater, Alarms, Pilot Lights, Z-Purge, etc.					1	
71	PROCESS FILTRATION DUTY:	Continuous Removal of Silicon Dust Fines in a Hot Hydrogen Gas Effluent Stream						
72	Total Filtration Surface Area:	676 Ft ²						
73	Effluent Feed Gas Inlet Volumetric Flow Rate:	Case # 1B @ 1,798 ACFM	Case # 4A @ 1,652 ACFM	Case # 4B @ 1,811 ACFM	Case # 2H @ 1,968 ACFM			
74	Effluent Feed Gas Molecular Wt. - Type & Composition:	2 Lb / LbMole Effluent Hydrogen Gas For Operating Cases # 1B, 4A, 4B & 2H						
75	Effluent Feed Gas Operating Temperature:	Case # 1B @ 750°F	Case # 4A @ 950°F	Case # 4B @ 750°F	Case # 2H @ 750°F			
76	Effluent Feed Gas Inlet Operating Pressure:	4.8 psig For Cases # 1B, 4A, 4B, 2H & 2N						
77	Effluent Feed Gas Operating Viscosity:	Case # 1B: 0.016 cP at 750°F	Case # 4A: 0.017 cP at 950°F	Case # 4B: 0.016 cP at 750°F	Case # 2H: 0.016 cP at 750°F			
2	Effluent Feed Gas Dew Point Temperature:	GH2 Dew Point Temp @ -422 °F	GN2 Dew Point Temp @ -316 °F			2		
1	79 Cases # 1B/4A/4B/2H Backpulse Gas Type & Pressure:	Clean Dry Hydrogen Gas at 80 - 100 psig For Operating Cases # 1B, 4A, 4B, 2H & 2N					1	
80	Minimum Required Temp. of Backpulse Gas:	GH2 or GN2 Temperature Inside Accumulator Must Be Maintained at a Temperature Greater than the Dew Point Temperature of the Effluent Gas Being Filtered - See Mott Note # 1						
81	Nitrogen Feed Gas Inlet Volumetric Flow Rate:	Case # 2N @ 869 ACFM						
82	Nitrogen Feed Gas Molecular Weight:	Case # 2N @ 28 Lb / LbMole For Nitrogen Feed Gas						
83	Nitrogen Feed Gas Operating Temperature:	Case # 2N @ 750 °F						
84	Nitrogen Feed Gas Operating Pressure:	Case # 2N @ 4.8 psig						
85	Nitrogen Feed Gas Viscosity:	Case # 2N @ 0.032 cP at 750 °F						
1	86 Case # 2N Backpulse Gas Type & Supply Pressure:	Case # 2N: Backpulse Gas is Clean Dry Nitrogen Gas at 80 - 100 psig Operating Pressure					1	
87	Total Dust Solids Loading Rate:	Case # 1B = 42 Lb/Hr;	Case # 4A = 60.3 Lb/Hr;	Case # 4B = 78.7 Lb/Hr	Case # 2H = 0 Lb/Hr	Case # 2N = 0 Lb/Hr		
88	Dust Solids Type, Particle Density & Size Distribution:	Silicon Dust at a Particle Density of 30 Lb/Ft ³ with a Particle Size Distribution by Weight as follows: 1.55% < 0.1 um, 14.47% < 0.4 um, 36.71% < 1 um, 80.9% < 3 um, 100% < 30 um						
89	Estimated Operating Bulk Dry Density of Dust Cake:	8 To 24 Lb/Ft ³ Reported in Fluor Element Filter Data Sheet (Avg @ 16 Lb/Ft ³) BUT 25 Lb/Ft ³ Measured By Mott Using REC Dust Sample (Refer to Mott Lab Report FN # 1397)						
4	90 Expected Filtration Efficiency & Dust Holding Capacity:	Less Than 0.005 Grains / SFt ³ of particulate solids (silicon dust) in filtered effluent gas stream. The estimated dust solids holdup capacity in the bottom of each filter vessel is 32 Ft ³ .					4	
91	Maximum Allowable Operating Pressure Drop:	0.35 psi						
92	PROCESS FILTRATION DATA TABLE FOR EACH FILTER VESSEL SYSTEM							
93	SFt ³ measured at 60 °F & 14.696 psia							
1	94	Filter Run Time & Backpulse Gas Consumption Based Upon Bulk Dry Density of Silicon Dust at 16 Lb/Ft ³	GH2 Peak Production	GH2 Hi Temperature Poor Yield	GH2 Peak Production Poor Yield	GH2 Standby	Nitrogen Gas Standby	1
95	Total Filtration Surface Area [Ft ²]	676	676	676	676	676		
96	Process Feed Gas Inlet Temperature [°F]	750	950	750	750	750		
97	Process Feed Gas Inlet Pressure [psig]	4.8	4.8	4.8	4.8	4.8		
98	Process Feed Gas Mass Flow Rate [Lb / Min]	5.401	4.259	5.440	5.912	36.548		
99	Process Feed Gas Volumetric Flow Rate [AFt ³ / Min]	1798	1652	1811	1968	869		
1	100 Backpulse Gas Pressure Inside Accumulator Tank (Min. REC Plant Supply Pressure) [psig]	80	80	80	80	80	1	
101	Nominal Filtration Face Velocity [AFt / Min]	2.66	2.44	2.68	2.91	1.29		
1	102 Dust Solids Bulk Dry Density [Lb / Ft ³]	16	16	16	16	16	1	
103	Dust Solids Loading Rate [Lb / Hr]	42.0	60.3	78.7	0.0	0.0		
104	Dust Solids Concentration in Flowing Inlet Process Gas Stream [Grains / AFt ³]	2.725	4.258	5.070	0.0	0.0		
1	105 Est. Conditioned Clean Pressure Drop after completion of On-Line Cleaning Cycle [psi]	0.101	0.095	0.102	0.112	0.133	1	
106	Est. Maximum Terminal Dirty Pressure Drop at Start of On-Line Cleaning Cycle [psi]	0.350	0.350	0.350	0.350	0.350		
1	107 Est. Terminal Dust Cake Thickness at Start of On-Line Cleaning Cycle [Inches]	0.146	0.154	0.145	0.000	0.000	1	
1	108 Est. Filter Vessel Run Time (filter run time between on-line cleaning cycles) [Minutes]	199	146	105	∞	∞	1	
109	Est. On-Line Cleaning Cycle Time Duration [Seconds]	30	30	30	30	30		
1	110 Est. Number of Total Filter Vessel Cleaning Cycles per Day During Operation [CC / Day]	7.23	9.85	13.69	N/A	N/A	1	
1	111 Est. Backpulse Gas Consumption per Cleaning Cycle [Lb / CC]	0.67	0.65	0.67	0.67	6.84	1	
1	112 Avg Hourly Backpulse Gas Consumption During Operation (GH2 from Accumulator) [SFt ³ / Hr]	38.0	50.5	72.1	N/A	N/A	1	
1	113 Avg. Daily Backpulse Gas Consumption During Operation (GH2 from Accumulator) [Lb / Day]	4.8	6.4	9.2	N/A	N/A	1	
114	MOTT ON-LINE CLEANING SYSTEM CONTROL & SET POINTS:							
1	115	Filter Vessel Auto On-Line Cleaning System is initiated by High Diff. Pressure Set Point and by Timer Set Point. Timer can be set to initiate a cleaning cycle at 3.5 hour intervals depending upon process flow rates.					1	
116	The Timer Set Point limits extreme dust cake build-up during periods of very low process gas flow rates. Normally a Timer Set Point is the primary control with High Diff. Pressure Set Point as the Over-Ride Control.							
117	MOTT ON-LINE BACKPULSE CLEANING CYCLE OPERATION:							
118	The Fast Acting Auto Backpulse Valves and the Accumulator Tank are sized to provide a high pressure sonic pulse inside each cartridge element during the on-line cleaning cycle which discharges							
119	dust cake from the outside surface of each element. Mott also provides a Gas Jet Nozzle/Venturi Assembly located in the open end of each Mott cartridge element which reduces backpulse gas consumption and							
120	which also enhances the pulsed jet cleaning process. This Mott design provides for very robust and efficient cleaning cycles. Each complete on-line cleaning cycle consists of four backpulse valves sequentially							
121	actuated one-at-a-time with an adjustable lag time set point between each valve actuation. As shown in the Process Data Table above, one complete on-line cleaning cycle lasts for 30 Seconds with valve lag time							
122	set at 9 Seconds for each auto backpulse valve. Total Actuation Time (From Full Closed - To - Full Open - Back To - Full Closed) for each Auto Backpulse Valve is less than 1 Second.							
123	MOTT CARTRIDGE ELEMENT EXTERNAL CLEANING REQUIREMENTS:							
124	Periodically, the filter vessel cartridge elements must be removed for external cleaning. Depending upon process conditions, the frequency of required cartridge element change-outs for external cleaning is							
125	expected to be once every 2 to 4 years or longer. Mott will provide Customer with a recommended list of international vendors that specialize in the cleaning of Mott porous metal cartridge elements.							
126	MOTT UTILITY REQUIREMENTS:							
1	127	Mott requires clean dry hydrogen gas at 80 - 100 psig (80 psig minimum) for Re-Fill of Accumulator Tanks during On-Line Filter Vessel Cleaning Cycles.					1	
128	Mott requires clean dry plant instrument air at 100 psig (80 psig minimum) for powering automatic backpulse valve actuators.							
129	MOTT NOTES TO CUSTOMER:							
130	Mott Note No. 1: The temperature of the backpulse gas inside the Accumulator Tank must always be maintained at a temperature that is greater than the Dew Point Temperature of the Process Feed Gas that is being							
131	filtered. Whenever Backpulse Gas Temperature (inside Accumulator Tank) is less than the Dew Point Temperature of the Process Feed Gas that is being filtered; then, moisture can condense inside the Porous Media							
132	of each Cartridge Element during on-line cleaning cycles. If condensate forms inside the porous media during on-line cleaning cycles; then, the result will be a gradual build-up of permanent cake on the							
133	outside surface of each cartridge element which will reduce filtration run times, increase backpulse gas consumption rates and increase the frequency of cartridge element change-outs. Since on-line cleaning							
1	134	cycles will occur every 3.3 hours or less, the GH2 inside the Accumulator Tank may have to be heated to maintain temperature that is above the Dew Point Temperature of the Process Feed Gas that is being filtered.					1	
135	If this is the case; then, Mott can provide an Electric Immersion Heater and/or other related equipment for each Accumulator Tank for heating the hydrogen or nitrogen backpulse gas inside each Accumulator Tank.							
1	136	Mott Note No. 2: Mott Proposal includes internal 32 Ra polished surfaces for the bottom cone of each filter vessel plus passivation & cleaning for all filter vessel internal wetted surfaces in contact with the Effluent Gas Stream.					1	
137	Mott Note No. 3: Mott Proposal includes all Mott cartridge elements equipped with 2-1/2" NPT open end adapters. Mott cartridge elements are easily removed or installed into the top side of each tubesheet by simple thread engagement.							
138	Mott Note No.4: Mott Proposal is for two complete "Fully Assembled", "Pre-Packaged" and "Shop Tested" Filter Systems shipped with pressurized GN2 Blanket including: Filter Vessels, Accumulator Tanks, Instrument Air Pipe Manifolds,							
139	Auto BP Vlv's & Manual BP Isolation Vlv's, Exp. Joints, Wiring, Conduit, Junction Boxes and two Local Control Panels. Mott Proposal includes Optional Spare Parts such as Spare Bundle Frame w/ Elements & Spare Auto BP Vlv's.							
0	SHEET NO.: 2 OF 2	DATE: 09/25/14 EFM	ISSUE/REV.: 0	DESCRIPTION: Based upon Fluor PO No. A5KM-4-0701-01 and attached Fluor/REC specifications except Material-Of-Construction will be TP304 SS NOT TP304H SS			0	
1	MOTT CORPORATION	DATE: 10/20/14 EFM	ISSUE/REV.: 1	Revisions requested by REC/Fluor and recorded in Fluor Conference Note CN-R2526-00010 documenting the 10/09/14 REC/Fluor/Mott Project Kick-Off Review Meeting.			1	
2	BUSINESS CONFIDENTIAL	DATE: 11/14/14 EFM	ISSUE/REV.: 2	Re-named Nozzle "T2" as "T1" on Sht. # 1, Added Dew Point Temperatures of Hydrogen Gas & Nitrogen Gas on Sht. # 2			2	
3		DATE: 12/12/14 EFM	ISSUE/REV.: 3	Changed Gaskets to TP304/304L SS Spiral Wound Mica Fill, TP304/304L SS Inner & Outer Rings on Line # 27, Sht # 1			3	
4		DATE: 04/08/15 EFM	ISSUE/REV.: 4	Increased Dust Storage Volume in bottom of each Effluent Gas Filter Vessel from 10 Ft ³ to 32 Ft ³			4	

REV	ECN	ZONE	DESCRIPTION	DATE	DRAWN	CHKD
0	2478		REL FOR FABRICATION	09/22/14	BTD	EFM
1	2488		CUSTOMER REQUEST CHANGES	10/17/14	BTD	EFM
2	2500		CHANGED NOZZLE "P2" TO "P1", ADDED "2" CLASS 150" TO "NOZZLE "P3" PRESSURE TRANSMITTER ACCUMULATOR TANK"	11/13/14	BTD	EFM
3	2515		SEE SHEET 1	12/11/14	BTD	EFM
4	2578		CHANGED TO FINAL AS BUILT	04/02/15	BTD	EFM
5	2587		SEE SHEET 1	04/28/15	BTD	EFM
6	2604		SEE SHEET 1	05/08/15	BTD	EFM
7	2615		CHANGED: CHANGED NOZZLE "T1": "TEMPERATURE TRANSMITTER" TO "SPARE CONNECTION"; NOZZLE "B1": "PROCESS GAS OUTLET, 10" CLASS 300 TO "2" CLASS 300	06/03/15	BTD	EFM
8	2633		SEE SHEET 1	06/22/15	BTD	EFM

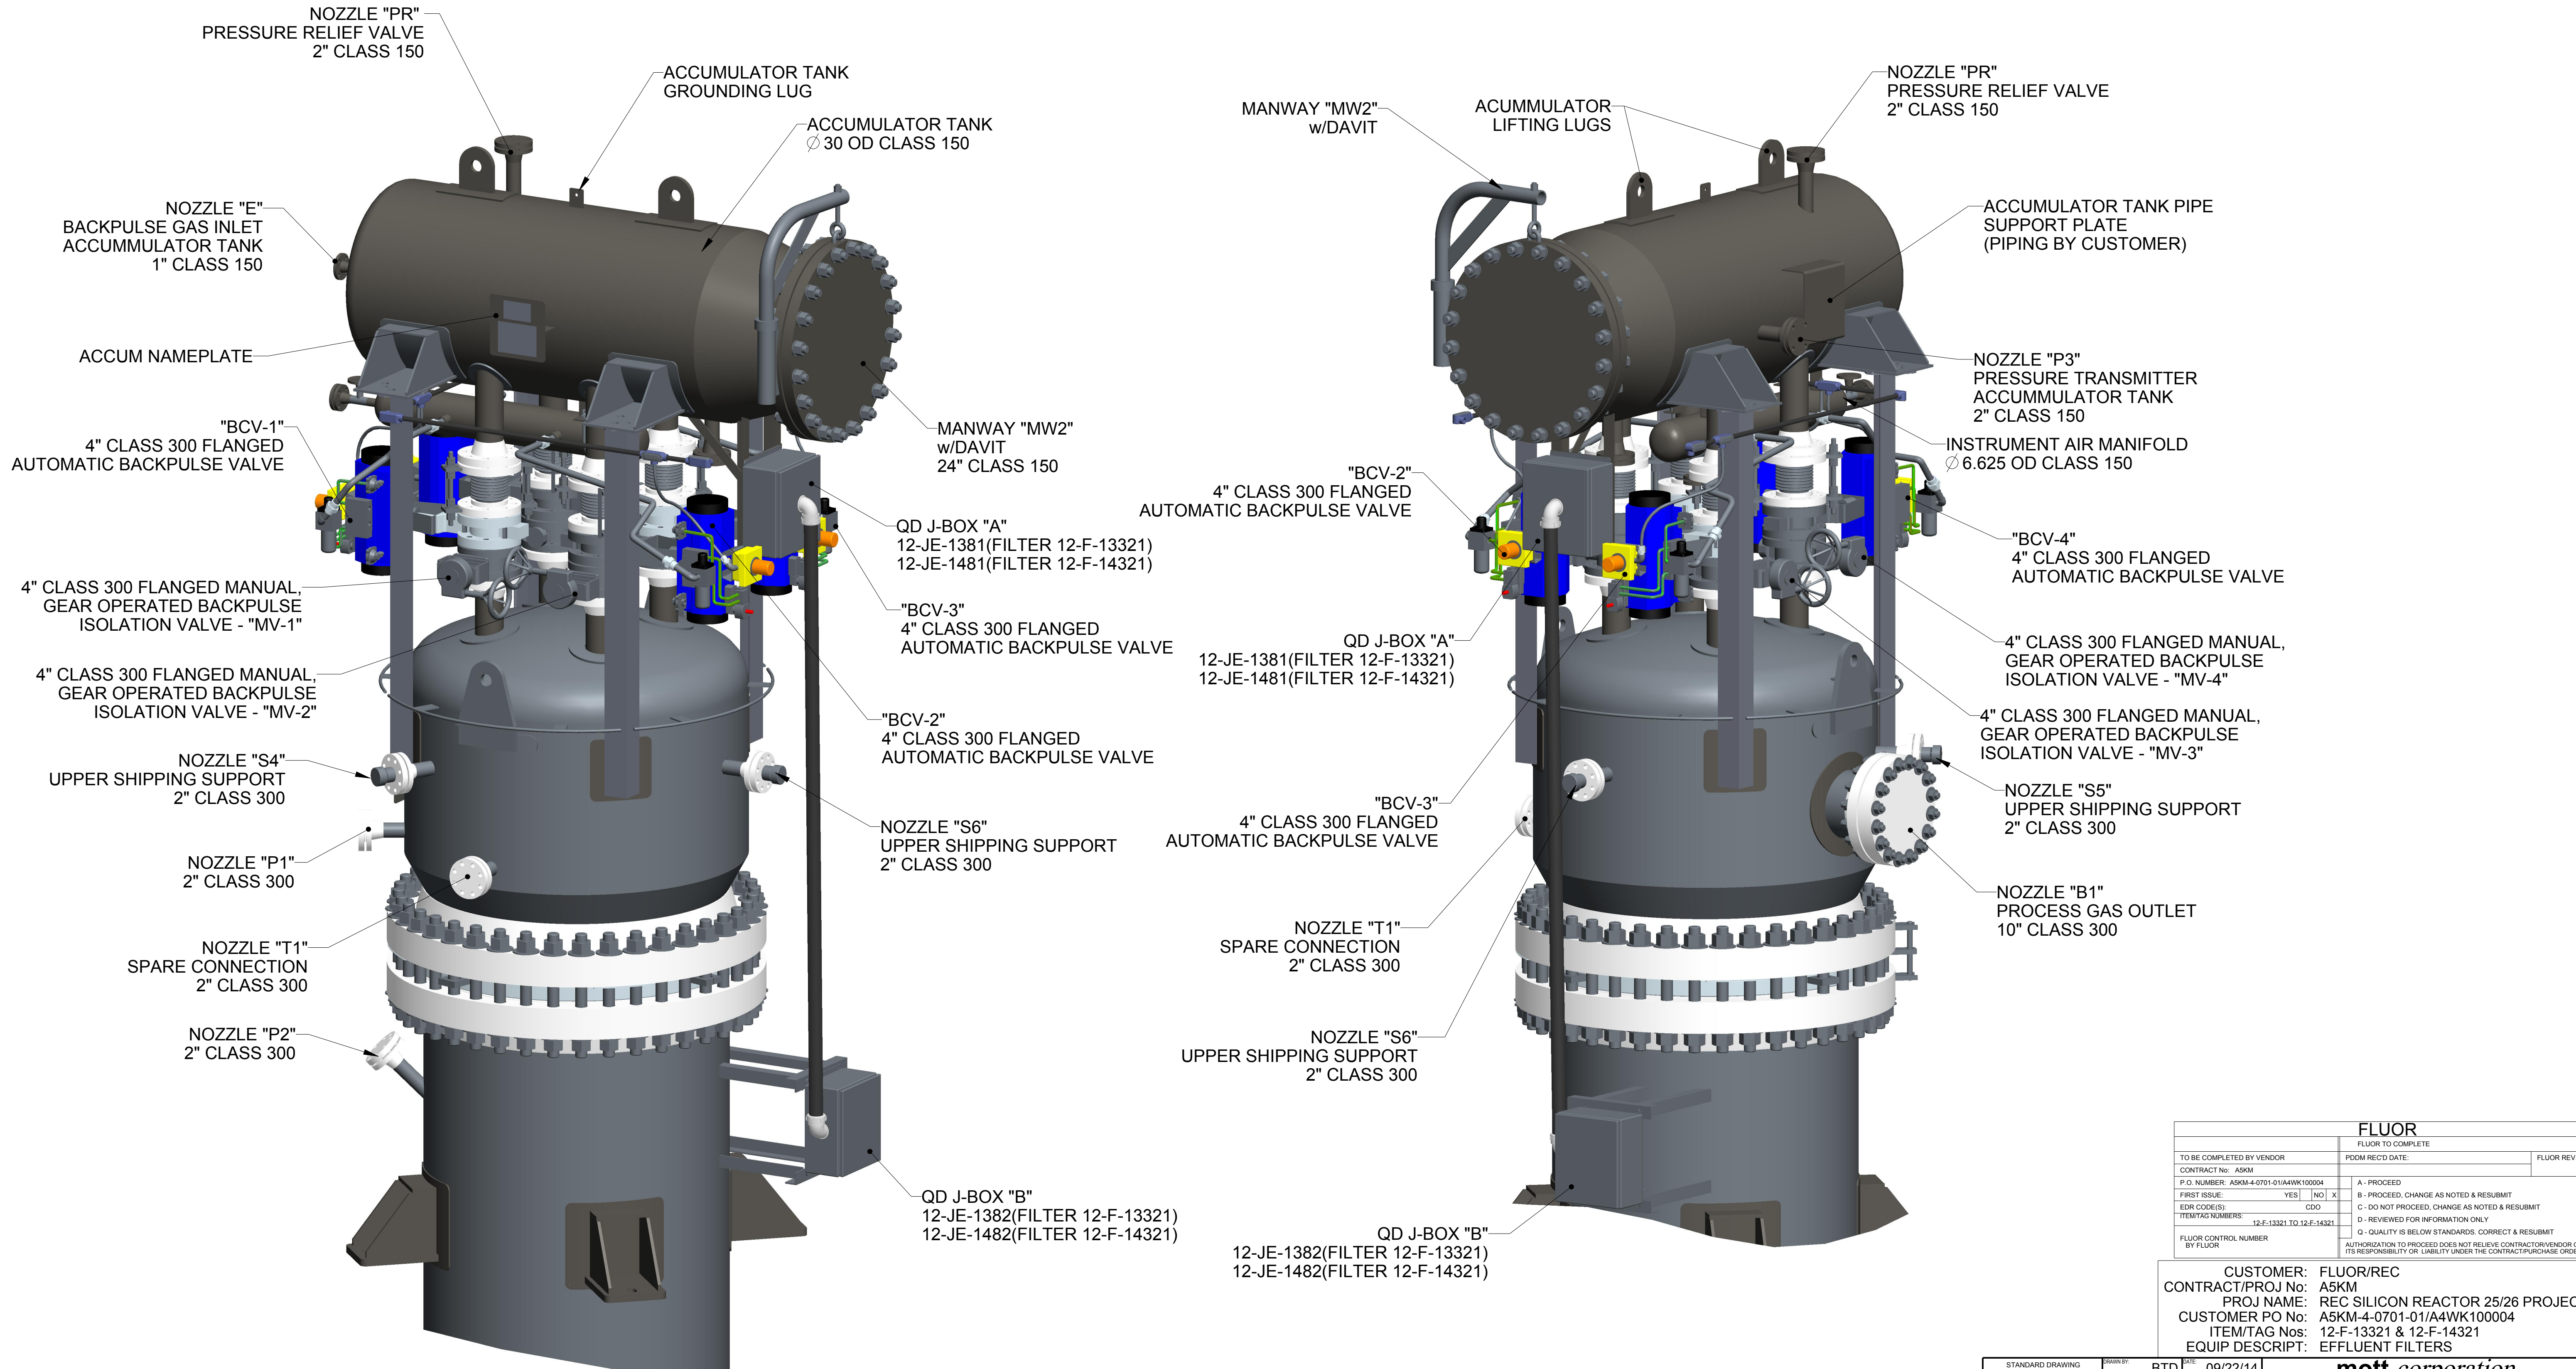

FLUOR		
TO BE COMPLETED BY VENDOR	FLUOR TO COMPLETE	FLUOR REV.
CONTRACT No: A5KM	PODM REC'D DATE:	
P.O. NUMBER: A5KM-4-0701-01/A4WK100004	A - PROCED	
FIRST ISSUE: YES [] NO [X]	B - PROCED, CHANGE AS NOTED & RESUBMIT	
EQR CODE(S): CDO	C - DO NOT PROCED, CHANGE AS NOTED & RESUBMIT	
ITEM/TAG NUMBERS: 12-F-13321 TO 12-F-14321	D - REVIEWED FOR INFORMATION ONLY	
FLUOR CONTROL NUMBER BY FLUOR	Q - QUALITY IS BELOW STANDARDS, CORRECT & RESUBMIT	
AUTHORIZATION TO PROCEED DOES NOT RELIEVE CONTRACTOR/VENDOR OF ITS RESPONSIBILITY OR LIABILITY UNDER THE CONTRACT/PURCHASE ORDER.		
CUSTOMER: FLUOR/REC		
CONTRACT/PROJ No: A5KM		
PROJ NAME: REC SILICON REACTOR 25/26 PROJECT		
CUSTOMER PO No: A5KM-4-0701-01/A4WK100004		
ITEM/TAG Nos: 12-F-13321 & 12-F-14321		
EQUIP DESCRIPT: EFFLUENT FILTERS		



STANDARD DRAWING	DATE	BY	DATE	BY	DATE	BY	DATE	BY	DATE	BY
09/22/14	09/22/14	BTD	09/22/14	EFM	09/22/14					
QU0202582										
SO2010865										
PRJ0000338										

DIMENSIONS ARE IN INCHES
 1. PLC DIMS: ±.005
 2. PLC DIMS: ±.010
 3. PLC DIMS: ±.015
 ANGLES: 45° & 90°
 ROUNDS: R.015 APPROX RADIUS

THIS DOCUMENT IS THE PROPERTY OF THE MOTT CORPORATION AND IS NOT TO BE REPRODUCED IN PART OR WHOLE, NOR THE INFORMATION CONTAINED HEREIN, TRANSMITTED TO ANY UNAUTHORIZED INDIVIDUAL, COMPANY OR ORGANIZATION WITHOUT THE WRITTEN CONSENT OF THE MOTT CORPORATION.

MATERIAL: NOTED
 FINISH: NOTED
 SCALE: 0.080
 SHEET: 2 OF 3
 NEXT ASSY: D
 9354100 8

REV	ECN	ZONE	DESCRIPTION	DATE	DRAWN	CHKD
0	2478		REL FOR FABRICATION	09/22/14	BTD	EFM
1	2488		CUSTOMER REQUEST CHANGES	10/17/14	BTD	EFM
2	2500		SEE SHEETS 1 & 2	11/13/14	BTD	EFM
3	2515		SEE SHEET 1	12/11/14	BTD	EFM
4	2578		CHANGED TO FINAL AS BUILT	04/02/15	BTD	EFM
5	2587		SEE SHEET 1	04/28/15	BTD	EFM
6	2604		SEE SHEET 1	05/08/15	BTD	EFM
7	2615		SEE SHEETS 1 & 2	06/03/15	BTD	EFM
8	2633		SEE SHEET 1	06/22/15	BTD	EFM

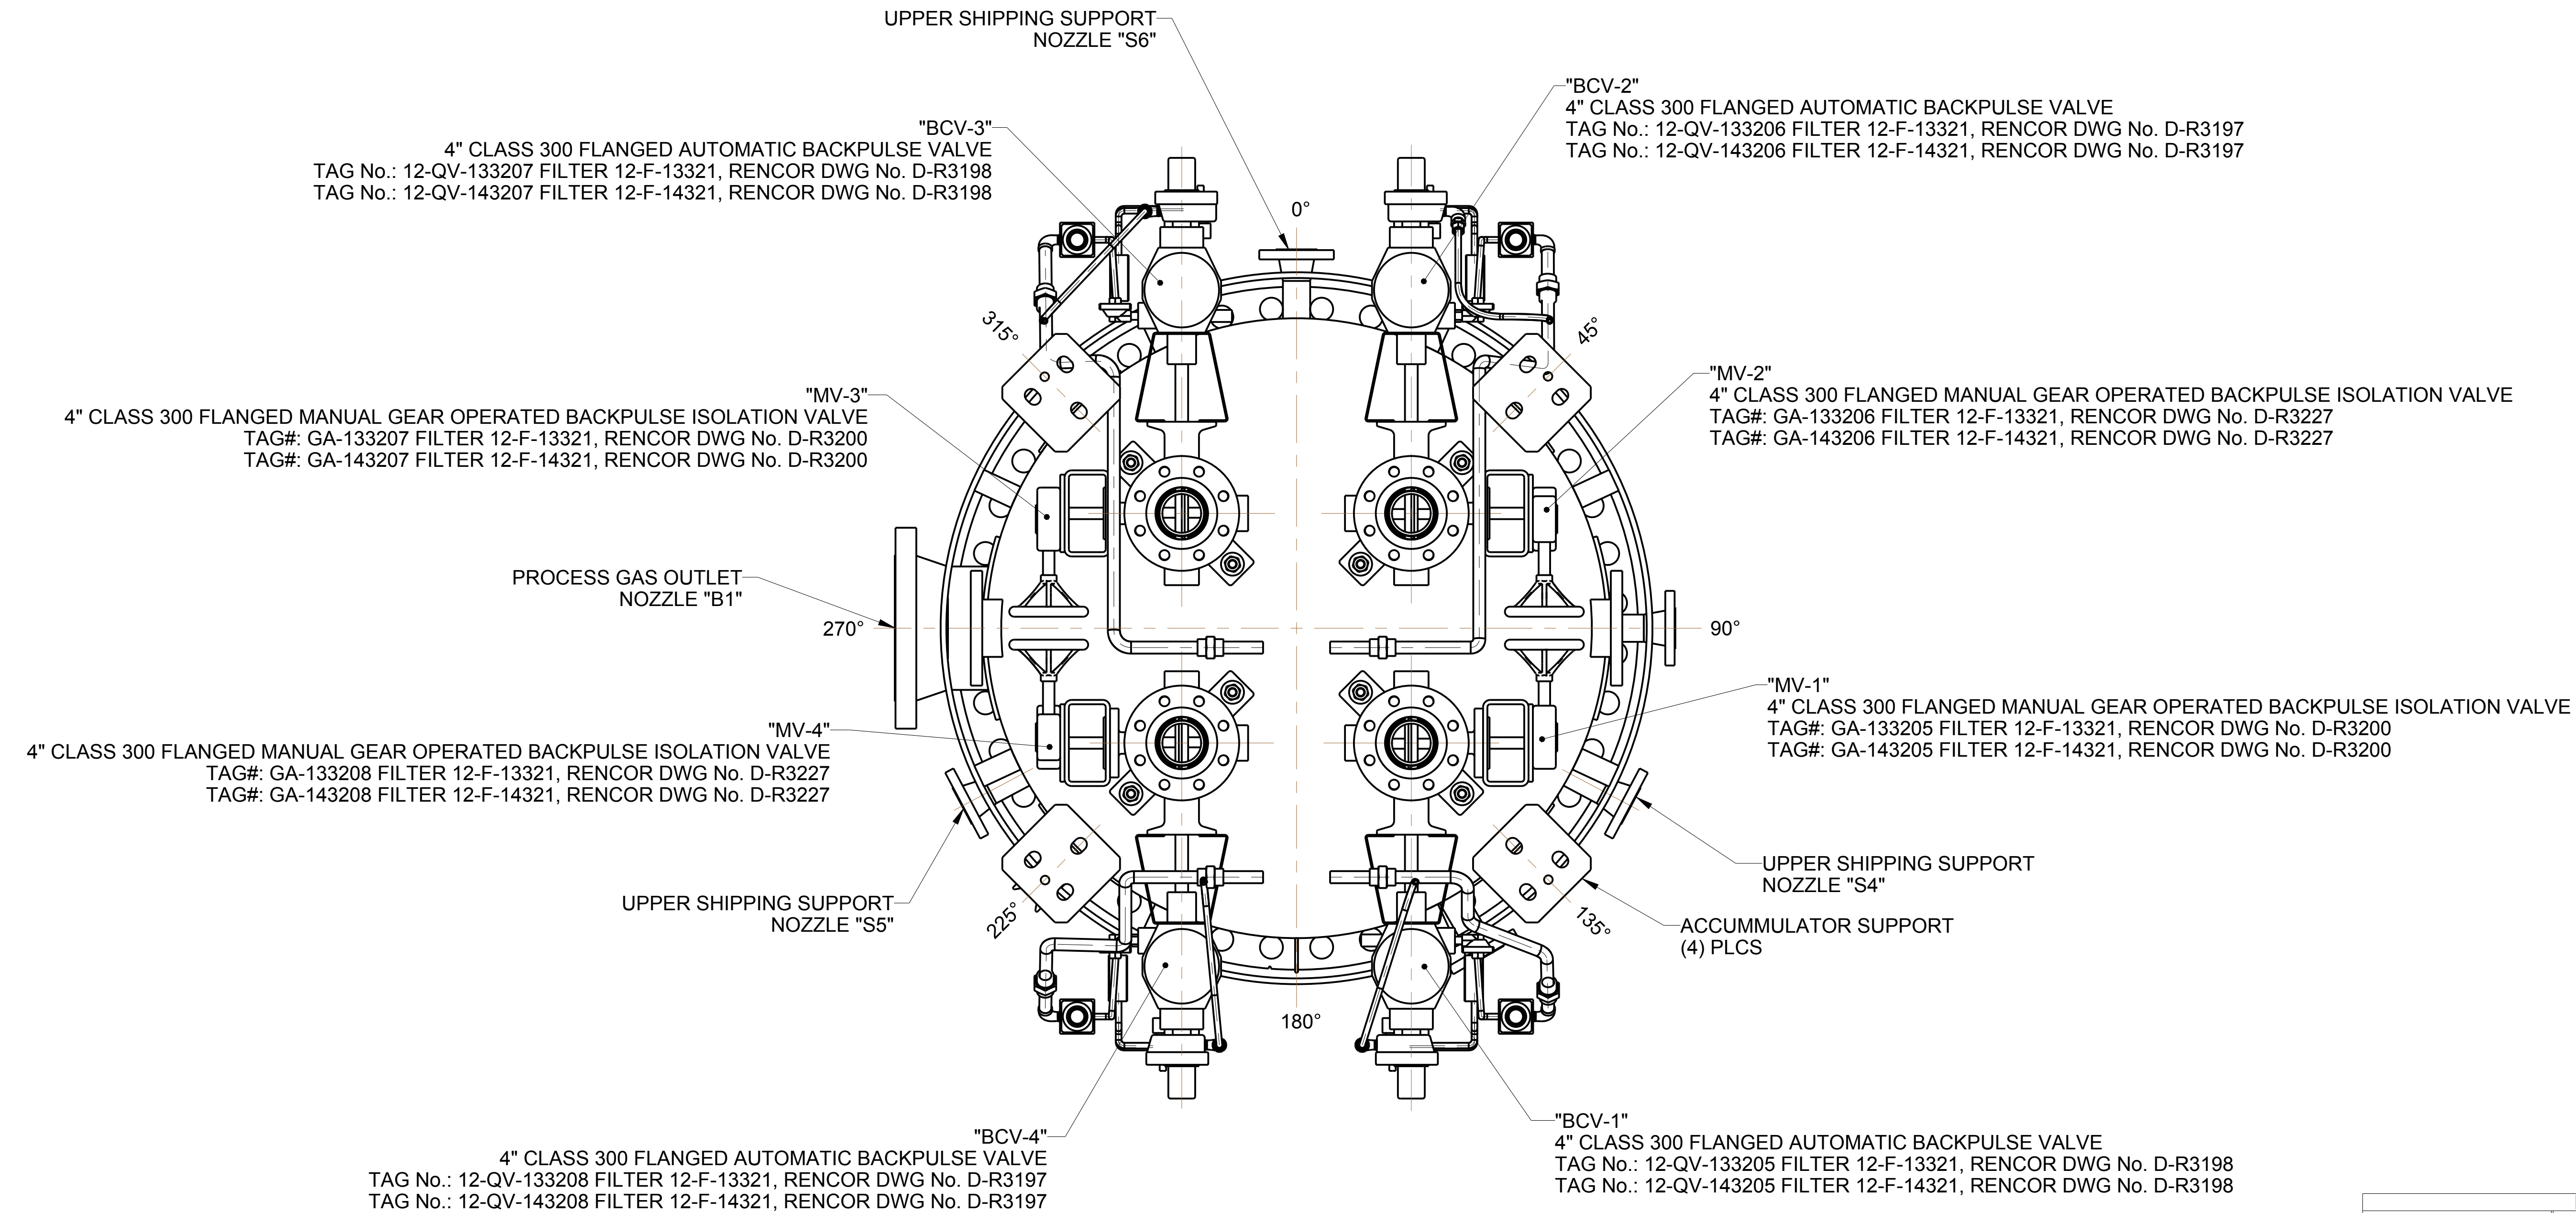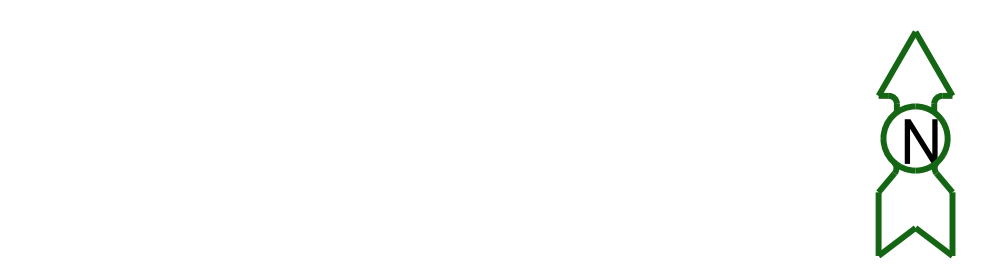

FLUOR	
TO BE COMPLETED BY VENDOR	FLUOR TO COMPLETE
CONTRACT No. A5KM	P00M RECD DATE:
P.O. NUMBER: A5KM-4-0701-01/A4WK100004	FLUOR REV.:
FIRST ISSUE: YES [] NO [x]	A - PROCEED
EDR CODE(S): CDO	B - PROCEED, CHANGE AS NOTED & RESUBMIT
ITEM/TAG NUMBERS: 12-F-13321 TO 12-F-14321	C - DO NOT PROCEED, CHANGE AS NOTED & RESUBMIT
FLUOR CONTROL NUMBER BY FLUOR:	D - REVIEWED FOR INFORMATION ONLY
	E - QUALITY IS BELOW STANDARDS, CORRECT & RESUBMIT
	F - AUTHORIZATION TO PROCEED DOES NOT RELIEVE CONTRACTOR/VENDOR OF ITS RESPONSIBILITY OR LIABILITY UNDER THE CONTRACT/PURCHASE ORDER.
CUSTOMER: FLUOR/REC	
CONTRACT/PROJ No: A5KM	
PROJ NAME: REC SILICON REACTOR 25/26 PROJECT	
CUSTOMER PO No: A5KM-4-0701-01/A4WK100004	
ITEM/TAG Nos: 12-F-13321 & 12-F-14321	
EQUIP DESCRIPT: EFFLUENT FILTERS	

STANDARD DRAWING	DRAWN BY: BTD	DATE: 09/22/14	
TOLERANCES UNLESS OTHERWISE SPECIFIED	APP'D BY: EFM	DATE: 09/22/14	
DIMENSIONS ARE IN INCHES	REV: 0	REV: 0	mott corporation 84 Spring Lane, Farmington, CT 06032-3159 860-747-6333 FAX 860-747-5529 www.mottcorp.com
1 P.L.C. DECIMALS: ±.005	REV: 0	REV: 0	
2 P.L.C. DECIMALS: ±.010	REV: 0	REV: 0	BACKPULSE VALVE ORIENTATION 54" x 48" HyPULSE® GSV
3 P.L.C. DECIMALS: ±.015	REV: 0	REV: 0	
ANGLES: ±.005	REV: 0	REV: 0	NOTED NOTED SCALE: .125 3 OF 3 NEXT ASSY: 9354100 8
RISER CHAMF EDGES & CORNERS: ±.015 APPROX RADIUS	REV: 0	REV: 0	
THIS DOCUMENT IS THE PROPERTY OF THE MOTT CORPORATION AND IS NOT TO BE REPRODUCED IN PART OR WHOLE, NOR THE INFORMATION CONTAINED HEREIN, TRANSMITTED TO ANY UNAUTHORIZED INDIVIDUAL, COMPANY OR ORGANIZATION, WITHOUT THE WRITTEN CONSENT OF THE MOTT CORPORATION.	REV: 0	REV: 0	