
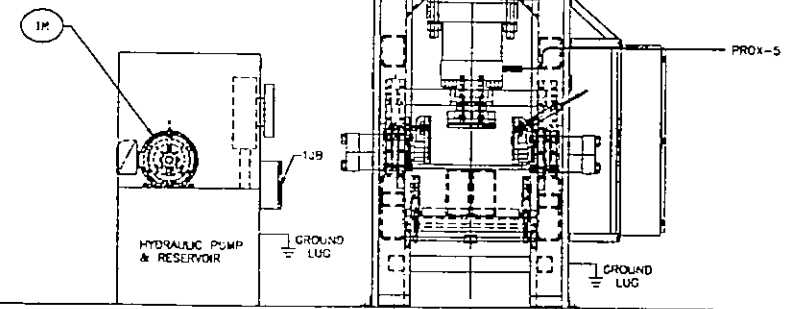


HYDRAULIC PUMP
& RESERVOIR
200 GAL

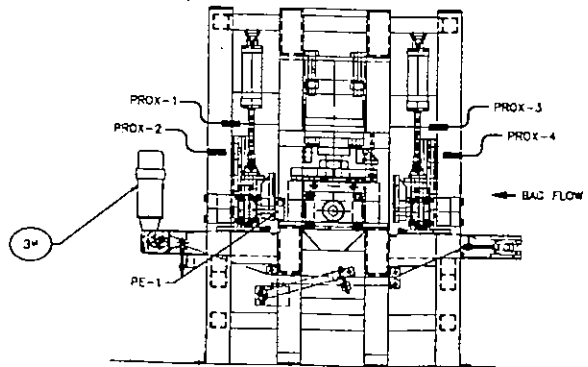

MOTOR DATA

MOTOR NO.	H.P.	BRAKE TYPE	EQUIPMENT
1M	30	-----	HYDRAULIC PUMP
2M	1/2	-----	HEAT EXCHANGER
3M	1	3 LB/FT	CONVEYOR

ELECTRICAL REQUIREMENTS

480/3/80 60 AMP SERVICE 55 AMP LOAD

PNEUMATIC REQUIREMENTS

15 CFM AT 80 PSI 96 SCFM

LCDC # 71672

TOLERANCES UNLESS SPECIFIED 2 PL. DEC. ±.010 3 PL. DEC. ±.005 FRACTIONS ±1/16 ANGLES ±1/2°	CONTROL DESIGN & MANUFACTURING, INC. THIS DRAWING IS THE PROPERTY OF CONTROL DESIGN & MANUFACTURING, INC. UNAUTHORIZED REPRODUCTION IS PROHIBITED. DRAWN SWST 1/25/99 SUPERSEDES NO C440
USED ON SCALE: 3/4"=12" SHEET 1 OF 1	
ELECTRICAL COMPONENT ARRANGEMENT 98-1420 Dwg No: 140-02213-1 REV A	

10/98 SWSIAS INSTALLED 5/99 SWSIAS BUILT REV DATE BY DESCRIPTION
--