

FORM U-1 MANUFACTURER'S DATA REPORT FOR PRESSURE VESSELS S-5206-C

As required by the Provisions of the ASME Code Rules

SECTION VIII, DIVISION 1. **7/16/68**

1. Manufactured by INDUSTRIAL FABRICATING COMPANY 3159 SOUTH SHERIDAN ROAD TULSA, OKLAHOMA
(Name and address of Manufacturer)

2. Manufactured for M. W. Kellogg Company Houston, Texas
(Name and address of Purchaser) **105-C**

3. Type VERT Kind Heat Exch Vessel No. (5206-3) (La. La.) Nat'l Bd. No. 2197 Yr. Built 1976
(Horiz. or Vert.) (Tank, Jacketed, Heat Exch.) (Mfrs' Serial) (State & State No.)

Items 4-9 incl. to be completed for single wall vessels (such as air tanks), jackets of jacketed vessels, or shells of Heat Exchangers

4. SHELL: Material SA-515-70 T.S. 70,000 Nominal Thickness 1" Corrosion Allowance 1/4" C. ft. Diam. 4 ft. 10 in. Length 11 ft. 0 in.
(Kind and Spec. No.) (Fig. or F. B. & Spec. Min. T.S.)

5. SEAMS: Long Dbl. Butt H.T. No. R.T. Complete Sectioned No Efficiency 100 %
(Welded, Dbl., Single, Lap, Butt) (Yes or No) (Spot or Complete) (Yes or No)
Girth Dbl. Butt H.T. No. R.T. Complete Sectioned No No. of Courses 2

If riveted describe seams fully on reverse side of form

6. HEADS: (a) Material SA-515-70 T.S. 70,000 (b) Material SA-515-70 T.S. 70,000
Location Thickness Crown Radius Knuckle Radius Elliptical Ratio Conical Apex angle Hemispherical Radius Flat Diameter Side to Pressure (Convex or Concave)

(a)
(b) Shell Cover 1-1/8 (M) 2:1 Concave

If removable, bolts used Stl; SA-193-B7; 125,000; 1-3/8; 64 Other fastening
(Material, Spec. No., T.S., Size, Number) (Describe or Attach Sketch)

7. STAYBOLTS: If hollow Attachment Pitch X Diam.
(Material) (Size of Hole) (Threaded, Welded) (Horiz.) (Vert.) (Nominal)

8. JACKET CLOSURE:
(Describe as ogee & weld, bar, etc. If bar give dimensions, if bolted, describe or sketch)

9. Constructed for max. allowable working press. 440 psi. at max. temp. 380 °F. Min. temp. (when less than -20°) °F. Hydrostatic Test Press. 660 psi.
(Pneumatic or Combination)

Items 10 and 11 to be completed for tube sections.

10. TUBE SHEETS: Stationary. Material SA-240TP-316SS Diam. 5 7/8 in. Thickness 4-7/8 in. Attachment Bolted
(Kind & Spec. No.) (Subject to Pressure) (Welded, Bolted)

TP-304SS (SA-450) Floating. Material SA-240 TP-304SS Diam. 5 5/8 OD in. Thickness 4-7/8 in. Attachment Bolted
Dual Tested (Kind & Spec. No.)

11. TUBES: Material SA-249 O.D. 3/4 in. Thickness 16 AVG. inches or gage. Number 2790 Type Straight
(Kind & Spec. No.) (Straight or U)

Items 12-15 incl. to be completed for inner chambers of jacketed vessels, or channels of heat exchangers.

12. SHELL: Material SA-240TP-304SS T.S. 75,000 Nominal Thickness 3/8 in. Corrosion Allowance 0 in. Diam. 11-1/8 ft. Length 11-1/8 ft. in.
(Kind and Spec. No.) (Fig. or F. B. & Spec. Min. T.S.)

13. SEAMS: Long Dbl. Butt H.T. No. R.T. Complete Sectioned No Efficiency 100 %
(Welded, Dbl., Single, Lap, Butt) (Yes or No) (Spot or Complete) (Yes or No)
Girth Dbl. Butt H.T. No. R.T. Complete Sectioned No No. of courses 1

If riveted describe seams fully on reverse side of form

14. Heads (a) Material SA-240 TP-304SS T.S. 75,000 (b) Material SA-240 TP-304SS T.S. 75,000 (c) Material SA-240 TP-304SS T.S. 75,000
Location Thickness Crown Radius Knuckle Radius Elliptical Ratio Conical Apex angle Hemispherical Radius Flat Diameter Side to Pressure (Convex or Concave)

(a) Top, bottom, ends
(b) Channel
(c) Floating 2-1/8 (M) 54" D.R. Both

If removable, bolts used (a) (b)
(Material, Spec. No., T.S., Size, Number)

(c) Stl; SA-193-B7; 125,000; 7/8; 68 Other fastening
(Describe or Attach Sketch)

15. Constructed for max. allowable working press. 75 psi. at max. temp. 270 °F. Min. temp. (when less than -20°) °F. Hydrostatic Test Press. 145 psi.
(Pneumatic or Combination)

Items below to be completed for all Vessels where applicable.

16. SAFETY VALVE OUTLETS: Number Size Location

17. NOZZLES:	Number	Diam. or Size	Type	Material	Thickness	Reinforcement Material	How Attached
Chan In	Split Flgs	to Mate 12"	150#	SA-312TP-304SS	.688	SA-240TP-304SS	Welded
Chan Out	1	30"	90° ELL	SA-403WP-304SS	STD	wt. weld	Welded
Shell In	1	16" Pipe	Seamless	SA-106-B	Sch. 80	SA-515-70	Welded
Shell Out	1	14" Pipe	Seamless	SA-106-B	Sch. 80	SA-515-70	Welded
Shell	1	4"	90° Ell	SA-234-WPB	Sch. 160	weld	Welded
Aux NOZ	2	1"	LWN	SA-182-F 304SS	-----	weld	Welded

¹ If Postweld Heat-Treated ² List other internal or external pressures with coincident temperature when applicable.

CONT. 17. NOZZLES:
Purpose (Inlet, Outlet, Drain)

S-5206-C

Number	Diam. or Size	Type	Material	Thickness	Reinforcement Material	How Attached
* Conc Cone	56" I.D x 29 1/4" I.D.		x 1" 11-1/8"	Lg 3/8" Thk.		

18. INSPECTION Manholes, No. _____ Size _____ Location _____
 OPENINGS: Handholes, No. _____ Size _____ Location _____
 Threaded, No. _____ Size _____ Location _____

19. SUPPORTS: Skirt _____ Lugs _____ Legs _____ Other _____ Saddles _____ Attached _____ Welded _____
 (Yes or No) (Number) (Number) (Describe) (Where & How)

20. REMARKS: Item: 105-CB Service: CO₂ Stripper Gas Reboiler
 Shell Side: LTS Gas
 Tube Side: MEA Solution 30 Wt%
 M. W. Kellogg Company (Monsanto)
 M.W. Kellogg P. O. 5058-P-C21-103 (A)
 Req# 5058-P-C21-103 Job# 5058P

Flgs: S-344-56 SA-182-F 304SS S-1644-60 SA-105 S-575-30 SA-182-F 304SS S-744-56 S-844-56
 Full X-Ray Shell Cover Expansion joint located in shell cover Partial Data Serial#

S-2944-15 SA-105 (Brief description of purpose of the vessel, as Air Tank, After Cooler, Jacketed Cooler, etc. State contents of each part.) W/Weld Pad SA-515-1" Thk. 70

We certify that the statements made in this report are correct and that all details of design, material, construction, and workmanship of this vessel conform to the ASME Code for Pressure Vessels, Section VIII, Division 1.

Date: Dec. 31 19 75 Signed: Industrial Fabricating Company By: M.L. Plunk
 Manufacturer

Certificate of Authorization NO. 10891 Expires Jan. 15, 1977

CERTIFICATE OF SHOP INSPECTION

VESSEL MADE BY INDUSTRIAL FABRICATING CO. at TULSA, OKLAHOMA

I, the undersigned, holding a valid commission issued by the National Board of Boiler and Pressure Vessel Inspectors and the State or Province of Ark. and employed by Commercial Union Ins. Company of Boston, Mass. have inspected the pressure vessel described in this manufacturer's data report on 1-16 19 76 and state that to the best of my knowledge and belief, the manufacturer has constructed this pressure vessel in accordance with the applicable sections of the ASME Boiler and Pressure Vessel Code.

By signing this certificate neither the Inspector nor his employer makes any warranty, expressed or implied, concerning the pressure vessel described in this manufacturer's data report. Furthermore, neither the Inspector nor his employer shall be liable in any manner for any personal injury or property damage or a loss of any kind arising from or connected with this inspection.

Date: 1-16 19 76
 [Signature] Commissions N.B. # 7003
 National Board, State, Province and N.





30" 90° Ell Partial Data Serial # H-4208

CERTIFICATE OF FIELD ASSEMBLY INSPECTION

I, the undersigned, holding a valid commission issued by the National Board of Boiler and Pressure Vessel Inspectors and the State or Province of _____ and employed by _____ of _____ have compared the statements in this manufacturer's data report with the described pressure vessel and state that parts referred to as data items _____ not included in the certificate of shop inspection have been inspected by me and that to the best of my knowledge and belief the manufacturer has constructed and assembled this pressure vessel in accordance with the applicable sections of the ASME Boiler and Pressure Vessel Code. The described vessel was inspected and subjected to a hydrostatic test of _____ psl.

By signing this certificate neither the Inspector nor his employer makes any warranty, expressed or implied, concerning the pressure vessel described in this manufacturer's data report. Furthermore, neither the Inspector nor his employer shall be liable in any manner for any personal injury or property damage or a loss of any kind arising from or connected with this inspection.

Date: 10
 [Signature] Commissions
 National Board, State, Province and N.

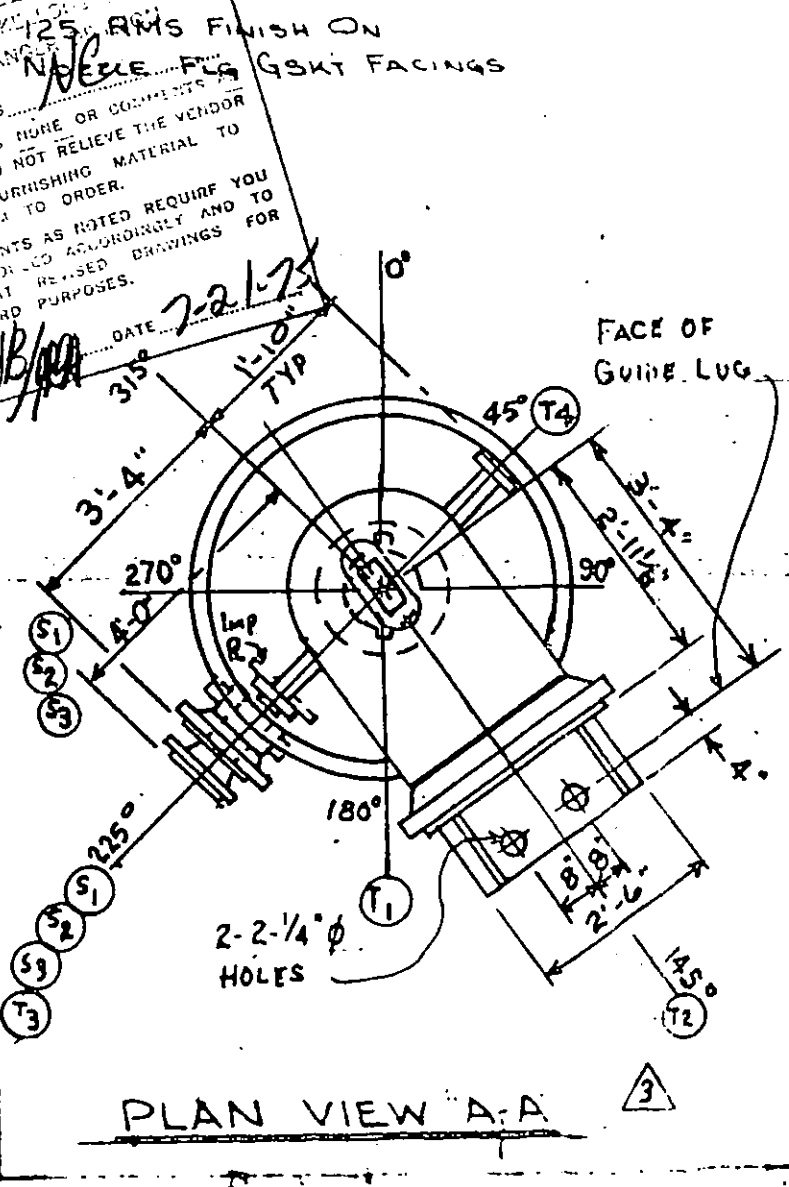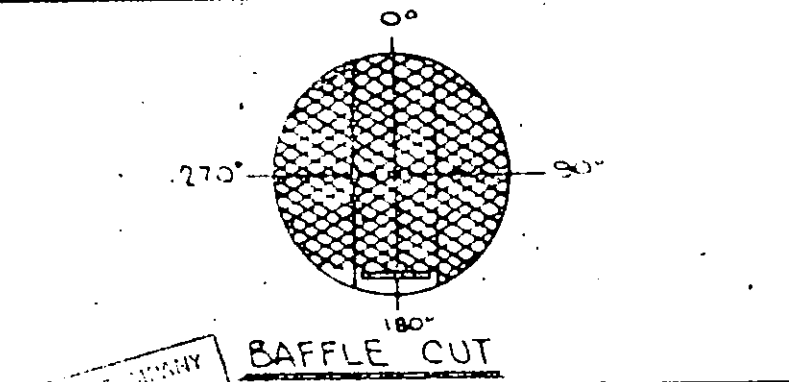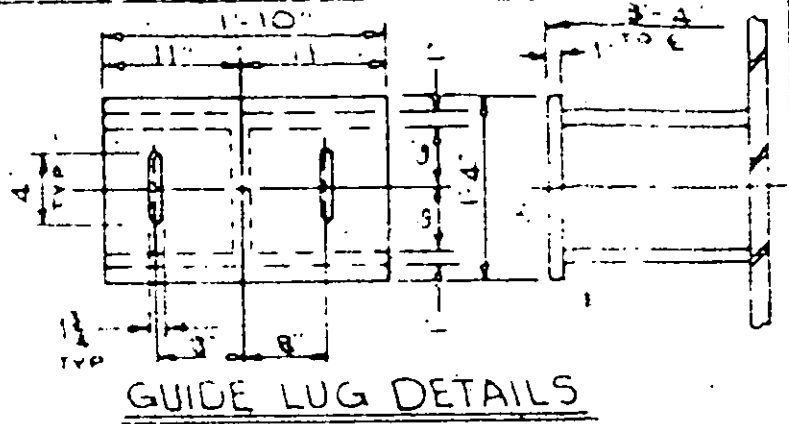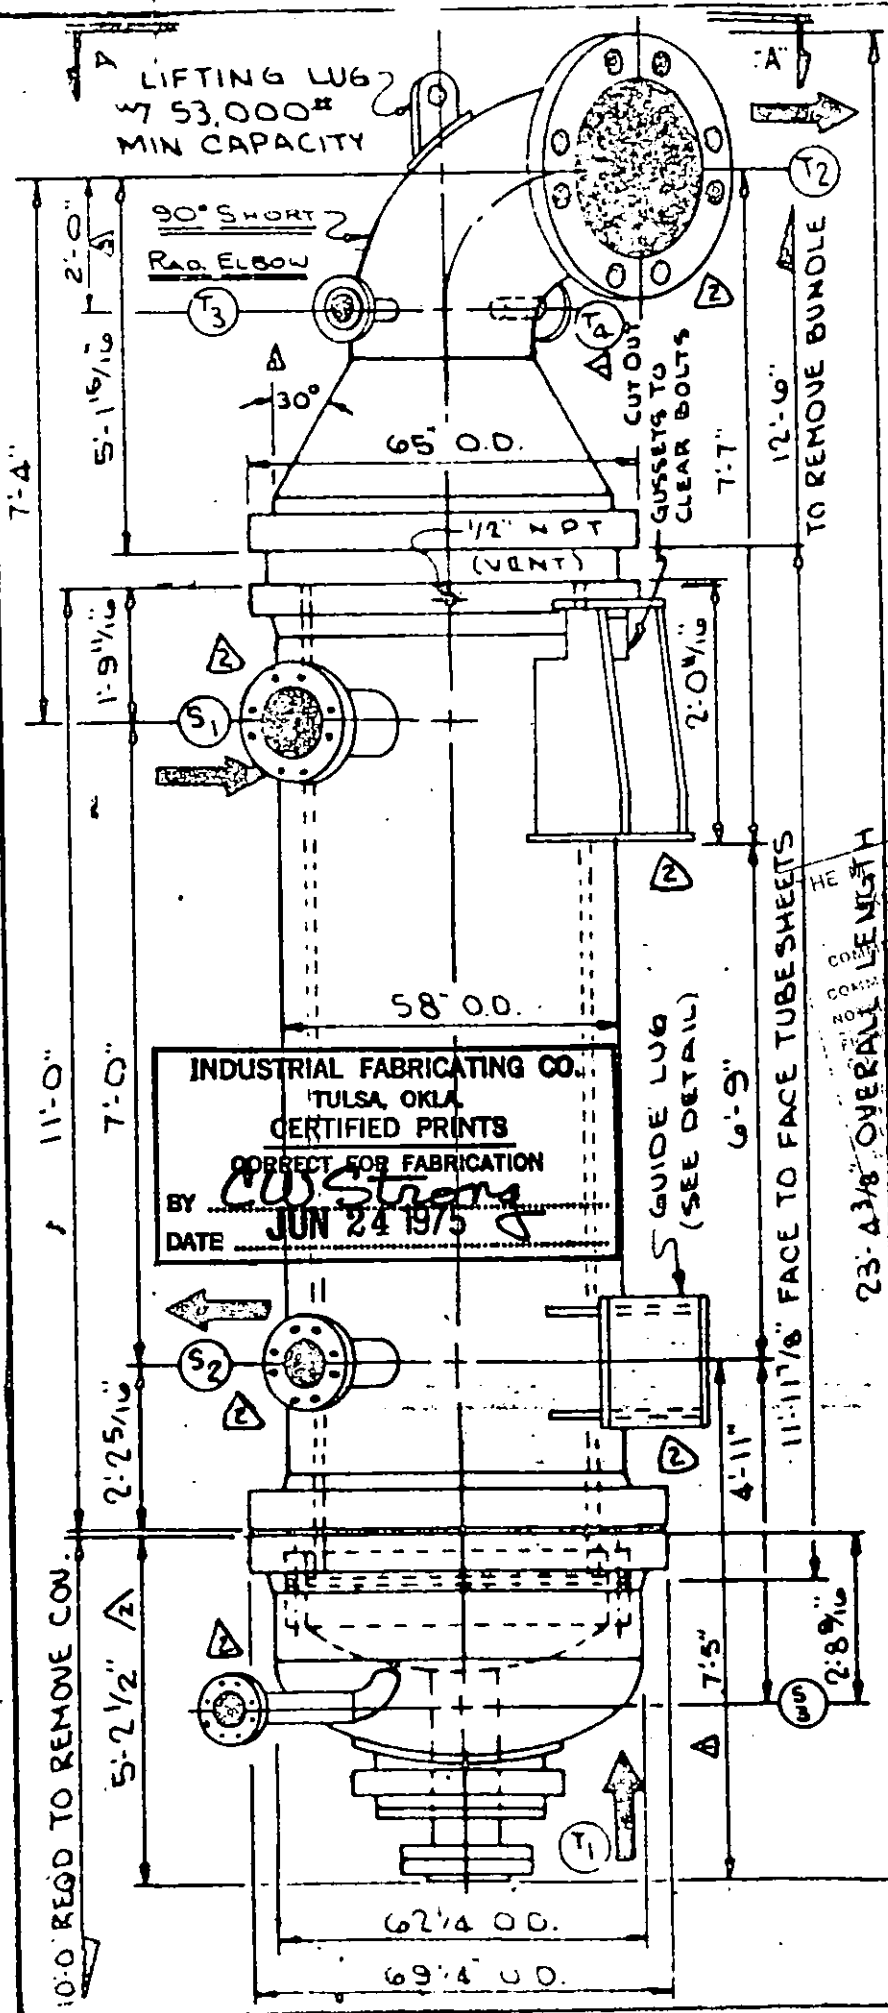

SPECIFICATIONS FOR ONE 7616P

	SHELL SIDE	TUBE SIDE	MATERIALS
DESIGN PRESSURE PSIG.	440	- 75	CHANNEL-SOLID TP 304 STN. STL
TEST PRESSURE PSIG.	660	145	TUBES-SA-249-TP 316 STN. STL. (SA-450)
DESIGN TEMPERATURE °F.	380	270	STATIONARY TUBE SHEET-SA-240-TP 316 STN. STL.
NUMBER OF PASSES	1	1	FLOATING TUBE SHEET-SA-240-TP 304 STN. STL.
CORROSION ALLOWANCE	1/4" ON C.S.	NONE	BAFFLES, TIE RODS & SPACERS-TP-316 STN. STL.
TUBE SURFACE: 6110 SQ. FT.			EXPANSION JOINT BELLOWS-TP-321 STN. STL.
TUBE PITCH 15/16" Δ			FLTG. HD. COV.-SOLID TP-304 STN. STL.
NO OF TUBES: 2790 - 3/4" OD x 16 BW.G. (WG) x 12'-0" LG			TI NOZ.-TP-304 S.S. REMAINDER-C-STL.

ALL BOLT HOLES TO STRADDLE E'S. BOLTING PROTECTED W/ HIGH-TEMP. THREAD LUBE. LOCATE (2) - 3/4" - 6000# PIPE CPLG'S IN S1 & S2 NOZ'S. FULL X-RAY CHANNEL, SHELL & SHELL COVER. SANDBLAST SUPPORTS ONLY PER SP 6 & PAINT W/ 1 COAT OF CARBLINE CARBO ZINC #11 (3-MILS D.F.T.) MAGNAFLUX OR DYE CHECK ARC STRIKES, NOZ. & ATTACHMENT WELDS & TEMPORARY ATTACH. WELDS AFTER REMOVAL. COAT NOZ. FLG. GSKT SURFACES RUST PREVENTATIVE STENCIL PAINT ON SIDE OF SHELL ITEM NO.: 105-CB, SHIPPING WT.: 52,800#, & P.O. NO.: 5058-P.C21-103(A) * TUBES TO BE DUAL TESTED.

DESIGNED & CONSTRUCTED IN ACCORDANCE W/ TEMA R. MWK SPEC. CA-1E6, API-660, PURCH DATA SHEET, 1974 A S.M.E. CODE (SECT. VIII, DIVISION 1) & SO STAMPED BY NAT'L. BD.

CUSTOMER: M.W. KELLOGG CO. (MONSANTO)

REV	DATE	DESCRIPTION	BY
1	10/31	GEN. REV. / CUST.	DK
2	11/25	GEN. REV.	W
3	12/20	ADD T3 & T4 NOZZLES / CUST.	CS

P.O. NO. 5058-P.C21-103(A)
 ITEM NO. 105-CB
 M.W.K. REQ. NO.: 5058-P.C21-103
 * PER TAYLOR FORGE CATALOG 571, PAGES 70 & 71

NOZZLES	INDUSTRIAL FABRICATING COMPANY
T1 SPLIT FLGS TO MATE 12"-150° RF	
T2 30"-150° RF-WN	
S1 16"-300° RF-WN	
S2 14"-300° RF-WN	
S3 4"-300° RF-WN W/ 90° SR ELBOW	
T3 2"-150° RF-WN	
T4 2"-150° RF-WN	

ASSEMBLY & SPECIFICATIONS FOR ONE VERTICAL "YES-2"-56" x 14'-6110

SERVICE: CO₂ STRIPPER GAS REBOILER

Don 10-3-74 STEEL

FILE: 74-765 W.C. S-5206-C

S-5206
C-1

INDUSTRIAL FABRICATING CO. TULSA, OKLA. CERTIFIED PRINTS. CORRECT FOR FABRICATION. BY CW Strong. DATE JUN 24 1975.

125 ARMS FINISH ON GSKT FACINGS

DATE 7-21-75

COMMENTS: NONE OR COMMENTS TO NOT RELIEVE THE VENDOR FROM FURNISHING MATERIAL TO ORDER.

REVISIONS AS NOTED REQUIRE YOU TO BE MADE ACCORDINGLY AND TO BE RE-USED DRAWINGS FOR YOUR PURPOSES.

NOTE: THIS IS A W.O. DUPLICATE OF W.O. S-5206-C