

FORM U-1 MANUFACTURERS' DATA REPORT FOR PRESSURE VESSELS
As Required by the Provisions of the ASME Code Rules, Section VIII, Division 1

78906

1. Manufactured by Fabricated Products, Inc., 7900 Pence Rd., Charlotte, NC 28212
(Name and address of manufacturer)
2. Manufactured for Badische Corporation, 602 Copper Rd., Freeport, Texas 77541
(Name and address of purchaser)
3. Location of installation Badische Corporation, Acrylic Monomer Project, Freeport, Texas 77541
(Name and address)
4. Type Vertical Vessel No. 80-345-B 80-345-2 505 Year Built 1981
(Horiz. or vert. tank) (Mfr's Serial No.) (CRN) (Drawing) (Nat'l Bld No.)
5. The chemical and physical properties of all parts meet the requirements of material specifications of the ASME BOILER AND PRESSURE VESSEL CODE. The design, construction, and workmanship conform to ASME Rules, Section VIII, Division 1 1977 and Addenda to W'79 and Code Case no. _____
(Date) (Year)

Special service per UG-120(d) _____

Manufacturers' Partial Data Reports properly identified and signed by Commissioned Inspectors have been furnished for the following items of the report: _____
(Name of part, item number, mfr's name and identifying stamp)

Items 6-11 incl. to be completed for single wall vessels, jackets of jacketed vessels, or shells of heat exchangers

6. Shell: Material SA312TP304 Nom. Thickness Sch 40 In. Corrosion Allowance 0 In. Diam. _____ ft. _____ In. Length 140 Approx. In.
(Spec. No., Grade) (Overall)
7. Seams: Longitudinal Sngl. R.T. NA Efficiency NA % H.T. Temp. _____ F Time _____ Girth Sngl. R.T. NA No. of Courses 14
(Dbl., Sngl.) (Spot or Full) (Dbl., Sngl.) (Spot, Partial, or Full)

8. Heads: (a) Material WPB 304 Caps (b) Material WPB 304 Caps
(Spec. No., Grade) (Spec. No., Grade)

| | Location (Top, Bottom, Ends) | Minimum Thickness | Corrosion Allowance | Crown Radius | Knuckle Radius | Elliptical Ratio | Conical Apex Angle | Hemispherical Radius | Flat Diameter | Side to Pressure (Convex or Concave) |
|-----|------------------------------|-------------------|---------------------|--------------|----------------|------------------|--------------------|----------------------|---------------|--------------------------------------|
| (a) | End | .154 | 0 | 1/2 Weld Cap | | | | | | Convex |
| (b) | End | .154 | 0 | 1/2 Weld Cap | | | | | | Convex |

If removable, bolts used (describe other fastenings) _____

(Material, Spec. No., Gr., Size, No.)

9. Type of Jacket 1/2 Pipe Proof Test _____
10. Jacket Closure Welded If bar, give dimensions _____ If bolted, describe or sketch.
(Describe as open & weld, bar, etc.)

11. Constructed for max. allowable working pressure 120 psi at max. temp. 400F Min. temp. (when less than -20 F) _____ F.
Hydrostatic, pressure or comb. test pressure 180 psi.

Items 12 and 13 to be completed for tube sections

12. Tubesheets: Stationary Material _____ Diam. _____ In. Nominal Thick. _____ In. Corrosion Allow. _____ In. Attachment _____
(Spec. No., Gr.) (Subject to pressure) (Welded, Bolted)
- Floating Material _____ Diam. _____ In. Nominal Thick. _____ In. Corrosion Allow. _____ In. Attachment _____
(Spec. No., Gr.)

13. Tubes: Material _____ O.D. _____ In. Nominal Thickness _____ In. or gauge Number _____ Type _____
(Spec. No., Gr.) (Straight or "U")

Items 14-17 incl. to be completed for inner chambers of jacketed vessels or channels of heat exchangers

14. Shell: Material SA240TP316L Nominal Thickness .25 In. Corrosion Allowance 0 In. Diam. 6 ft. _____ In. Length 5 ft. 11-1/2
(Spec. No., Gr.)
15. Seams: Longitudinal Dbl. R.T. Spot Efficiency 85 % H.T. Temp. _____ F Time _____ Girth Dbl. R.T. Spot No. of courses 1
(Dbl., Sngl.) (Spot or Full) (Dbl., Sngl.) (Spot, Partial, or Full)

16. Heads: (a) Material SA240TP316L (b) Material SA240TP316L
(Spec. No., Grade) (Spec. No., Grade)

| | Location (Top, Bottom, Ends) | Minimum Thickness | Corrosion Allowance | Crown Radius | Knuckle Radius | Elliptical Ratio | Conical Apex Angle | Hemispherical Radius | Flat Diameter | Side to Pressure (Convex or Concave) |
|-----|------------------------------|-------------------|---------------------|--------------|----------------|------------------|--------------------|----------------------|---------------|--------------------------------------|
| (a) | Top | .50 | 0 | 72 | | | | | | Convex |
| (b) | Bottom | .50 | 0 | 72 | | | | | | Convex |

If removable, bolts used (describe other fastenings) _____

(Material, Spec. No., Gr., Size, No.)

17. Max. allowable working pressure 90 psi at max temp. 500 F. Min. temp. (when less than -20F) _____ F.
Hydro. pres. or comb. test pressure 135 psi.

Items below to be completed for all vessels where applicable

18. Safety Valve Outlets: Number _____ Size _____ Location In Line By Customer

This form may be obtained from the National Board of Boiler and Pressure Vessel Inspectors, 1055 Crupper Ave., Col's., O. 43229

78906

19. Nozzles:

| Purpose (Inlet, Outlet, Drain) | Number | Diam. or Size | Type | Material | Nominal Thickness | Reinforcement Material | How Attached |
|-----------------------------------|--------|------------------|------|------------|----------------------|---------------------------|-----------------|
| Vent/ Temp | | | | | | | Welded |
| Steam/Cond. | 4 | 1" | RFSO | SA182F316L | 150# | | Welded |
| Acid/Water | 2 | 1-1/2" | RFSO | SA182F316L | 150# | | Welded |
| Outlet | 1 | 4" | RFSO | SA182F316L | 150# | | Welded |
| Agitator | 1 | 16" | RFSO | SA18160 | 150# | | Welded |
| | | | | | | | |
| | | | | | | | |

20. Inspection Openings:

Manholes No. 1 Size 20" Location Top Head-Welded

Handholes No. _____ Size _____ Location _____

Threaded No. _____ Size _____ Location _____

21. Supports: Skirt _____ Lugs _____ Legs _____ Other _____ Attached _____

(Yes or no)

(No.)

(No.)

(Describe)

(Where and how)

22. Remarks:

CERTIFICATE OF COMPLIANCE

We certify that the statements made in this report are correct and that all details of design, material, construction, and workmanship of this vessel conform to the ASME Code for Pressure Vessels, Section VIII, Division 1.

Date 7-28-81 Signed Fabricated Products, Inc. by Willie Hudson
(Manufacturer) (Representative)U" Certificate of Authorization No. 10,264 expires January 15, 19 83

CERTIFICATE OF SHOP INSPECTION

Vessel made by Fabricated Products, Inc. at 7900 Pence Rd., Charlotte, NC 28212I, the undersigned, holding a valid commission issued by the National Board of Boiler and Pressure Vessel Inspectors and the State or Province of North Carolina and employed by Dept. of Laborof North Carolina have inspected the pressure vessel described in this Manufacturers' Data Report on 7-28- 19 81, and state that, to the best of my knowledge and belief, the Manufacturer has constructed this pressure vessel in accordance with ASME Code, Section VIII, Division 1.

By signing this certificate neither the Inspector nor his employer makes any warranty, expressed or implied, concerning the pressure vessel described in the Manufacturers' Data Report. Furthermore, neither the Inspector nor his employer shall be liable in any manner for any personal injury or property damage or a loss of any kind arising from or connected with this inspection.

Date 7-28-81Signed [Signature] Commissions NC722 NB6072
(Inspector) (Nat'l Board, State, Province and No.)

CERTIFICATE OF COMPLIANCE FOR FIELD WORK

We certify that the statements made in this report are correct and that all details of design, material, construction, and workmanship of this vessel conform to the ASME Code for Pressure Vessels, Section VIII, Division 1.

Date _____ Signed _____ by _____
(Manufacturer) (Representative)

U" Certificate of Authorization No. _____ expires _____, 19 _____

CERTIFICATE OF FIELD ASSEMBLY INSPECTION

I, the undersigned, holding a valid commission issued by the National Board of Boiler and Pressure Vessel Inspectors and the State or Province of _____ and employed by _____

of _____ have compared the statements in this Manufacturers' Data Report with the described pressure vessel and state that parts referred to as data items _____, not included in the




certificate of shop inspection, have been inspected by me and that, to the best of my knowledge and belief, the Manufacturer has constructed and assembled this pressure vessel in accordance with ASME Code, Section VIII, Division 1.

The described vessel was inspected and subjected to a hydrostatic test of _____ psi.

By signing this certificate neither the Inspector nor his employer makes any warranty, expressed or implied, concerning the pressure vessel described in this Manufacturers' Data Report. Furthermore, neither the Inspector nor his employer shall be liable in any manner for any personal injury or property damage or a loss of any kind arising from or connected with this inspection.

Date _____

Signed _____ Commissions _____
(Authorized Inspector) (Nat'l Board, State, Province and No.)

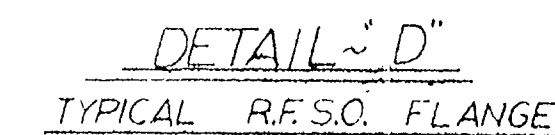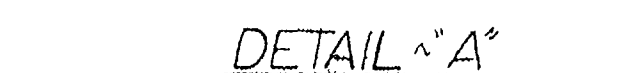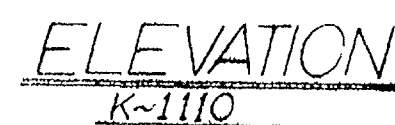

DETAIL ~ G # 78906

FINAL | DATE 7-9-81 | 5

| | | | | | | | | | |
|--------|-----|---|-----|------|---------------------------------|--|------------------|----------------|--------------------|
| 7-8-81 | △ | PER INSULATION RING W/TH WAS 3" | ECL | | TOLERANCES (EXCEPT AS NOTED) | FABRICATED PRODUCTS, INC. CHARLOTTE, N.C. | | | |
| 4/1/86 | △ | THK. OF Baffle SUBST WAS 1/2". Baffle DET. WAS SECT. A-A. NOZ. A-1 P-10 HAD PLUNGERS, ADDED LUGS. THK. WAS 1/2". LUGS A-1 P-10 ADDED THK. OF 1/2" PIPE COILS, ADDED NOZ. INFO TO NAMEPLATE | ACL | | ± .005 | FOR: BADISCHE CORPORATION | SCALE: N.T.S. | BY: S.E.S. | APPROVED BY: |
| 4/1/86 | △ | ADDED ORIENTATION ON NOZZLES, LIFTING LUGS, INSULATION RINGS, Baffle DETAIL, MANWAY COVER DET. ADDED DET. NAMEPLATE DETAIL, TYP. NAMEP. DET. DELETED LUGS ADDED LUGS. NOZ. S-1 WAS 2", NOZ. S-2 WAS 1 1/2". NOZ. S-3 WAS 1 1/2" ADDED HANDLES TO NOZ. A | BCL | | ± 1/8 | TITLE EXTRACTION-KETTLE K-1110 | | | |
| DATE | BYM | REVISION RECORD | | AUTH | CR | ANGULAR ± 1/2 | DATE | DRAWING NUMBER | |
| | | | | | | | 10-27-80 | 80-345 | DWG. #2 SH. 1 of 1 |