

FORM U-1 MANUFACTURERS' DATA REPORT FOR PRESSURE VESSELS
As Required by the Provisions of the ASME Code Rules, Section VIII, Division 1

93688

1. Manufactured by De Dietrich & Cie Zinswiler, France
(Name and address of manufacturer)
2. Manufactured for Singmaster & Breyer, Inc. New York, New York
(Name and address of purchaser)
3. Location of Installation FMC Corp. Baltimore, Maryland
(Name and address)
4. Type Vertical Vessel No. 30971 N/A VT-2600-14-2
(Horiz. or vert. tank) (Mfr's Serial No) (CRN) (Drawing)
1654 Year Built 1978
(Nat'l. Bld. No.)
5. The chemical and physical properties of all parts meet the requirements of material specifications of the ASME BOILER AND PRESSURE VESSEL CODE. The design, construction, and workmanship conform to ASME Rules, Section VIII, Division 1 1974 and Addenda to Summer 76
and Code Case no. N/A Special service per UG-120(d) N/A (Year) (Date)
Manufacturers' Partial Data Reports properly identified and signed by Commissioned Inspectors have been furnished for the following items of the report: N/A

(Name of part, item number, mfr's name and identifying stamp)
Items 6-11 incl. to be completed for single wall vessels, jackets of jacketed vessels, or shells of heat exchangers
6. Shell: Material SA 285 B Nominal Thickness 35/64 in. Corrosion Allowance N/A in.
(Spec. No., Grade)
Diam. 8 ft 6-3/8 in. Length 7 ft 9-7/8 in.

CERTIFICATE OF COMPLIANCE

We certify that the statements made in this report are correct and that all details of design, material, construction, and workmanship of this vessel conform to the ASME Code for Pressure Vessels, Section VIII, Division 1.

Date Feb. 2, 78 Signed De Dietrich & Cie by WAGNER R. Q.C. MGR. [Signature]
(Manufacturer) (Representative)

"U" Certificate of Authorization No. 11718 expires April 16, 1980

CERTIFICATE OF SHOP INSPECTION

Vessel made by De Dietrich & Cie at Zinswiler, France

I, the undersigned, holding a valid commission issued by the National Board of Boiler and Pressure Vessel Inspectors and/or the State or Province of New York and employed by The Royal Indemnity Company of New York N.Y. have inspected the pressure vessel described in this Manufacturers' Data Report on February 2, 1978 and state that, to the best of my knowledge and belief, the Manufacturer has constructed this pressure vessel in accordance with ASME Code, Section VIII, Division 1.

By signing this certificate neither the Inspector nor his employer makes any warranty, expressed or implied, concerning the pressure vessel described in the Manufacturers' Data Report. Furthermore, neither the Inspector nor his employer shall be liable in any manner for any personal injury or property damage or a loss of any kind arising from or connected with this inspection.

Date February 2, 1978
Signed [Signature] Commissions N.B. 8074
(Inspector) (S.G. AKERMAN) (Nat'l Board State, Province and No.)

CERTIFICATE OF COMPLIANCE FOR FIELD WORK

We certify that the statements made in this report are correct and that all details of design, material, construction, and workmanship of this vessel conform to the ASME Code for Pressure Vessels, Section VIII, Division 1.

Date _____ Signed _____ by _____
(Manufacturer) (Representative)

"U" Certificate of Authorization No. _____ expires _____, 19____

CERTIFICATE OF FIELD ASSEMBLY INSPECTION

I, the undersigned, holding a valid commission issued by the National Board of Boiler and Pressure Vessel Inspectors and/or the State or Province of _____ and employed by _____ of _____ have compared the statements in this Manufacturers' Data Report with the described pressure vessel and state that parts referred to as data items _____ not included in the certificate of shop inspection, have been inspected by me and that, to the best of my knowledge and belief, the Manufacturer has constructed and assembled this pressure vessel in accordance with ASME Code, Section VIII, Division 1.

The described vessel was inspected and subjected to a hydrostatic test of _____ psi.

By signing this certificate neither the Inspector nor his employer makes any warranty, expressed or implied, concerning the pressure vessel described in this Manufacturers' Data Report. Furthermore, neither the Inspector nor his employer shall be liable in any manner for any personal injury or property damage or a loss of any kind arising from or connected with this inspection.

Date _____
Signed _____ Commissions _____
(Authorized Inspector) (Nat'l Board State, Province and No.)

93688

7. Seams: Longitudinal Welded, Dbl. Butt R.T. Spot Efficiency 85 %
 (Welded, Dbl., Sngl. Lap, Butt) (Spot or Full)

H.T. Temp 1600° F Time 90min Girth Welded, Dbl. Butt R.T. Partial No. of Courses 1
 (Welded, Dbl., Sngl. Lap, Butt) (Spot, Partial, or Full)

8. Heads: (a) Material SA 285 C (Spec No., Grade) (b) Material SA 285 C
 (Spec No., Grade)

Location (Top, Bottom, Ends)	Minimum Thickness	Corrosion Allowance	Crown Radius	Knuckle Radius	Elliptical Ratio	Conical Apex Angle	Hemispherical Radius	Flat Diameter	Side to Pressure (Convex or Concave)
(a) Top	35/64"	N/A	102-3/8"	10-15/64"	N/A	N/A	N/A	N/A	Concave
(b) Bottom	35/64"	N/A	102-3/8"	10-15/64"	N/A	N/A	N/A	N/A	Concave

If removable, bolts used (describe other fastenings) N/A
 (Material, Spec No., Gr., Size No.)

9. Type of Jacket N/A Proof Test _____

10. Jacket Closure N/A If bar, give dimensions _____
 If bolted, describe or sketch. (Describe as ogee and weld bar, etc.)

11. Constructed for max. allowable working pressure 40 or F.V. psi at max. temp. 400° F Min. temp. (when
 less than -20 F) N/A F. Hydrostatic, ~~XXXXXX~~ test pressure 44 psi.

Items 12 and 13 to be completed for tube sections

12. Tubesheets: Stationary—Material N/A Diam. _____ in. (Subject to pressure)
 (Spec No. Gr.)

Nominal Thickness _____ in. Corrosion Allowance _____ in. Attachment _____ (Welded Bolted)
 Floating—Material _____ in. Nominal Thickness _____ in. Corrosion Allowance _____ in.
 (Spec No., Gr.)

Attachment _____

13. Tubes: Material N/A O.D. _____ in. Nominal Thickness _____ in. or gauge Number _____ Type _____
 (Spec No., Gr.) (Straight or U)

Items 14-17 incl. to be completed for inner chambers of jacketed vessels or channels of heat exchangers

14. Shell: Material _____ Nominal Thickness _____ in. Corrosion Allowance _____ in.
 Diam. _____ ft _____ in. Length _____ ft _____ in.

15. Seams: Longitudinal N/A R.T. _____ Efficiency _____ %
 (Welded, Dbl., Sngl. Lap, Butt) (Spot or Full)

H.T. Temp _____ F Time _____ Girth _____
 (Welded, Dbl., Sngl. Lap, Butt)

R.T. _____ No. of courses _____
 (Spot, Partial or Full)

16. Heads: (a) Material N/A (Spec No., Grade) (b) Material _____
 (Spec No., Grade)

Location (Top, Bottom, Ends)	Minimum Thickness	Corrosion Allowance	Crown Radius	Knuckle Radius	Elliptical Ratio	Conical Apex Angle	Hemispherical Radius	Flat Diameter	Side to Pressure (Convex or Concave)
(a) _____	_____	_____	_____	_____	_____	_____	_____	_____	_____
(b) _____	_____	_____	_____	_____	_____	_____	_____	_____	_____

If removable, bolts used (describe other fastenings) N/A
 (Material, Spec No., Gr., Size No.)

17. Constructed for max. allowable working pressure N/A psi at max temp. _____ F. Min. temp. (when
 less than -20 F) _____ F. Hydrostatic, pneumatic, or combination test pressure _____ psi.
 Items below to be completed for all vessels where applicable

18. Safety Valve Outlets: Number N/A Size _____ Location _____

19. Nozzles:

Purpose (Inlet, Outlet, Drain)	Number	Diam. or Size	Type	Material	Nominal Thickness	Reinforcement Material	How Attached
Inlet	4	3"	Lap Joint	SA 181-1	15/32"	None	Welded
Outlet	1	3"	Lap Joint	SA 181-1	15/32"	None	Welded

20. Inspection Openings: 1 Size 17-3/4" dia. Location on top head
 Manholes No. _____ Size _____ Location _____
 Handholes No. 0 Size _____ Location _____
 Threaded No. 0 Size _____ Location _____


21. Supports: Skirt Yes Lugs 2 lifting Legs 6-3" pipe Other 2 guiding lugs
 (Yes or no) (No) (No) (Describe)
 Attached Welded on heads.
 (Where and how)

22. Remarks: Glass lined steel vessel for chemical use.

93688



NATIONAL BOARD			
	NAME OF NO.	1654	
	NAME OF MEMBER	DE DIETRICH - ZII SWILLER	
	INT. MEASUREMENT	40 / FV	400
W	JKT. MEASUREMENT		
RI 3	JKT. MEASUREMENT		
HT	MFR'S NO.	30971	YEAR BUILT 1978
	INSPECTED BY	R I C	
CLASS	3008	NOM. CAP.	4000 U.S. GALS
DEM. NO.			
TANK SH. THK. $35/64$ " TOP HD. THK. $35/64$ " BOT. HD. THK. $35/64$ " HD. ICR. $102 3/8$ "			
JKT. SH. THK. JKT. HD. THK. JKT. HD. ICR.			
	MFG. BY DE DIETRICH & CIE-FRANCE		
	DIST. BY DE DIETRICH (U.S.A.), INC.		
UNION, N.J. U.S.A.			

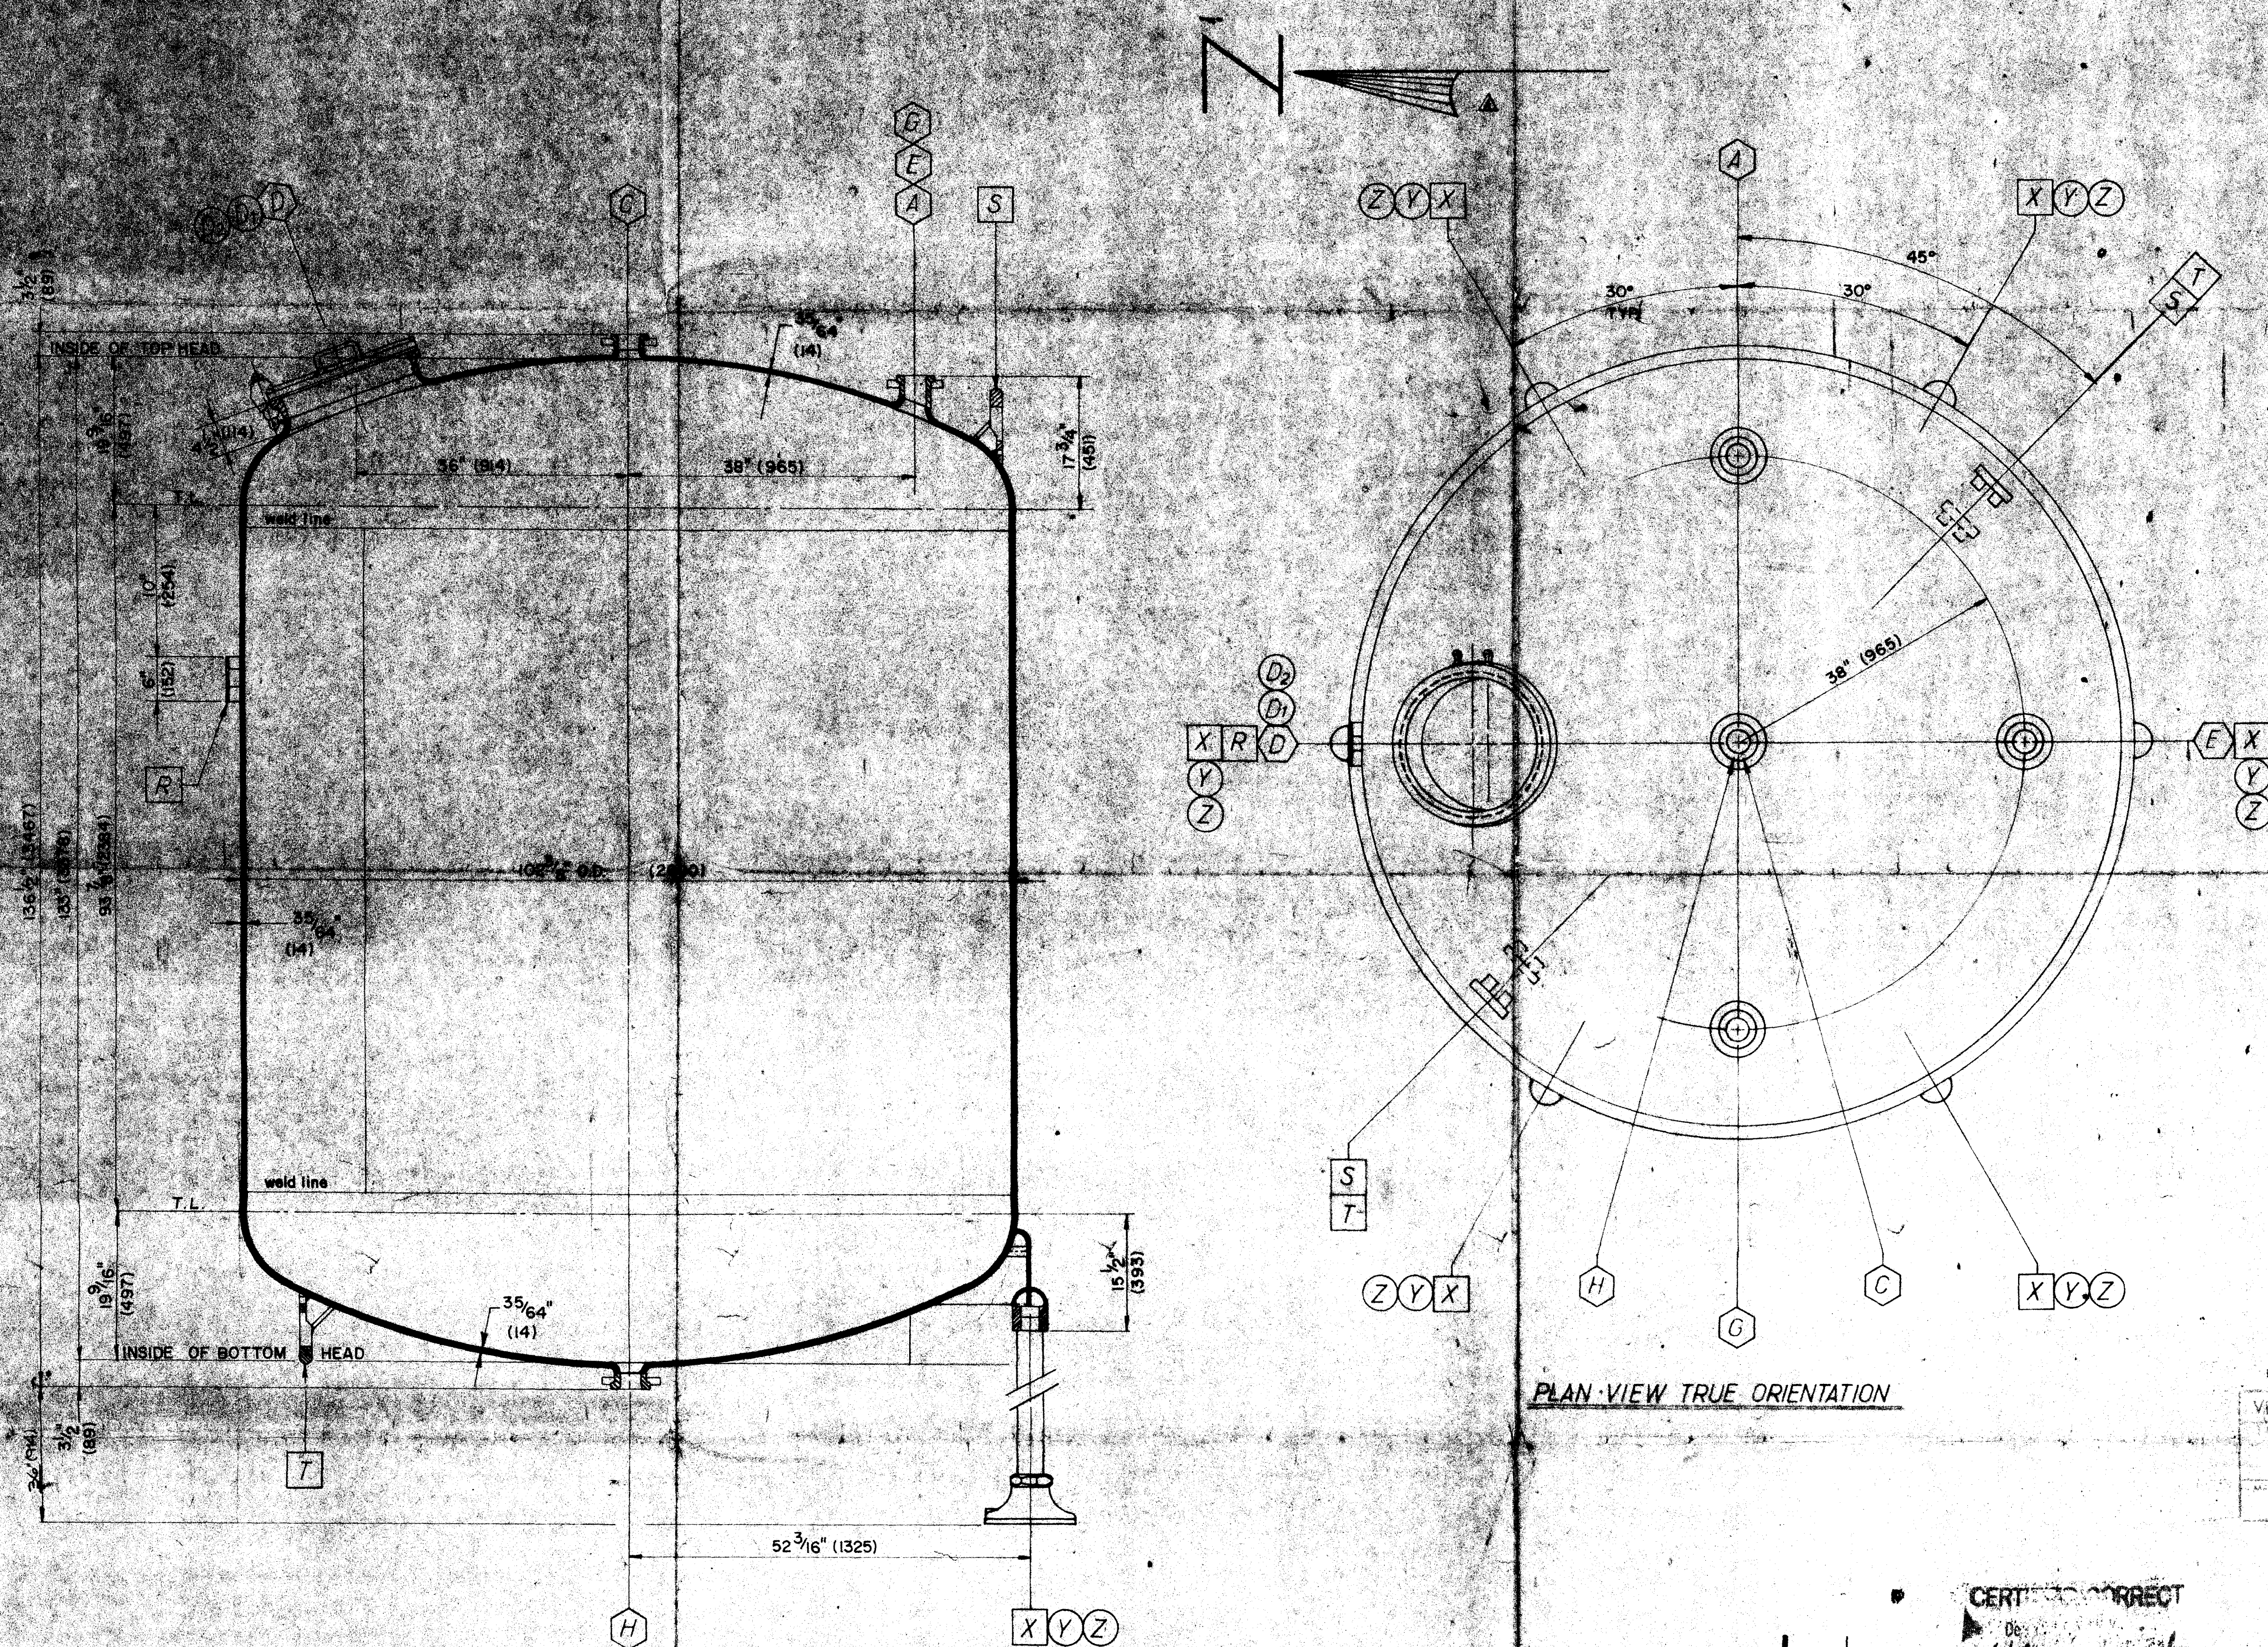

MARK	SIZE	SERVICE	MARK	SIZE	SERVICE
ATTACHMENTS			NOZZLE SCHEDULE		
			D	18"	MANWAY W/PLAIN HINGED COVER
			C	3"	N2 INLET
			E	3"	EXHAUST / VACUUM BREAKER
R	-	NAMEPLATE SUPPORT BRACKET	A	3"	PROCESS INLET / MTL. COMM.
S	-	(2) LIFTING LUGS TOP HEAD	G	3"	CONSERVATION VENT
T	-	(2) GUIDING LUGS BOTTOM HEAD	H	3"	BOTTOM OUTLET
ACCESSORIES			GENERAL NOTES		
X	3"	(6) LEG CPLG.	1. BOLT CIRCLE & O.D. OF ALL SPLIT LOOSE FLANGES IN ACCORDANCE WITH ANSI B16.5 SERIES 150 LBS. EXCEPT AS NOTED. ALL DIMENSIONS ARE STEEL TO STEEL, AND ARE NOMINAL DUE TO HIGH TEMP. FIRING. 2. DESIGNED AND CONSTRUCTED IN ACCORDANCE WITH ASME CODE, SEC VIII, DIV. I, LATEST ADDENDA. 3. ELECTROSTATIC TESTS 15,000 VOLTS AT FACTORY, 6000 VOLTS IN FIELD. 4. ALL NOZZLES SUPPLIED WITH SPLIT LOOSE FLANGE, EXCEPT WHERE NOTED.		
D1	18"	PLAIN ROUND HINGED COVER			
D2	76"	(18) CLAMPS W/RETAINING RING			
Y	3"	(6) PIPE LEGS (SCH. 40)			
Z	3"	(6) ADJUSTABLE FEET PER DWG. P-390B & P-391A			

MATERIALS OF CONSTRUCTION	
VESSEL-SHELL & HEADS	SA 285 B
MANHOLE COVER	SA 285 B
NOZZLES	SA 181-1
FLANGES	SA 181-1 OR SA 315-60
BACK UP FLANGES	SA 105
CLAMPS	SA 449
GASKETS	TFE ENVELOPE W/ASBESTOS
GLASS	CORRUGATED METAL INSERTS, NO. 3008, BLUE, ACID/ALKALI/THERMAL SHOCK RESISTANT
PLUGS	(IF REQUIRED) W/ALUMINUM / TFE / FURAN RESIN
PAINT	PRIMER: ZINC-RICH EPOXY BOUND FINISH: WHITE EPOXY ENAMEL
LIFTING LUGS	SA 285 B
BOLTS (when req'd)	SA 193-B7
NUTS	SA 325 OR SA 194-2H

SPECIFICATIONS	
DESIGN PRESSURE	40 psig or 2.75 bars
TEST PRESSURE	44 psig 3.03 bars
DESIGN TEMPERATURE	400°F 204°C
CORROSION ALLOW.	NONE
RADIOGRAPH (longitudinal) (circumferential)	SPOT & PARTIAL
HEAT TREATMENT	YES
ASME STAMP & N.B. REG.	YES
VOL- EACH HEAD	
VOL- PER' INCH ST. SIDE	
VOL-TOTAL	4152 gal 15,716 L.
WEIGHT- EMPTY	8700# 3,947 kg.
WEIGHT- FLOODED W/H ₂ O	43,430# 19,703 kg.
WEIGHT- SHIPPING	

RELEASED FOR CONSTRUCTION

VENDOR: *De Dietrich* PRINT: *S. & B. FILE* 103-14
 DATE: *9/25/79* 2A

CERT. CORRECT

REV	DESCRIPTION	ENGR.	DATE	BY
A	REV. PER. CUST. MARKED UP DWG. 8-15-79	WK	9-12-79	LJ

NOTICE: THESE PAPERS CONTAIN CONFIDENTIAL MATTERS WHICH ARE THE EXCLUSIVE PROPERTY OF De Dietrich (USA), Inc. NO EXTRACTS THEREFROM OR ANY USE OR DISCLOSURE THEREOF MAY BE MADE EXCEPT UPON PROPER AUTHORIZATION IN WRITING AND FOR THE SOLE BENEFIT OF THE CORPORATION.

De Dietrich (USA), Inc.
 U.S. ROUTE 22 • UNION, NEW JERSEY

93688

VT-4000 GALLON GLASTOR® STORAGE TANK

CUSTOMER: *FMC CORP*
 P.O.# *C-454-4001* BALTIMORE, MD.

ENGINEERS: *SINGMASTER & BREYER INC.* NY, NY.

CUST. REF. DWG. / SPEC. NO.	QUANTITY (1) <i>ONE</i>
INT. DATE	DDZ. SO*
DDZ. PO*	TAG NO(S) <i>T-300</i>
APPROVED	DDZ. DWG.
RELEASED	SCALE

DWG. NO. *D-3530*