

FORM U-1 MANUFACTURERS' DATA REPORT FOR PRESSURE VESSELS
As Required by the Provisions of the ASME Code Rules, Section VIII, Division 1

93699

1. Manufactured by De Districh & Cie, 1 rue d'Offwiller, 67110 Zinswiller, France
(Name and address of manufacturer)

2. Manufacturer for Singmaster & Breyer, Inc. New York, New York
(Name and address of purchaser)

3. Location of installation FMC Corp. Baltimore, Maryland
(Name and address)

4. Type Vertical Vessel No. 31756 N/A VT 2600-027A 2367 Year Built 1980
(Horiz. or vert. tank) (Mfg's Serial No.) (CRN) (Drawing) (Nat'l Brd No.)

5. The chemical and physical properties of all parts meet the requirements of material specifications of the ASME BOILER AND PRESSURE VESSEL CODE. The design, construction, and workmanship conform to ASME Rules, Section VIII, Division 1 1977 and Addenda to Summer 78 and Code Case no. N/A Special service per UG-120(d) N/A
(Date) (Year)

Manufacturers' Partial Data Reports properly identified and signed by Commissioned Inspectors have been furnished for the following items of the report: N/A
(Name of part, item number, mfg'r's name and identifying stamp)

Items 6-11 incl. to be completed for single walled vessels, jackets of jacketed vessels, or shells of heat exchangers.

6. Shell: Material SA285B Nominal Thickness 35/64 in. Corrosion Allowance N/A in. Diam. 8 6-3/8 in. Length 7 4-11/32 in.
(Spec. No., Grade) (Material, Spec. No., Gr., Size, No.)

7. Seams: Longitudinal Welded, Dbl. Butt R.T. Spot Efficiency 85 % H.T. Temp * F
(Welded, Dbl., Sngl., Lap, Butt) (Spot or Full)

Time * Girth Welded, Dbl. Butt R.T. Partial No. of Courses 1
(Welded Dbl., Dngl., Lap, Butt) (Spot, Partial or Full)

8. Heads: (a) Material SA 285 B (b) Material SA 285 B
(Spec. No., Grade) (Spec. No., Grade)

	Location (Top, Bottom, Ends)	Minimum Thickness	Corrosion Allowance	Crown Radius	Knuckle Radius	Elliptical Ratio
(a)	<u>Top</u>	<u>35/64"</u>	<u>102-3/8"</u>	<u>10-15/64"</u>	<u>N/A</u>	<u>N/A</u>
(b)	<u>Bottom</u>	<u>35/64"</u>	<u>102-3/8"</u>	<u>10-15/64"</u>	<u>N/A</u>	<u>N/A</u>
	Conical Apex Angle	Hemispherical Radius	Flat Diameter	Side to Pressure (Convex or Concave)		
(a)	<u>N/A</u>	<u>N/A</u>	<u>N/A</u>	<u>Concave</u>		
(b)	<u>N/A</u>	<u>N/A</u>	<u>N/A</u>	<u>Concave</u>		

If removable, bolts used (describe other fastenings) N/A
(Material, Spec. No., Gr., Size, No.)

9. Type of Jacket N/A Proof Test N/A

10. Jacket Closure N/A If bar, give dimensions N/A If bolted, describe or sketch.

11. Constructed for max. allowable working pressure 40 & F.V. psi at max. temp. 400° F Min. temp. (when less than -20 F) N/A F.
Hydrostatic, pneumatic, or combination test pressure 44 psi

Items 12 and 13 to be completed for tube sections

12. Tubesheets: Stationary—Material N/A Diam. N/A in. Nominal Thickness N/A in. Corrosion Allowance N/A in. Attachment N/A Floating—Material N/A Diam. N/A in. Attachment N/A
(Spec. No., Gr.) (Subject to pressure) (Spec. No., Grade)

13. Tubes: Material N/A O.D. N/A in. Nominal Thickness N/A in. or gauge Number N/A Type N/A
(Spec. No., Gr.) (Straight or "U")

Items 14-17 incl. to be completed for inner chambers of jacketed vessels or channels of heat exchangers.

14. Shell: Material N/A Nominal Thickness N/A in. Corrosion Allowance N/A in. Diam. N/A ft N/A in. Length N/A ft N/A in.
(Spec. No., Gr.)

15. Seams: Longitudinal N/A R.T. N/A Efficiency N/A % H.T. Temp N/A F Time N/A
(Welded, Dbl., Sngl. Lap, Butt) (Spot or Full)

Girth N/A R.T. N/A No. of courses N/A
(Welded, Dbl., Sngl., Lap, Butt) (Spot, Partial, or Full)

16. Heads: (a) Material N/A (b) Material N/A
(Spec. No., Grade) (Spec. No., Gr.)

	Location (Top, Bottom, Ends)	Minimum Thickness	Corrosion Allowance	Crown Radius	Knuckle Radius	Elliptical Ratio
(a)						
(b)						
	Conical Apex Angle	Hemispherical Radius	Flat Diameter	Side to Pressure (Convex or Concave)		
(a)						
(b)						

If removable, bolts used (describe other fastenings) N/A
(Material, Spec. No., Gr., Size, No.)

17. Constructed for max. allowable working pressure N/A psi at max temp. _____ F. Min. temp. (when less than -20 F) _____ F.

Hydrostatic, pneumatic, or combination test pressure _____ psi.

Items below to be completed for all vessels where applicable

18. Safety Valve Outlets: Number N/A Size _____ Location _____

19. Nozzles:

93699

Purpose (Inlet, Outlet, Drain)	Number	Diam. or Size	Type	Material	Nominal Thickness	Reinforcement Material	How Attached
Inlet	1	6" Db1	Butt Girth	SA 181-1	15/32"	None	Welded
Inlet	5	3" Db1	Butt Girth	SA 181-1	15/32"	None	Welded
Outlet	1	4" Db1	Butt Girth	SA 181-1	15/32"	None	Welded

20. Inspection Openings:

Manholes No. 1 Size 17-3/4" dia. Location on top head

Handholes No. 0 Size _____ Location _____

Threaded No. 0 Size _____ Location _____

21. Supports: Skirt Yes Lugs 2 lifting 6-3" pipe 2 insulation rings + 2 guiding lugs Attached Welded on heads
 (Yes or no) (No.) (No.) (Describe) (Where and how)

22. Remarks: *Vessel H.T. at high temperature for extended period of time due to glass lining process. Glass lined steel vessel for chemical use.

CERTIFICATE OF COMPLIANCE

We certify that the statements made in this report are correct and that all details of design, material, construction, and workmanship of this vessel conform to the ASME Code for Pressure Vessels, Section VIII, Division 1.

Date Feb. 14, 80 Signed De Dietrich & Cie by WAGNER R. B. C. MER.
 (Manufacturer) (Representative)

"U" Certificate of Authorization No. 11718 expires April 16 19 80.

CERTIFICATE OF SHOP INSPECTION

Vessel made by De Dietrich & Cie at Zinswiller, France
 I, the undersigned, holding a valid commission issued by the National Board of Boiler and Pressure Vessel Inspectors and/or the State or Province of Ohio and employed by The Royal Indemnity Company of New York, N.Y. have inspected the pressure vessel described in this Manufacturers' Data Report on Feb. 11 1980 and state that, to the best of my knowledge and belief, the Manufacturer has constructed this pressure vessel in accordance with ASME Code, Section VIII, Division 1.

By signing this certificate neither the inspector nor his employer makes any warranty, expressed or implied, concerning the pressure vessel described in the Manufacturers' Data Report. Furthermore, neither the Inspector nor his employer shall be liable in any manner for any personal injury or property damage or a loss of any kind arising from or connected with this inspection.

Date 25 Feb, 1980
 Signed S.G. AKERMAN Commissions N.B. 8074
 (Inspector) (Nat'l Board, State, Province and No.)

CERTIFICATE OF COMPLIANCE FOR FIELD WORK

We certify that the statements made in this report are correct and that all details of design, material, construction, and workmanship of this vessel conform to the ASME Code for Pressure Vessels, Section VIII, Division 1.

Date _____ Signed _____ by _____
 (Manufacturer) (Representative)

"U" Certificate of Authorization No. _____ expires _____, 19 _____.


CERTIFICATE OF FIELD ASSEMBLY INSPECTION

I, the undersigned, holding a valid commission issued by the National Board of Boiler and Pressure Vessel Inspectors and/or the State or Province of _____ and employed by _____ of _____ have compared the statements in this Manufacturers' Data Report with the described pressure vessel and state that parts referred to as data items _____, not included in the certificate of shop inspection, have been inspected by me and that, to the best of my knowledge and belief, the Manufacturer has constructed and assembled this pressure vessel in accordance with ASME Code, Section VIII, Division 1.

The described vessel was inspected and subjected to a hydrostatic test of _____ psi.

By signing this certificate neither the Inspector nor his employer makes any warranty, expressed or implied, concerning the pressure vessel described in this Manufacturers' Data Report. Furthermore, neither the Inspector nor his employer shall be liable in any manner for any personal injury or property damage or a loss of any kind arising from or connected with this inspection.

Date _____
 Signed _____ Commissions _____
 (Authorized Inspector) (Nat'l Board, State, Province and No.)

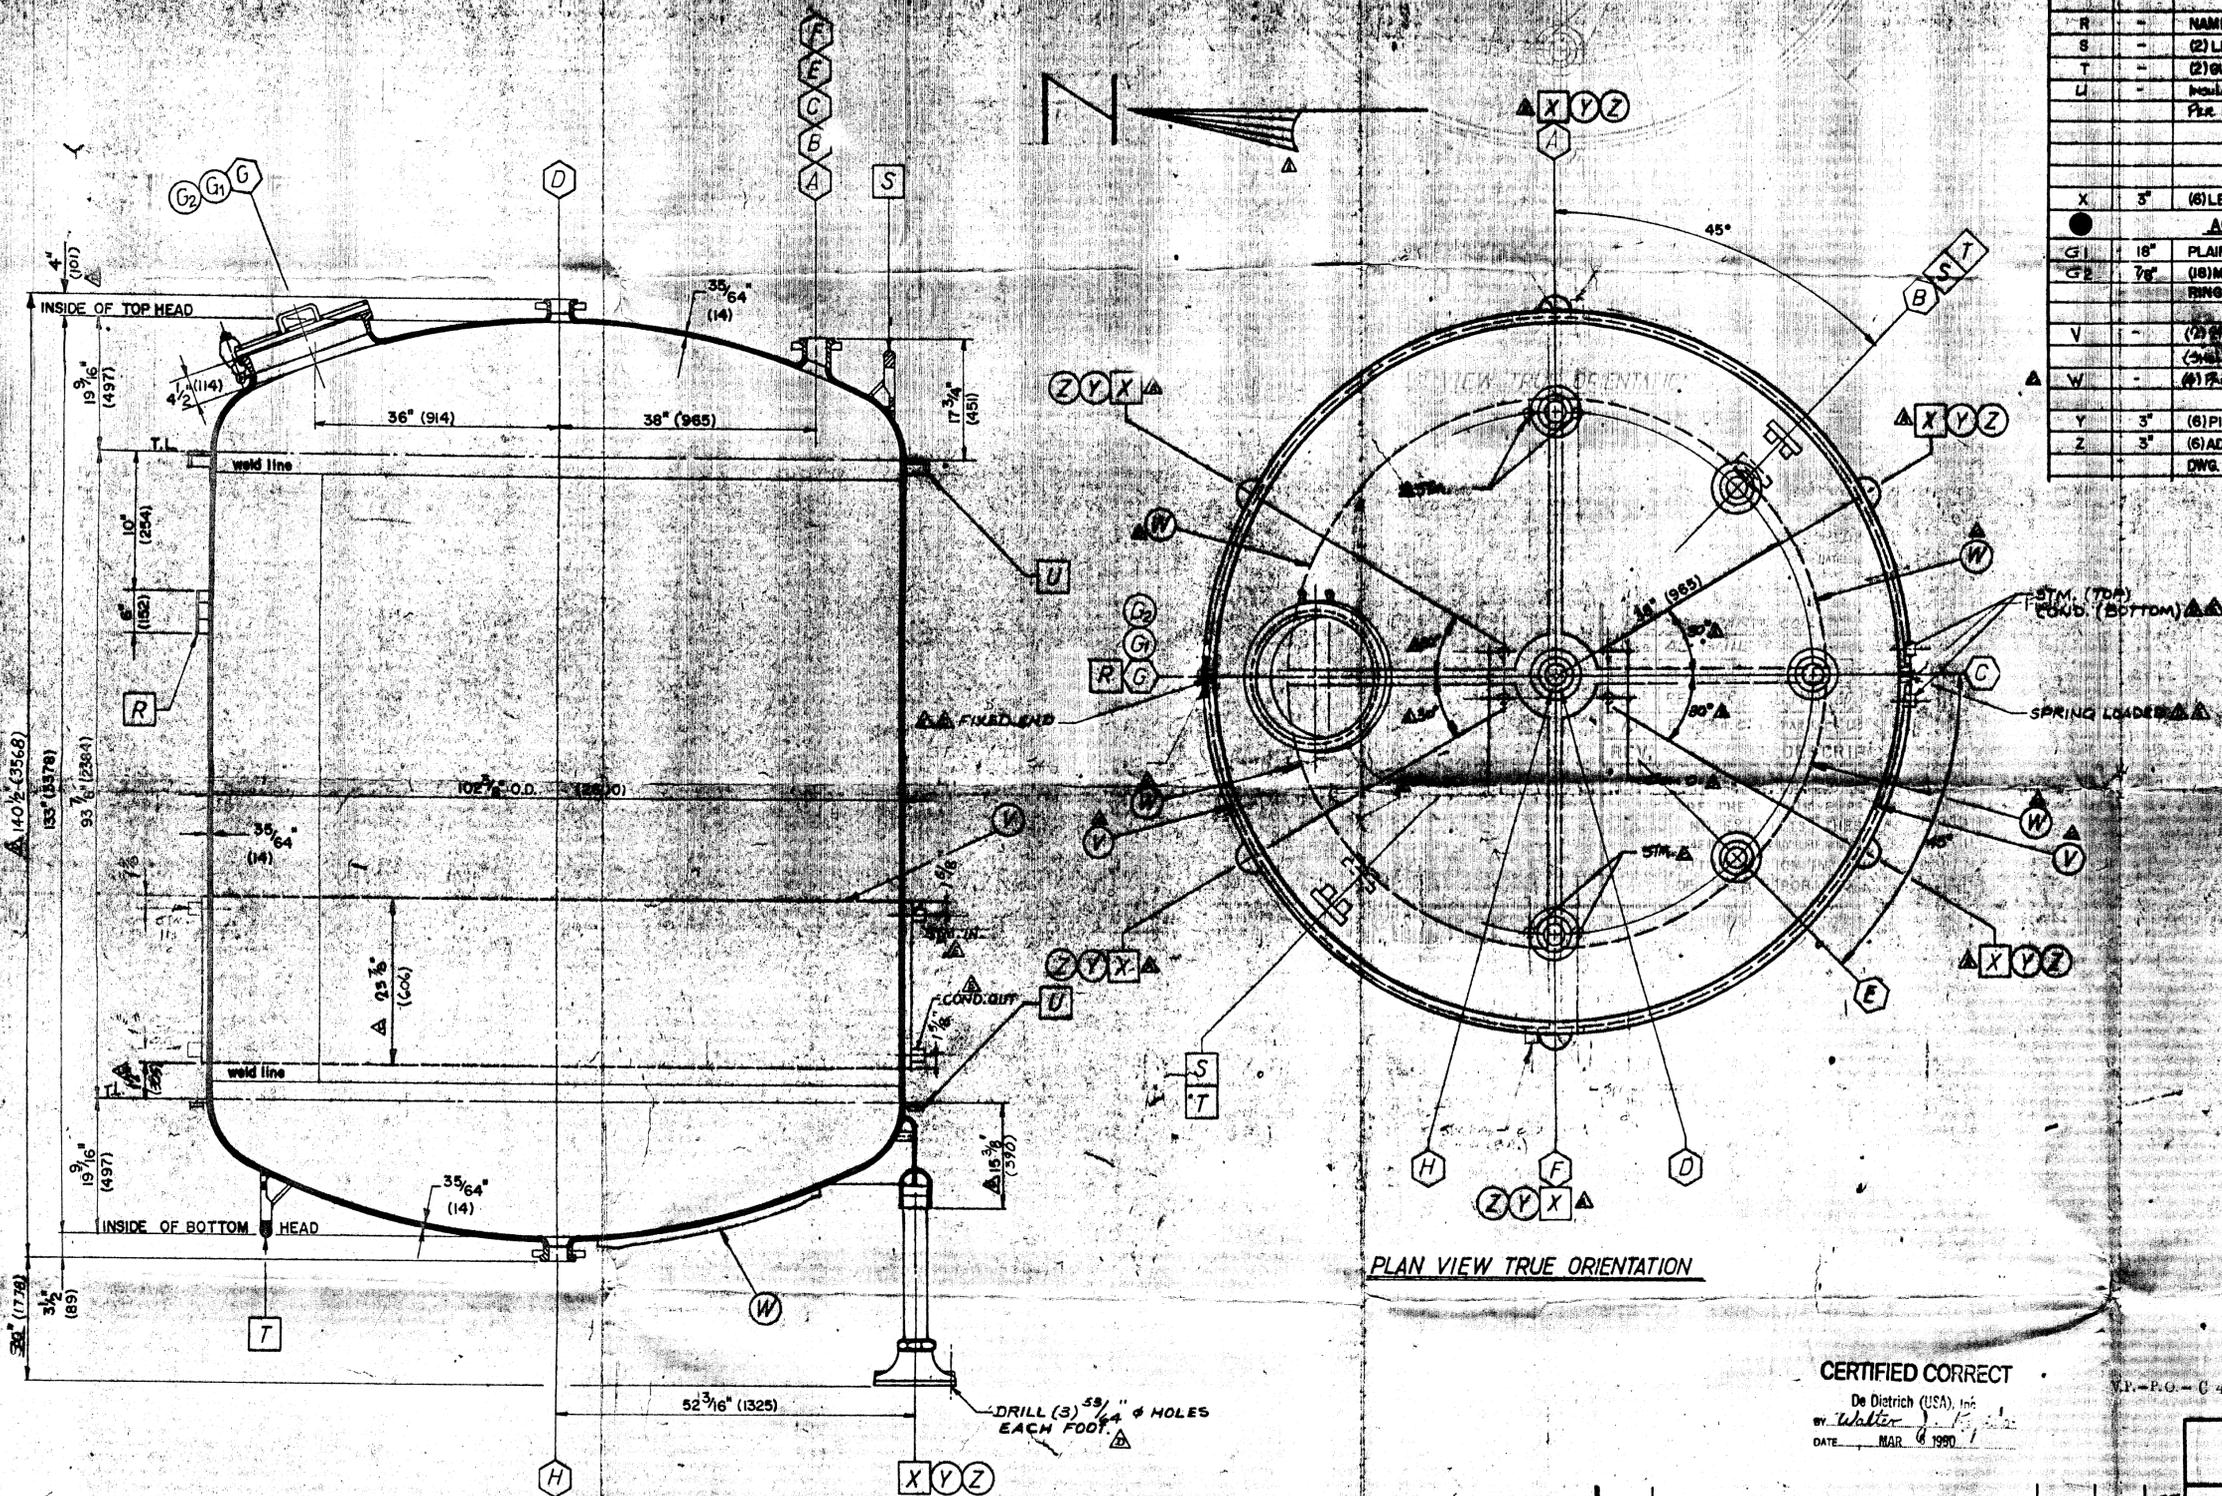

ATTACHMENTS		SCHEDULE	
C	PLAIN ROUND HINGED COVER		
D	(8) 18" CLAMPS W/RETAINING RING		
E	(2) LIFTING LUGS TOP HEAD		
F	(2) GUIDING LUGS BOTTOM HEAD		
G	(6) PIPE LEGS		
H	(6) ADJUSTABLE FEET PER DWG. PI-390B & PI-391A		
ACCESSORIES			
X	(6) LEG CPLG.		
GENERAL NOTES			
1- BOLT CIRCLE & O.D. OF ALL SPLIT LOOSE FLANGES IN ACCORDANCE WITH ANSI B16.5 SERIES 150 LBS. EXCEPT AS NOTED. ALL DIMENSIONS ARE STEEL TO STEEL AND ARE NOMINAL DUE TO HIGH TEMP. FIRING.			
2- DESIGNED AND CONSTRUCTED IN ACCORDANCE WITH ASME CODE, SEC VIII, DIV. 1, LATEST ADDENDA.			
3- ELECTROSTATIC TESTS 15,000 VOLTS AT FACTORY, 6000 VOLTS IN FIELD.			
4- ALL NOZZLES SUPPLIED WITH SPLIT LOOSE FLANGE, EXCEPT WHERE NOTED.			

MATERIALS OF CONSTRUCTION	
VESSEL - SHELL & HEADS	SA 285 B
MANHOLE COVER	SA 285B
NOZZLES	SA 181-1
FLANGES	SA 181-1 OR SA 181-10
BACK UP FLANGES	SA 105
CLAMPS	SA 449
GASKETS	TPE ENVELOPE W/ASBESTOS/CORRUGATED METAL INSERTS.
GLASS	NO. 3006, BLUE, ACID/ALKALI/THERMAL SHOCK RESISTANT.
PLUGS	(IF REQUIRED) TANTALUM/TPE/PURAN RESIN.
PAINT	PRIMER: ZINC-RICH EPOXY BOUND. FINISH: WHITe EPOXY ENAMEL.
LIFTING LUGS	SA 285 B
BOLTS (where applicable)	SA 192-17
NUTS	SA 325 OR SA 192-17

SPECIFICATIONS		
DESIGN PRESSURE	40 psig or 2.75 bars	
TEST PRESSURE	44 psig 3.03 bars	
DESIGN TEMPERATURE	400°F 204°C	
CORROSION ALLOW.	NONE	
RADIOGRAPH (longitudinal/circumferential)	SPOT & PARTIAL	
HEAT TREATMENT	YES	
ASME STAMP & N.S. REG.	YES	
VOL. EACH HEAD		
VOL. PER INCH ST. SIDE		
VOL. TOTAL	452 gal 15,716 L	
WEIGHT-EMPTY	8700 3,947 kg	
WEIGHT - FLOODED W/H ₂ O	43,430 19,703 kg	
WEIGHT - SHIPPING		

PLAN VIEW TRUE ORIENTATION

CERTIFIED CORRECT
De Dietrich (USA), Inc.
Walter
DATE MAR 6 1990

P.P.O. - C 454 4001 1D

De Dietrich (USA), Inc. #93699
U.S. ROUTE 22 • UNION, NEW JERSEY

REV	DESCRIPTION	ENGR.	DATE	BY
E	REV. PANEL COILS	WK	3-6-80	4F
D	AS BUILT	WJK	3-2-80	CN
C	REV. PANEL COILS	WK	12-17-79	1B
B	REV. PER CUST. MARKED UP DWG. 9-23-79	WJK	10-23-79	CN
A	REV. PER CUST. MARKED UP DWG. 8-28-79	WK	9-12-79	1B

VT-4000 GALLON GLASTOR® STORAGE TANK			
CUSTOMER: FMC CORP		BALTIMORE, MD.	
P.O. #0454001			
ENGINEERS: SINGMASTER & BREYER, INC.		NY, NY.	
CUST. REF. DWG. / SPEC. NO.		QUANTITY (1) ONE	
INT. DATE	DDZ SO	421-722	TAG NO(S) T-354
DWG BY	DDUS A	5209-5F	
APPROVED	DDZ DWG	VT2800-027	DWG. NO. D-3529
RELEASED	SCALE		

NOTICE: THESE PAPERS CONTAIN CONFIDENTIAL MATTERS WHICH ARE THE EXCLUSIVE PROPERTY OF De Dietrich (USA), Inc. NO EXTRACTS THEREFROM OR ANY USE OR DISCLOSURE THEREOF MAY BE MADE EXCEPT UPON PROPER AUTHORIZATION IN WRITING AND FOR THE SOLE BENEFIT OF THE CORPORATION.