

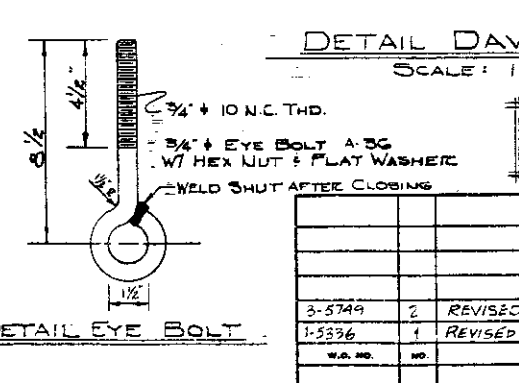
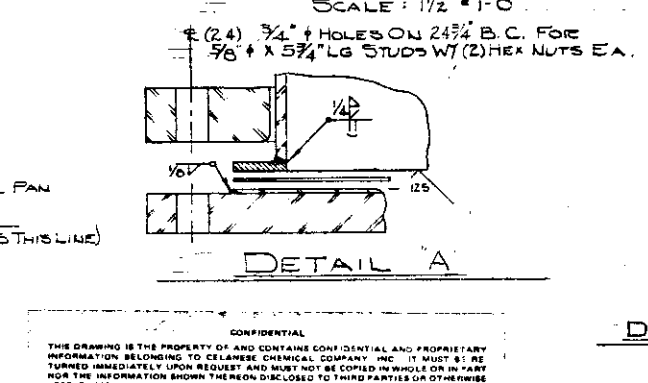
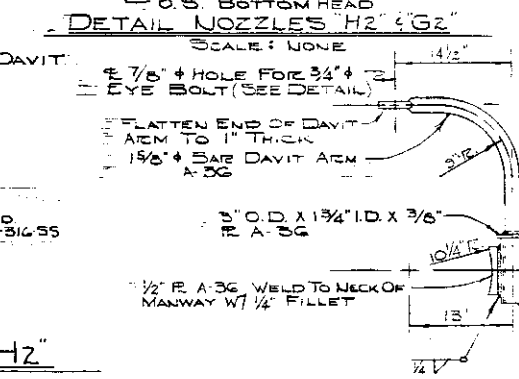
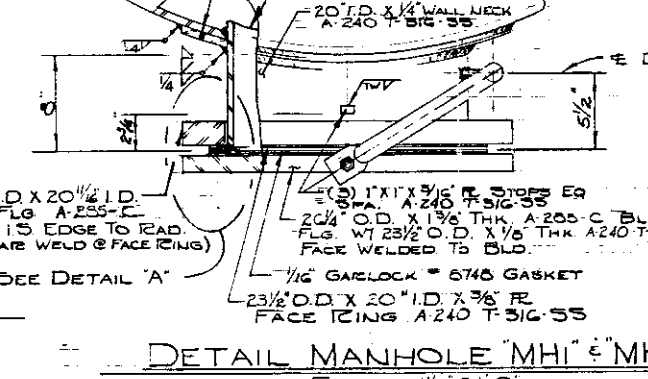
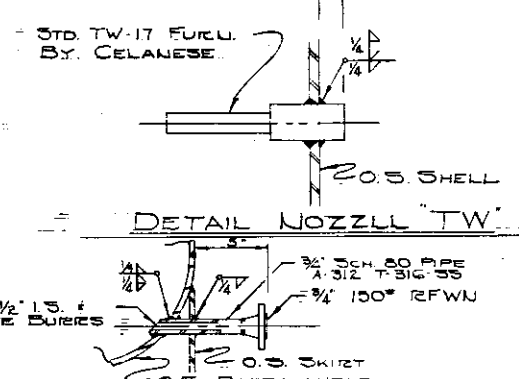
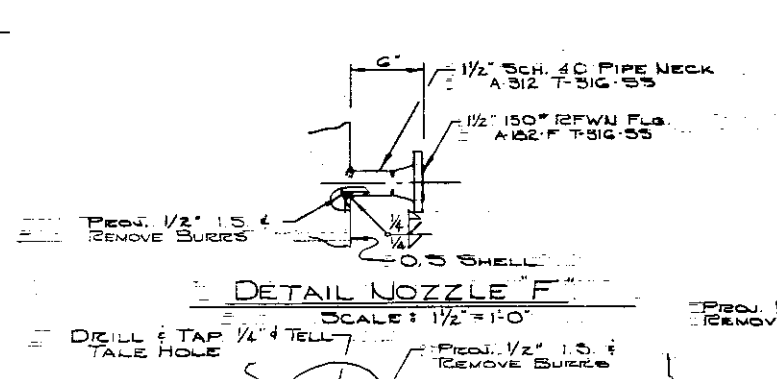
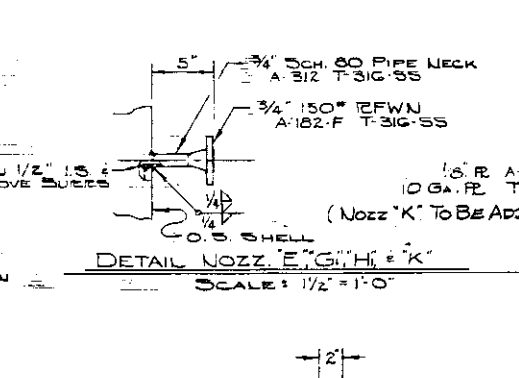
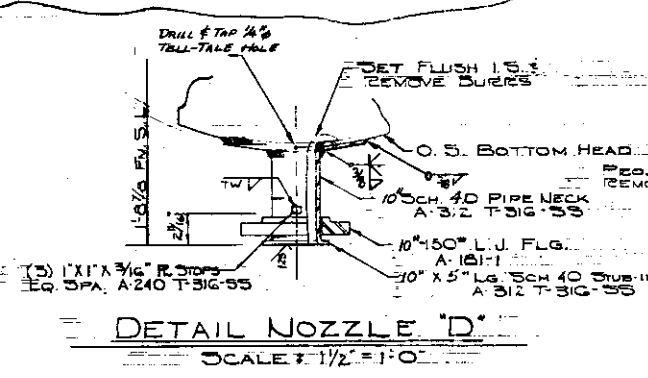
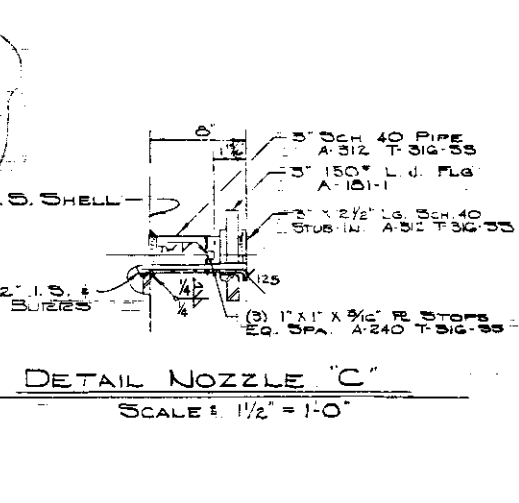
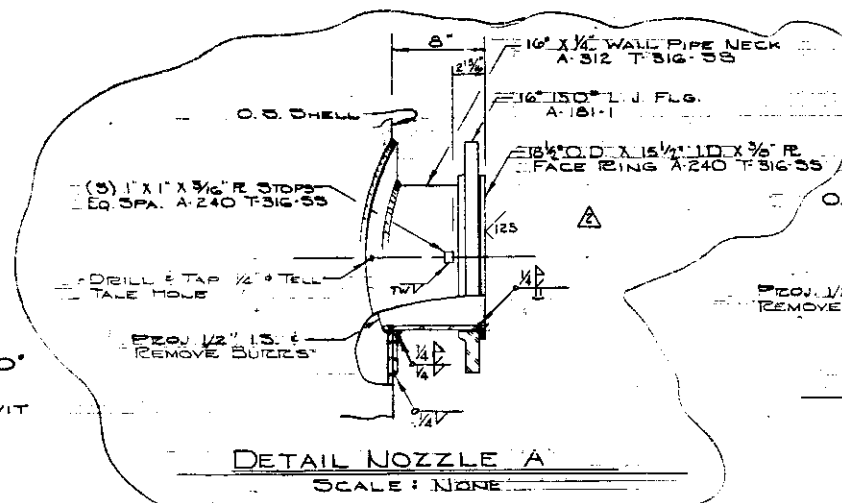


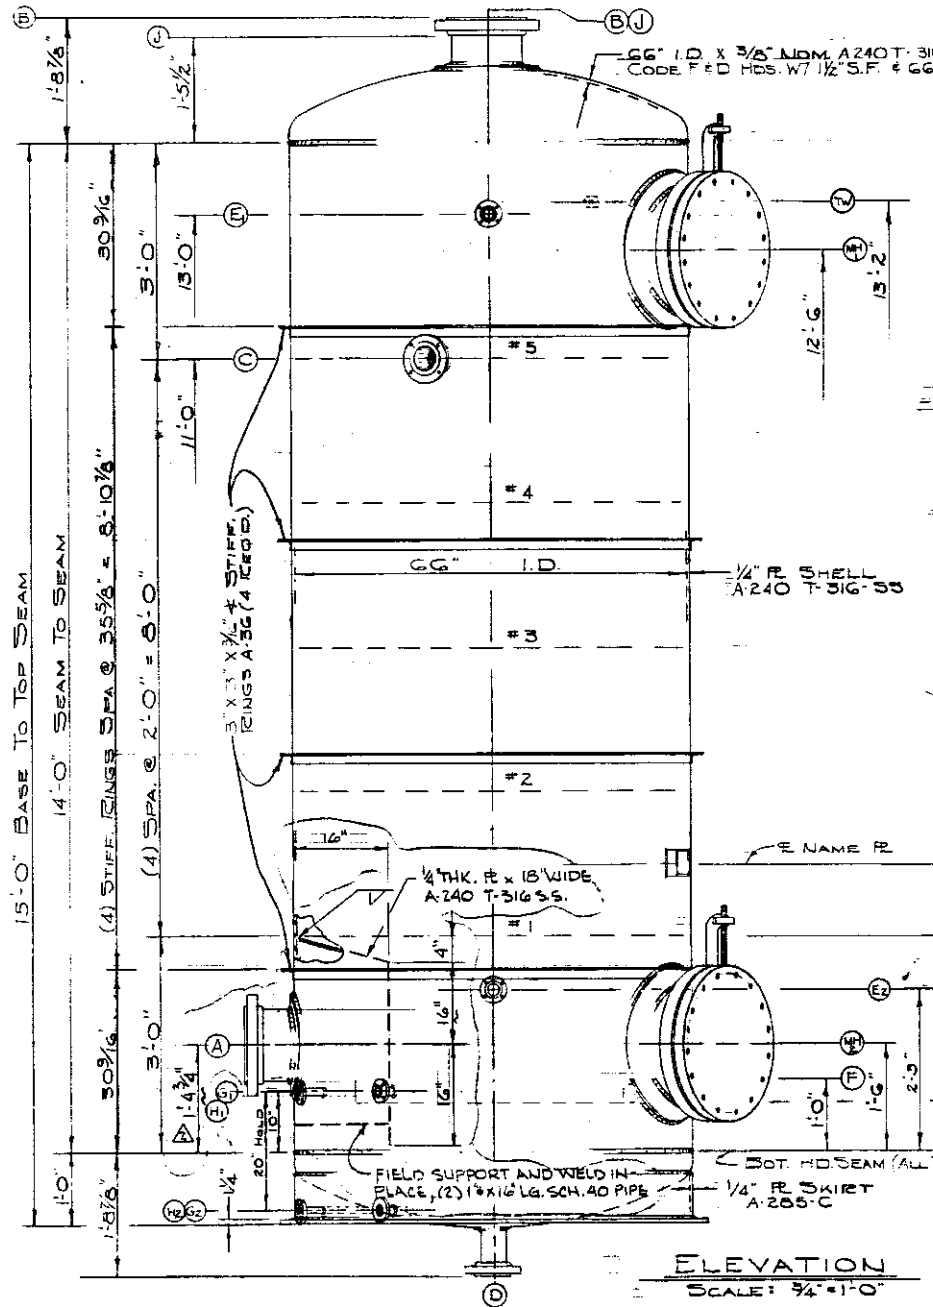

CONNECTION SCHEDULE																	
V	N	O	FLANGE			NECK		REIN. PAD			PROJ.		SERVICE				
			DATE	TYPE	MATL	THK	MATL	OD	ID	THK	MATL	N	OUT	REMARKS			
A	1	16"	150"	L.J.	A-181H	1/4"	A-312 T-36-55	2 1/2"	16 1/8"	3/8"	A-285C	1/2"	8"	FEED			
B	1	12"	"	"	"	1/4"	"	2 1/2"	12 1/8"	3/8"	A-285C	1/2"	8"	VAPOUR OUTLET			
C	1	3"	"	"	"	SCH 40	"	"	"	"	"	1/2"	8"	REFLUX			
D	1	10"	"	L.J.	"	SCH 40	"	19"	10 1/8"	1/2"	A-285C	3/4"	8"	RESIDUE			
E	2	1/4"	"	RFWN	A-181-F T-36-55	SCH 80	"	"	"	"	"	1/2"	5"	PRESSURE TAPS			
F	1	1/2"	"	"	"	SCH 40	"	"	"	"	"	"	6"	CORROSION PROBE			
G	1	3/4"	"	"	"	SCH 80	"	"	"	"	"	"	5"	SIGHT GLASS			
G	2	3/4"	"	"	"	"	"	"	"	"	"	"	"	SIGHT GLASS			
H	1	3/4"	"	"	"	"	"	"	"	"	"	"	"	LIC			
H	2	3/4"	150"	RFWN	A-181-F T-36-55	SCH 80	A-312 T-36-55	"	"	"	"	1/2"	5"	LIC			
J	1	4"	150"	LJ	A-181-H	SCH 40	A-312 T-36-55	8"	4 3/8"	3/8"	A-285C	1/2"	8"	PSV			
TW	1	"	"	STD TW-IT	T-36-55	"	"	"	"	"	"	"	2"	FURNISHED BY CELENGESE			
MH	1	20"	"	FAB	A-285C	1/4"	A-240 T-36-55	28 1/2"	20 3/8"	1/4"	A-285C	1/2"	8"	MANHOLE W/ BLD. & DAVIT			
MH	2	20"	"	FAB	A-285C	1/4"	A-240 T-36-55	28 1/2"	20 3/8"	1/4"	A-285C	1/2"	8"	MANHOLE W/ BLD. & DAVIT			
K1	1	3/4"	150"	RFWN	A-181-F T-36-55	SCH 80	A-312 T-36-55	"	"	"	"	1/2"	"	SAMPLE TAPS			
K2	1	3/4"	150"	RFWN	A-181-F T-36-55	SCH 80	A-312 T-36-55	"	"	"	"	1/2"	"	SAMPLE TAPS			
														TO BE ADDED LATER			

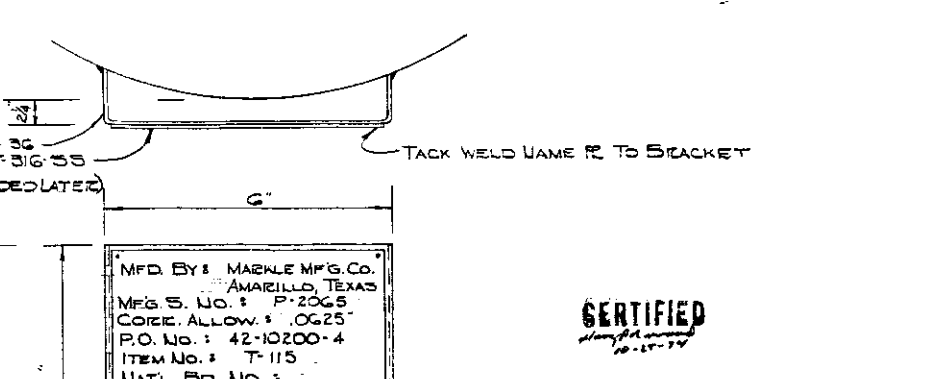

DESIGN DATA

A. ASME CODE FOR UNIFIED PRESS. VESSEL
SEC. VIII 1974 EDITION DIV. I

B. ADDITIONAL SPECS. : CELEBASE VENDORE
REQUIREMENTS

C. CODE SYMBOL TO BE APPLIED : YES

D. DESIGN PRESS. : FULL PSIG @ 400°

E. DESIGN TEMP. : 350° F. @ 200°

F. CORR. ALLOW. : 0.025

G. TYPE OF HEADS : CODE F & D

H. STEELS RELIEF REQ'D. : NO

I. RADIO GRAPH REQ'D. : SPOT PER CODE

J. JOINT EFFICIENCY : SHELL 85% HEAD 100%

K. MAX ALLOW WORKING PRESS. BEFORE COR ALLOW
90 PSIG LIMITED BY HEADS

NOTE COR. : 17.7 PSI LIMITED BY HEADS

L. HYDROSTATIC TEST PRESS. : 144 PSI

M. HAMMER TEST : NONE

N. WEIGHT EMPTY : 11,952 LBS.

O. WEIGHT FULL OF WATER : 35,628 LBS.

P. WEIGHT W/HD. FLUID : 30,225 LBS.

MATERIAL SPECIFICATIONS

- A. SHELL : ASTM A-240 T-316-SS
- B. HEADS : ASTM A-307 T-316-SS
- C. ANGLES : ASTM A-182 F T-316-SS A-181-1A285
- D. NOZZ. NECK : ASTM A-312 T-316-SS A-182A20 T-304
- E. NOZZ. TEEING : ASTM A-285-C
- F. PRESS. BOLTING : STUDS ASTM A-193-B7
NUTS ASTM A-194-2H
- G. INTERNALS : ASTM A-240 T-316-SS A-194-2H
- H. STRUCTURAL SUPPLIES : ASTM A-36 A-285
- I. STIFFENING : ASTM A-36
- J. GASKETS 1/16" GASKET # 6748
- K. PAINT : SANDBLAST & SPRAY ONE COAT
RED LEAD PRIMER @ C. S. ONLY
- L. WELD ELECT. : SS TO SS 3/32" ASTM E-317
CS TO SS 3/32" ASTM E-310

GENERAL NOTES

- A. ALL BOLT HOLES TO STREADLE NOTEM &
- B. PROTECT ALL MACH. SURFACES & THREADED
- C. COLL. WITH RUST PREVENTIVE
- D. VESSE. SHALL BE DRAINED, CLEANED, & ALL
- E. OPENINGS COVERED BEFORE SHIPPING
- F. ALL FLAG. SHALL BE ASA STD. EXCEPT MANHOLE

CELANESE P.O. No. 42-10200-4 FORM P-650 REV. 4-66			
CELANESE CHEMICAL COMPANY		A DIVISION OF CELANESE CORPORATION	
PAMPA ENGINEERING DEPT			
AREA XV 66" I.D. X 14'-0"		MEACA UNIT SEAM-SEAM	
VERTICAL TOWER PLAN & ELEVATION			
DRAWING NO.		SCALE	
DATE 8-1-74		DATE 9-4-74	
BY 801		AS	
APP. BY 547		DATE 2-28-75	
DATE		SHOWN	
WT-11187-2			

495560

CONFIDENTIAL

THIS DRAWING IS THE PROPERTY OF AND CONTAINS CONFIDENTIAL AND PROPRIETARY INFORMATION BELONGING TO CELANESE CHEMICAL COMPANY INC. IT MUST BE RETURNED IMMEDIATELY UPON REQUEST AND MUST NOT BE COPIED IN WHOLE OR IN PART NOR THE INFORMATION SHOWN THEREON DISCLOSED TO THIRD PARTIES OR OTHERWISE

MARKLE DWG. No.: 74-67-3704-01

MFG. BY MARKLE MFG. CO.

AMARILLO TEXAS

MFG. SER. NO. P-2065

CORR. ALLOW. .0625

P.O. NO. 42-10200-4

ITEM NO. T-115

NAT. BD. NO. 138

MAWP AT 77 P.S.I.G. AT 400°F

FULL VAC. AT 200°F

HYDRO. TEST PRESS. 144 P.S.I.G.



PRI

YEAR BUILT

1975

CELANESE CHEM. CO.

PAMPA TEXAS

95560

FORM U-1A MANUFACTURERS' DATA REPORT FOR PRESSURE VESSELS

Alternate Form For Single Chamber Completely Shop Fabricated Vessels Only

As required by the Provisions of the ASME Code Section VIII — Division I and the National Board

1. Manufactured by Markle Manufacturing Company, Amarillo, Texas
(Name and address of Manufacturer)
2. Manufactured for Celanese Chemical Co., Pampa, Texas
(Name and address of Purchaser)
3. Type Vertical Vessel No. (P-2065) (Mfrs. Serial) (State & Std. No.)
SA-240 T-316 Nat'l Bd. No. 138 Yr. Built 1975
(Horiz. or Vert.) (Thk. - 250) (Corr. - 0625)
4. SHELL: Mat'l T.S. 75,000 in. Allow. 5 ft. 6 in. Length 14 ft. 0 in.
(Kind and Spec. No.) (Flg. or F. B. & Spec. Min. T.S.)
5. SEAMS: Long Dbl. Butt H.T. No R.T. Spot Sectioned No Efficiency 85 %
(Welded, Dbl., Single, Lap, Butt) (Yes or No) (Spot or Complete) (Yes or No)
- Girth Dbl. Butt H.T. No R.T. Spot Sectioned No No. of Courses 3
6. HEADS: (a) Material SA-240-T-316 T.S. 75,000 (b) Material SA-240 T-316 T.S. 75,000

If riveted or brazed describe seams fully under remarks.

Location (Top, bottom, ends)	Thickness	Crown Radius	Knuckle Radius	Elliptical Ratio	Conical Apex angle	Hemispherical Radius	Flat Diameter	Side to Pressure (Convex or Concave)
(a) <u>Top</u>	<u>.375 Nom. 66"</u>	<u>4"</u>	<u>4"</u>					<u>Concave</u>
(b) <u>Bottom</u>	<u>.375 Nom. 66"</u>	<u>4"</u>	<u>4"</u>					<u>Concave</u>

If removable, bolts used _____ Other fastening _____

7. Constructed for max. allowable working press. 77 psi. at max. temp. 400 °F. (Material, Spec. No., T.S., Size, Number) (Describe or Attach Sketch)
Min. temp. (when less than -20°) _____ °F. Hydrostatic Pressure Test Combination Press. 144 psi.
8. SAFETY OR RELIEF VALVE OUTLETS: Number 1 Size 4" Location In top head.

9. NOZZLES:

Purpose, (Inlet Outlet, Drain)	Number	Diam. or Size	Type	Material	Thickness	Reinforcement Material	How Attached
Inlet-Outlet	<u>2</u>	<u>12"</u>	<u>Pipe</u>	<u>SA312-T316</u>	<u>.250</u>	<u>SA-285-C</u>	<u>Welded to Shell</u>
Outlet	<u>1</u>	<u>4"</u>	<u>"</u>	<u>"</u>	<u>.237</u>	<u>"</u>	<u>"</u>
Inlet	<u>1</u>	<u>3"</u>	<u>"</u>	<u>"</u>	<u>.216</u>	<u>None</u>	<u>Welded in Shell</u>
Cor. Probe	<u>1</u>	<u>1-1/2"</u>	<u>"</u>	<u>"</u>	<u>.145</u>	<u>"</u>	<u>"</u>
Various	<u>8</u>	<u>3/4"</u>	<u>"</u>	<u>"</u>	<u>.154</u>	<u>"</u>	<u>"</u>

10. INSPECTION Manholes, No. 2 Size 20" Location In shell at top and bottom
OPENINGS Handholes, No. _____ Size _____ Location _____
Threaded, No. _____ Size _____ Location _____

11. SUPPORTS: Skirt Yes Lugs _____ Legs _____ Other _____ Attached Welded to bottom
(Yes or No) (Number) (Describe) (Where & How) head.

12. REMARKS: 66" I.D. x 14'-0" Seam-Seam Vertical Tower, Item T-115,
per Celanese Dwg. #WT-11187, Markle Mfg. Co. Dwg. 74-67-3704-01.

(Brief description of purpose of the vessel, as Air Tank, After Cooler, Jacketed Cooker, etc. State contents.)

1 If Postweld Heat Treated 2 list other internal or external pressures with coincident temperature when applicable.

We certify that the statements made in this report are correct and that all details of design, material, construction, and workmanship of this vessel conform to the ASME Code for Unfired Pressure Vessels, Section VIII, Division I.

Date 1-20 19 75 Signed Markle Mfg. Co.

(Manufacturer)

By H.E. Spruehl
H.E. Spruehl, V-P & Gen. Mgr.

Certificate of Authorization Expires July 30, 1977.

CERTIFICATE OF SHOP INSPECTION

VESSEL MADE BY Markle Mfg. Co. at Amarillo, Texas

I, the undersigned, holding a valid commission issued by the National Board of Boiler and Pressure Vessel Inspectors and/or the State or Province of Texas and employed by Commercial Union Assurance Cos

of Boston, Mass. have inspected the pressure vessel described in this manufacturer's data report

on Jan. 16 19 75, and state that to the best of my knowledge and belief, the manufacturer has constructed this pressure vessel in accordance with the applicable sections of the ASME Boiler and Pressure Vessel Code.

By signing this certificate neither the Inspector nor his employer makes any warranty, expressed or implied, concerning the pressure vessel described in this manufacturer's data report. Furthermore, neither the Inspector nor his employer shall be liable in any manner for any personal injury or property damage or a loss of any kind arising from or connected with this inspection.

Date 1-20 19 75

Ralph X. King
Inspectors Signature

Commissions Nat'l Board 5912

Nat'l Board, State, or Province and No.