




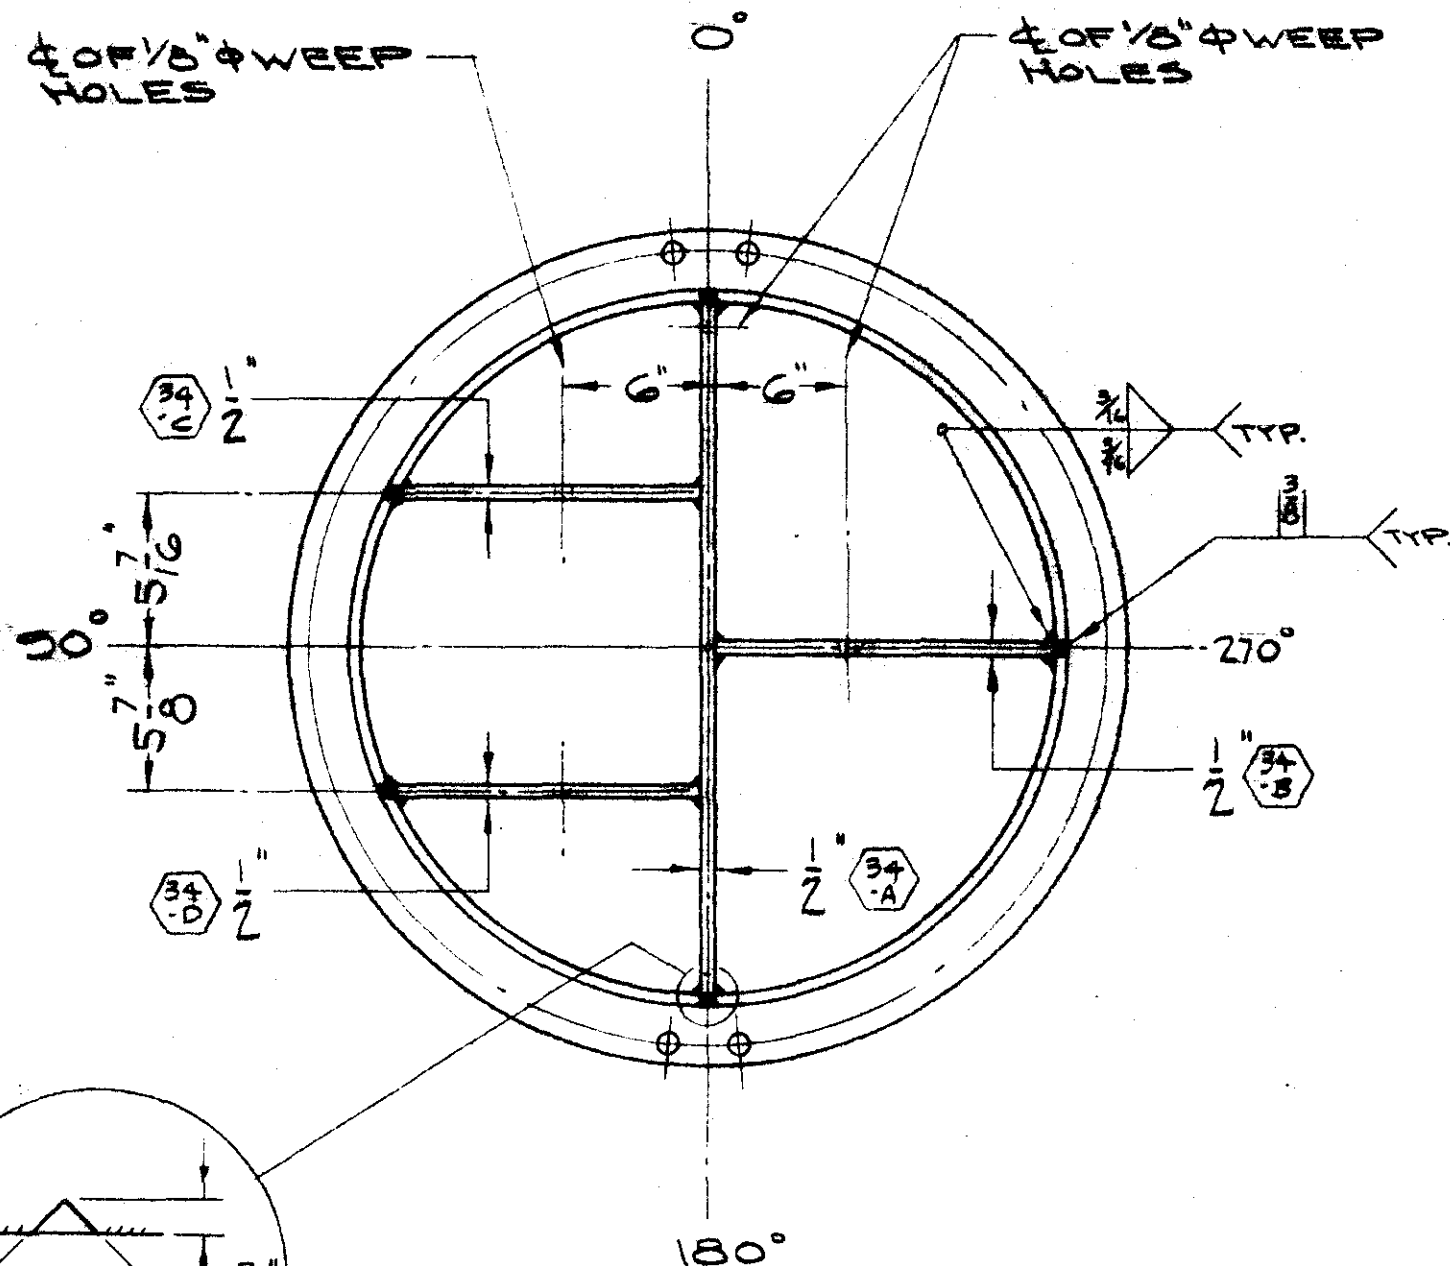


VIEW "F-F"

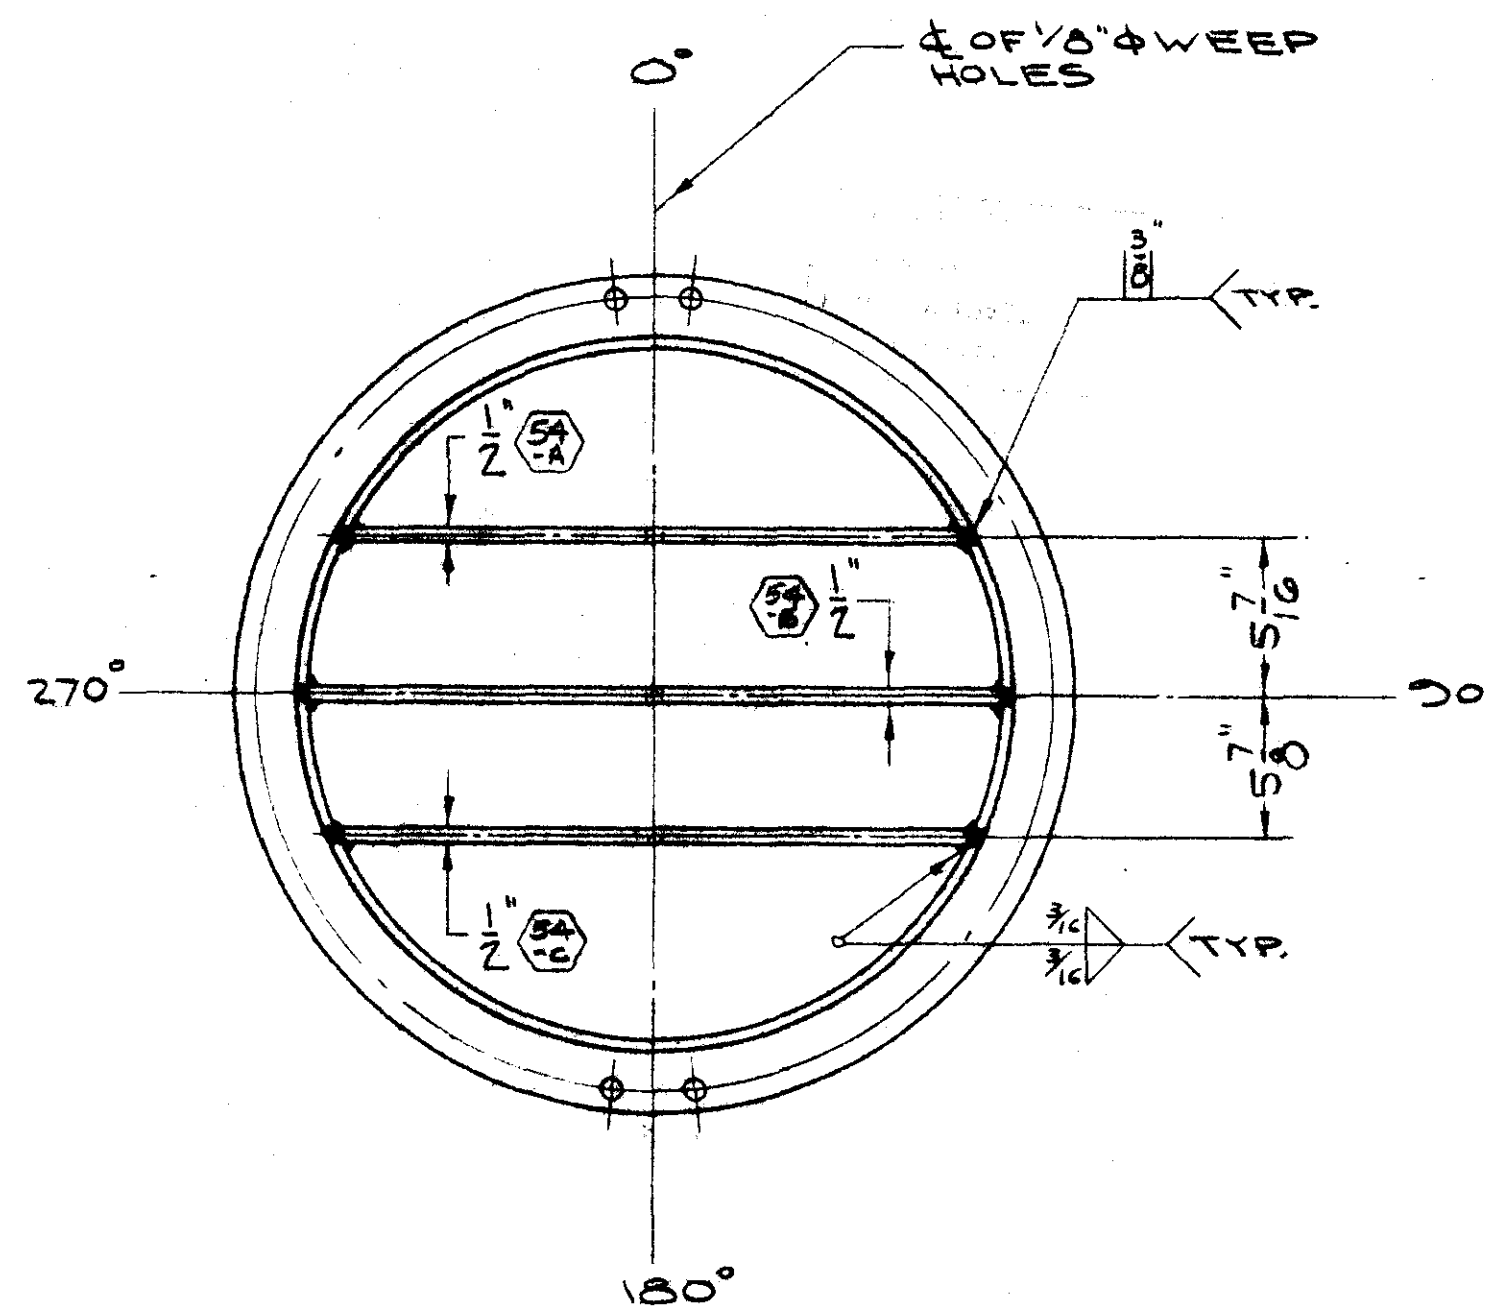

VIEW "G-G"

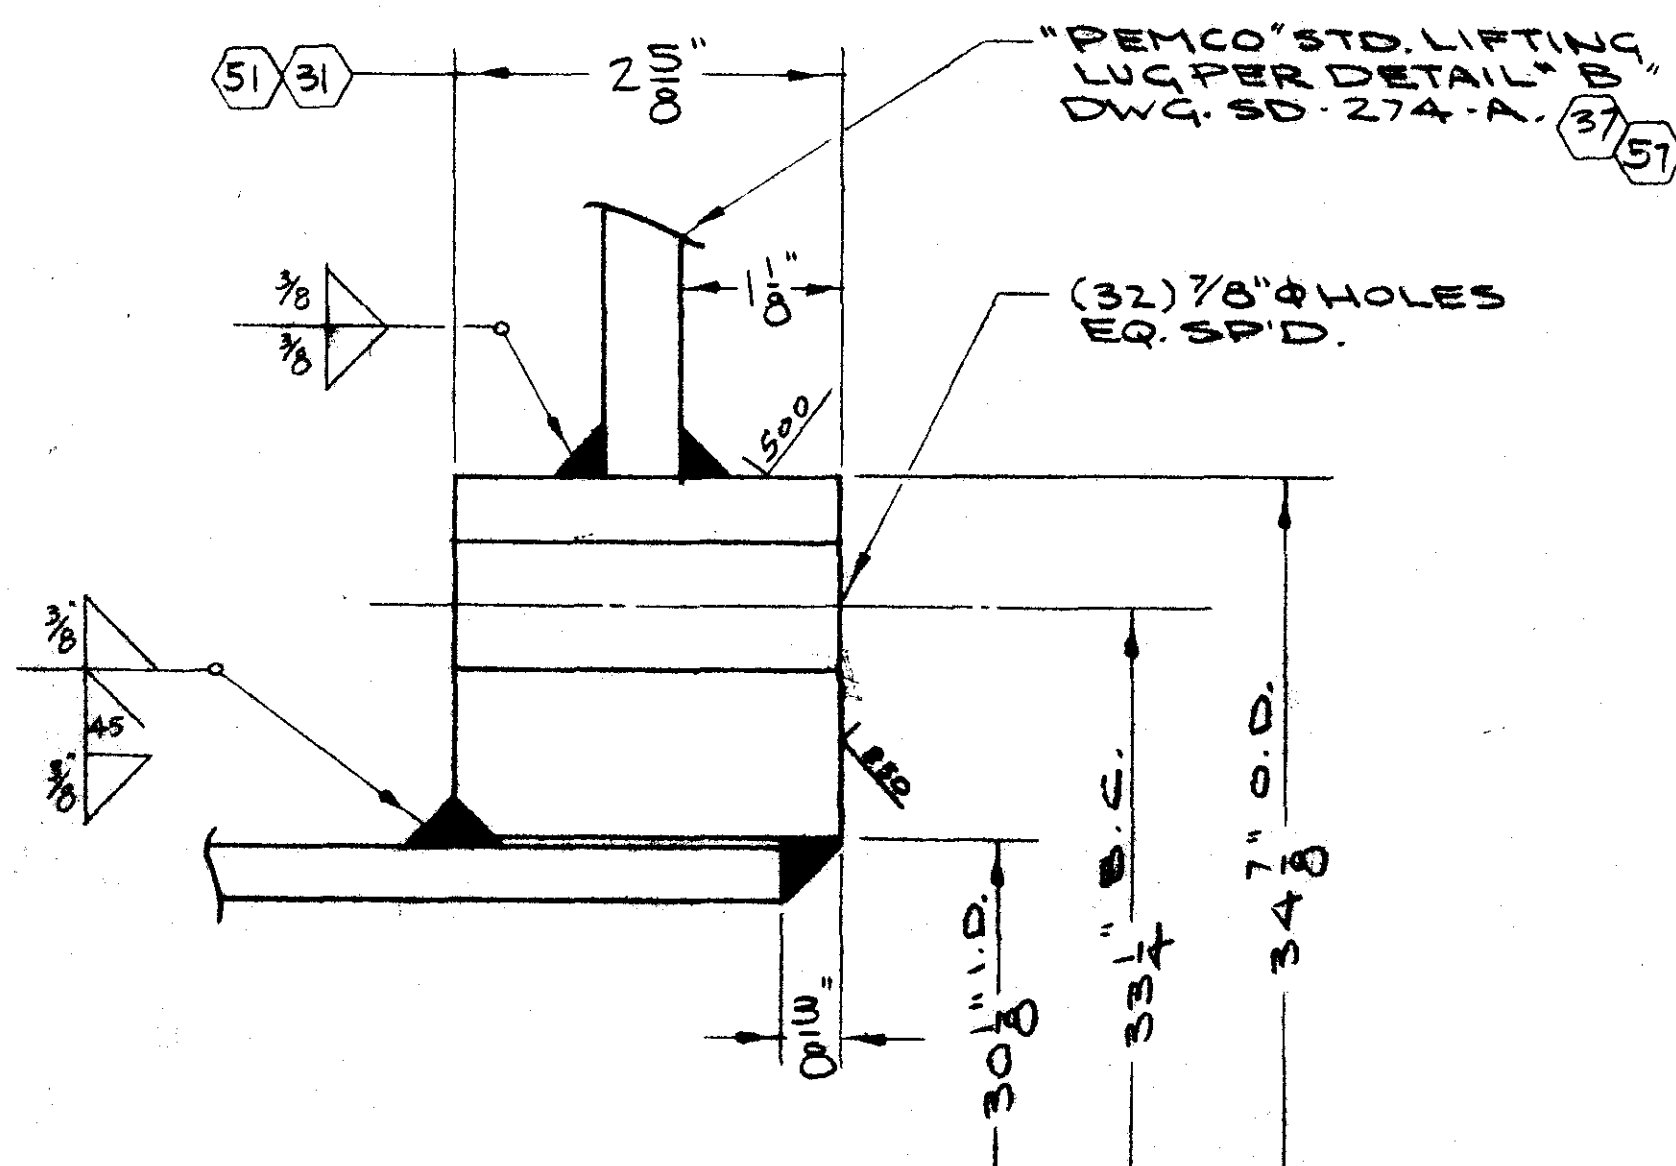


DETAIL "H"

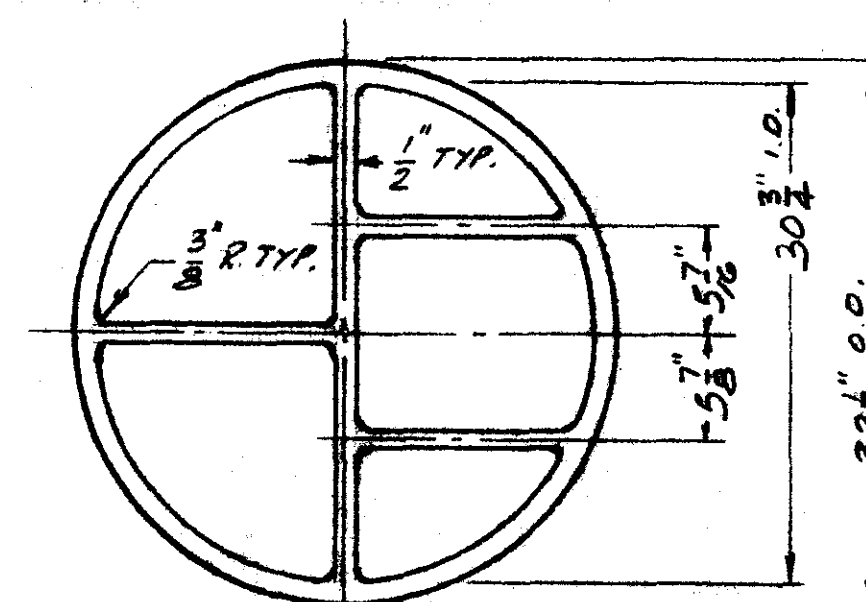

DETAIL "D"

INLET BONNET TO TUBESHEET GASKET
(1) REQ'D, MATERIAL - 1/8" TK MELRATH #750
OR EQUAL. GASKET TO BE MADE IN ONE PIECE

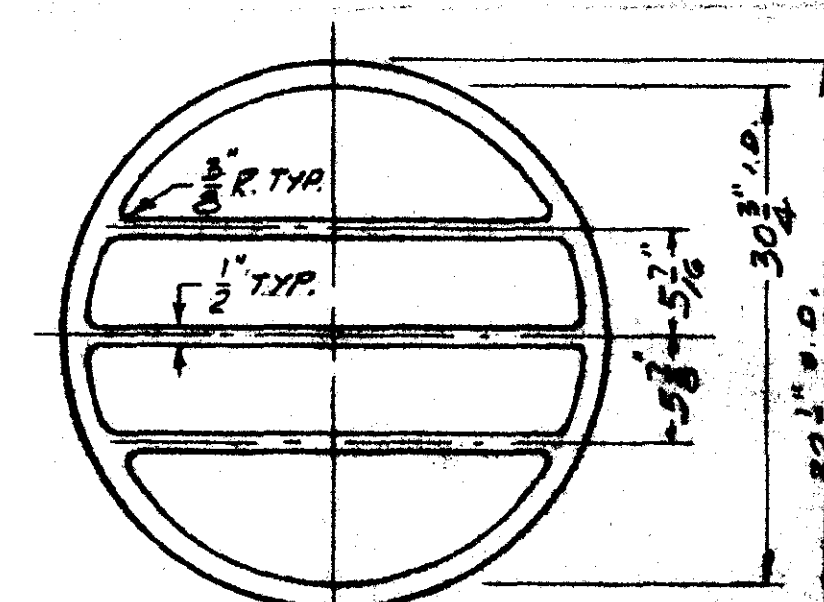

DETAIL "E"

RETURN BONNET TO TUBESHEET GASKET
(1) REQ'D, MATERIAL - 1/8" TK MELRATH #750 OR
EQUAL. GASKET TO BE MADE IN ONE PIECE

ADD TO
DWG.




ITEM NUMBER E327
F. W. CONTRACT 15-2192
F. W. REQ. No. 2192-1211
F. W. P. O. No. P224-1152192

FULLY APPROVED FOR FABRICATION.
APPROVED FOR FABRICATION, SUBJECT TO
THE NOTED REVISIONS AND/OR COMMENTS.
This drawing approved as to layout and general
design. No responsibility is accepted for
detailed design, dimensions, or construction
of equipment. This approval does not release
supplier or contractor from any liability in
connection herewith.
FOSTER WHEELER ENERGY CORP., LIVINGSTON, N.J.
DATE 10/13/78 BY AS


REFERENCE DWGS.	
J-8149-1-0	
SD-136-A	
SD-150-A	
SD-274-A	
CUST. P.O. PP-224-115-2192	
CONTRACT 8149	

REV.	DESCRIPTION	DATE	BY
PROCESS ENGINEERING & MACHINE CO. INC.			
ELIZABETH NEW JERSEY			
DETAILS FOR ONE (1) 25-144 TOTAL CONDENSER TYPE BEM (H) P224-E-327 EQUIP CODE MEX 3754			
FOSTER WHEELER ENERGY CORP., LIVINGSTON, N.J.			
DRAWN BY	DATE 9/6/78	SCALE	
APPROVED	DATE		
CHECKED BY	DATE 10/13/78		
DWG. J-8149-2-C			REV.

99646

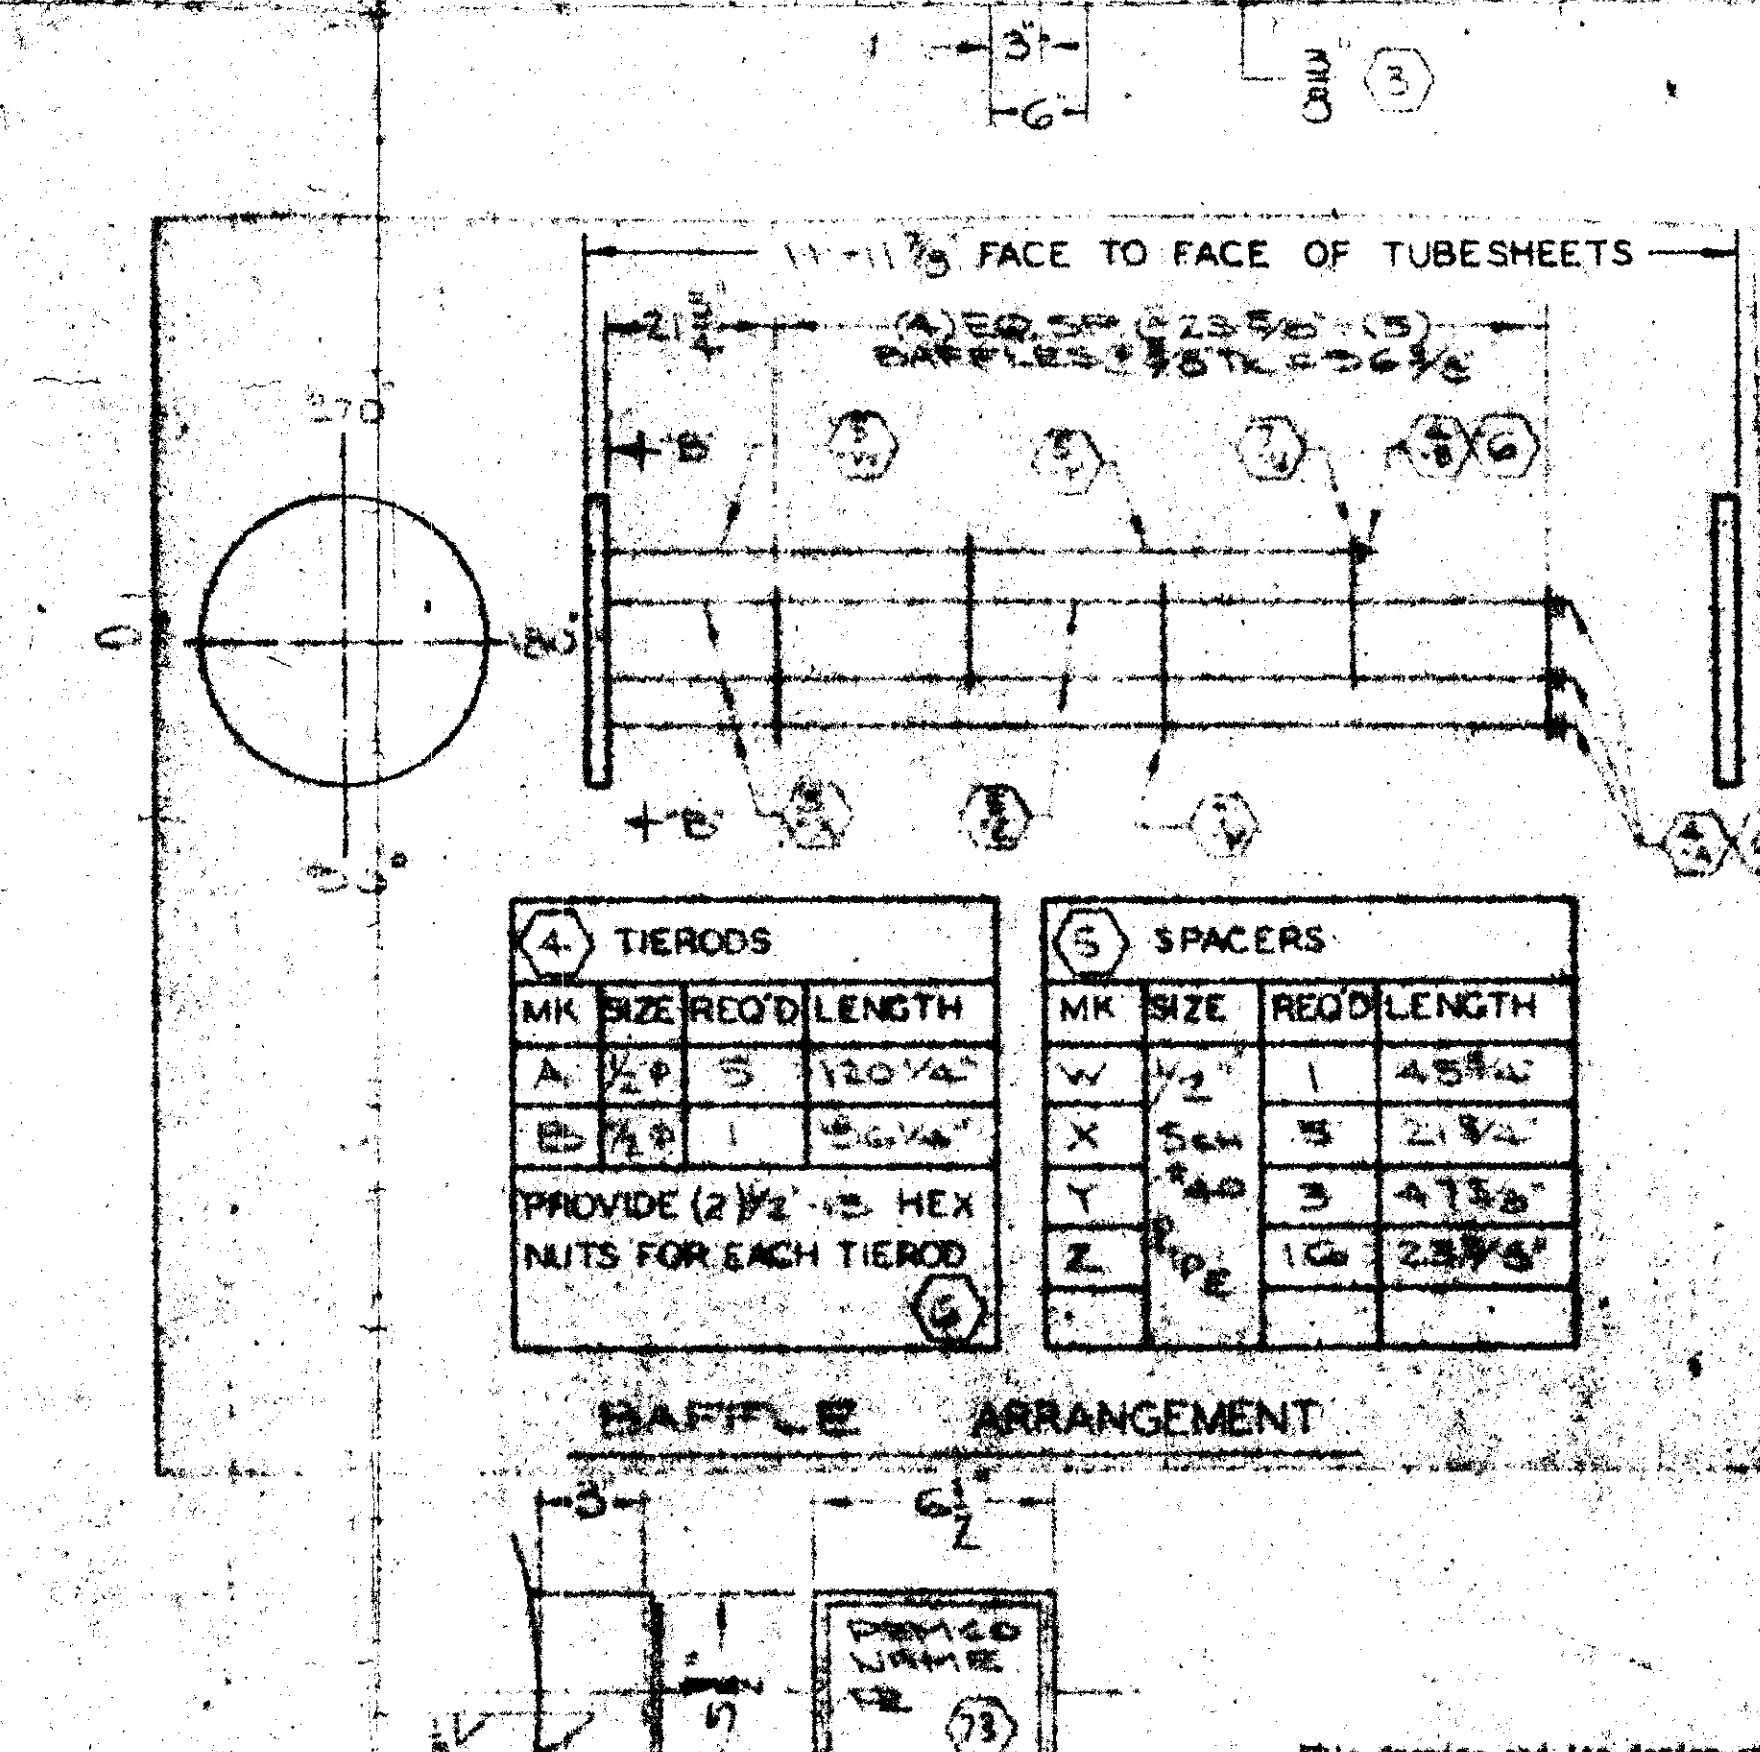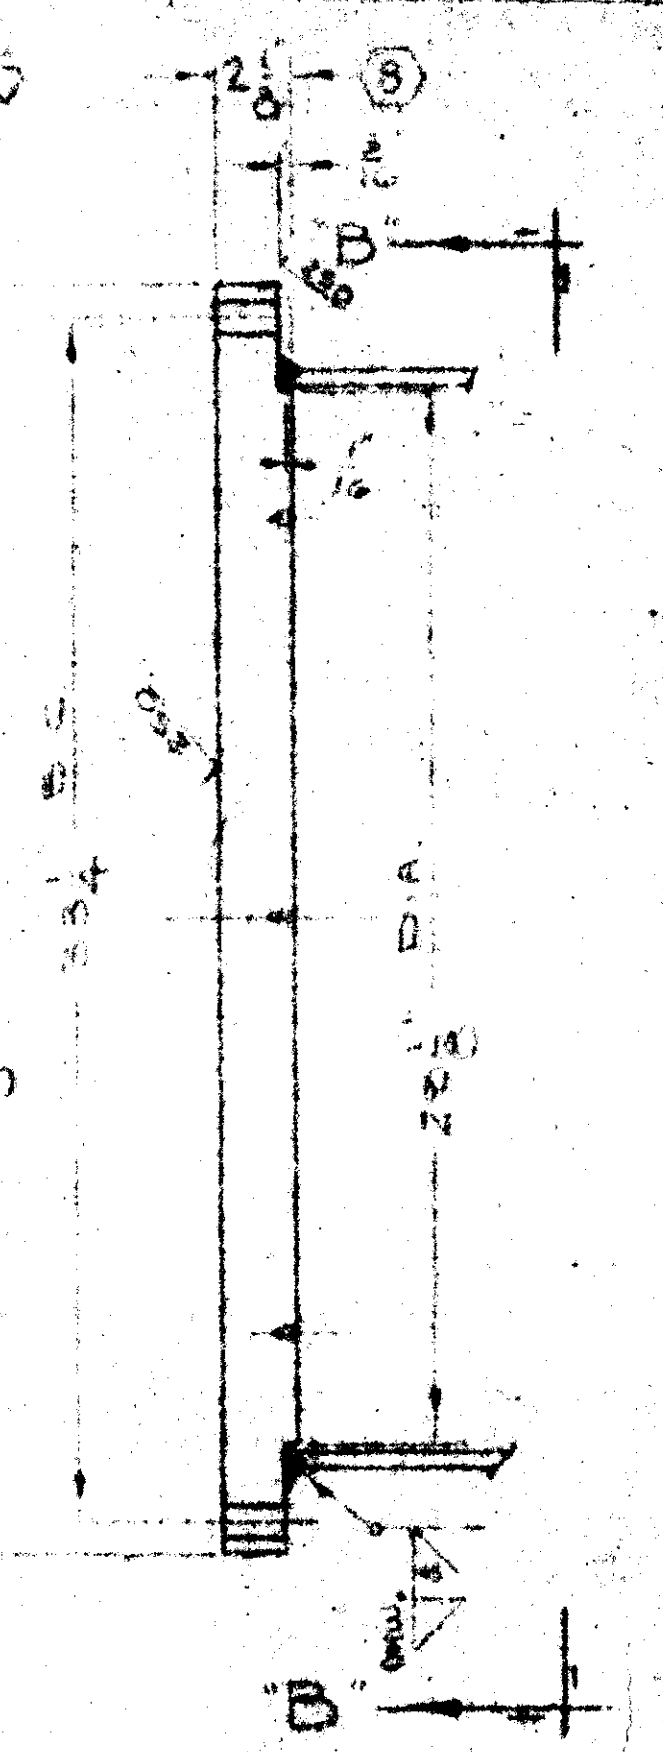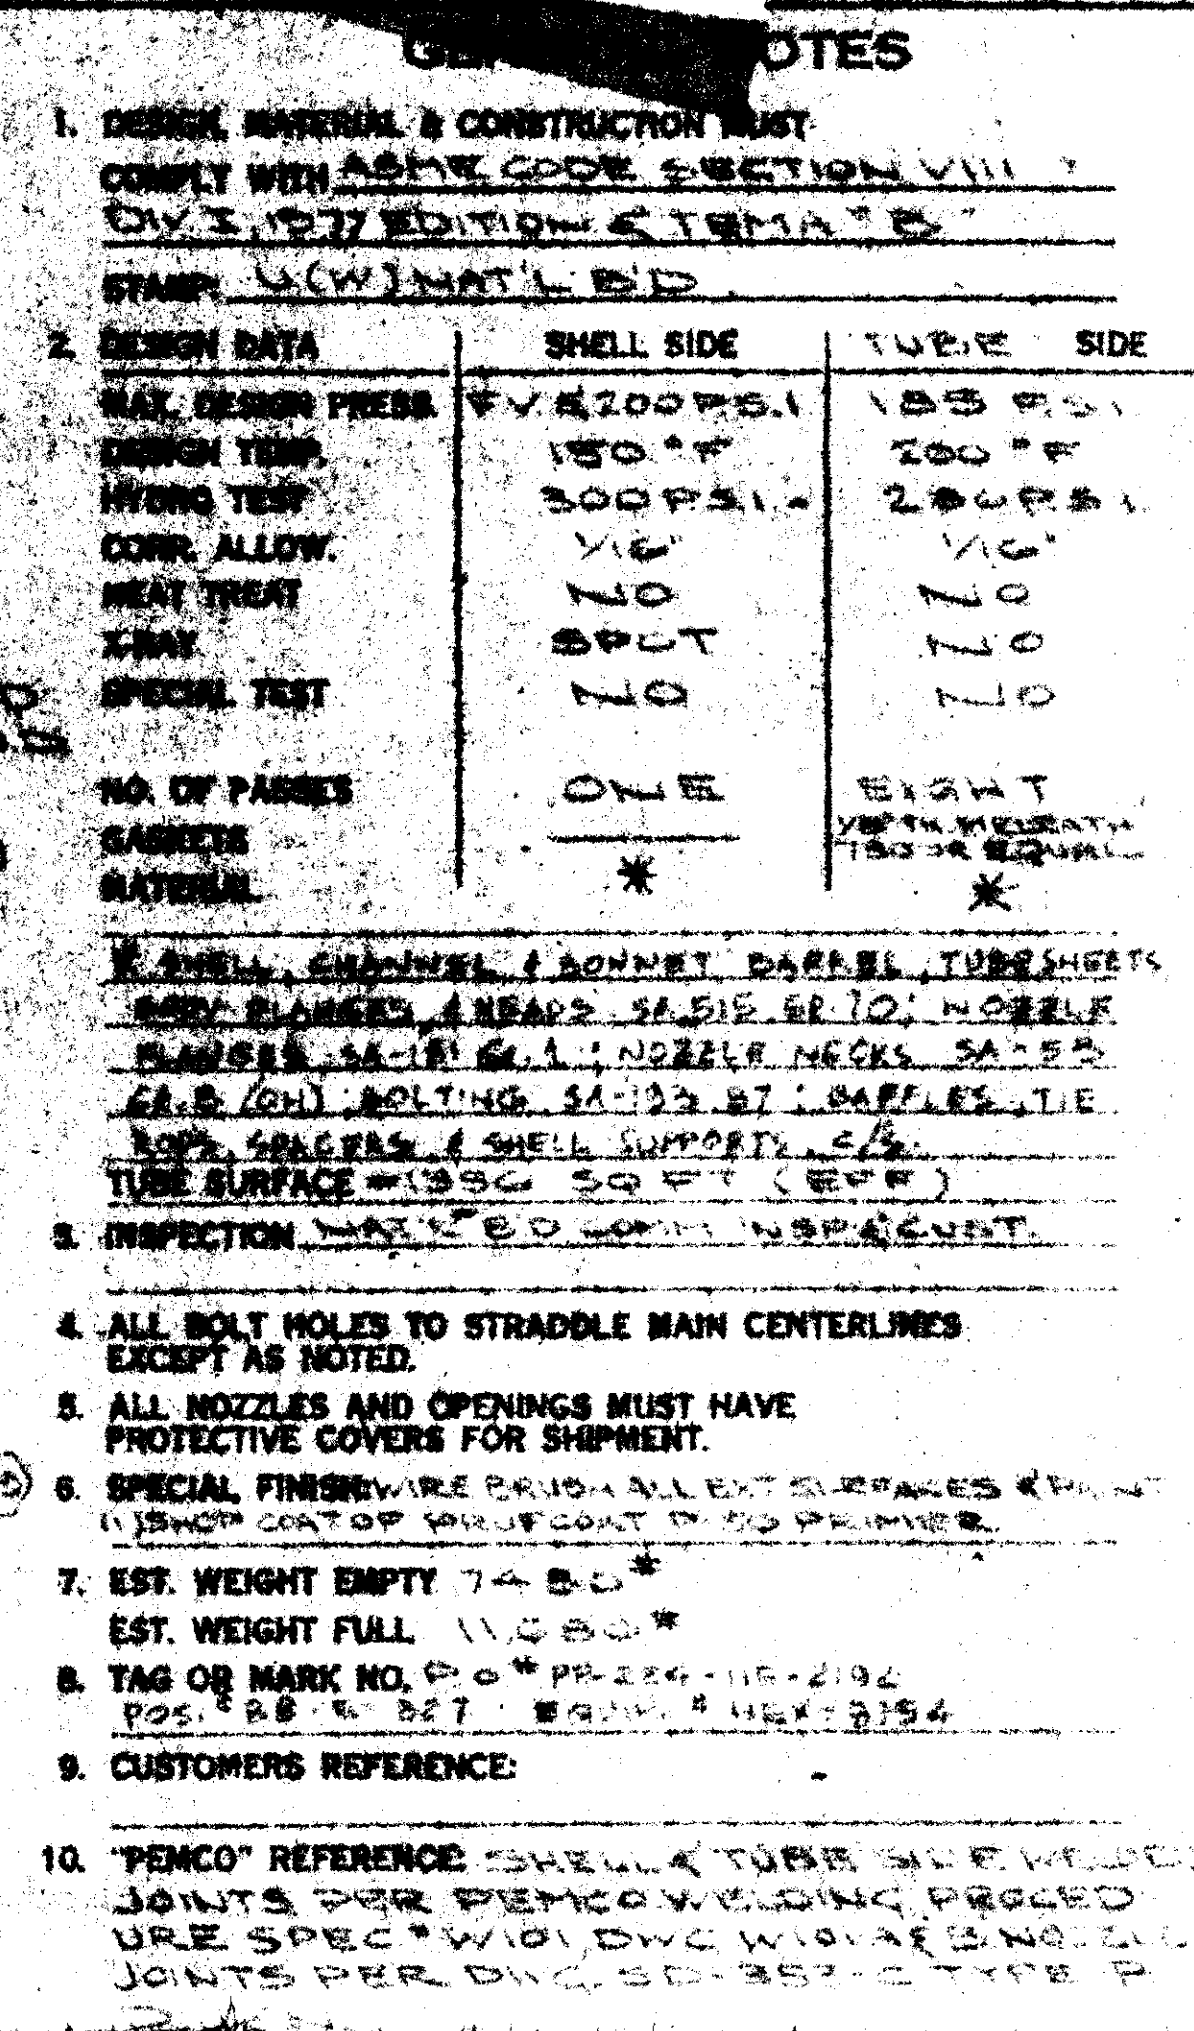

4. TIERODS			
MK	SIZE	REQ'D	LENGTH
A	1/2" S	120	4"
B	1/4" S	1	56
PROVIDE (2) 1/2" S HEX NUTS FOR EACH TIEROD			

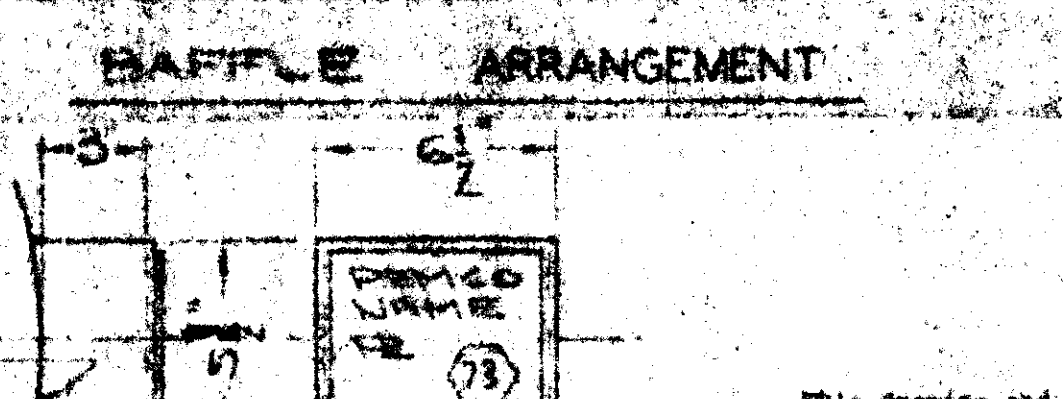

This drawing and its design are the property of
Process Manufacturing and Machine Company, Inc.
~~Company~~. ~~Manufacturing~~ This drawing is loaned to
you solely for your information and is not to be
reproduced, copied, used or otherwise disposed of,
directly or indirectly. It shall not be used to
publish any literature for the purpose of creating
prints, or reproducing or transmitting designs
where otherwise specifically provided for by contract.

TEMPERED VENDOR DRAWING
RELEASED FOR ERECTION

JAN 12 1979

D.L. NO. 21-540 BY
FOSTER WHEELER ENERGY CORP.
LIVINGSTON, N. J. 07039

☒ FULLY APPROVED FOR FABRICATION.
☐ APPROVED FOR FABRICATION, SUBJECT TO THE NOTED REVISIONS AND/OR COMMENTS.
This drawing approved as to layout and general content. No responsibility is accepted for detailed design, dimensions, or construction of equipment. This approval does not relieve supplier or contractor from any liability in connection herewith.
FOSTER WHEELER ENERGY CORP.
1000 STON, N. J. 07039
DATE 1/29/89 BY JS

DATE **DEC 19 1978**
8/6 11330
 PROCESSING & MATCH CO. INC.
 CERTIFIED PRINT

PROCESS ENGINEERING & MACHINE CO. INC.
 1000 10th AVE. NEW JERSEY
 NATL. BD 4115
 U CU PEMCO
 W M A W P.
 SPELL EV 4200 PSI AT 150 F
 TUBES 105 PSI AT 200 F
 SH SER NO 8149 RD
 KR BUILT 1976

NAMEPLATE STAMPING DETAIL

2	REVISED F.W. REG. NO.	11/17/75
1	ADDED TABLE - 374	11/18/75
DATE	REVISION	DATE
PROCESS ENGINEERING & MACHINE CO. INC.		
ELIZABETH		NEW JERSEY
ORDER 23-44 TOTAL QUANTITY		
TYPE REQ'D		
PO# 88-5-827 EQUIP CODE# 487552		
PAPER WEIGHTS ENGINE CORN. LIVINGSTON, N. J.		
DESIGN & CO.	DATE 8/8/75	SCALE 1/4" = 1'-0"
CHECKED BY	DATE 11/18/75	DWG 3-8243-1.0
APPROVED	DATE	

996046